


FED. ROAD DIST. NO.	STATE	FED. AID PROJ. NO.	FISCAL YEAR	SHEET NO.	TOTAL SHEETS
HAWAII	HAW.	BR-0190(13)	1999	68	75

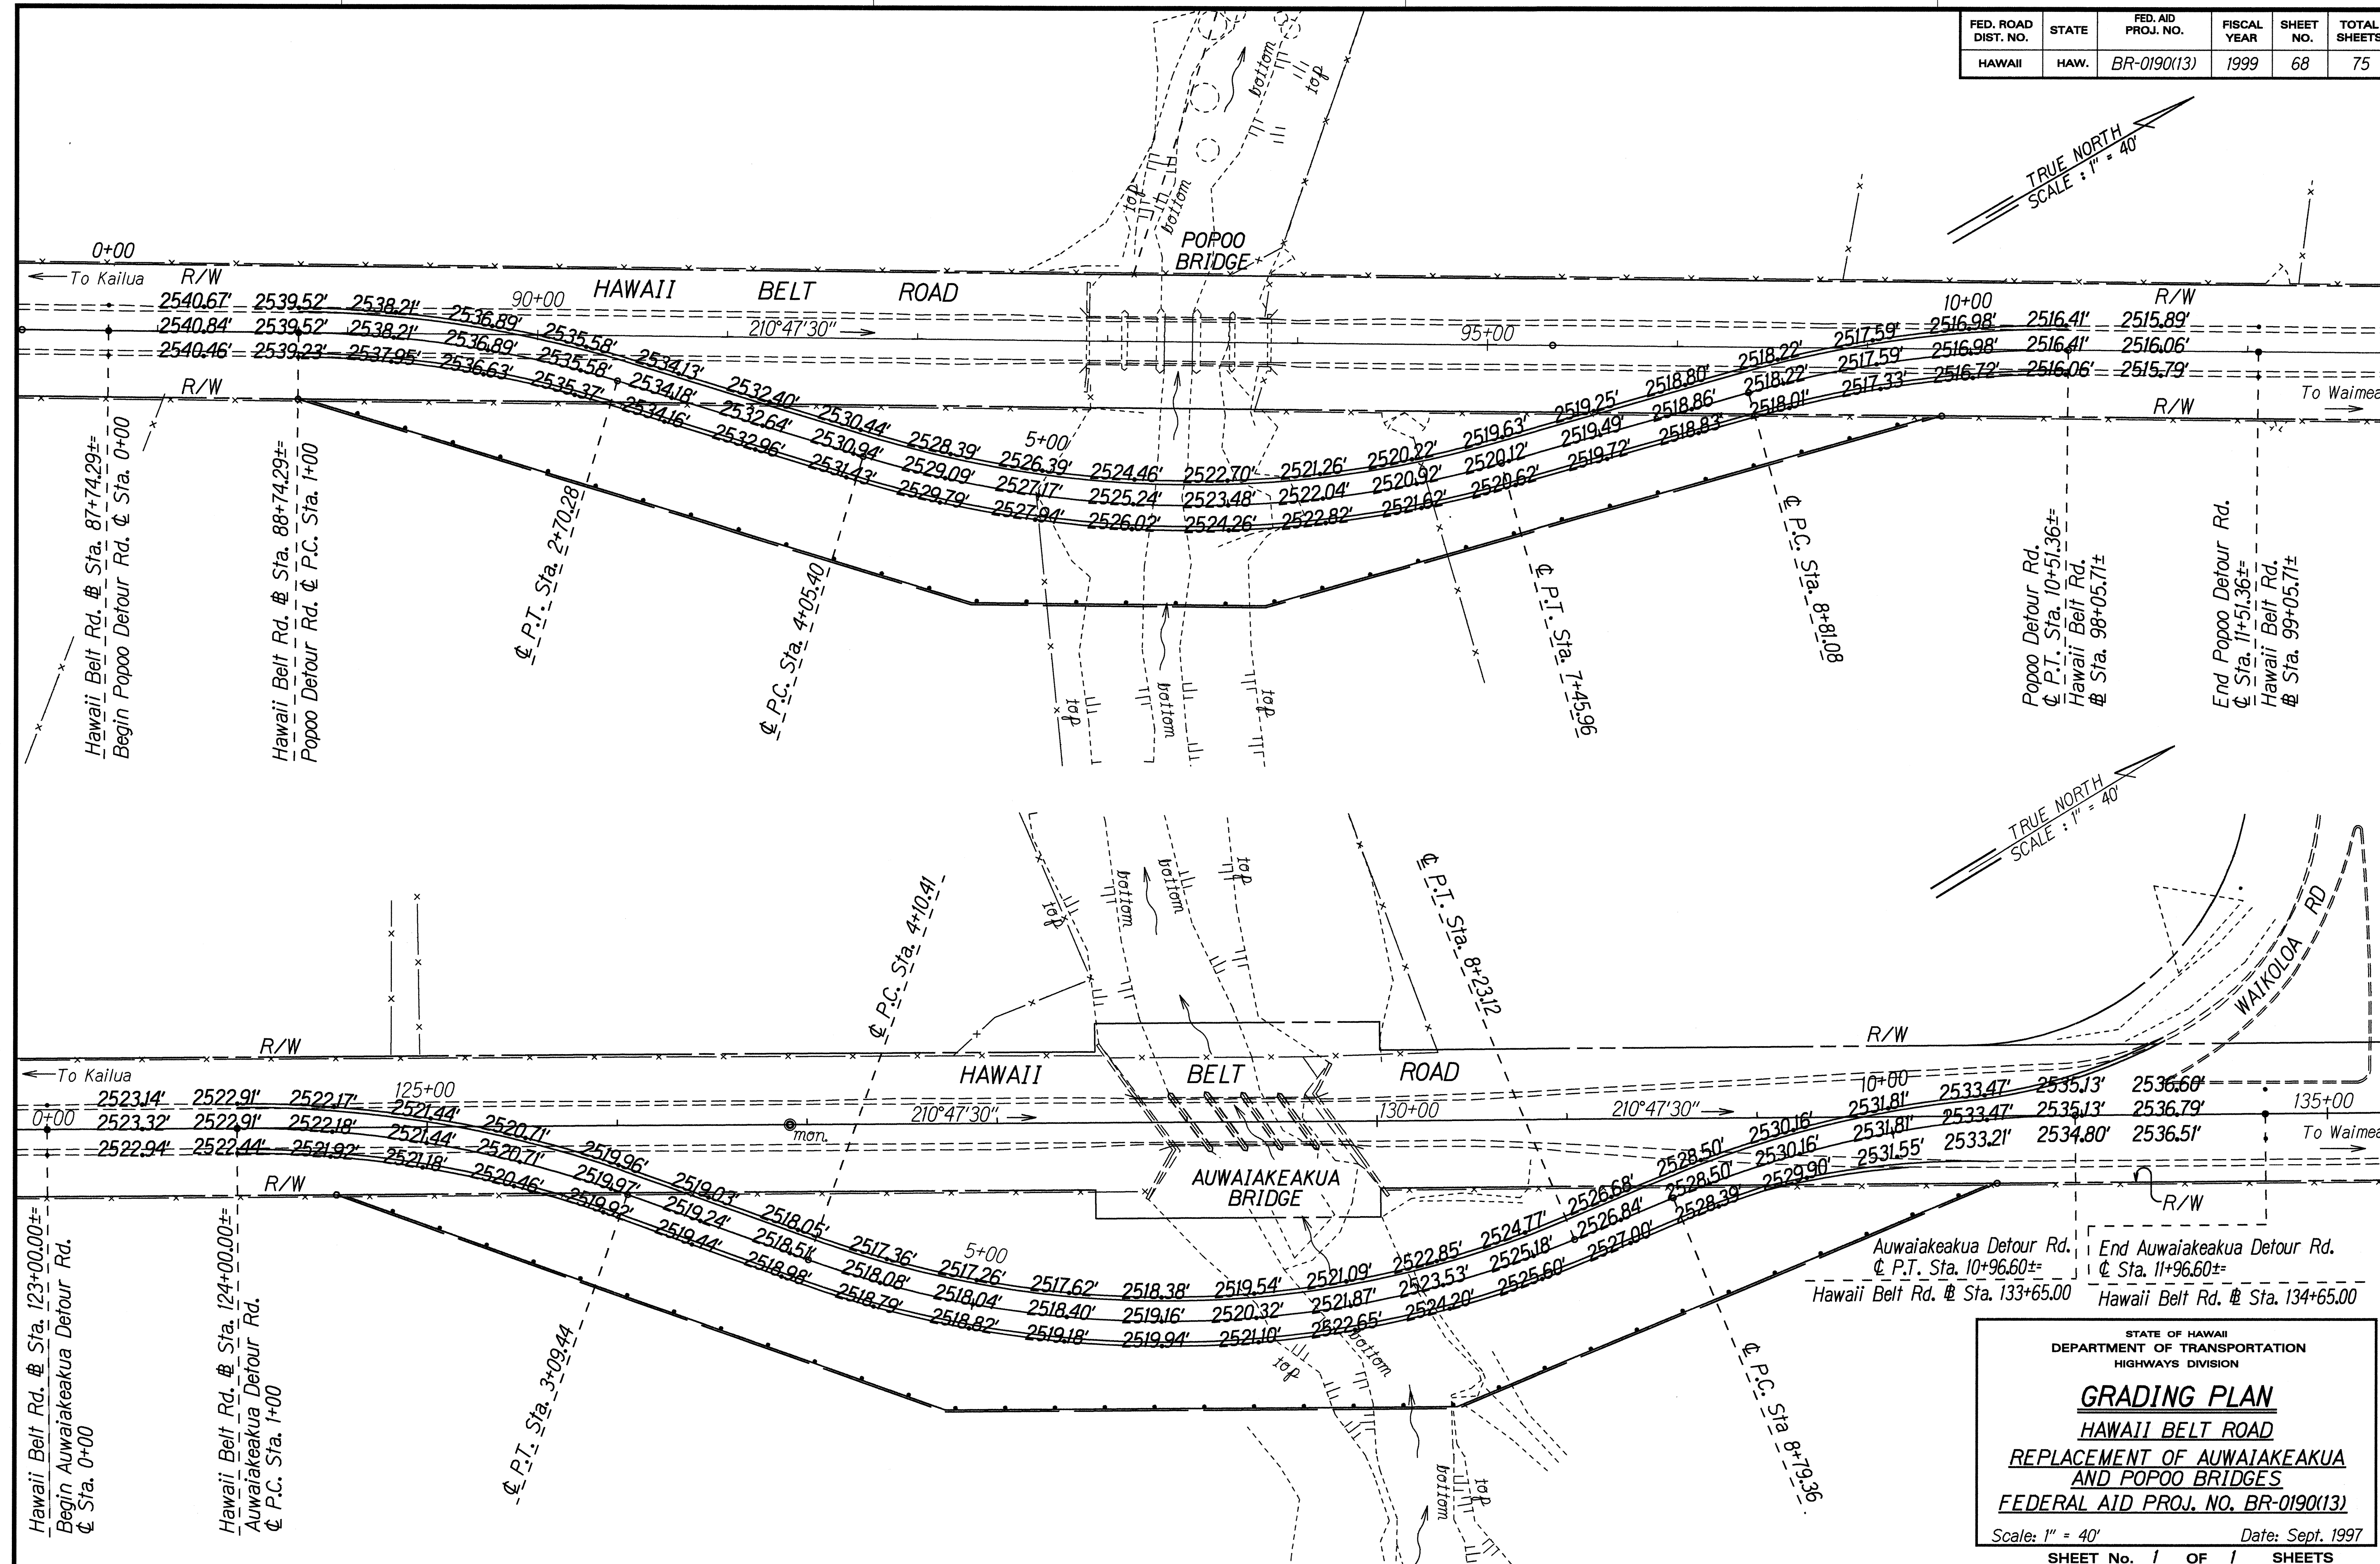

ORIGINAL PLAN	DATE
DESIGNED BY	3-20-99
NOTED BY	
CHECKED BY	
DESIGNED BY	
NOTED BY	
CHECKED BY	

STATE OF HAWAII
DEPARTMENT OF TRANSPORTATION
HIGHWAYS DIVISION

GRADING PLAN
HAWAII BELT ROAD
REPLACEMENT OF AUWAIKEAKUA AND POPOO BRIDGES
FEDERAL AID PROJ. NO. BR-0190(13)

Scale: 1" = 40' Date: Sept. 1997
SHEET No. 1 OF 1 SHEETS