


¢ Sta. 4+00± Lt. to ¢ Sta. 7+25± Lt.
 Install 225± L.F. of Guardrail, Type 3-Single



DETOUR ROAD

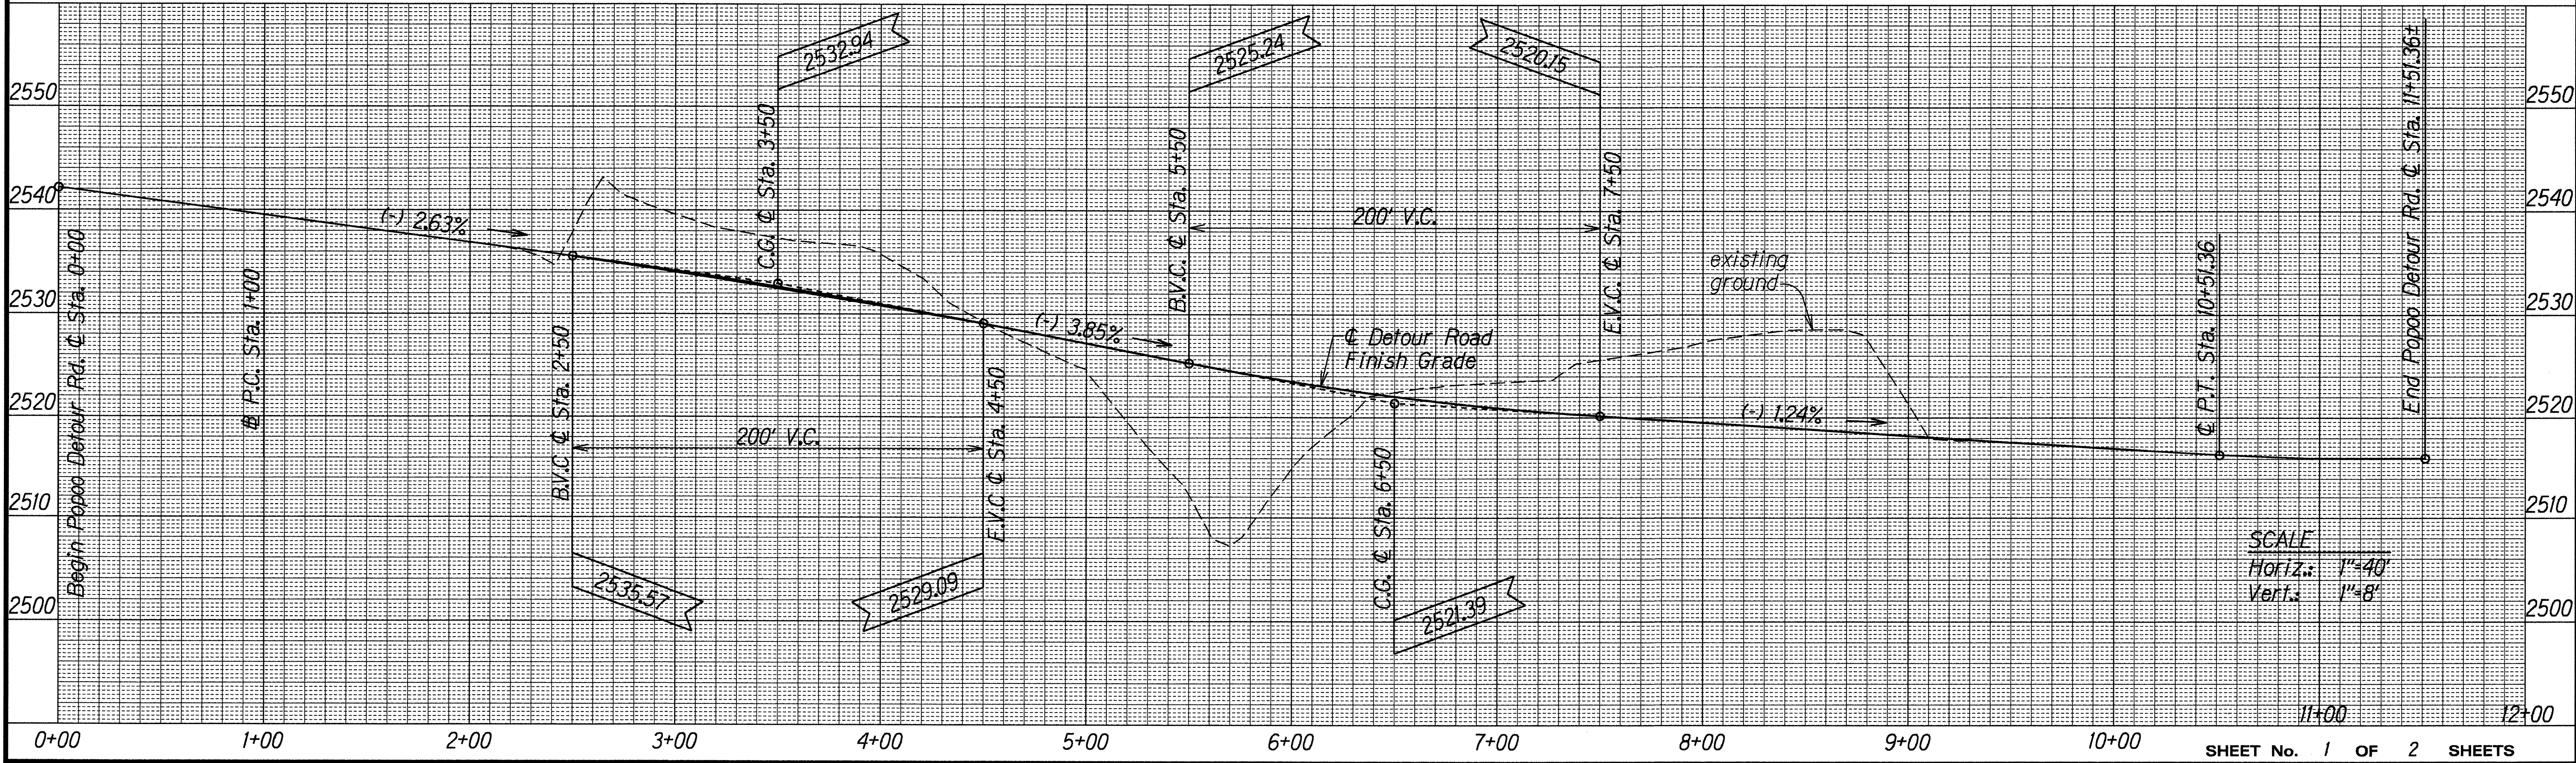

				51
--	--	--	--	----

