


FED. ROAD DIST. NO.	STATE	FED. AID PROJ. NO.	FISCAL YEAR	SHEET NO.	TOTAL SHEETS
HAWAII	HAW.	BR-0190(13)	1999	7	75

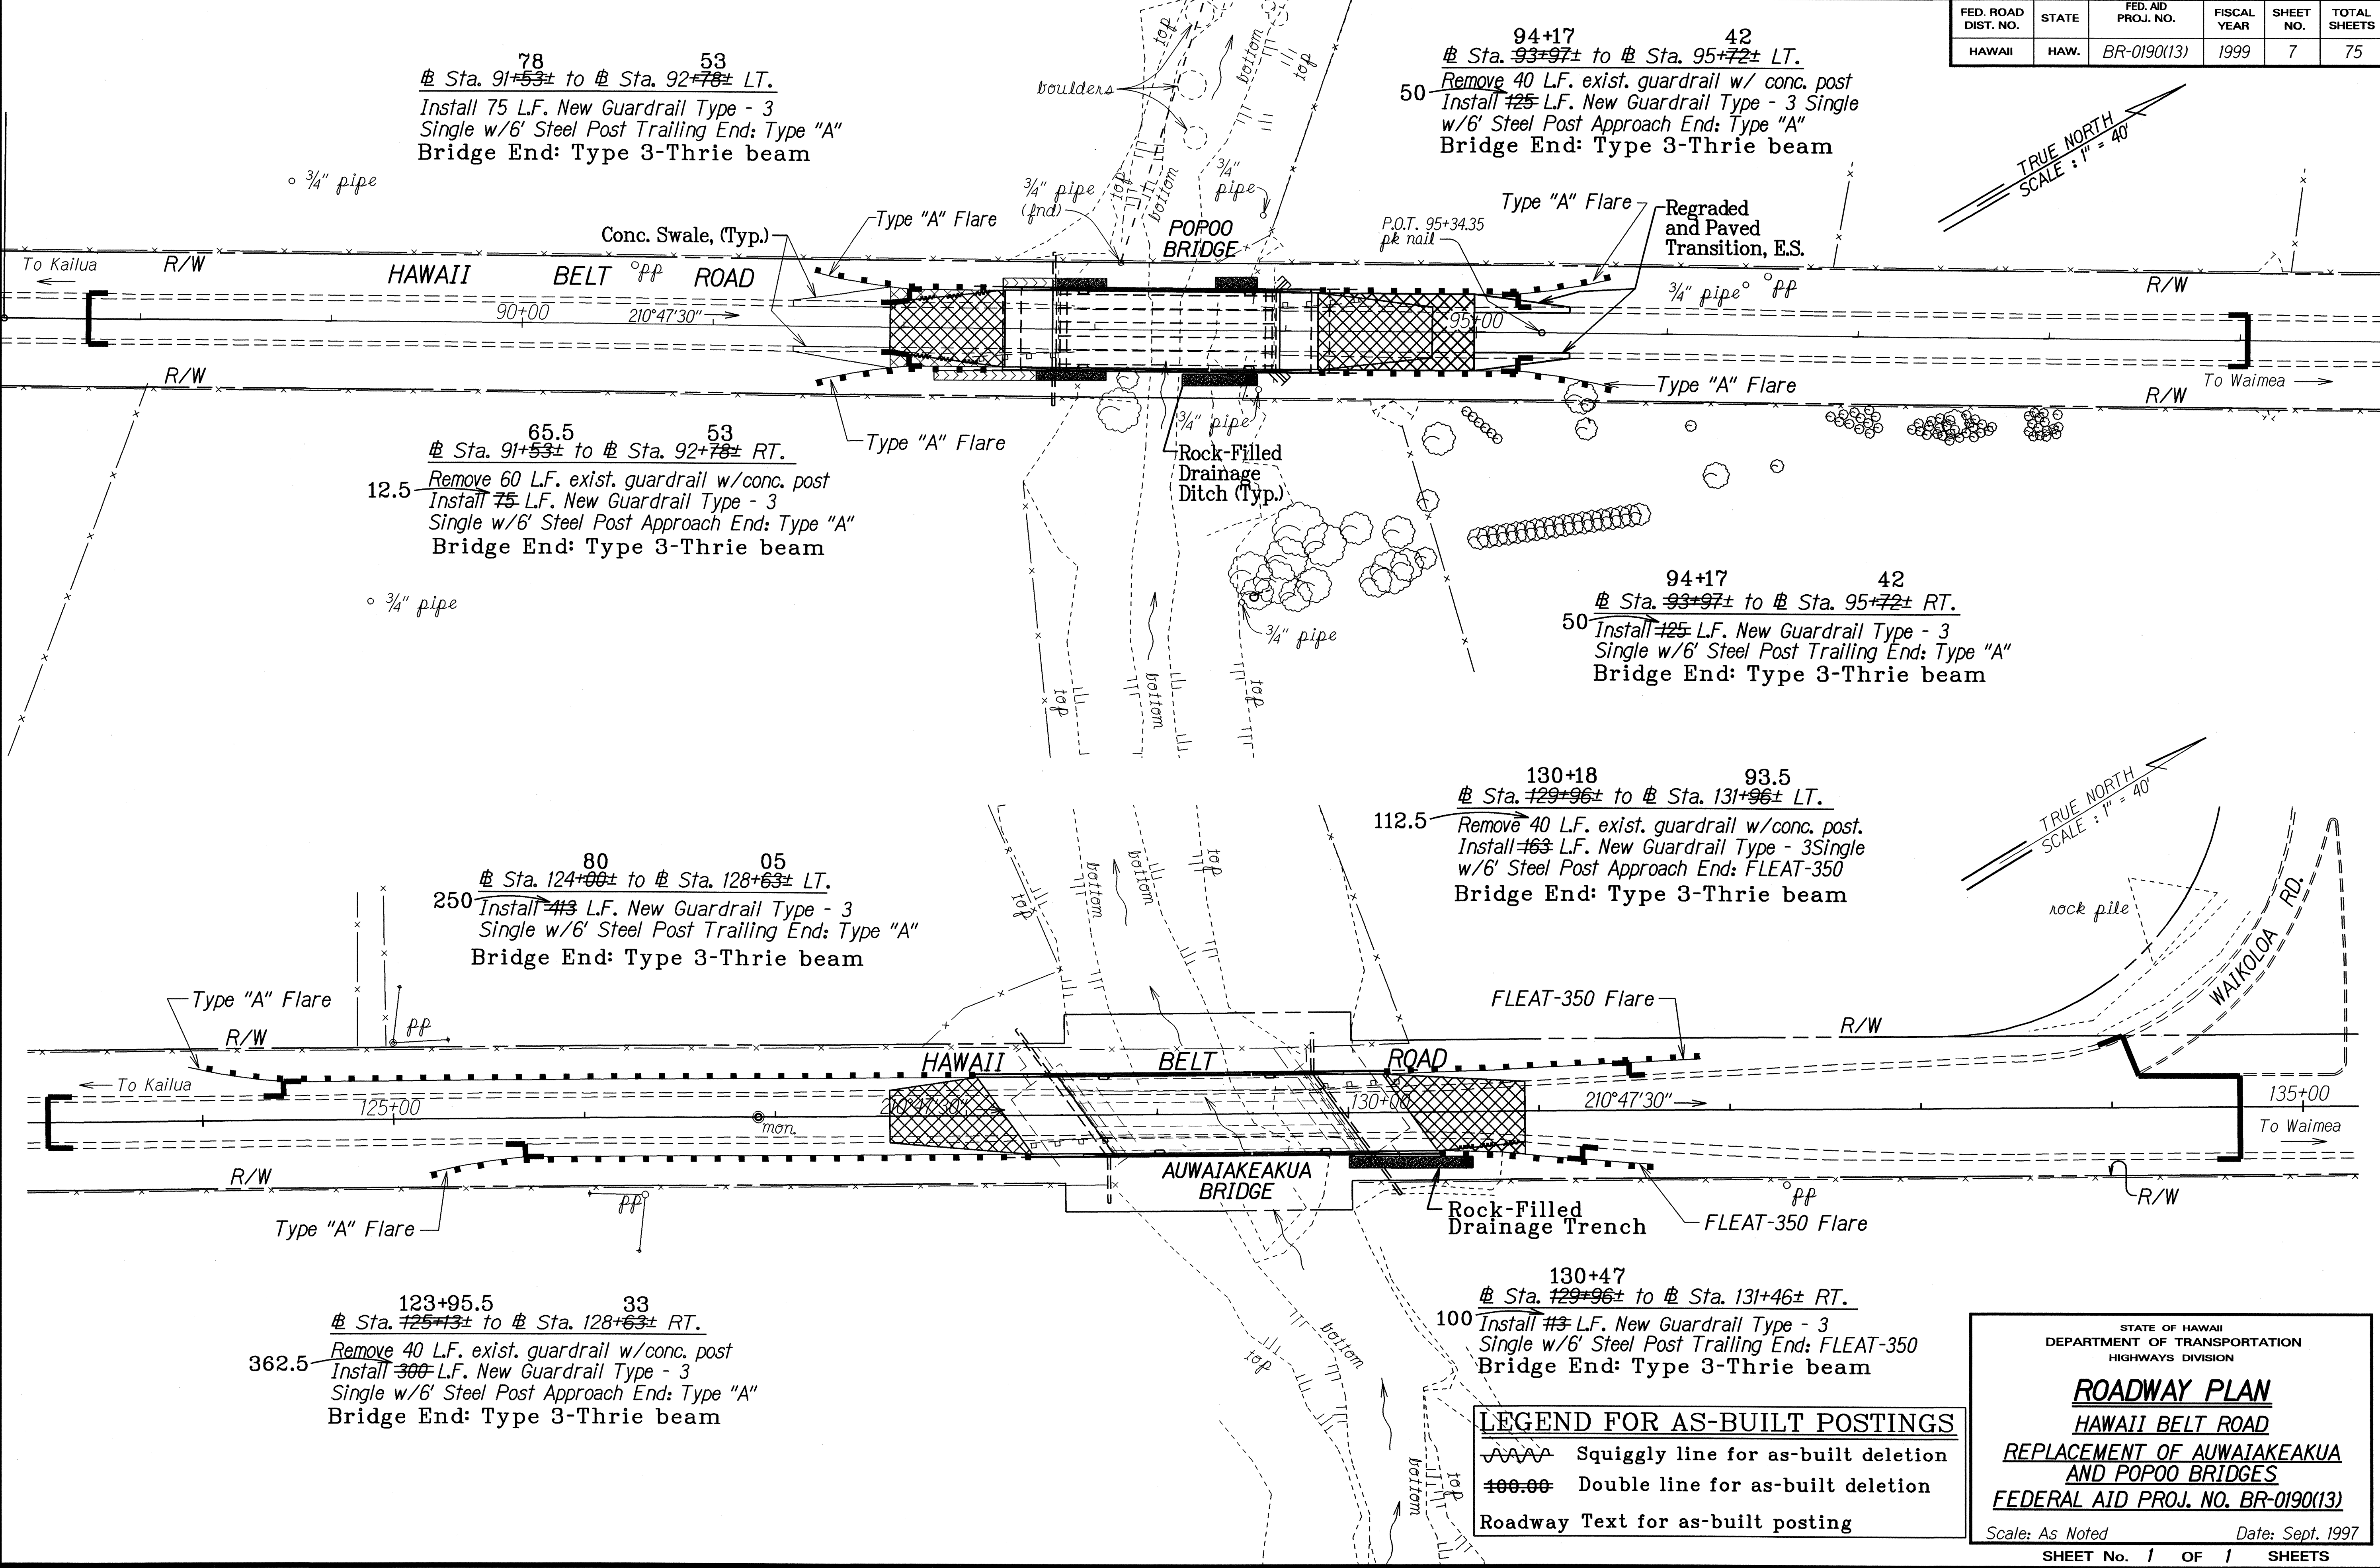

SURVEY PLOTTED BY	DATE
DRAWN BY P. WOOD, MH	4/23/99
DESIGNED BY J. WOOD, MH	
CHECKED BY S. WOOD, MH	
NOTED BY S. WOOD, MH	
ORIGINAL PLAN	

LEGEND FOR AS-BUILT POSTINGS	
~~~~~	Squiggly line for as-built deletion
====	Double line for as-built deletion
Roadway Text for as-built posting	

STATE OF HAWAII  
DEPARTMENT OF TRANSPORTATION  
HIGHWAYS DIVISION

**ROADWAY PLAN**  
**HAWAII BELT ROAD**  
**REPLACEMENT OF AUWAIKEAKUA**  
**AND POPOO BRIDGES**  
**FEDERAL AID PROJ. NO. BR-0190(13)**

Scale: As Noted Date: Sept. 1997  
SHEET No. 1 OF 1 SHEETS

"AS-BUILT"