


STATE OF HAWAII  
DEPARTMENT OF TRANSPORTATION  
HIGHWAYS DIVISION


ROADWAY & STRIPING PLAN  
HBR RESURFACING  
HONOKOHAU TO KAUPULEHU  
PROJ. 120B-01-31M

Scale: 1"=100'      Date: Nov. 1990

**SHEET No. 1 OF 5 SHEETS**

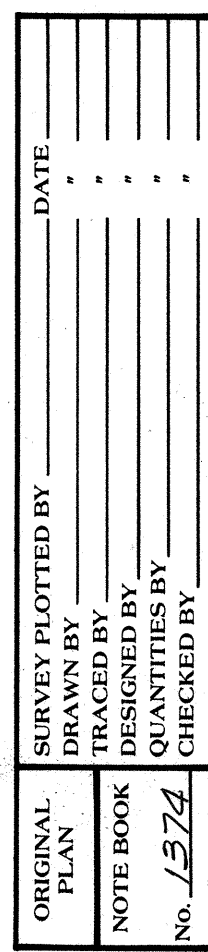

FED. ROAD DIST. NO.	STATE	FED. AID PROJ. NO.	FISCAL YEAR	SHEET NO.	TOTAL SHEETS
HAWAII	HAW.	190B-01-21M	1991	5	10

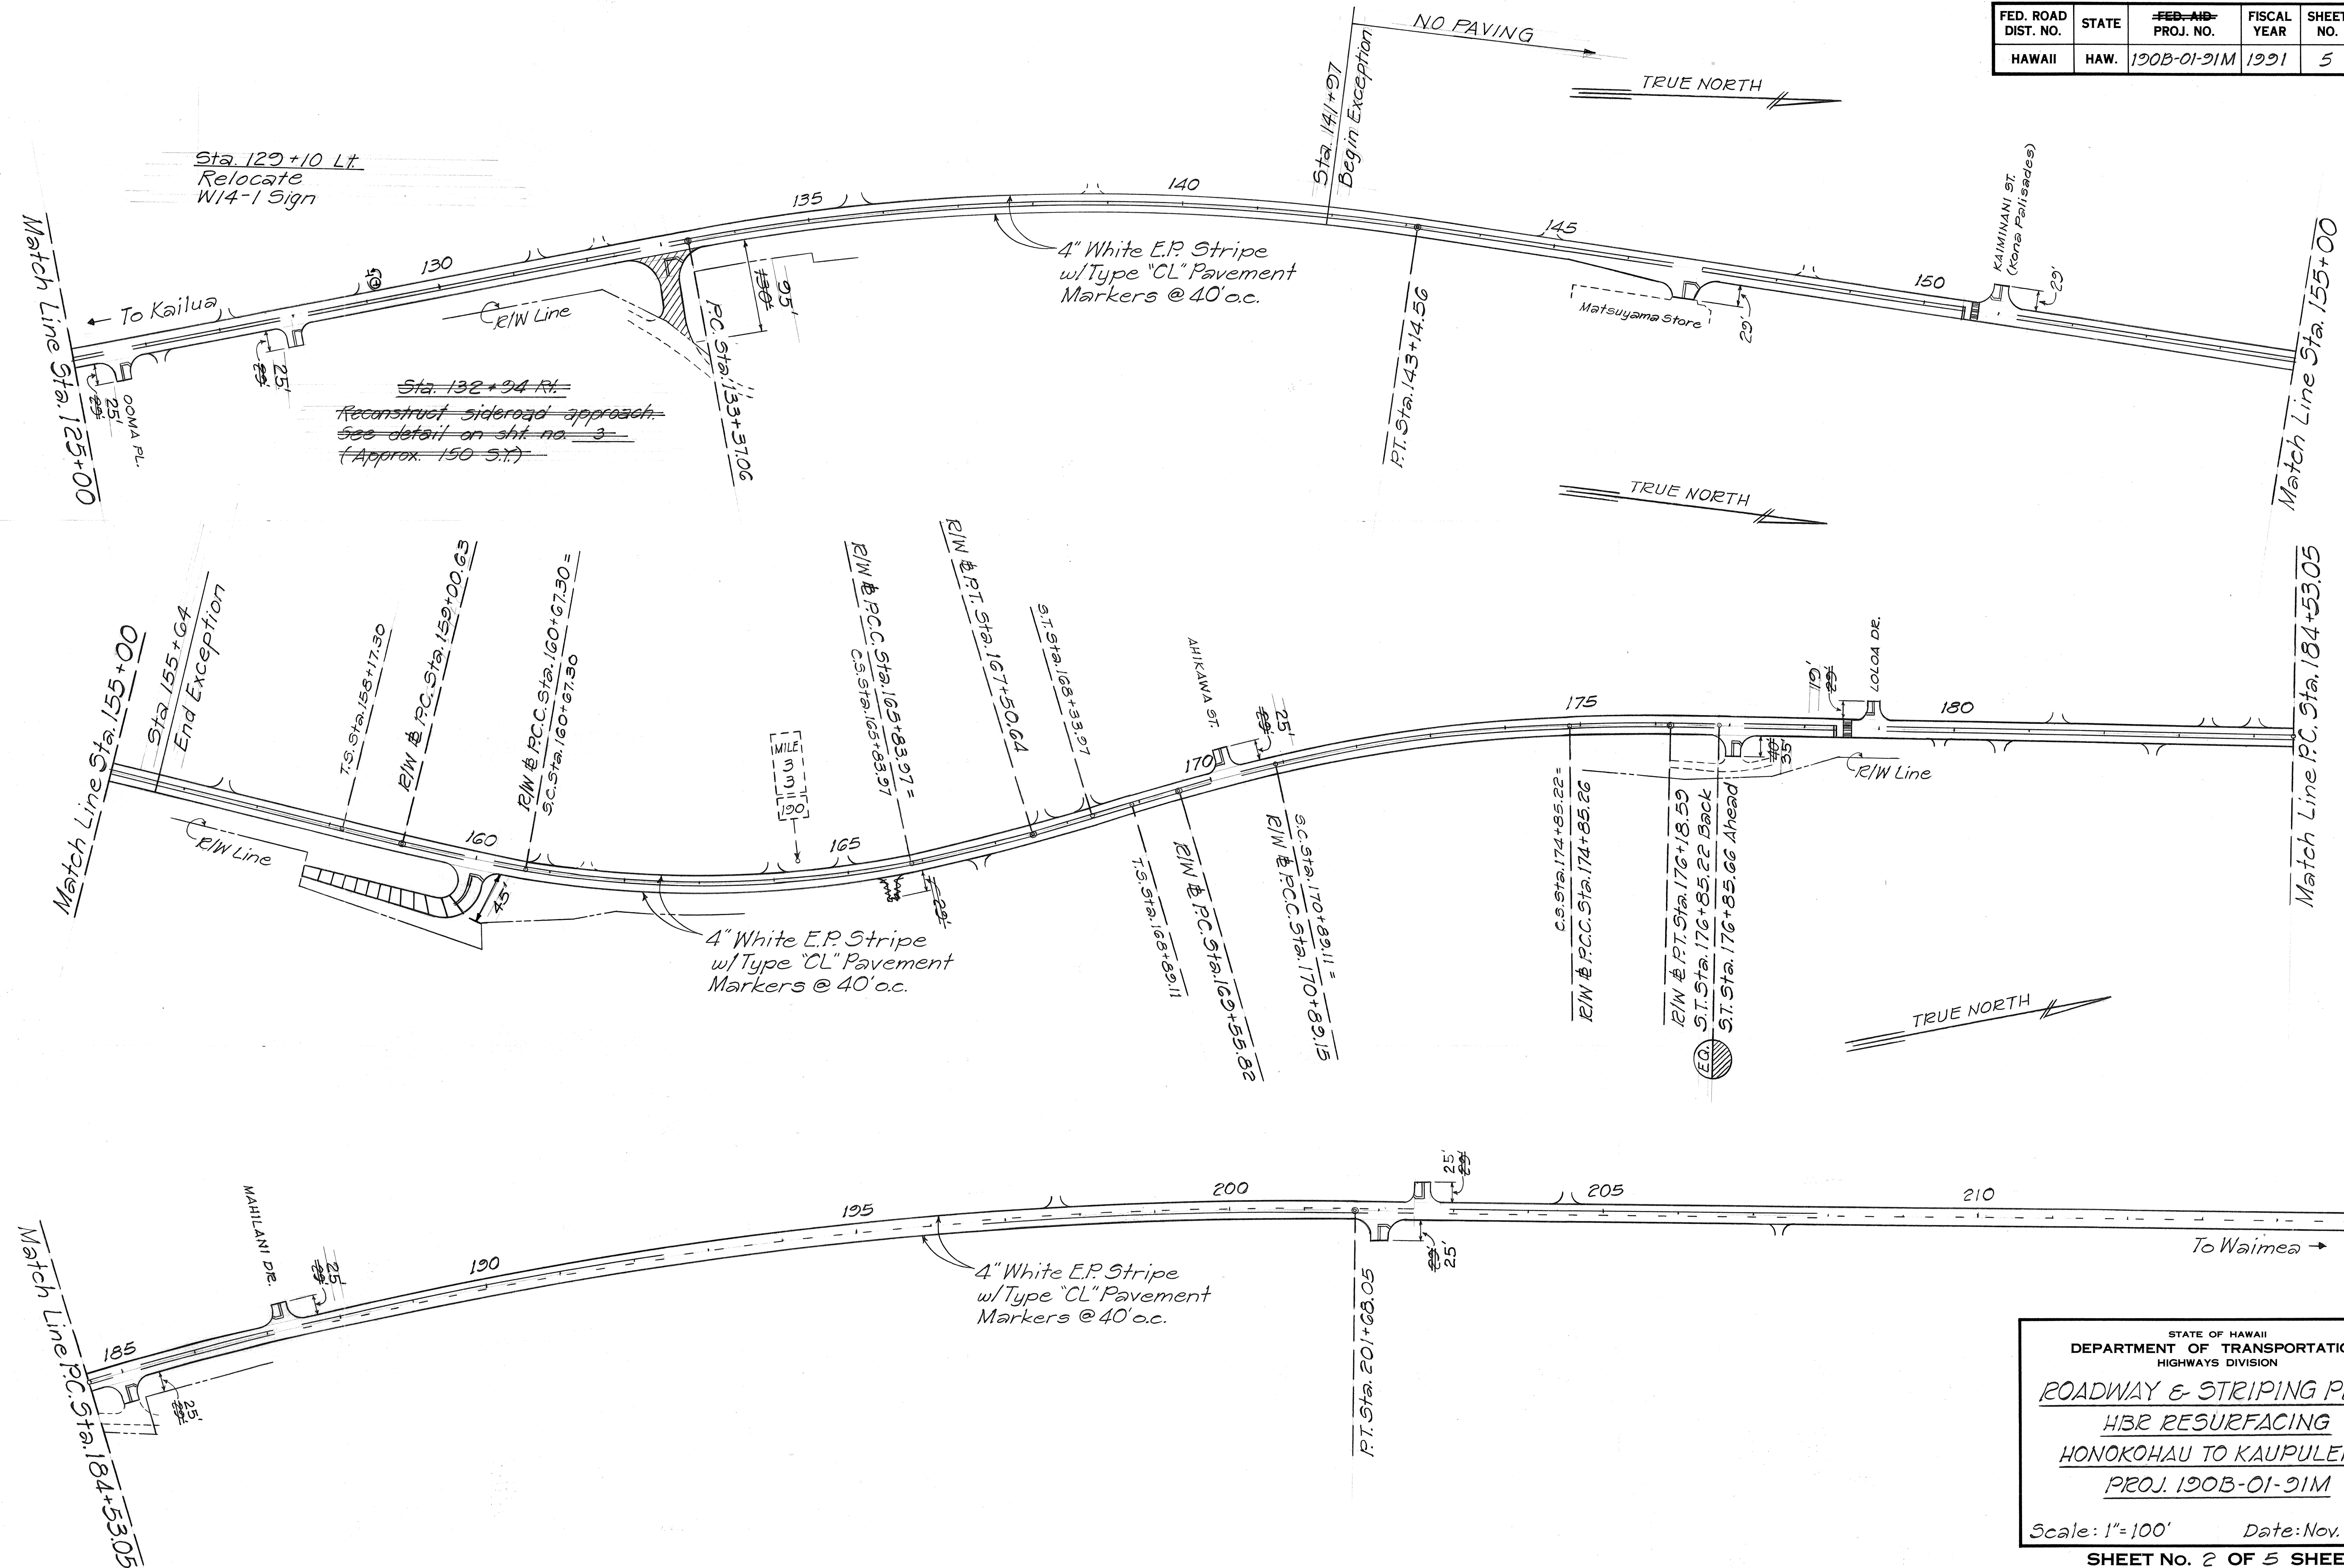

ORIGINAL PLAN	DATE
DRAWN BY	
DESIGNED BY	
CHECKED BY	
NO. 1574	

STATE OF HAWAII  
DEPARTMENT OF TRANSPORTATION  
HIGHWAYS DIVISION


**ROADWAY & STRIPING PLAN**  
**HBR RESURFACING**  
**HONOKOHAU TO KAUPULEHU**  
**PROJ. 190B-01-21M**

Scale: 1"=100'      Date: Nov. 1990

**SHEET NO. 2 OF 5 SHEETS**



FED. ROAD DIST. NO.	STATE	FED. AID PROJ. NO.	FISCAL YEAR	SHEET NO.	TOTAL SHEETS
HAWAII	HAW.	190B-01-21M	1991	6	10

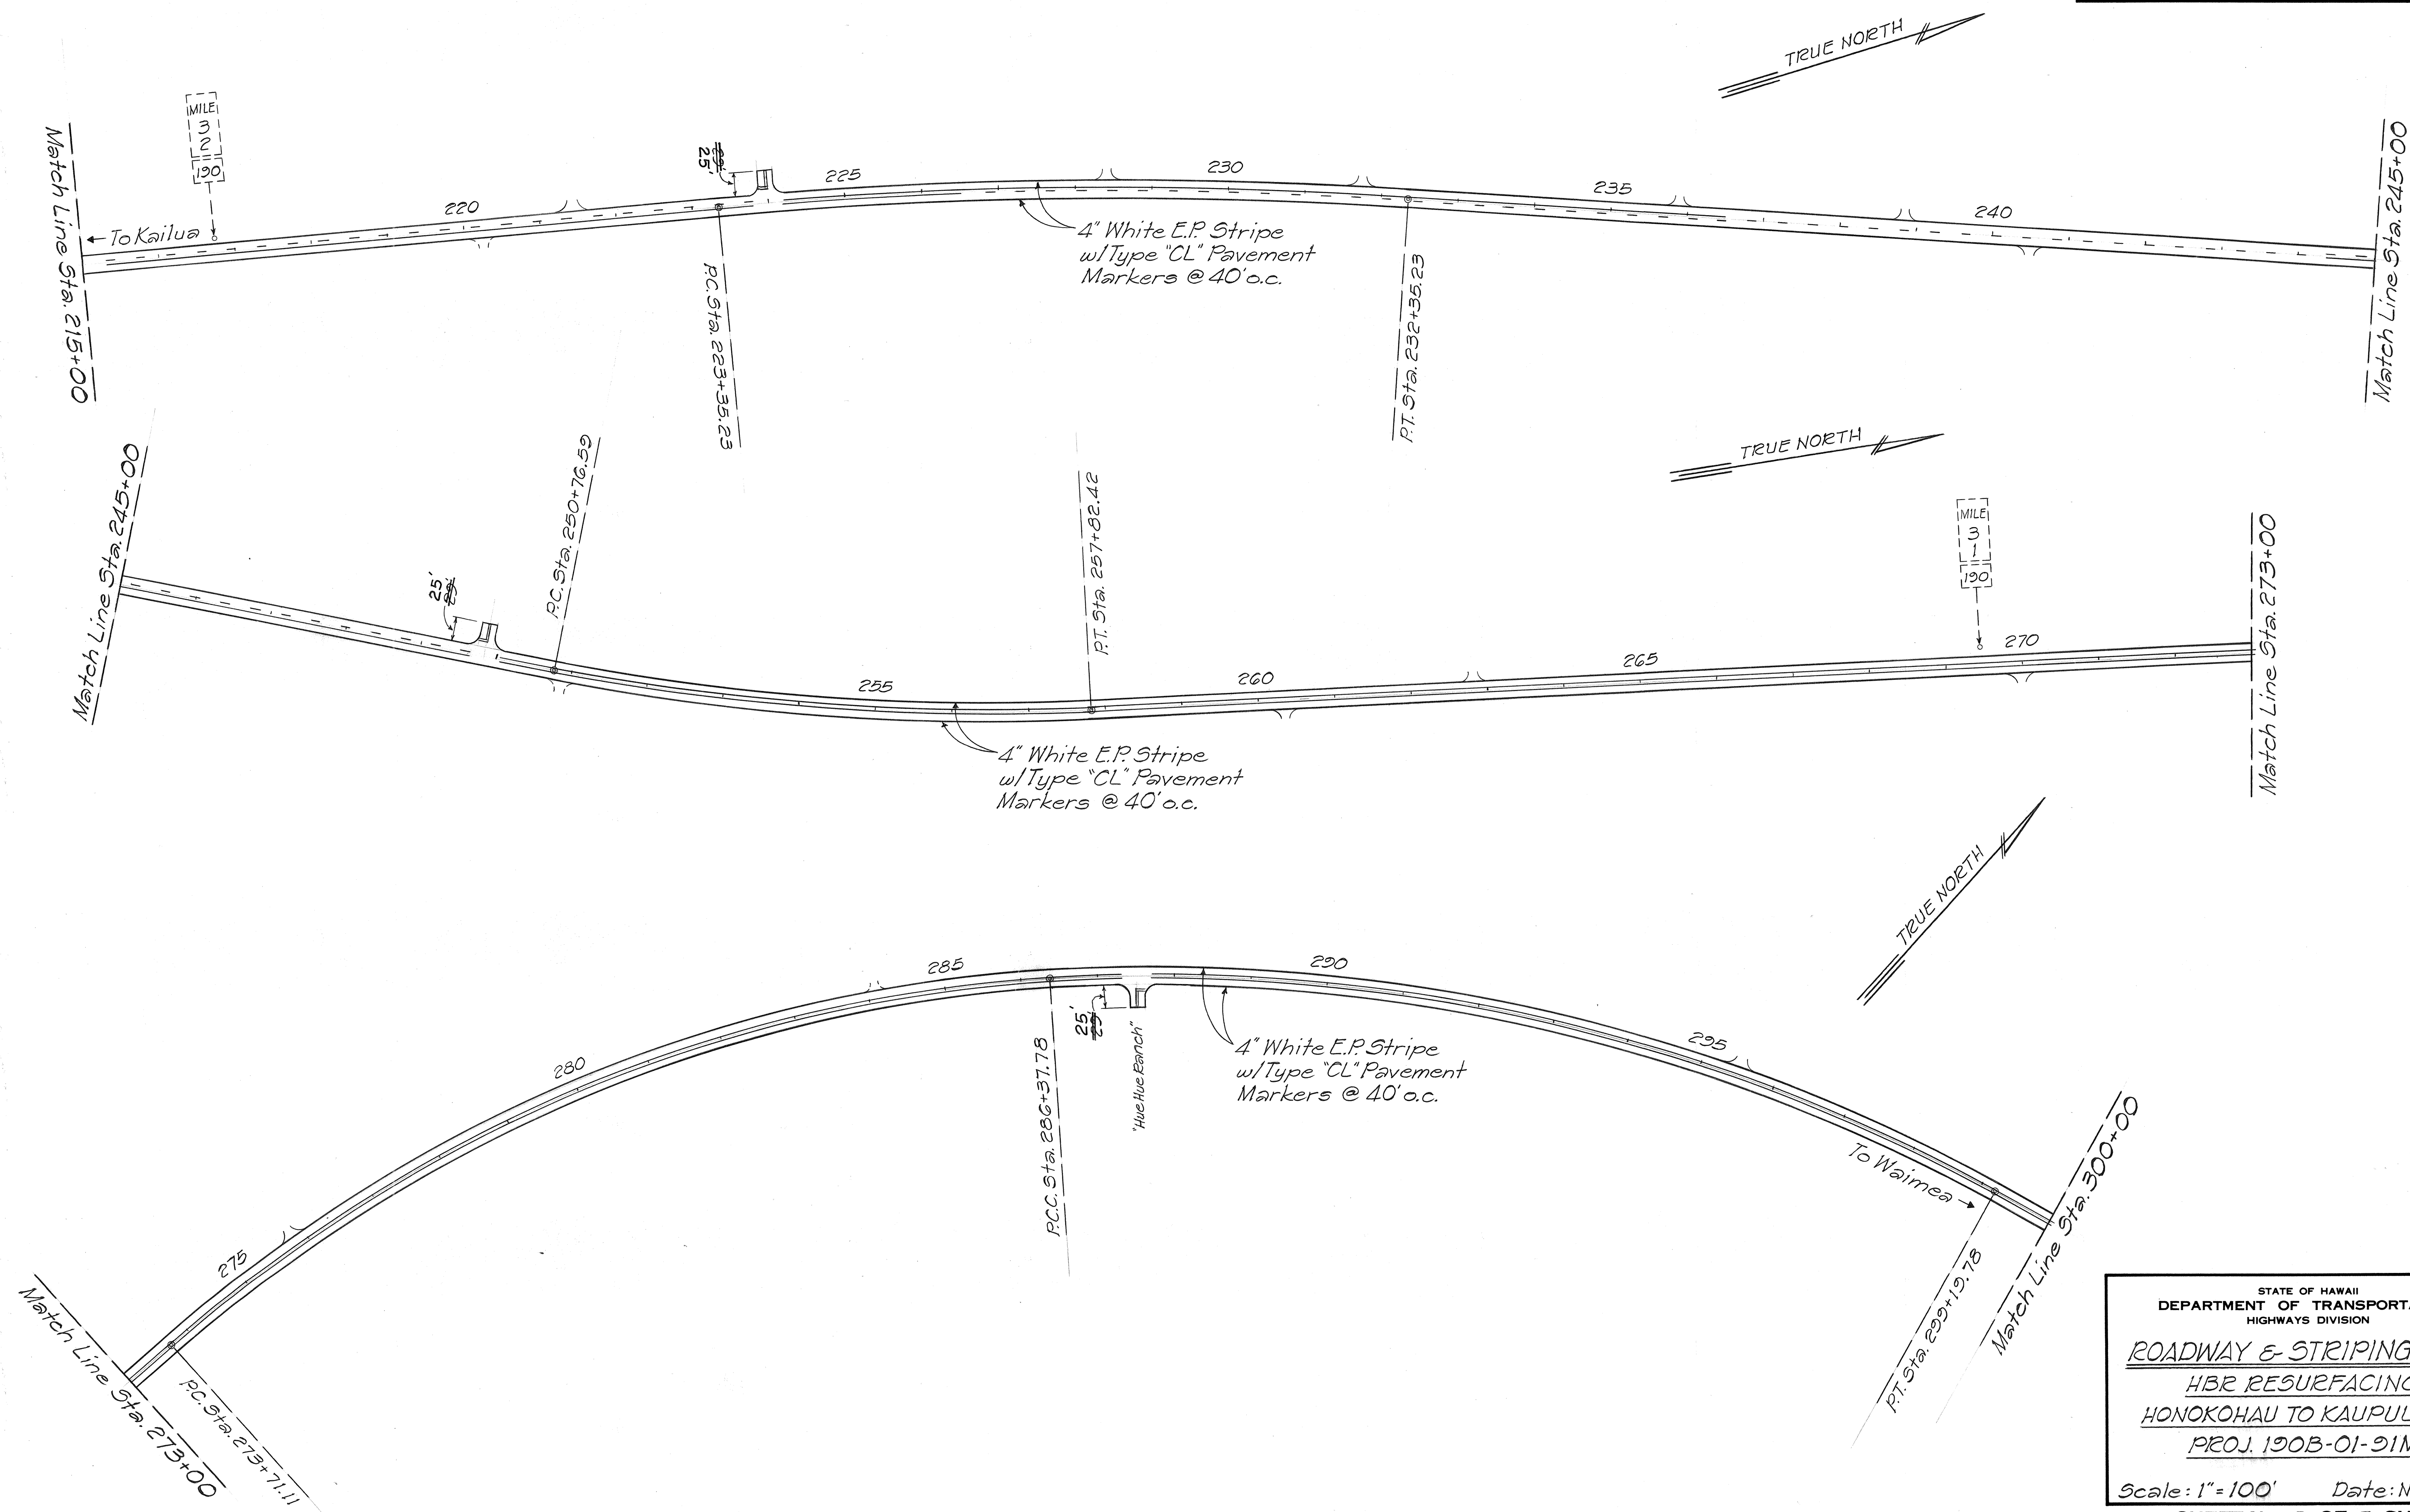


STATE OF HAWAII  
DEPARTMENT OF TRANSPORTATION  
HIGHWAYS DIVISION

**ROADWAY & STRIPING PLAN**  
HBR RESURFACING  
HONOKOHAU TO KAUPULEHU  
PROJ. 190B-01-21M

Scale: 1" = 100' Date: Nov. 1990  
SHEET NO. 3 OF 5 SHEETS

ORIGINAL PLAN	SURVEY PLOTTED BY	DATE
NOTE BOOK	DRAWN BY	
No. 1374	DESIGNED BY	
	CHECKED BY	

FED. ROAD DIST. NO.	STATE	<del>FED. AID</del> PROJ. NO.	FISCAL YEAR	SHEET NO.	TOTAL SHEETS
HAWAII	HAW.	190B-01-91M	1991	7	10

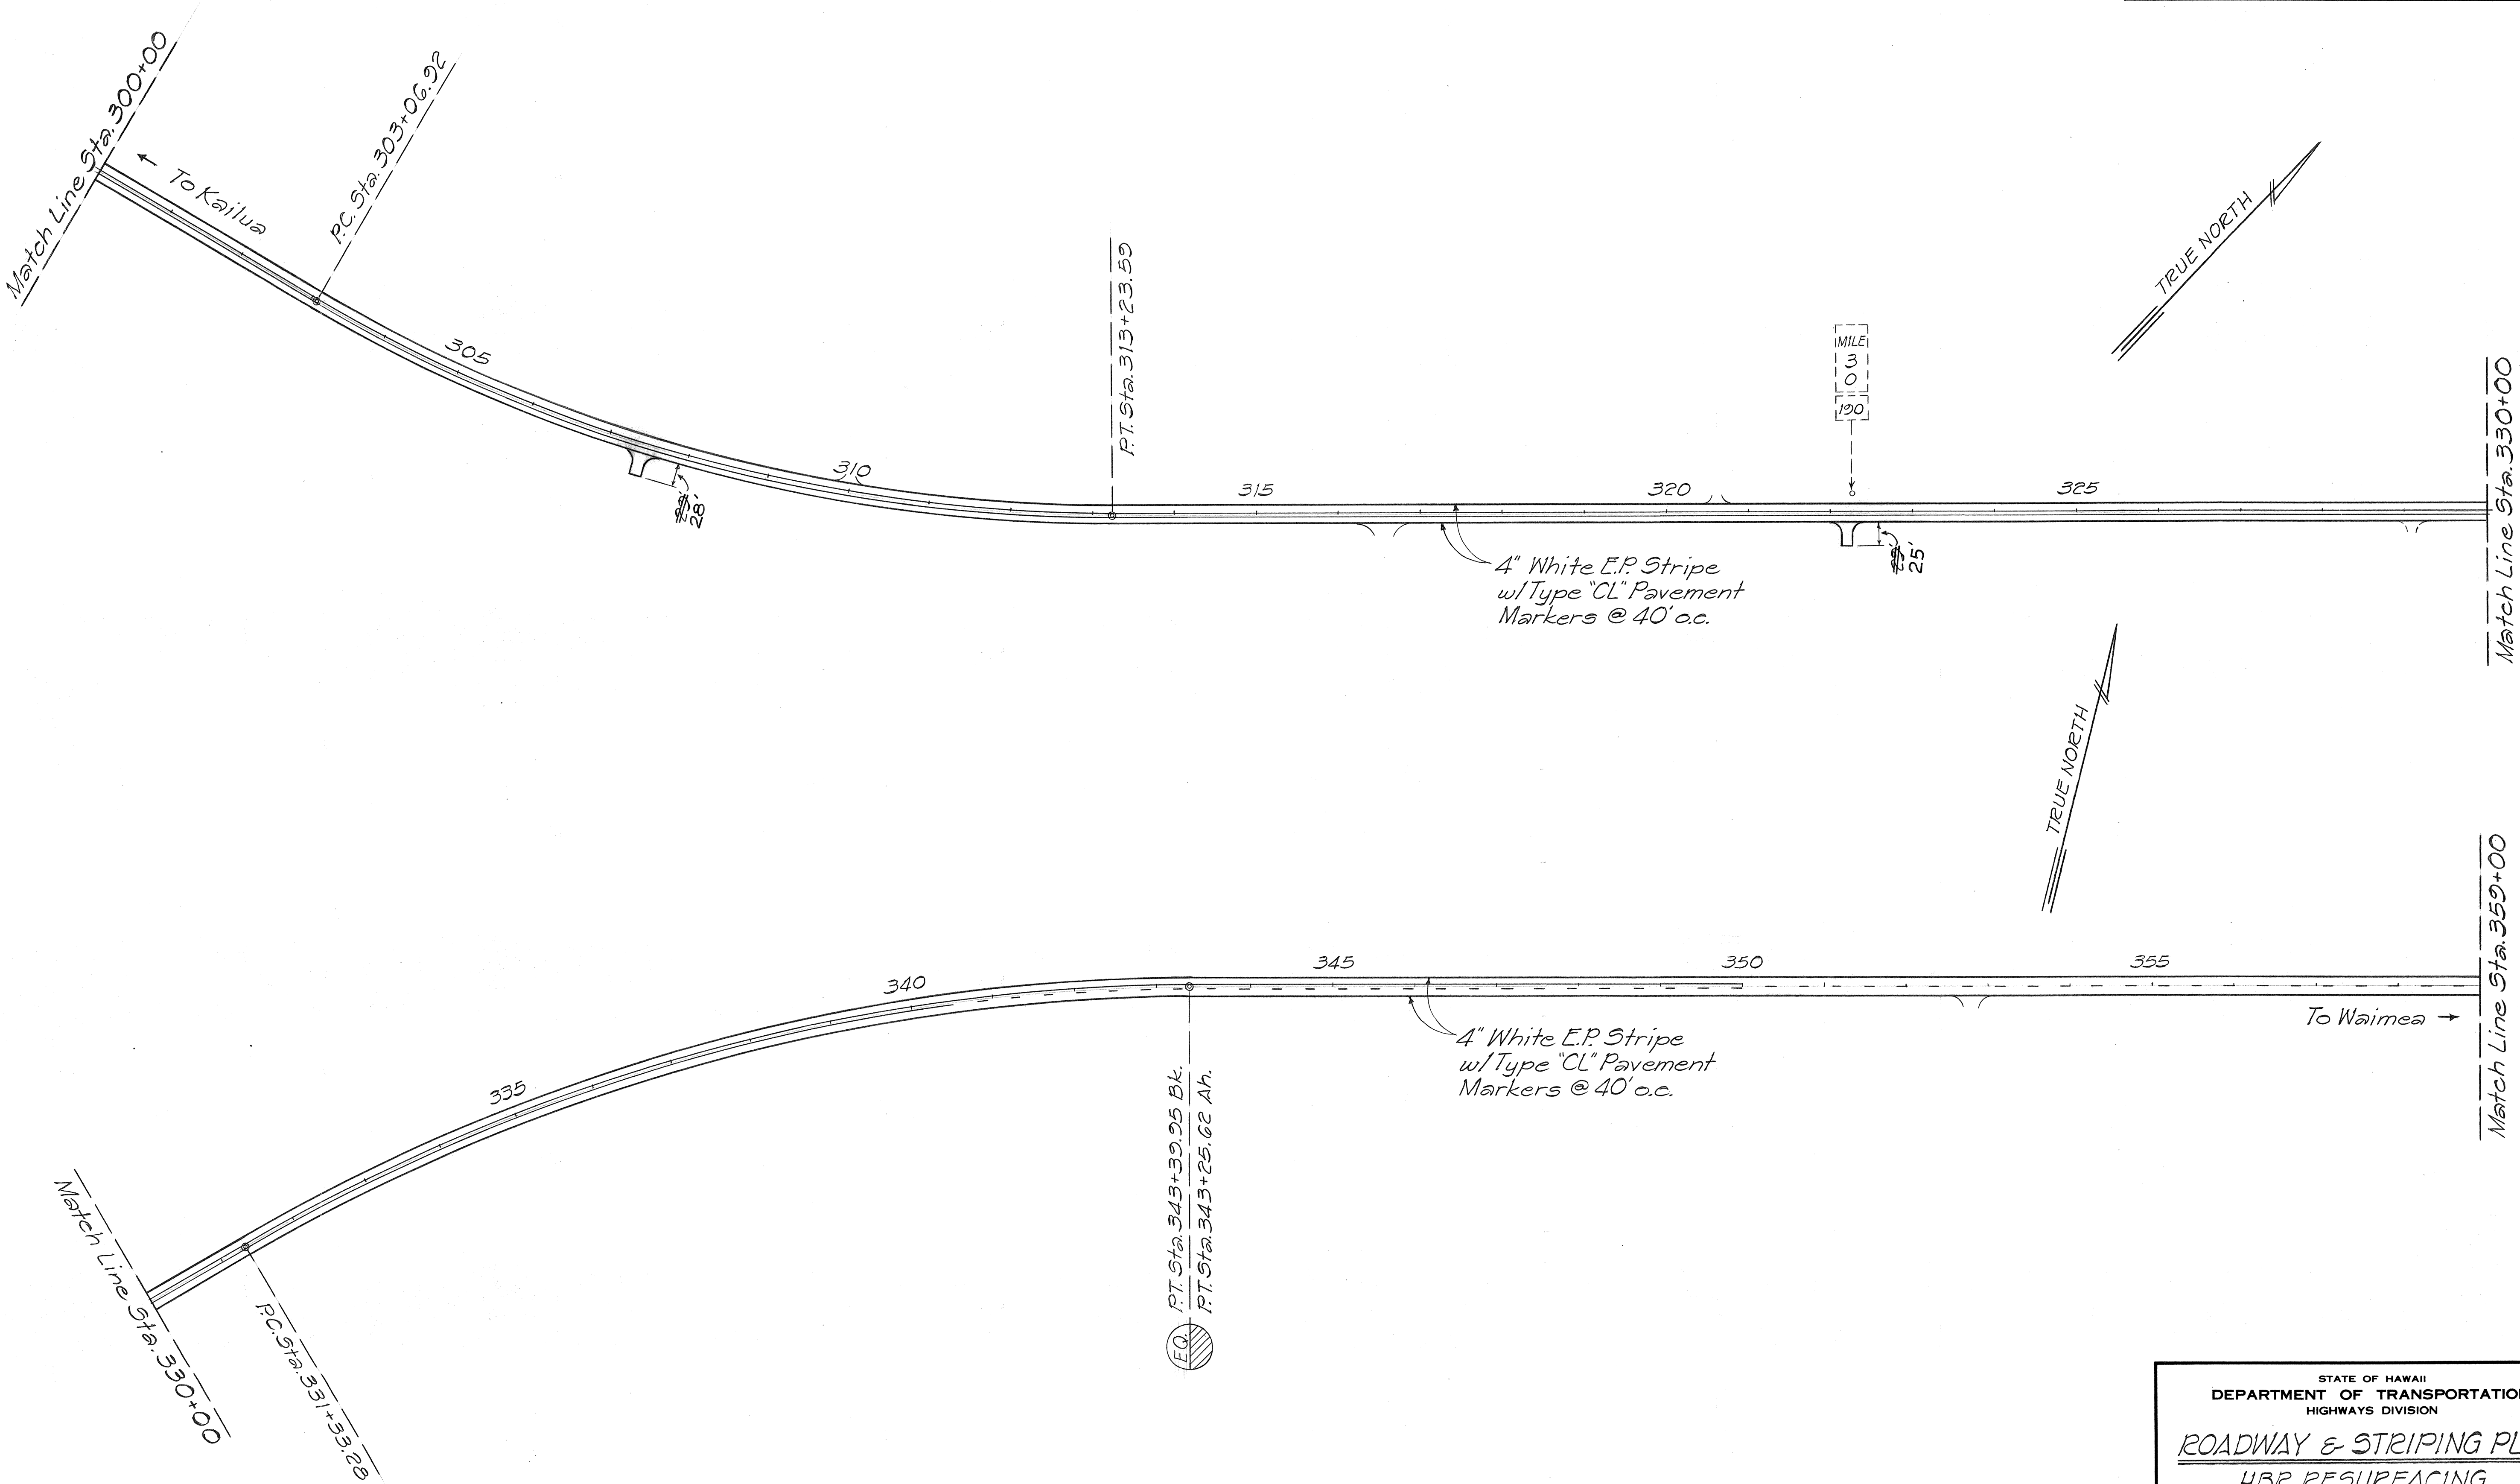

ORIGINAL PLAN	SURVEY PLOTTED BY _____	DATE _____
NOTE BOOK	DRAWN BY _____	" _____
	DESIGNED BY _____	" _____
	QUANTITIES BY _____	" _____
	CHECKED BY _____	" _____
No. <u>1374</u>		


STATE OF HAWAII  
DEPARTMENT OF TRANSPORTATION  
HIGHWAYS DIVISION

ROADWAY & STRIPING PLAN  
HBR RESURFACING  
HONOKOHAU TO KAUPULEHU  
PROJ. 190B-01-91M

Scale: 1"=100'      Date: Nov. 1990

**SHEET NO. 4 OF 5 SHEETS**

FED. ROAD DIST. NO.	STATE	FED. AID PROJ. NO.	FISCAL YEAR	SHEET NO.	TOTAL SHEETS
HAWAII	HAW.	190B-01-21M	1991	8	10

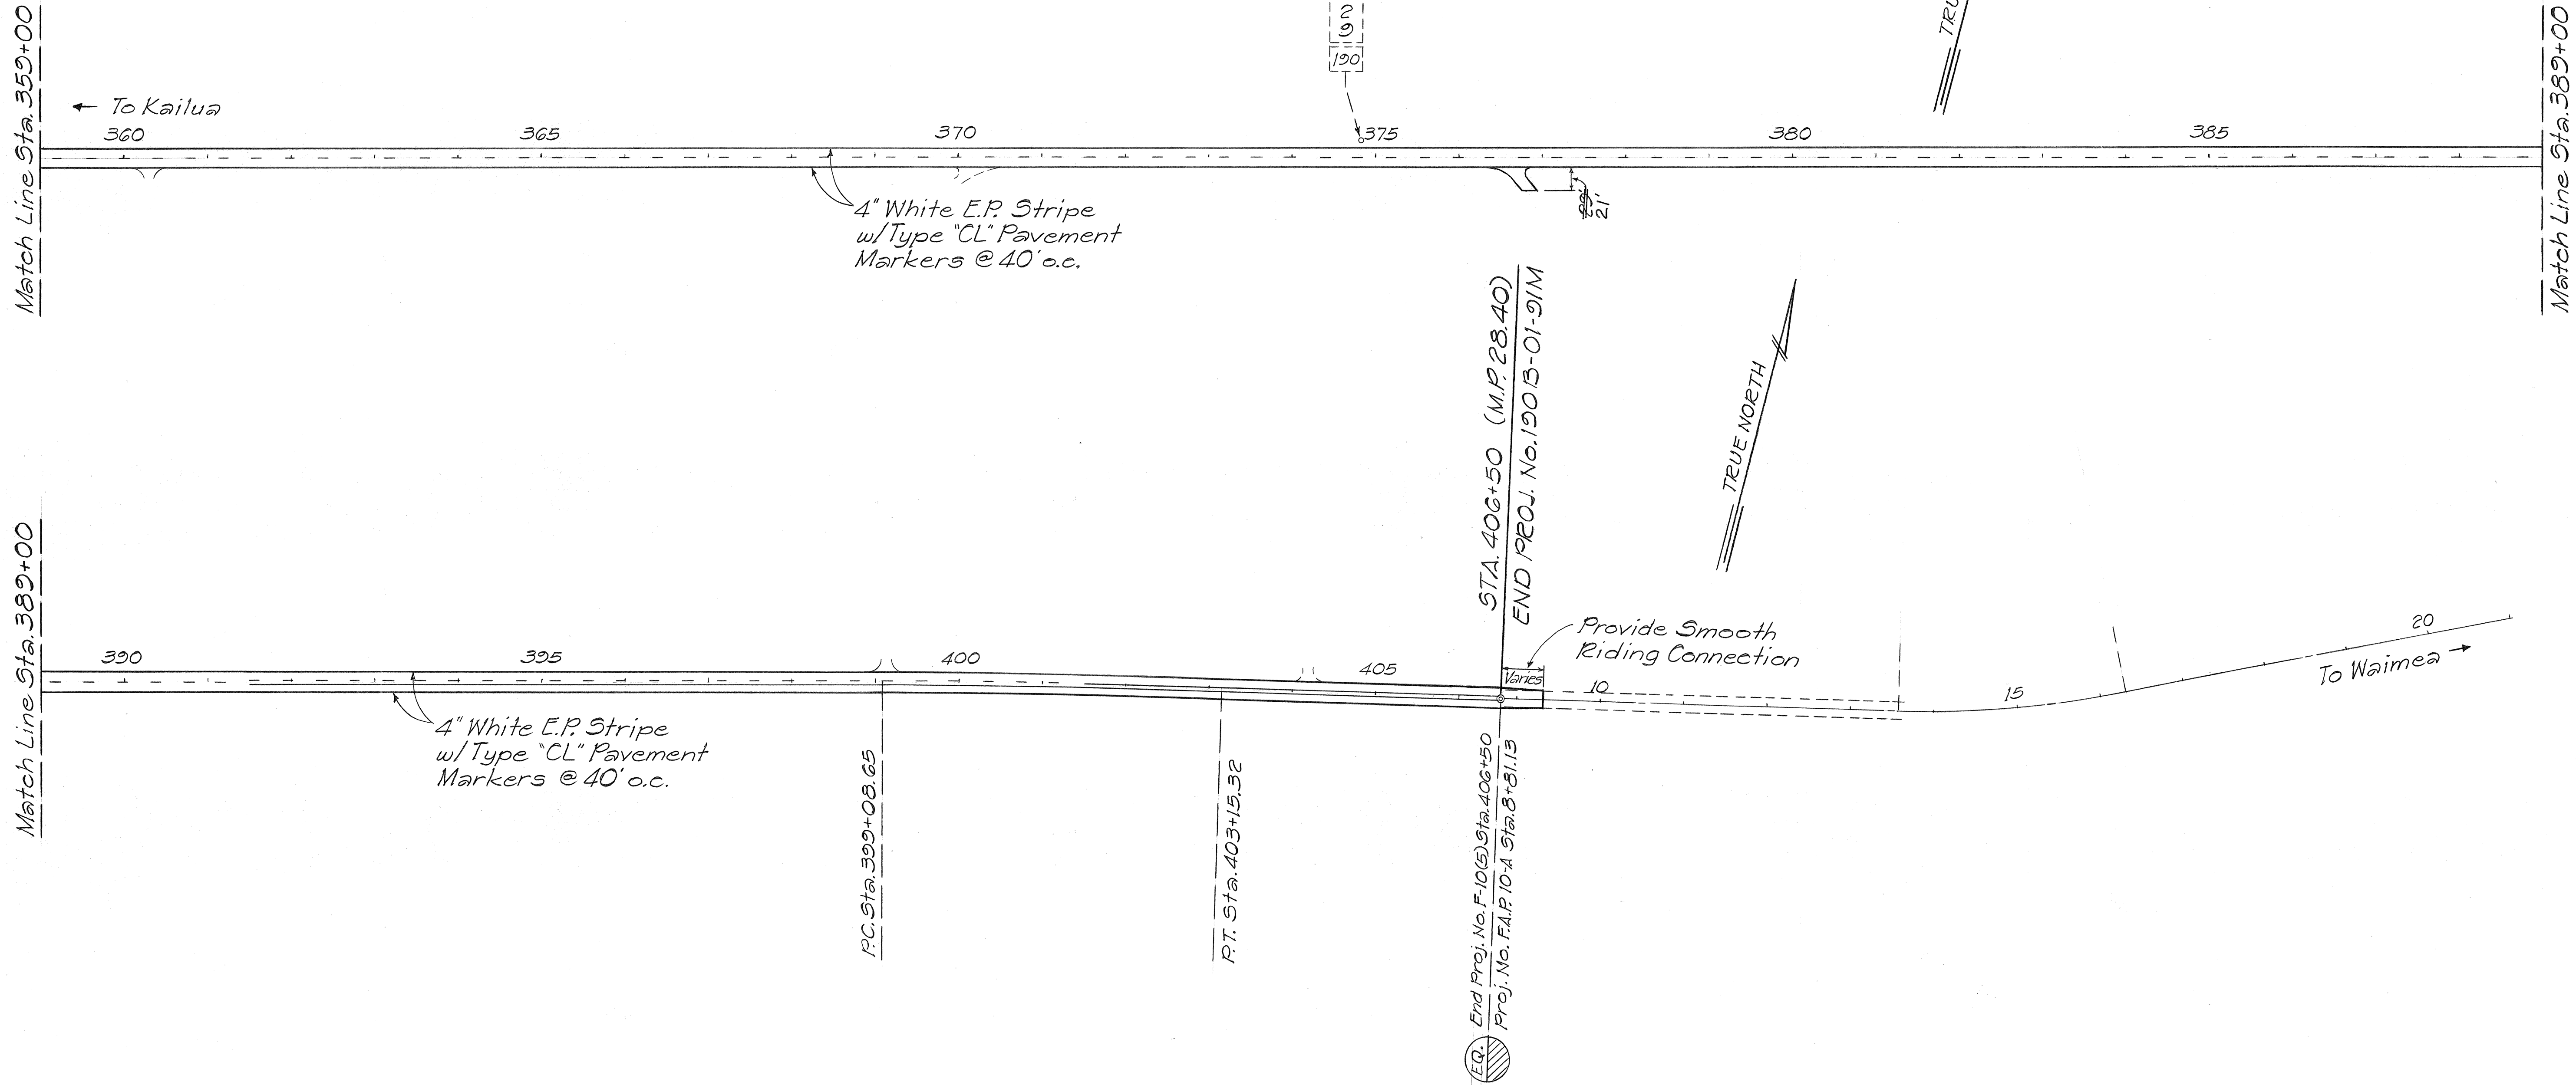

ORIGINAL PLAN	SURVEY PLOTTED BY	DATE
NOTE BOOK	DRAWN BY	
No. 1374	DESIGNED BY	
	CHECKED BY	

STATE OF HAWAII  
DEPARTMENT OF TRANSPORTATION  
HIGHWAYS DIVISION

**ROADWAY & STRIPING PLAN**  
**HBR RESURFACING**  
**HONOKOHAU TO KAUPULEHU**  
**PROJ. 190B-01-21M**

Scale: 1"=100'      Date: Nov. 1990

**SHEET NO. 5 OF 5 SHEETS**