

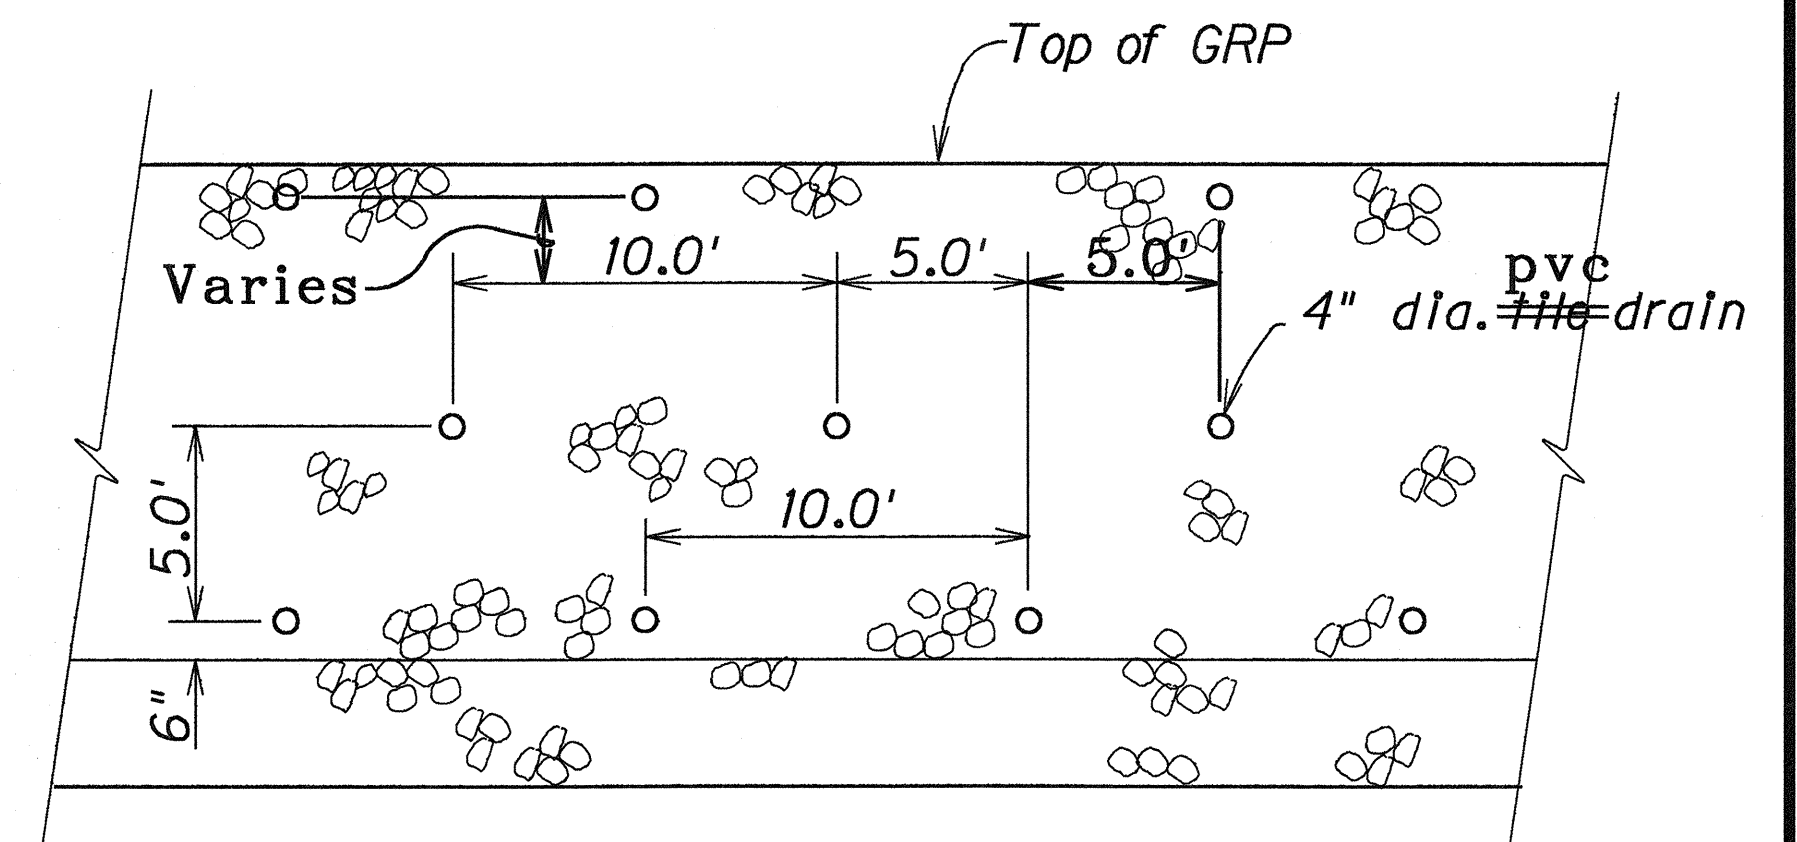
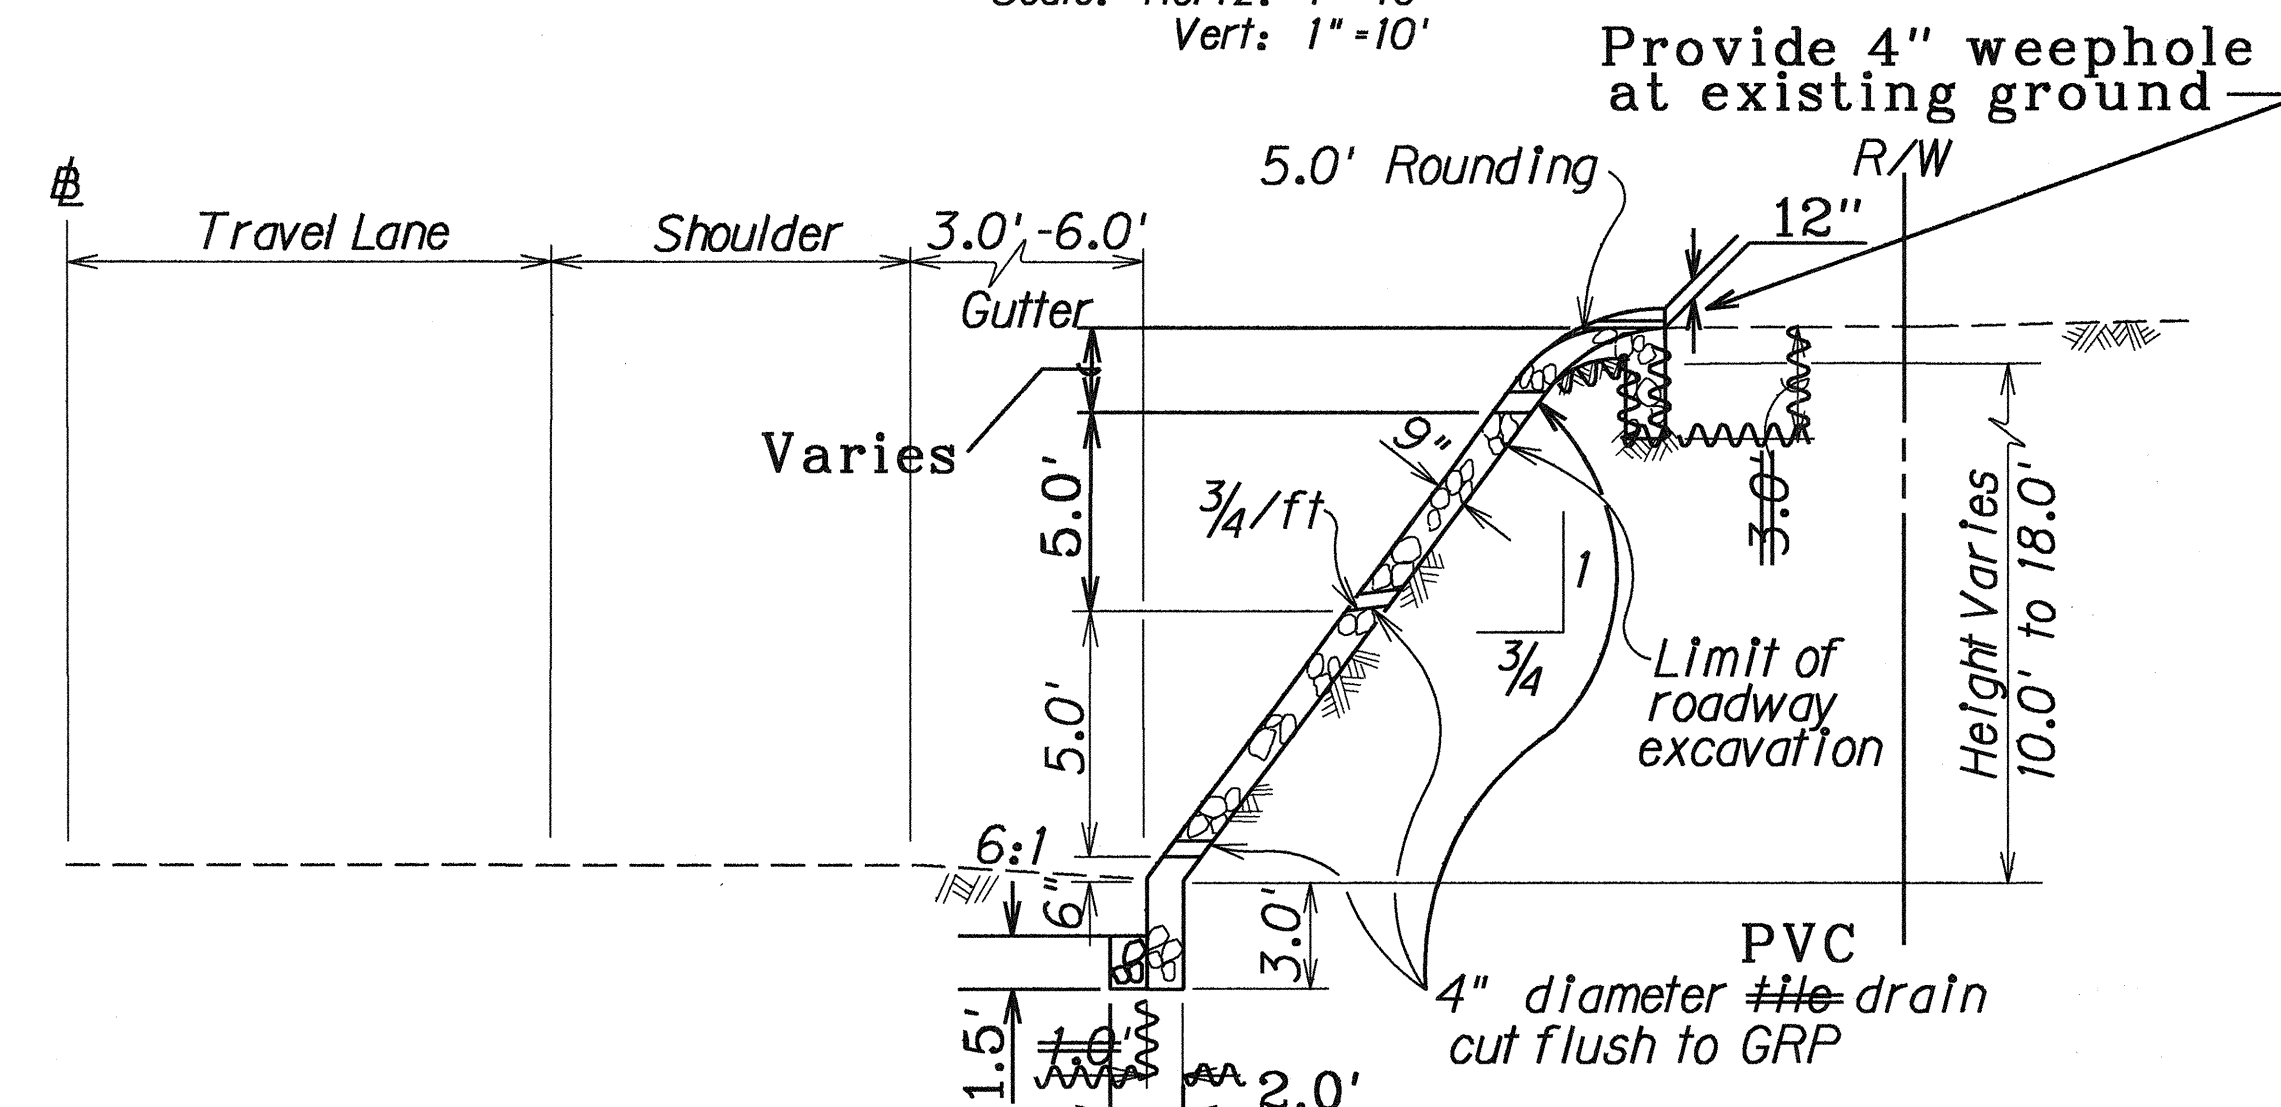
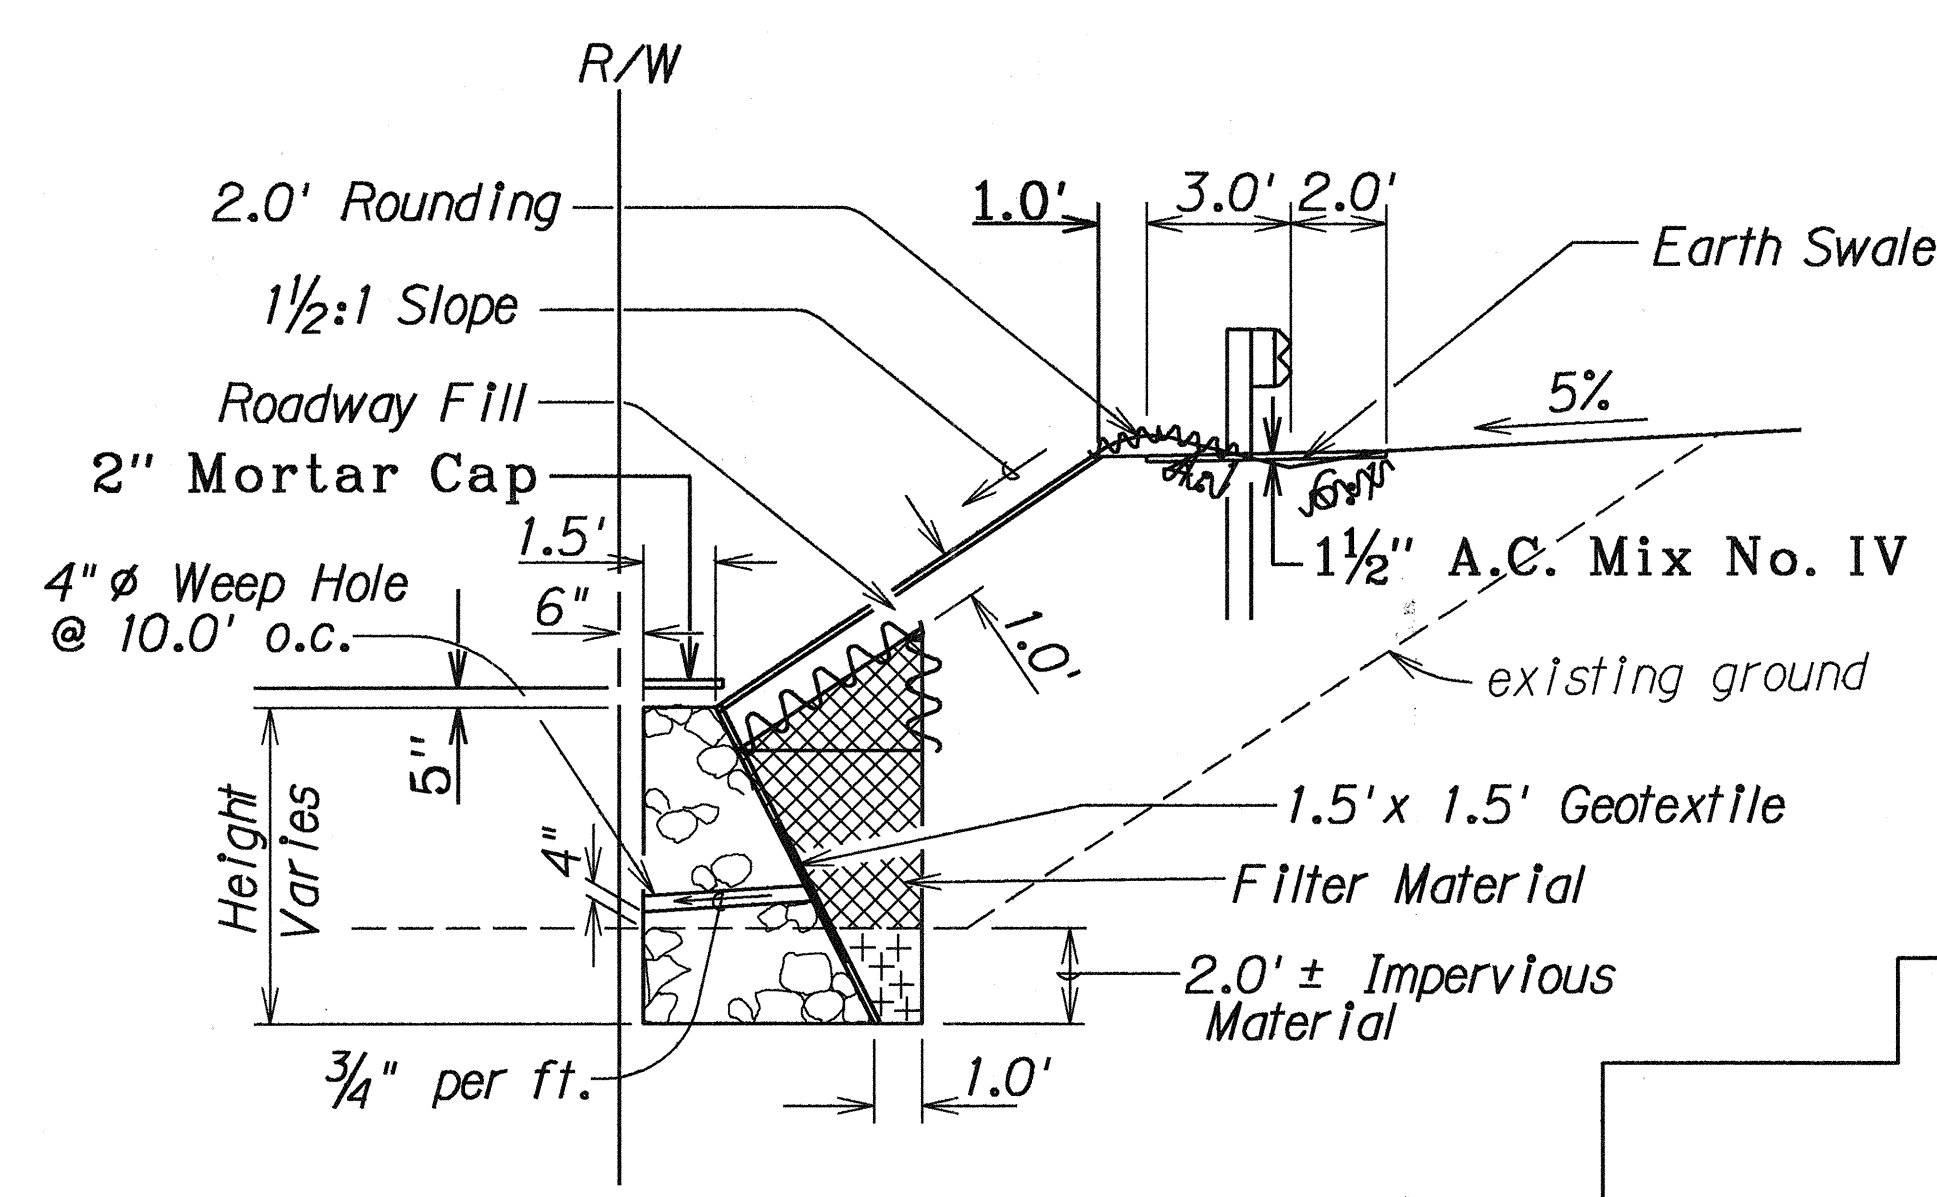


FED. ROAD DIST. NO.	STATE	PROJ. NO.	FISCAL YEAR	SHEET NO.	TOTAL SHEETS
HAWAII	HAW.	190B-02-91	1992	8	13

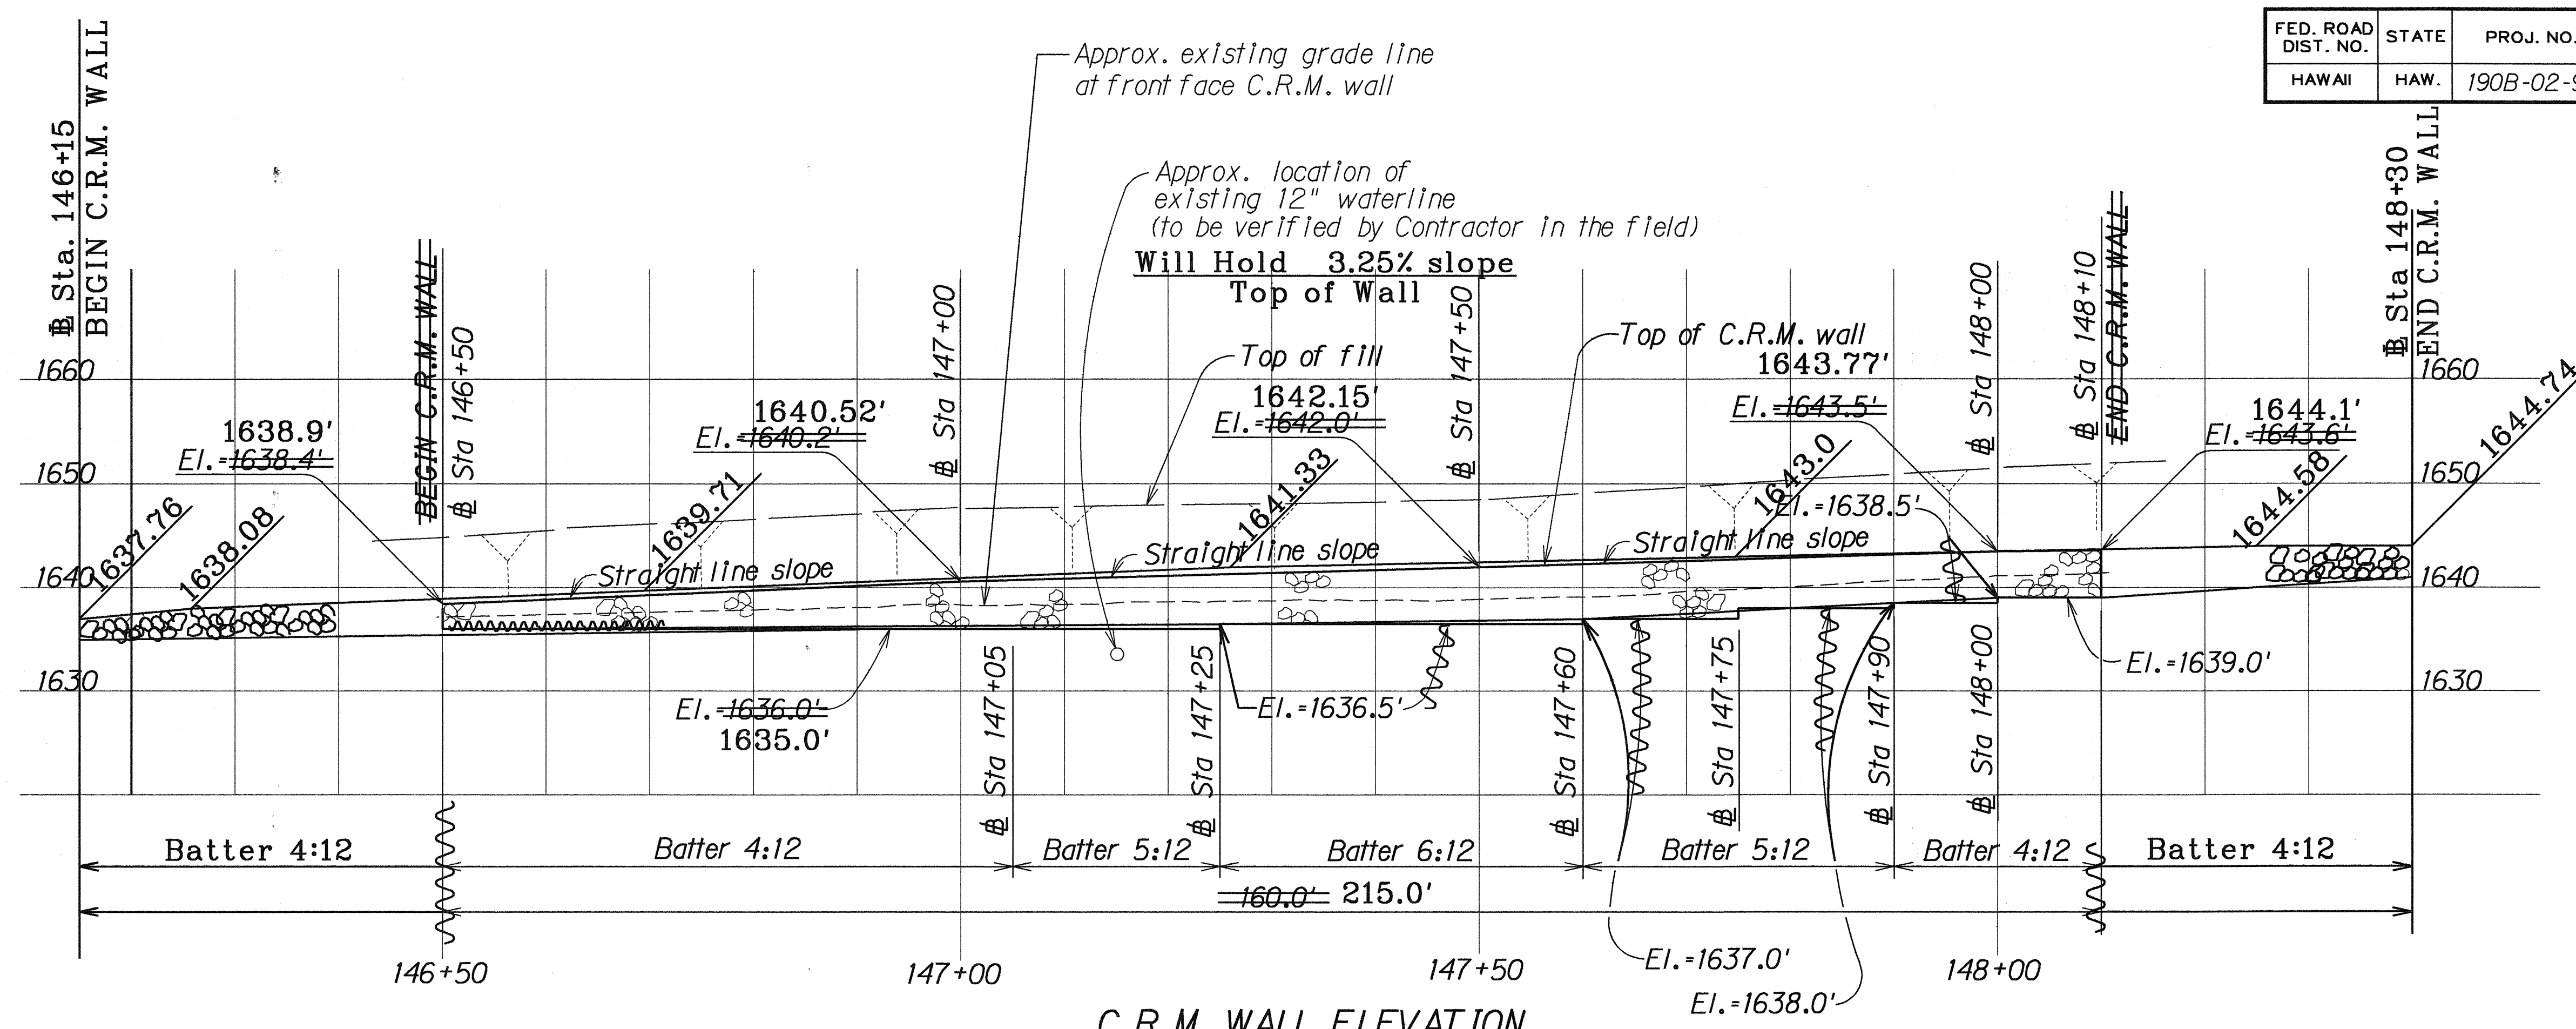

LEGEND FOR AS-BUILT POSTINGS	
	Squiggly line for as-built deletion
	Double line for as-built deletion
Roadway	Text for as-built posting

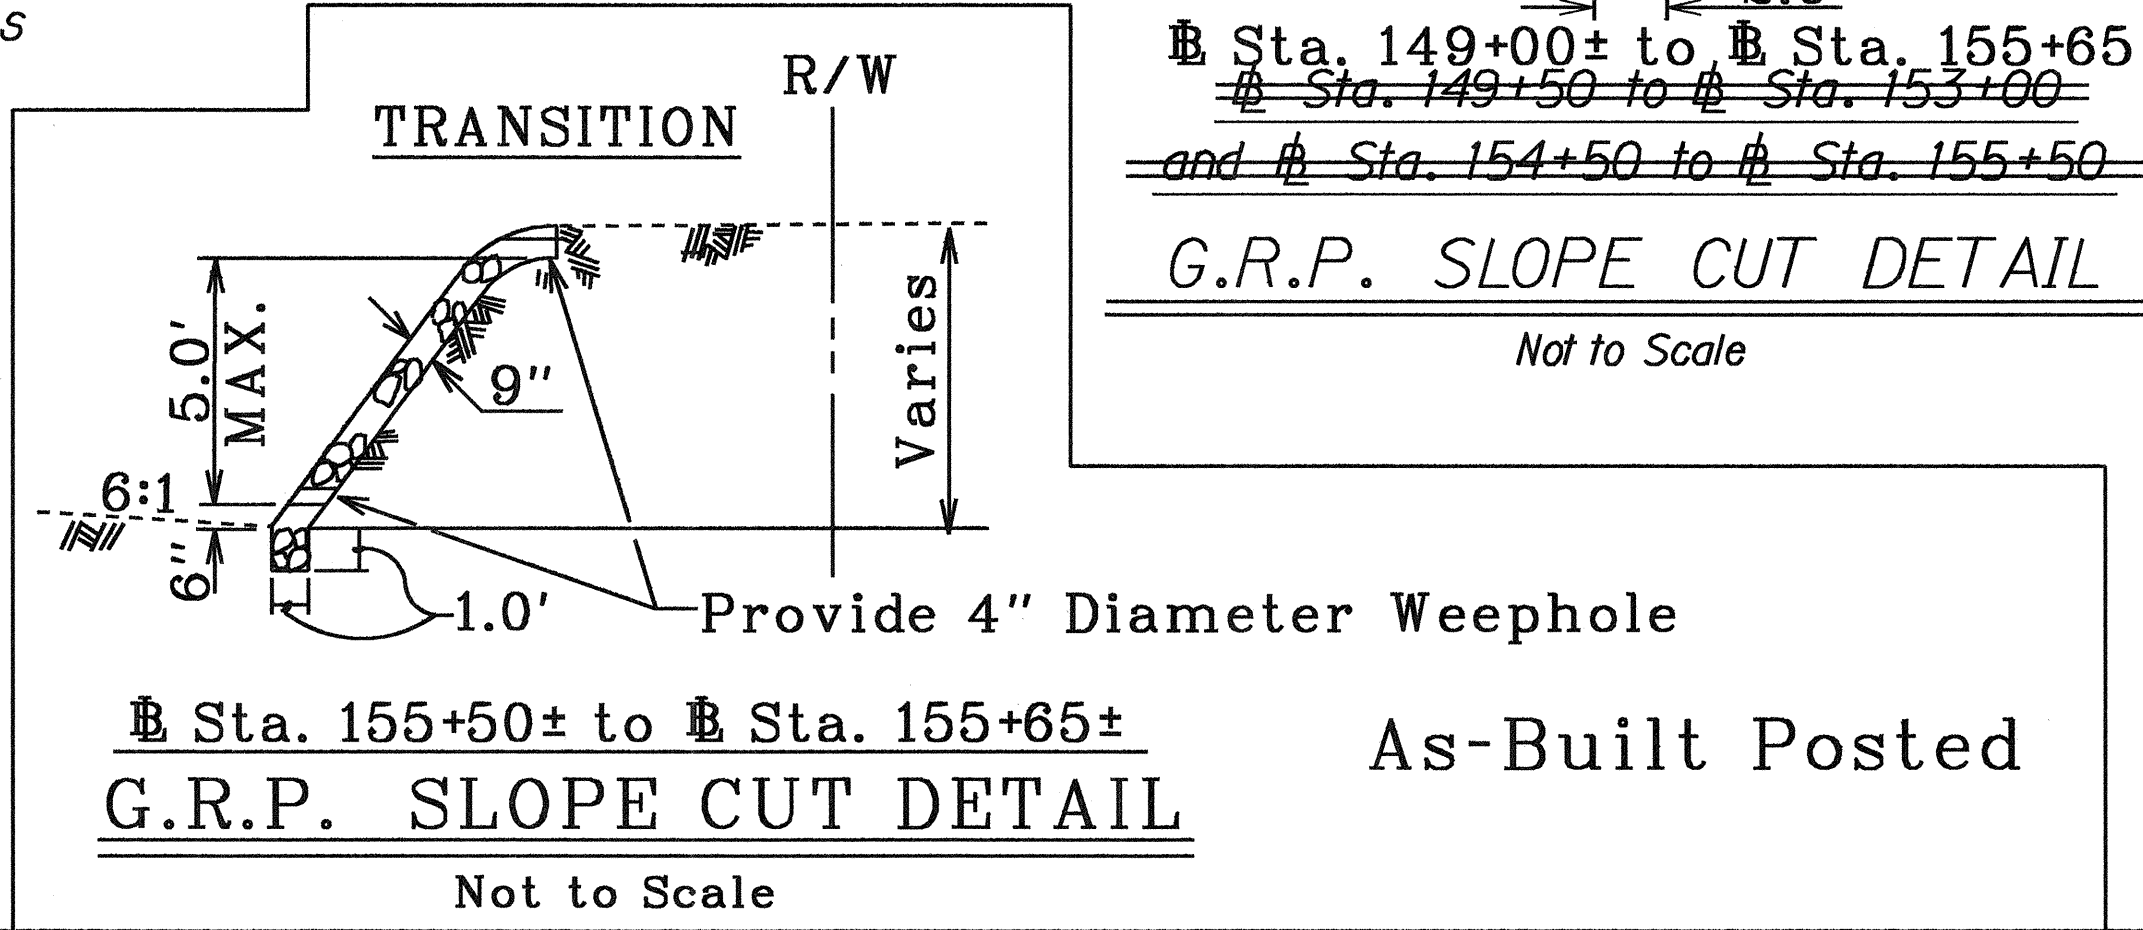

STATE OF HAWAII
 DEPARTMENT OF TRANSPORTATION
 HIGHWAYS DIVISION

MISCELLANEOUS DETAILS

MAMALAHOA HIGHWAY INTERSECTION
 Improvements at Matsuyama Store
 and Kona Palisades Subdivision
 Project No. 190B-02-91

Scale: As Shown Date: Jan, 1992
 SHEET No. 1 OF 1 SHEETS

ORIGINAL PLANNED BY: DATE: _____
 DRAWN BY: _____
 CHECKED BY: _____
 NOTED BY: _____
 DESIGNED BY: _____
 QUANTITIES BY: _____
 APPROVED BY: _____