	INDEX TO DRAWINGS
SHEET NO.	DESCRIPTION
l	TITLE SHEET
2	STANDARD PLANS SUMMARY
√3	TYPICAL SECTION &
	GENERAL NOTES
4	ROADWAY PLAN
5	UTILITY PLAN
6 - 7	WATER NOTES, DETAILS
8	MISCELLANEOUS DETAILS
9 - 10	TRAFFIC DETAILS, SUMMARIES
	& PAVEMENT MARKING PLAN
11 – 13	CROSS - SECTIONS
3 4	
	·

STATE OF HAWAII

DEPARTMENT OF TRANSPORTATION

HIGHWAYS DIVISION HONOLULU, HAWAII

"AS-BUILT"
PLANS FOR


MAMALAHOA HIGHWAY


INTERSECTION IMPROVEMENTS
AT MATSUYAMA STORE
AND KONA PALISADES SUBDIVISION

PROJECT NO. 190B-02-91

DISTRICT OF NORTH KONA

ISLAND OF HAWAII

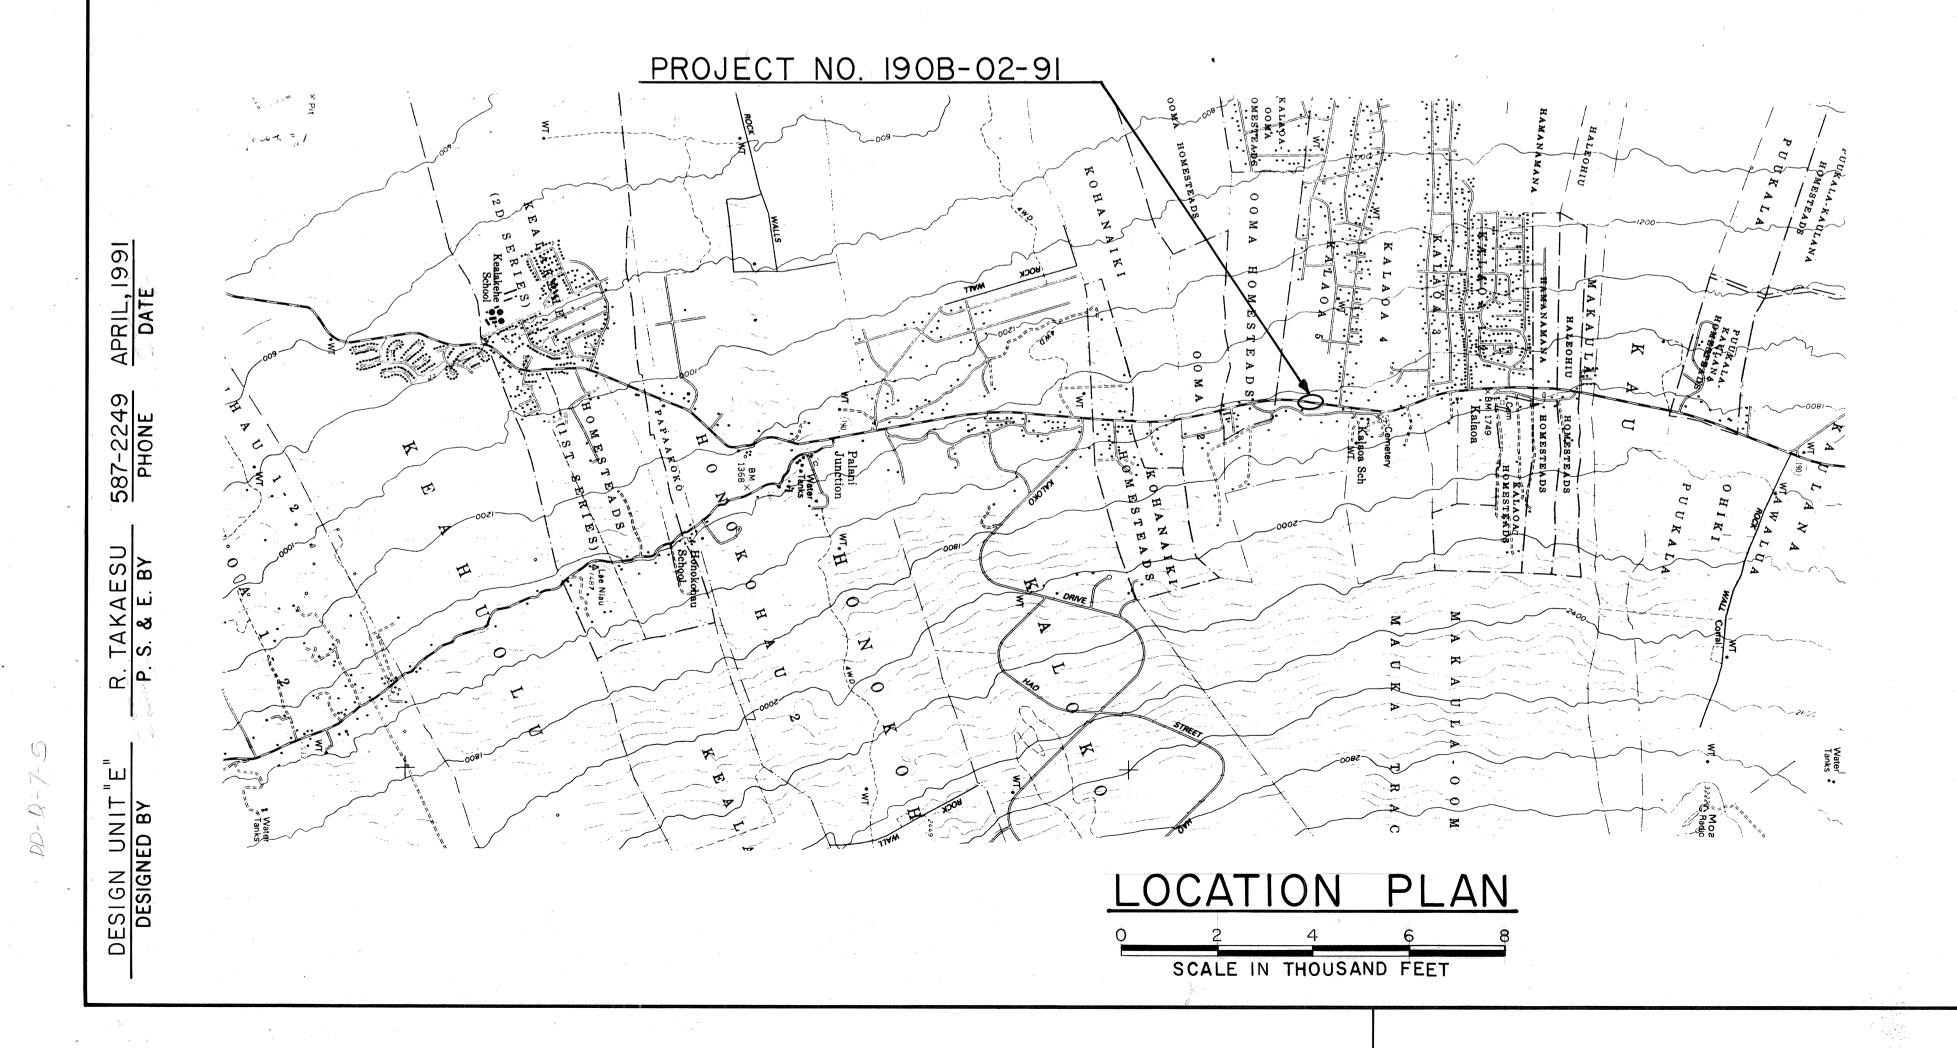

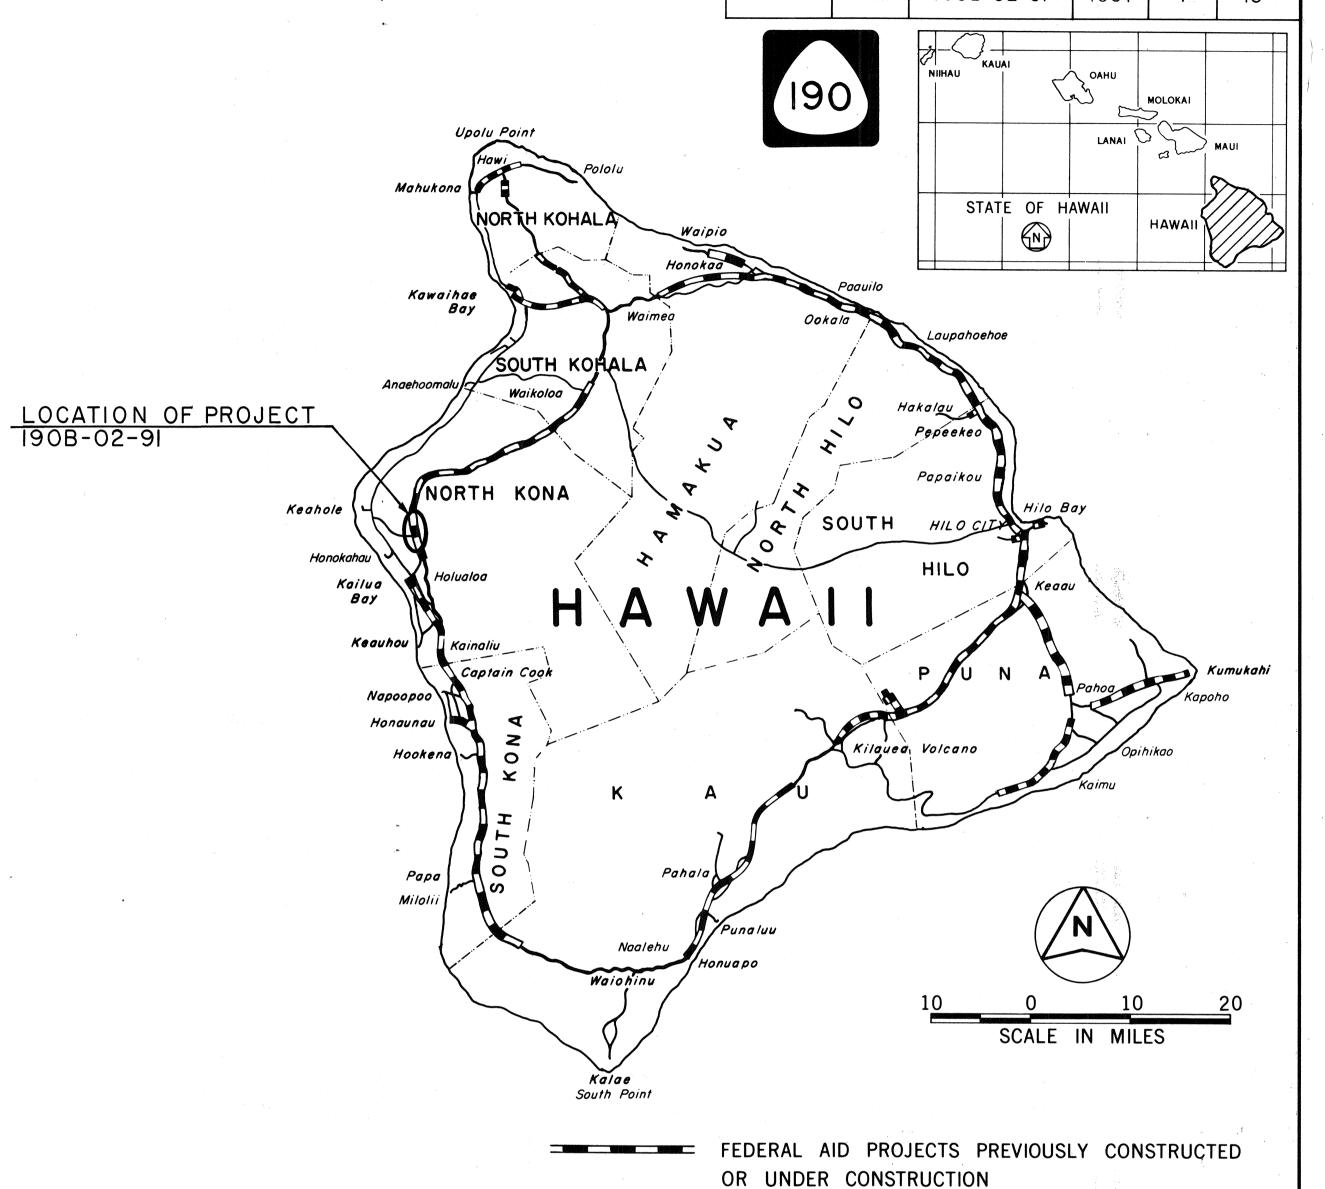

FED. ROAD DIST. NO.

STATE

PROJ. NO.

SHEET TOTAL NO. SHEETS

CHANGES MADE DURING CONSTRUCTION HAVE BEEN INCORPORATED ON THESE PLANS EXCEPT CHANGES IN THE ORIGINAL THEORETICAL QUANTITIES, FOR ACTUAL QUANTITIES, REFER TO PROJECT LEDGER AND/OR COMPUTATION BOOK.

RESIDENT ENGINEER

10-8-93 DATE

MILE POST 31.99 TO MILE POST 32.25

DEPARTMENT OF TRANSPORTATION
STATE OF HAWAII

APPROVED:

Stelling A. Monkowa 07 May 92

FOR DIR. OF TRANSPORTATION DATE

1