
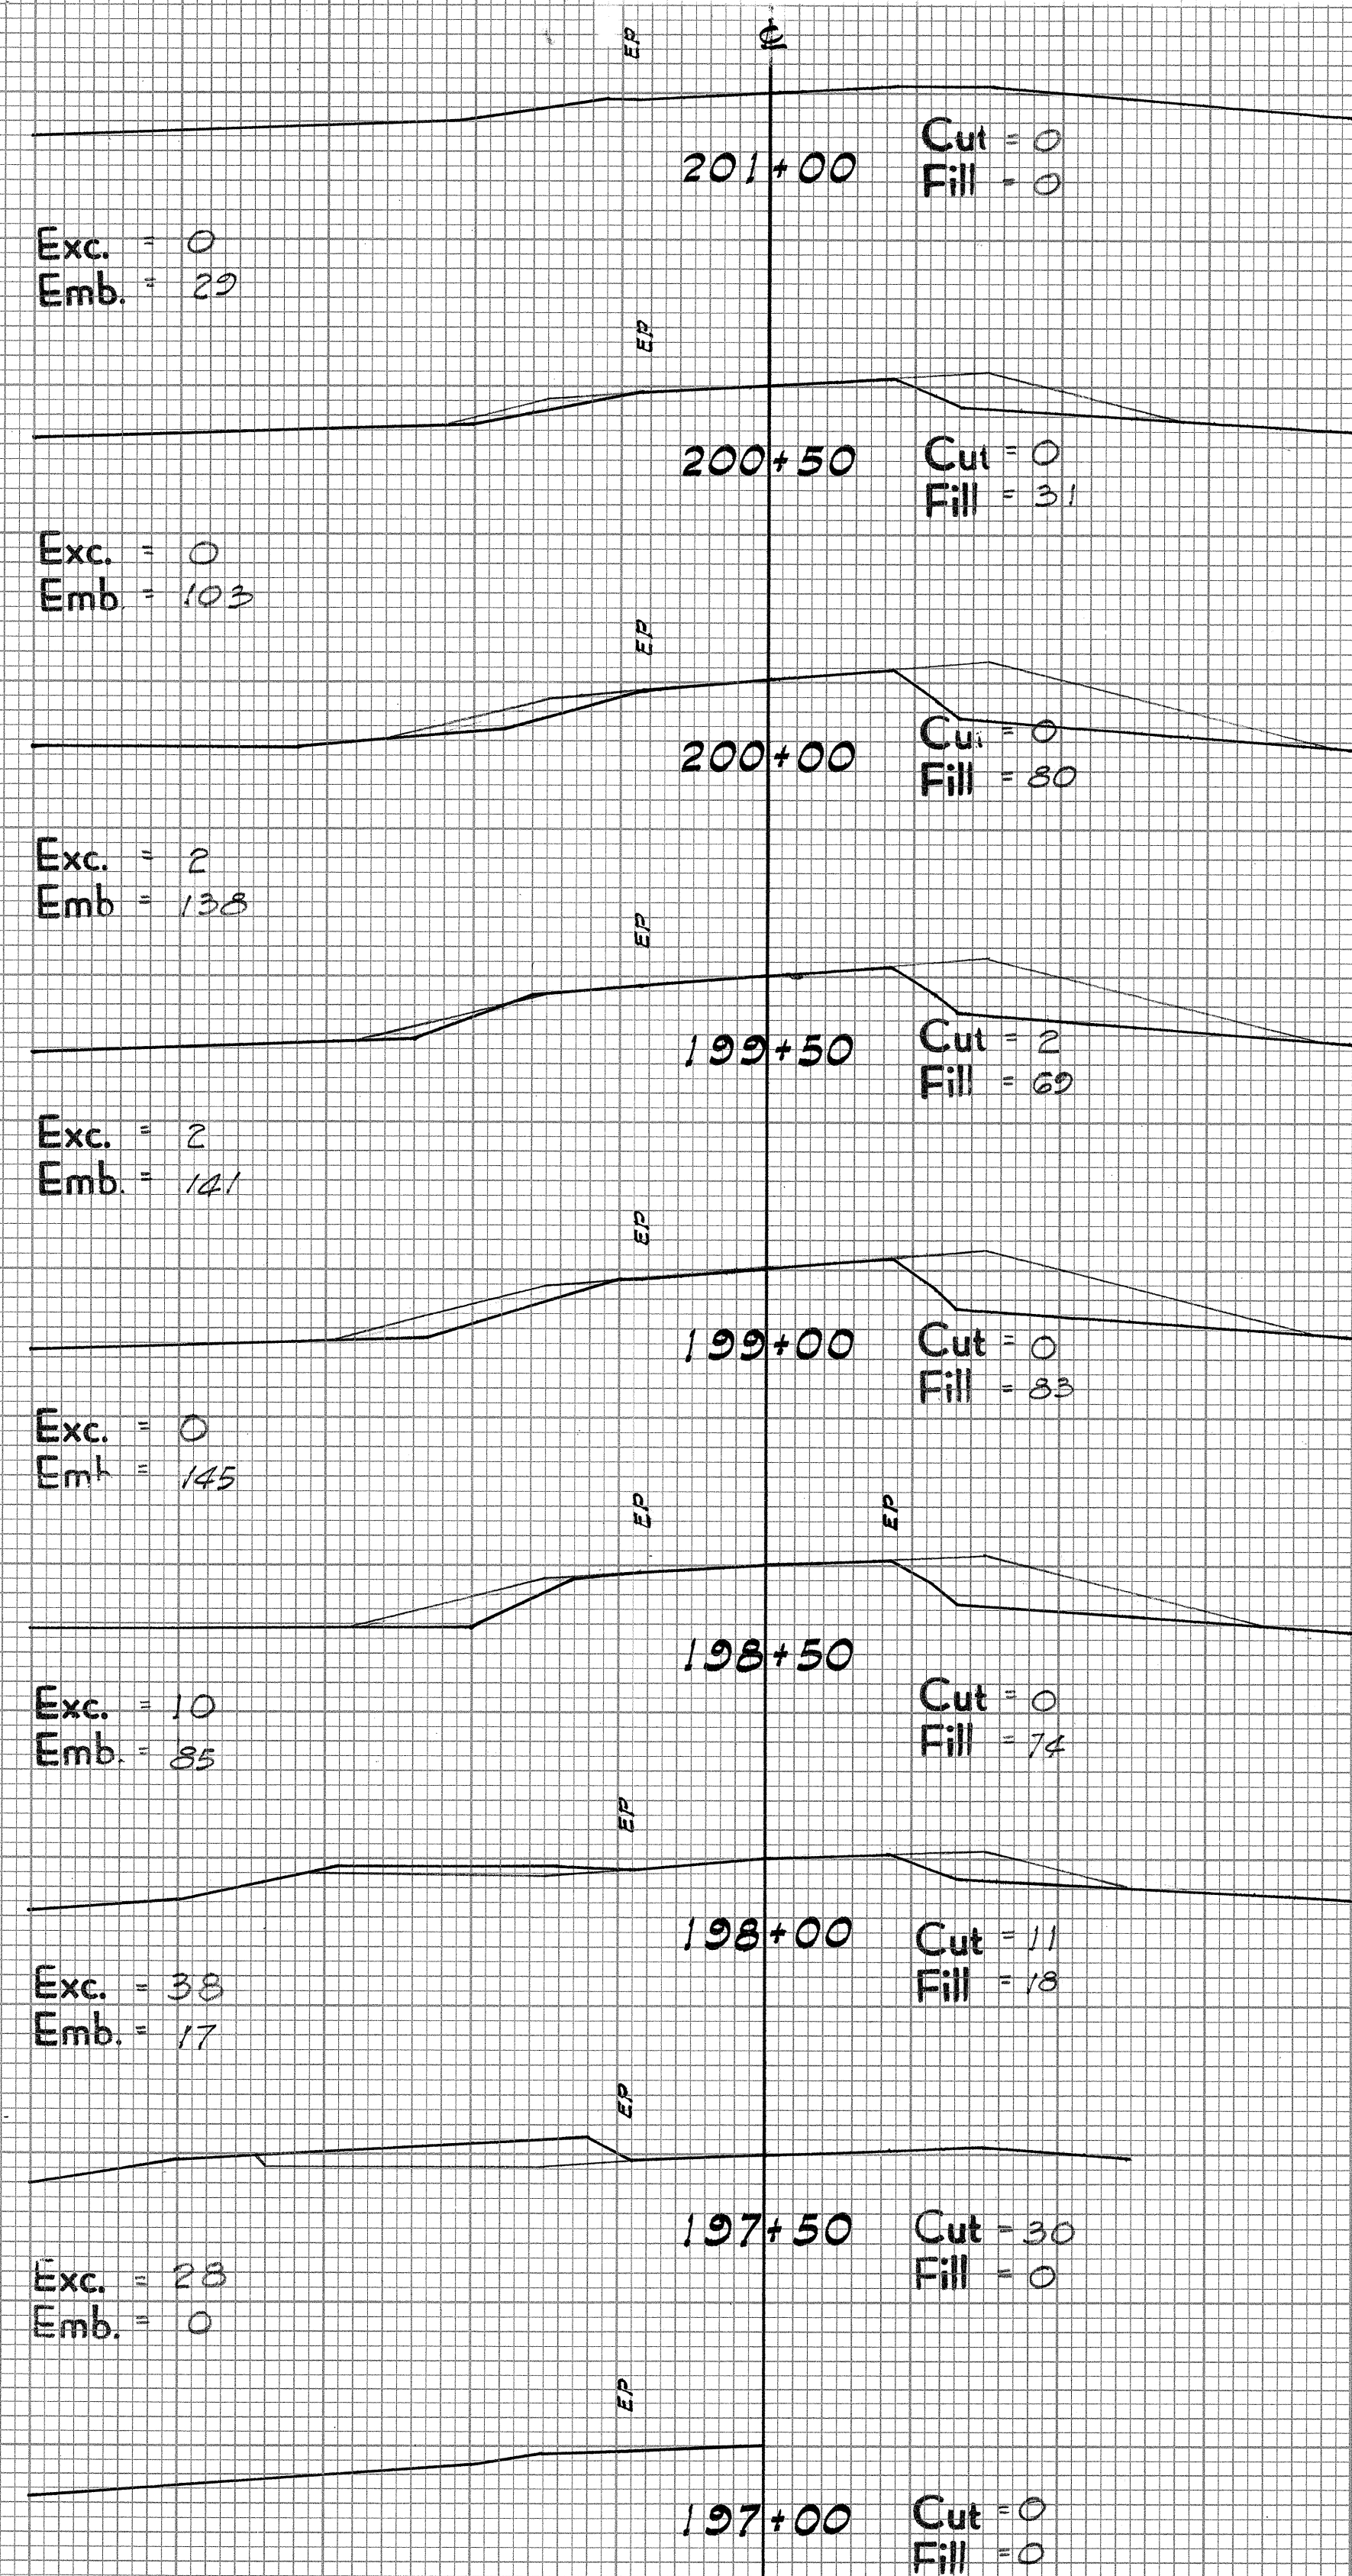
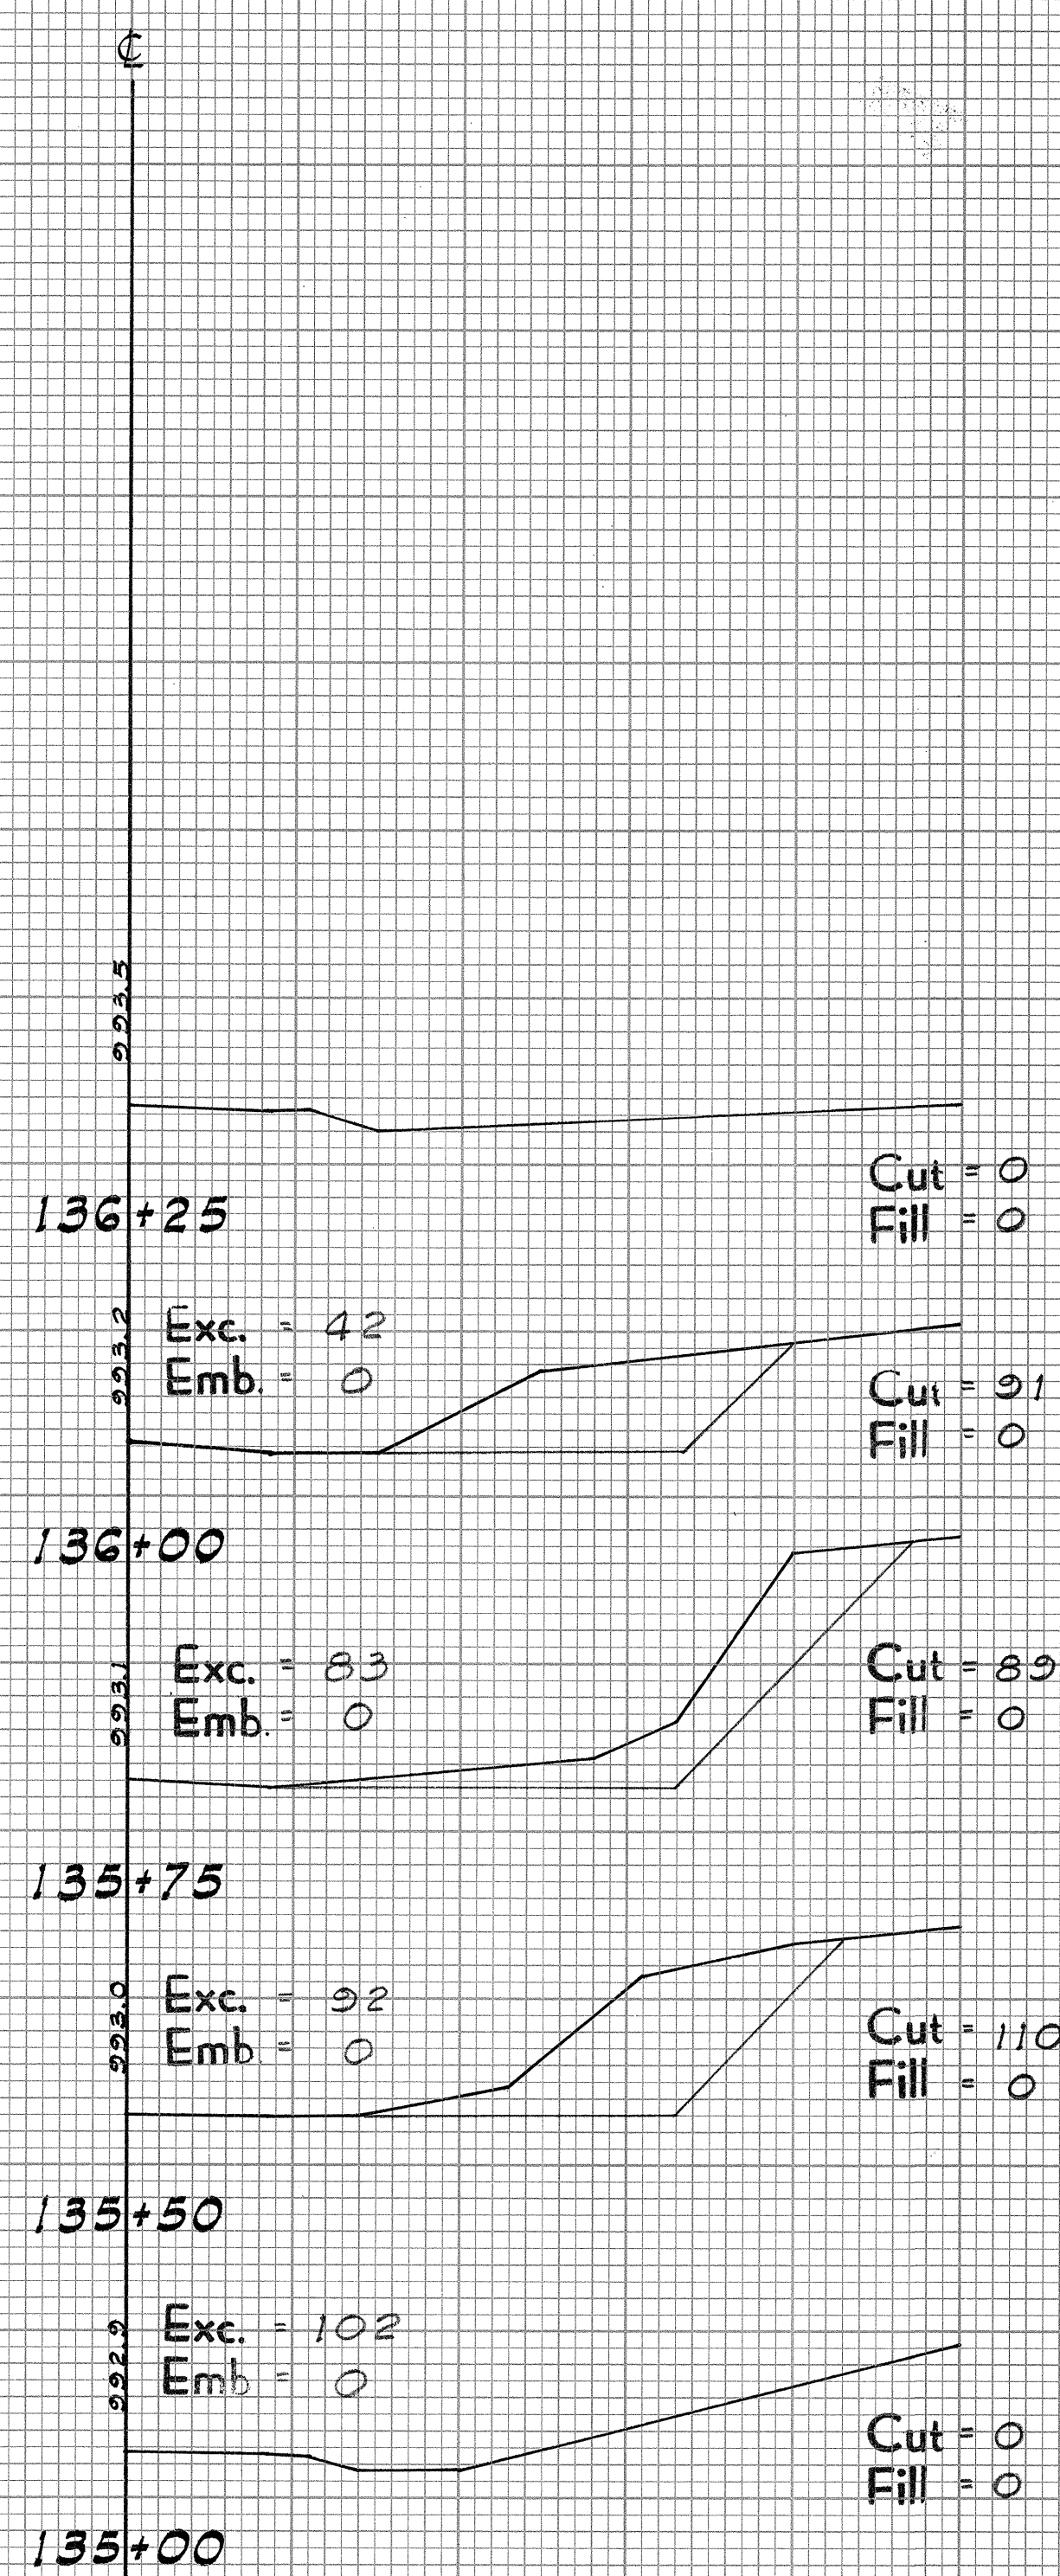
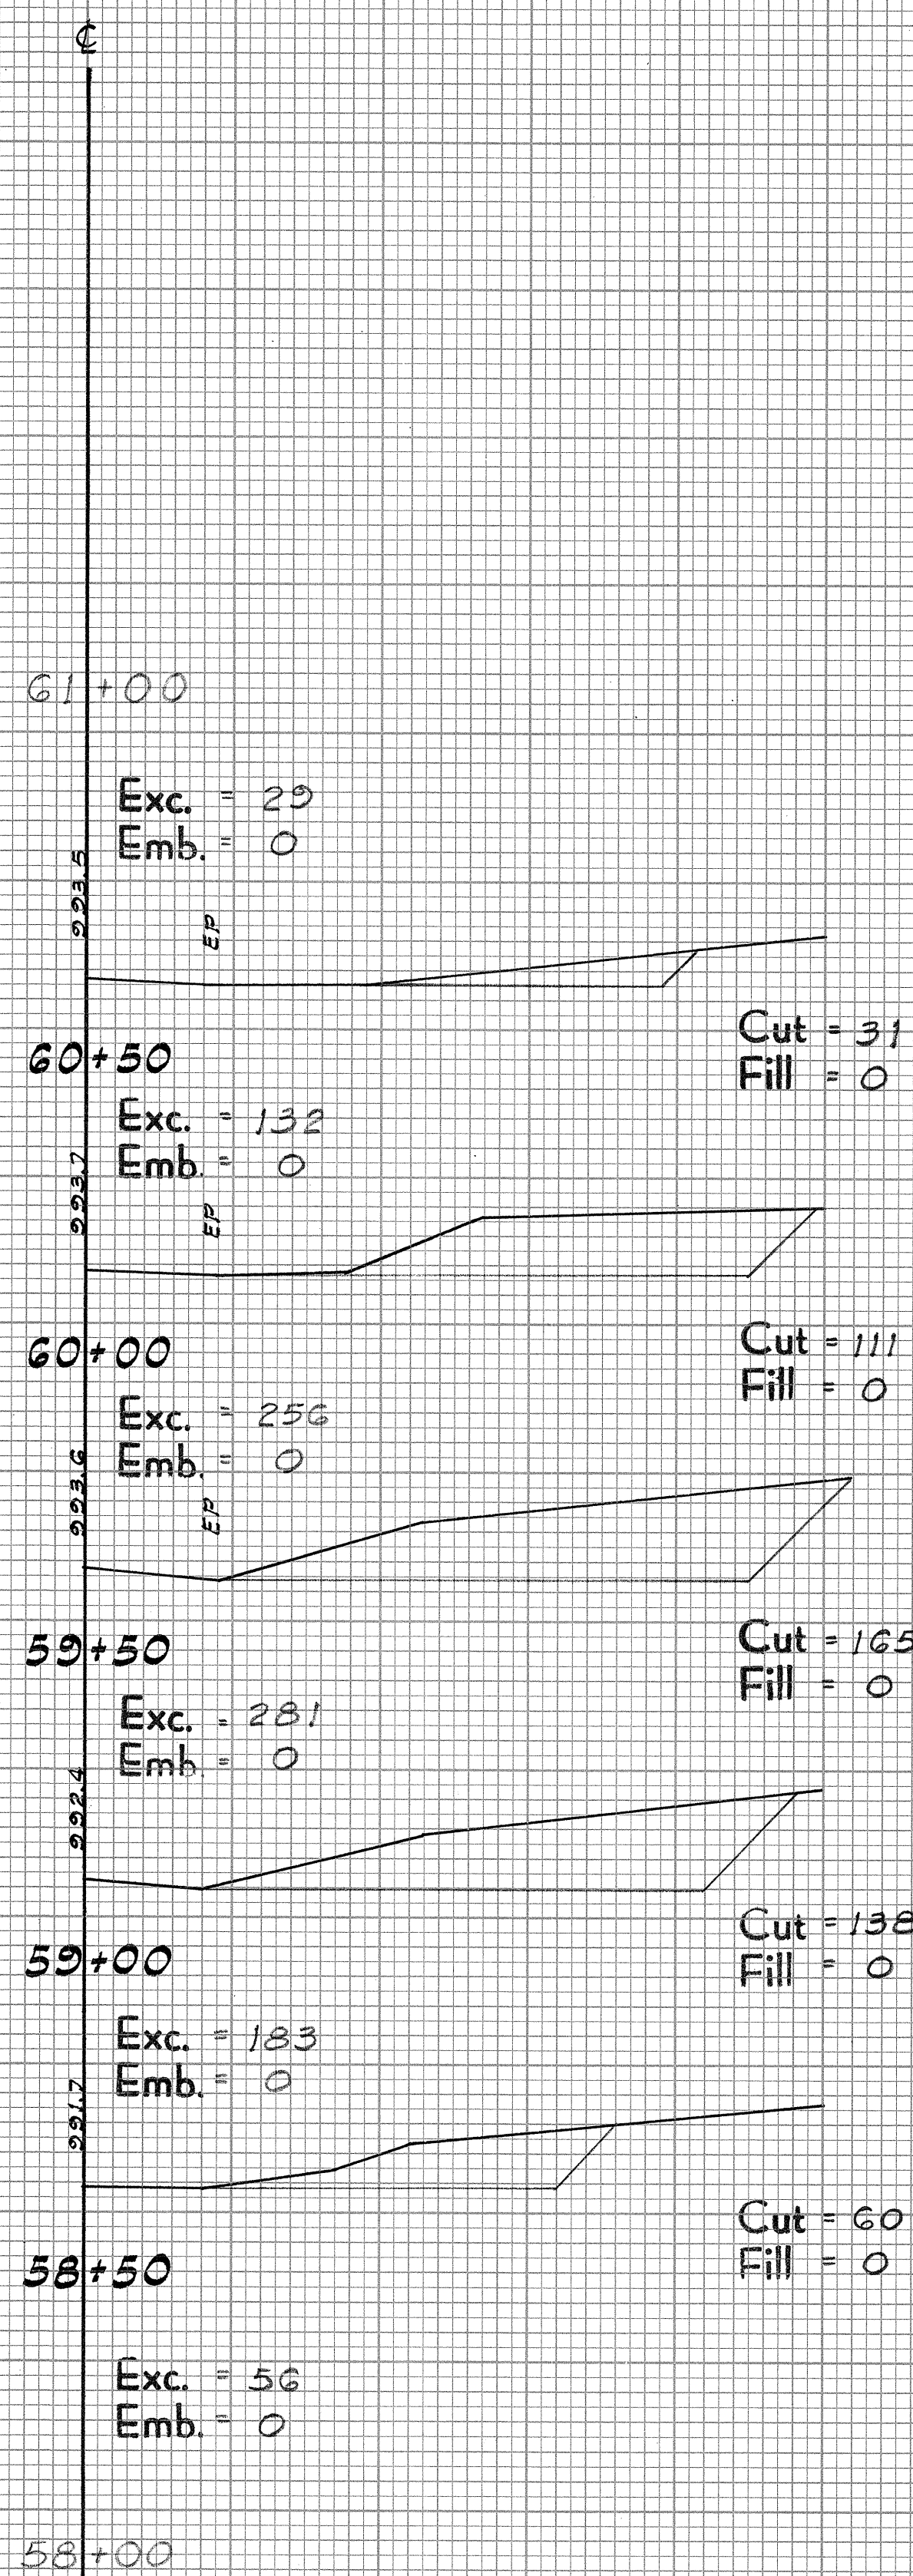


DATE	12/18/67	CHK BY	X.T.
BY	4.0		
FINAL SURVEY	SURVEYED	PLOTTED	TEMPERATURE
NOTE BOOK	NO. 216	AREAS CHECKED	

DATE		BY	
ORIGINAL SURVEY	SURVEYED	PLOTTED	TEMPERATURE
NOTE BOOK	NO. 216	AREAS CHECKED	

FED. ROAD DIST. NO.	STATE	FED. AID PROJ. NO.	FISCAL YEAR	SHEET NO.	TOTAL SHEETS
HAWAII	HAW.	19DE-01-68	1968	12	13


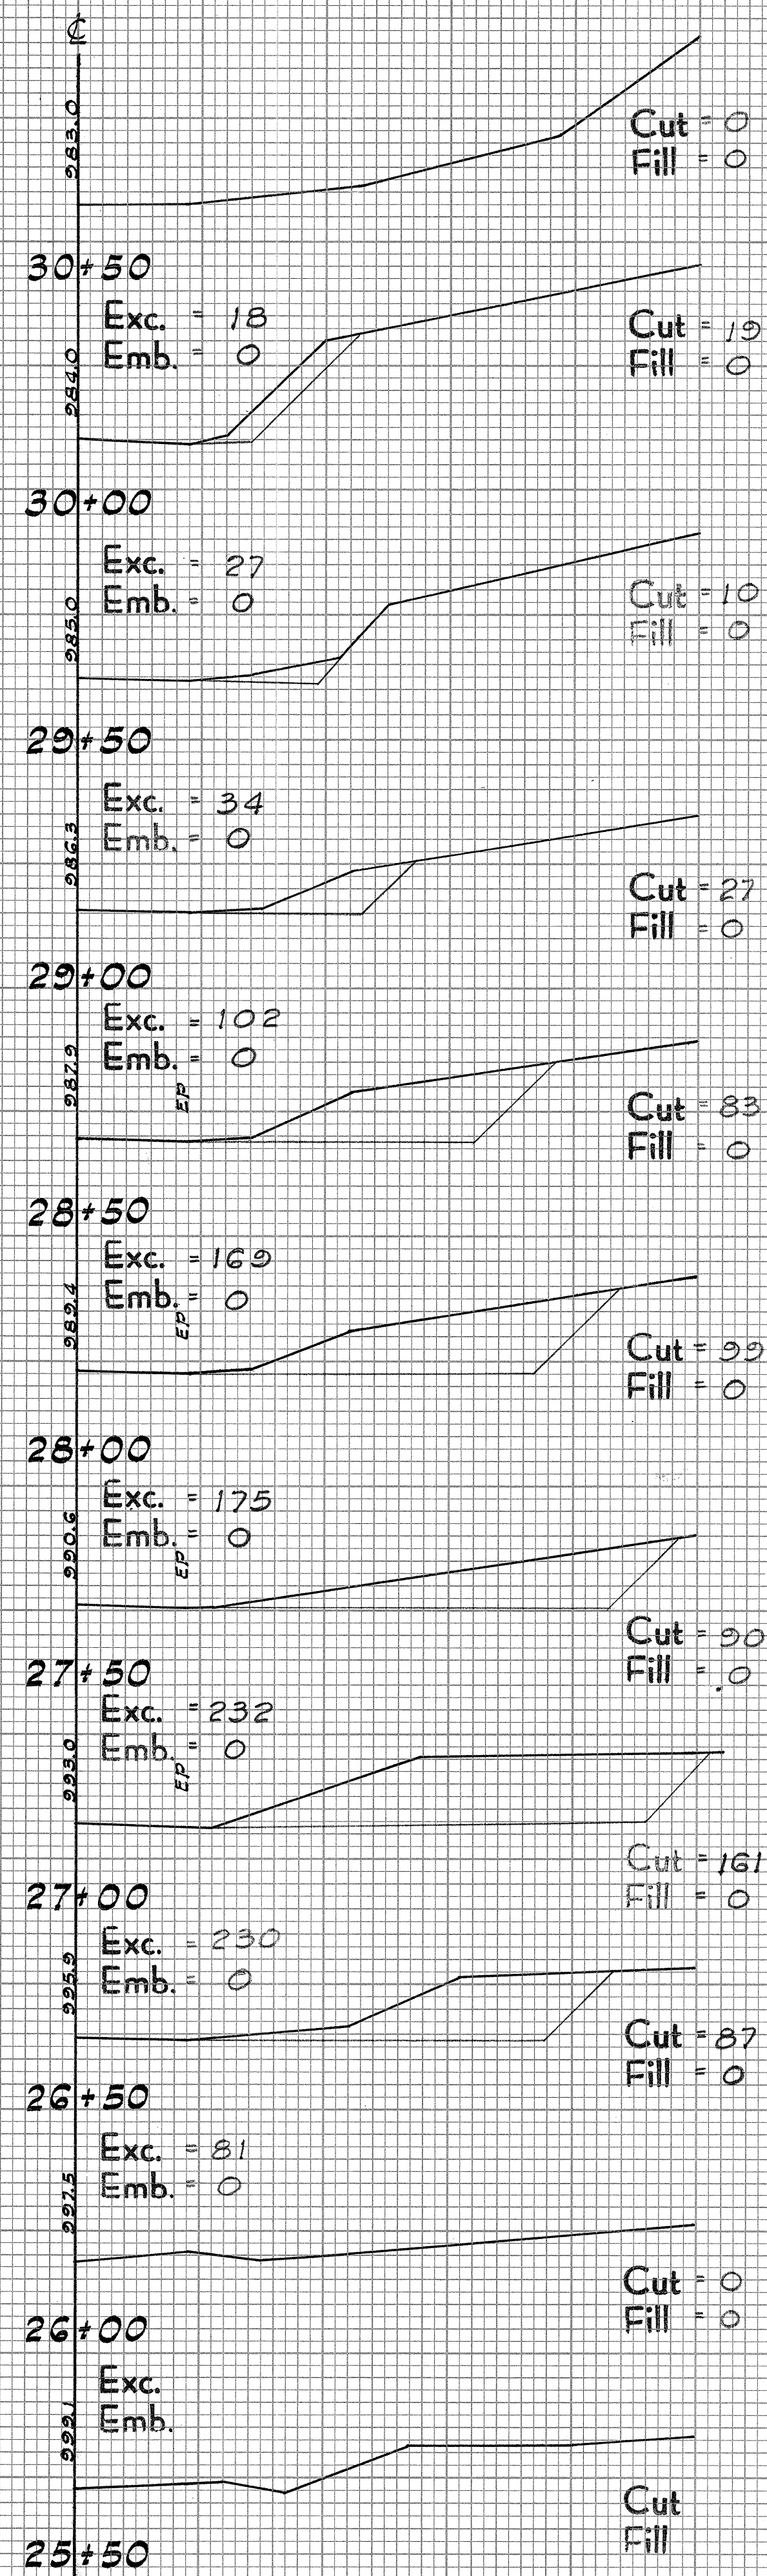


SCALE: HORIZ. = 10'
VERT. = 10'

PLATE 3 CROSS SECTION D. P. R. & R. E. STANDARD
100% RAD PAPER-MADE AND PRINTED IN U. S. A.
EUGENE DIETZGEN CO.

FINAL SURVEY	SURVEYED PLOTTED NOTE BOOK NO. 216	BY J.C.	DATE
			12/19/67
			chk. by J.E.
			12/29/67

ORIGINAL SURVEY	SURVEYED PLOTTED NOTE BOOK NO.	BY	DATE

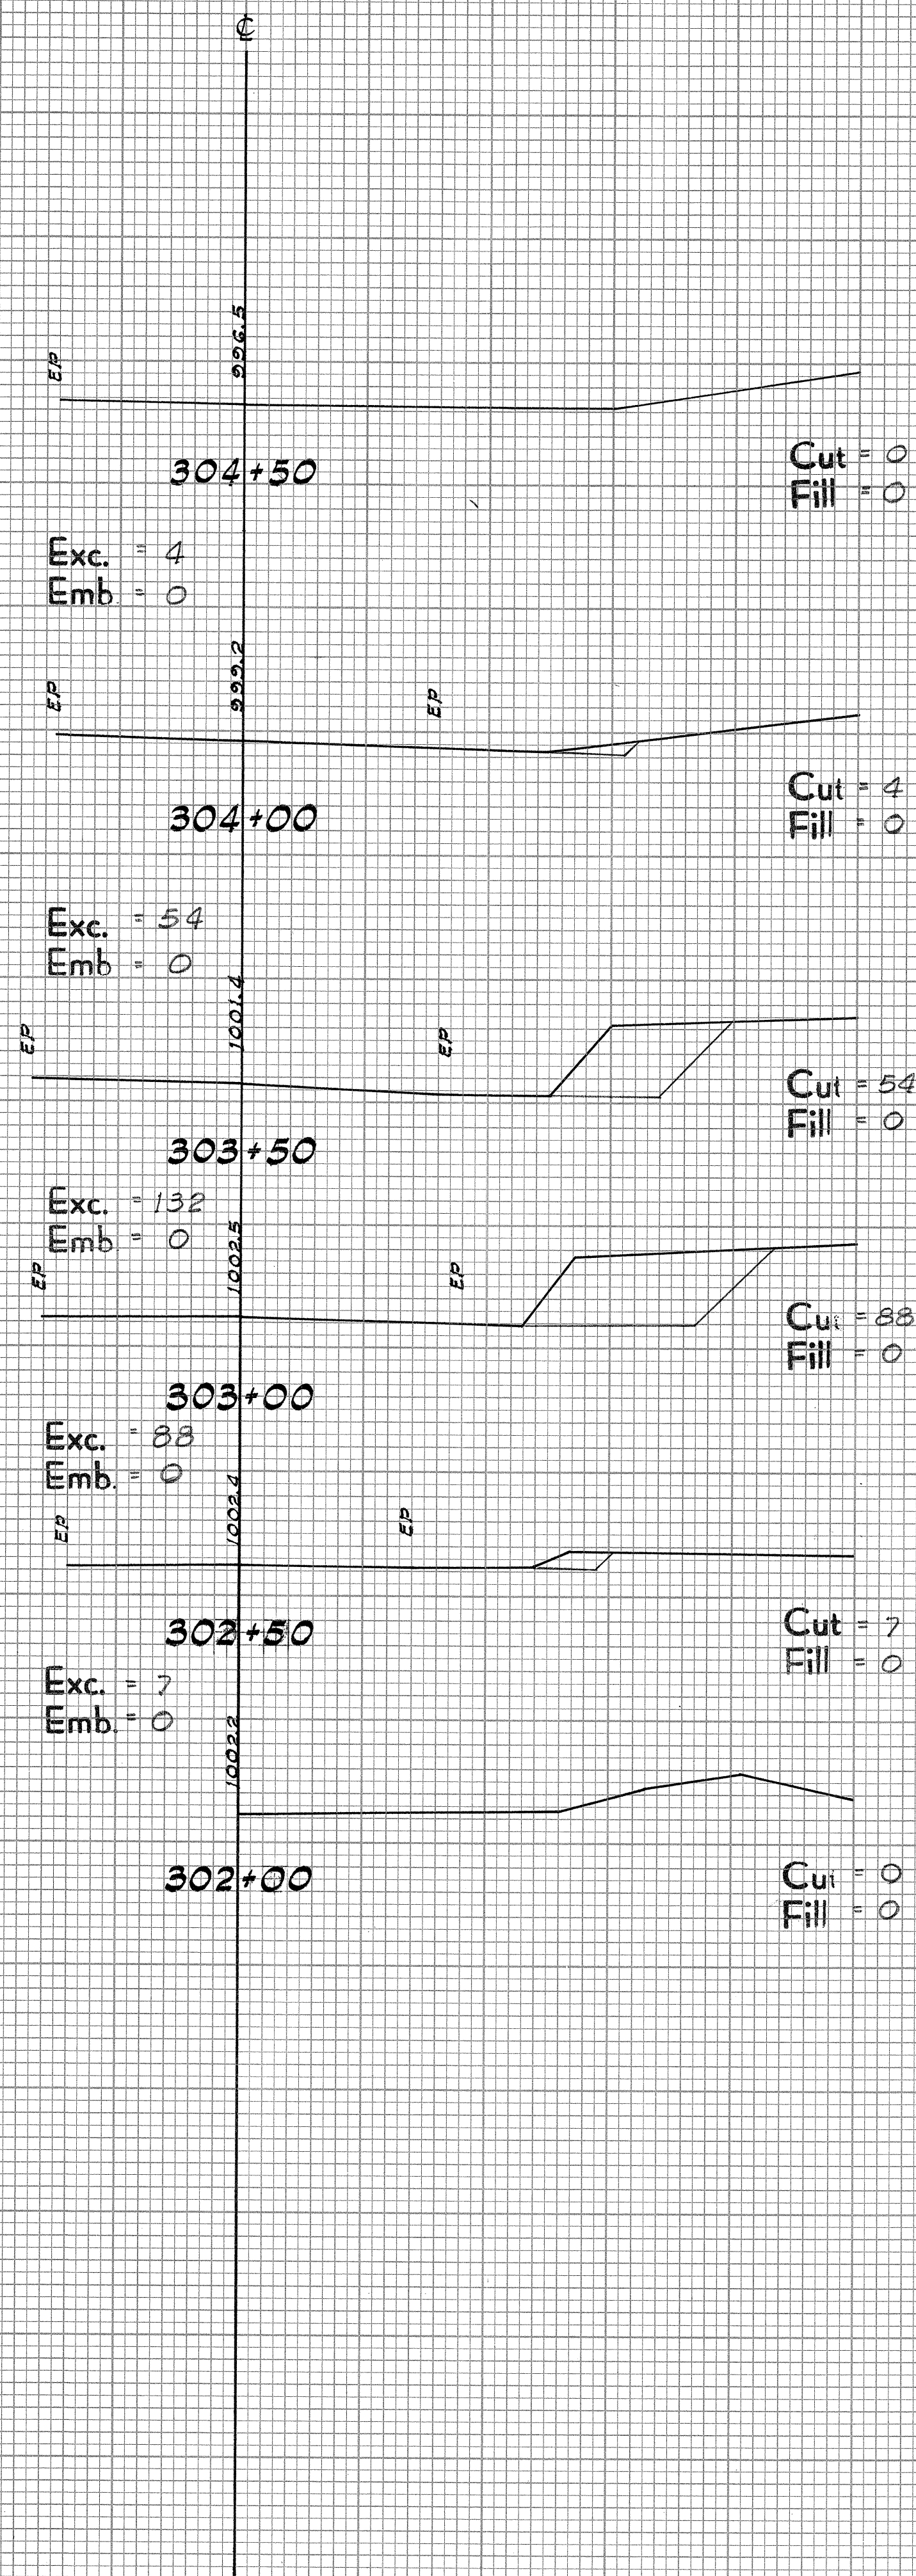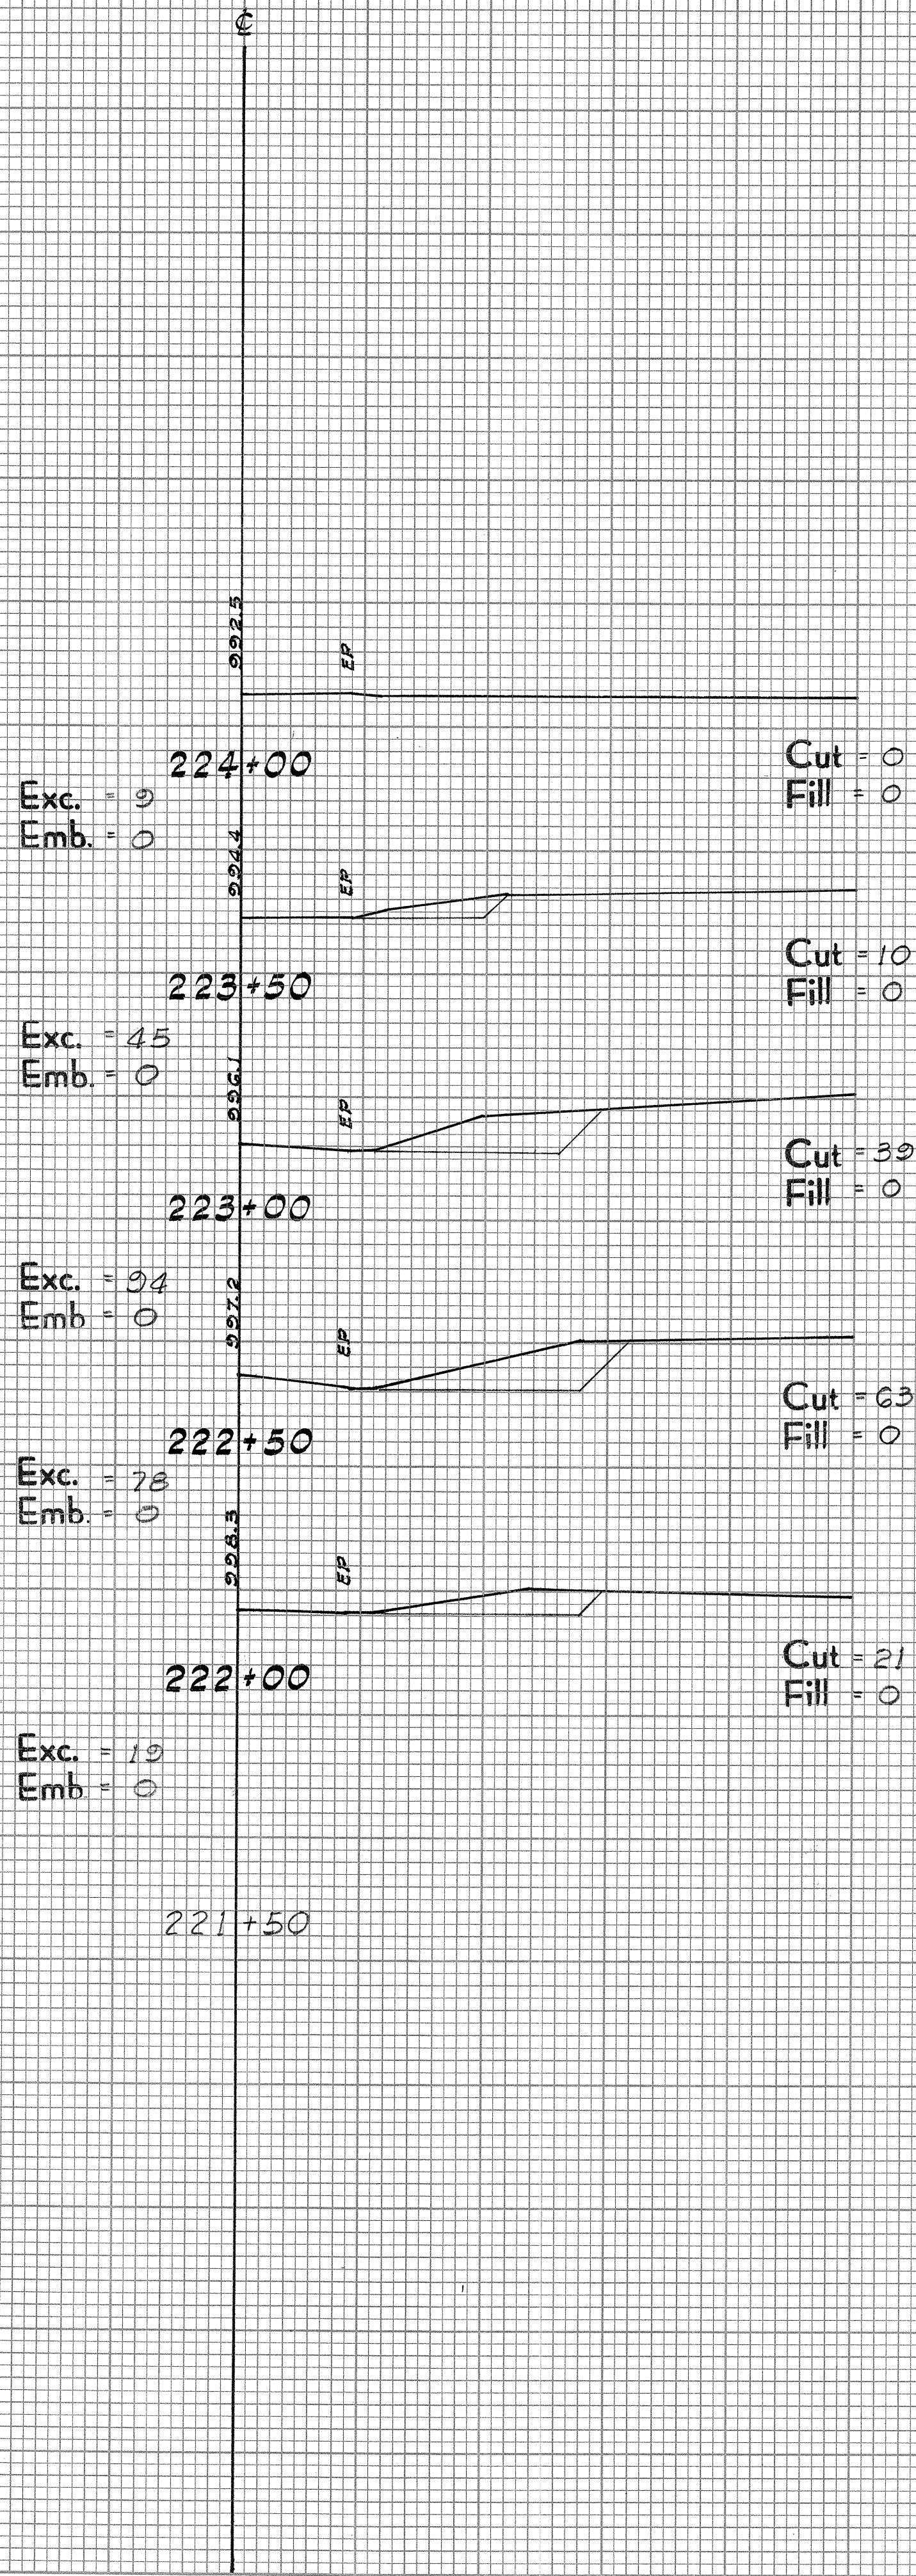

FED. ROAD DIST. NO.	STATE	FED. RD PROJ. NO.	FISCAL YEAR	SHEET NO.	TOTAL SHEETS
HAWAII	HAW.	19DE-01-68	1968	13	13