

INDEX TO DRAWINGS	
SHEET	DESCRIPTION
1	TITLE SHEET
2	PROJECT NO. 19C-01-68 TYPICAL SECTIONS
3	PROJECT NO. 19DE-01-68 TYPICAL SECTIONS
4	IMPROVEMENT OF SIGHT DISTANCE BY DAYLIGHTING
5	CULVERT AND CATTLE GUARD DETAIL
6-11	STANDARD AND MISC. DETAILS
12-13	CROSS SECTIONS



STATE OF HAWAII
DEPARTMENT OF TRANSPORTATION

PLANS FOR

RESURFACING AND REHABILITATION PROGRAM
OF HIGHWAYS
DISTRICT OF SOUTH KOHALA
ISLAND OF HAWAII

RECONSTRUCT AND RESURFACE HAWAII BELT ROAD
PROJECT NO. 19 C-01-68
DISTRICT OF SOUTH KOHALA

IMPROVE AND RESURFACE HAWAII BELT ROAD
PROJECT NO. 19 DE-01-68
DISTRICT OF SOUTH KOHALA

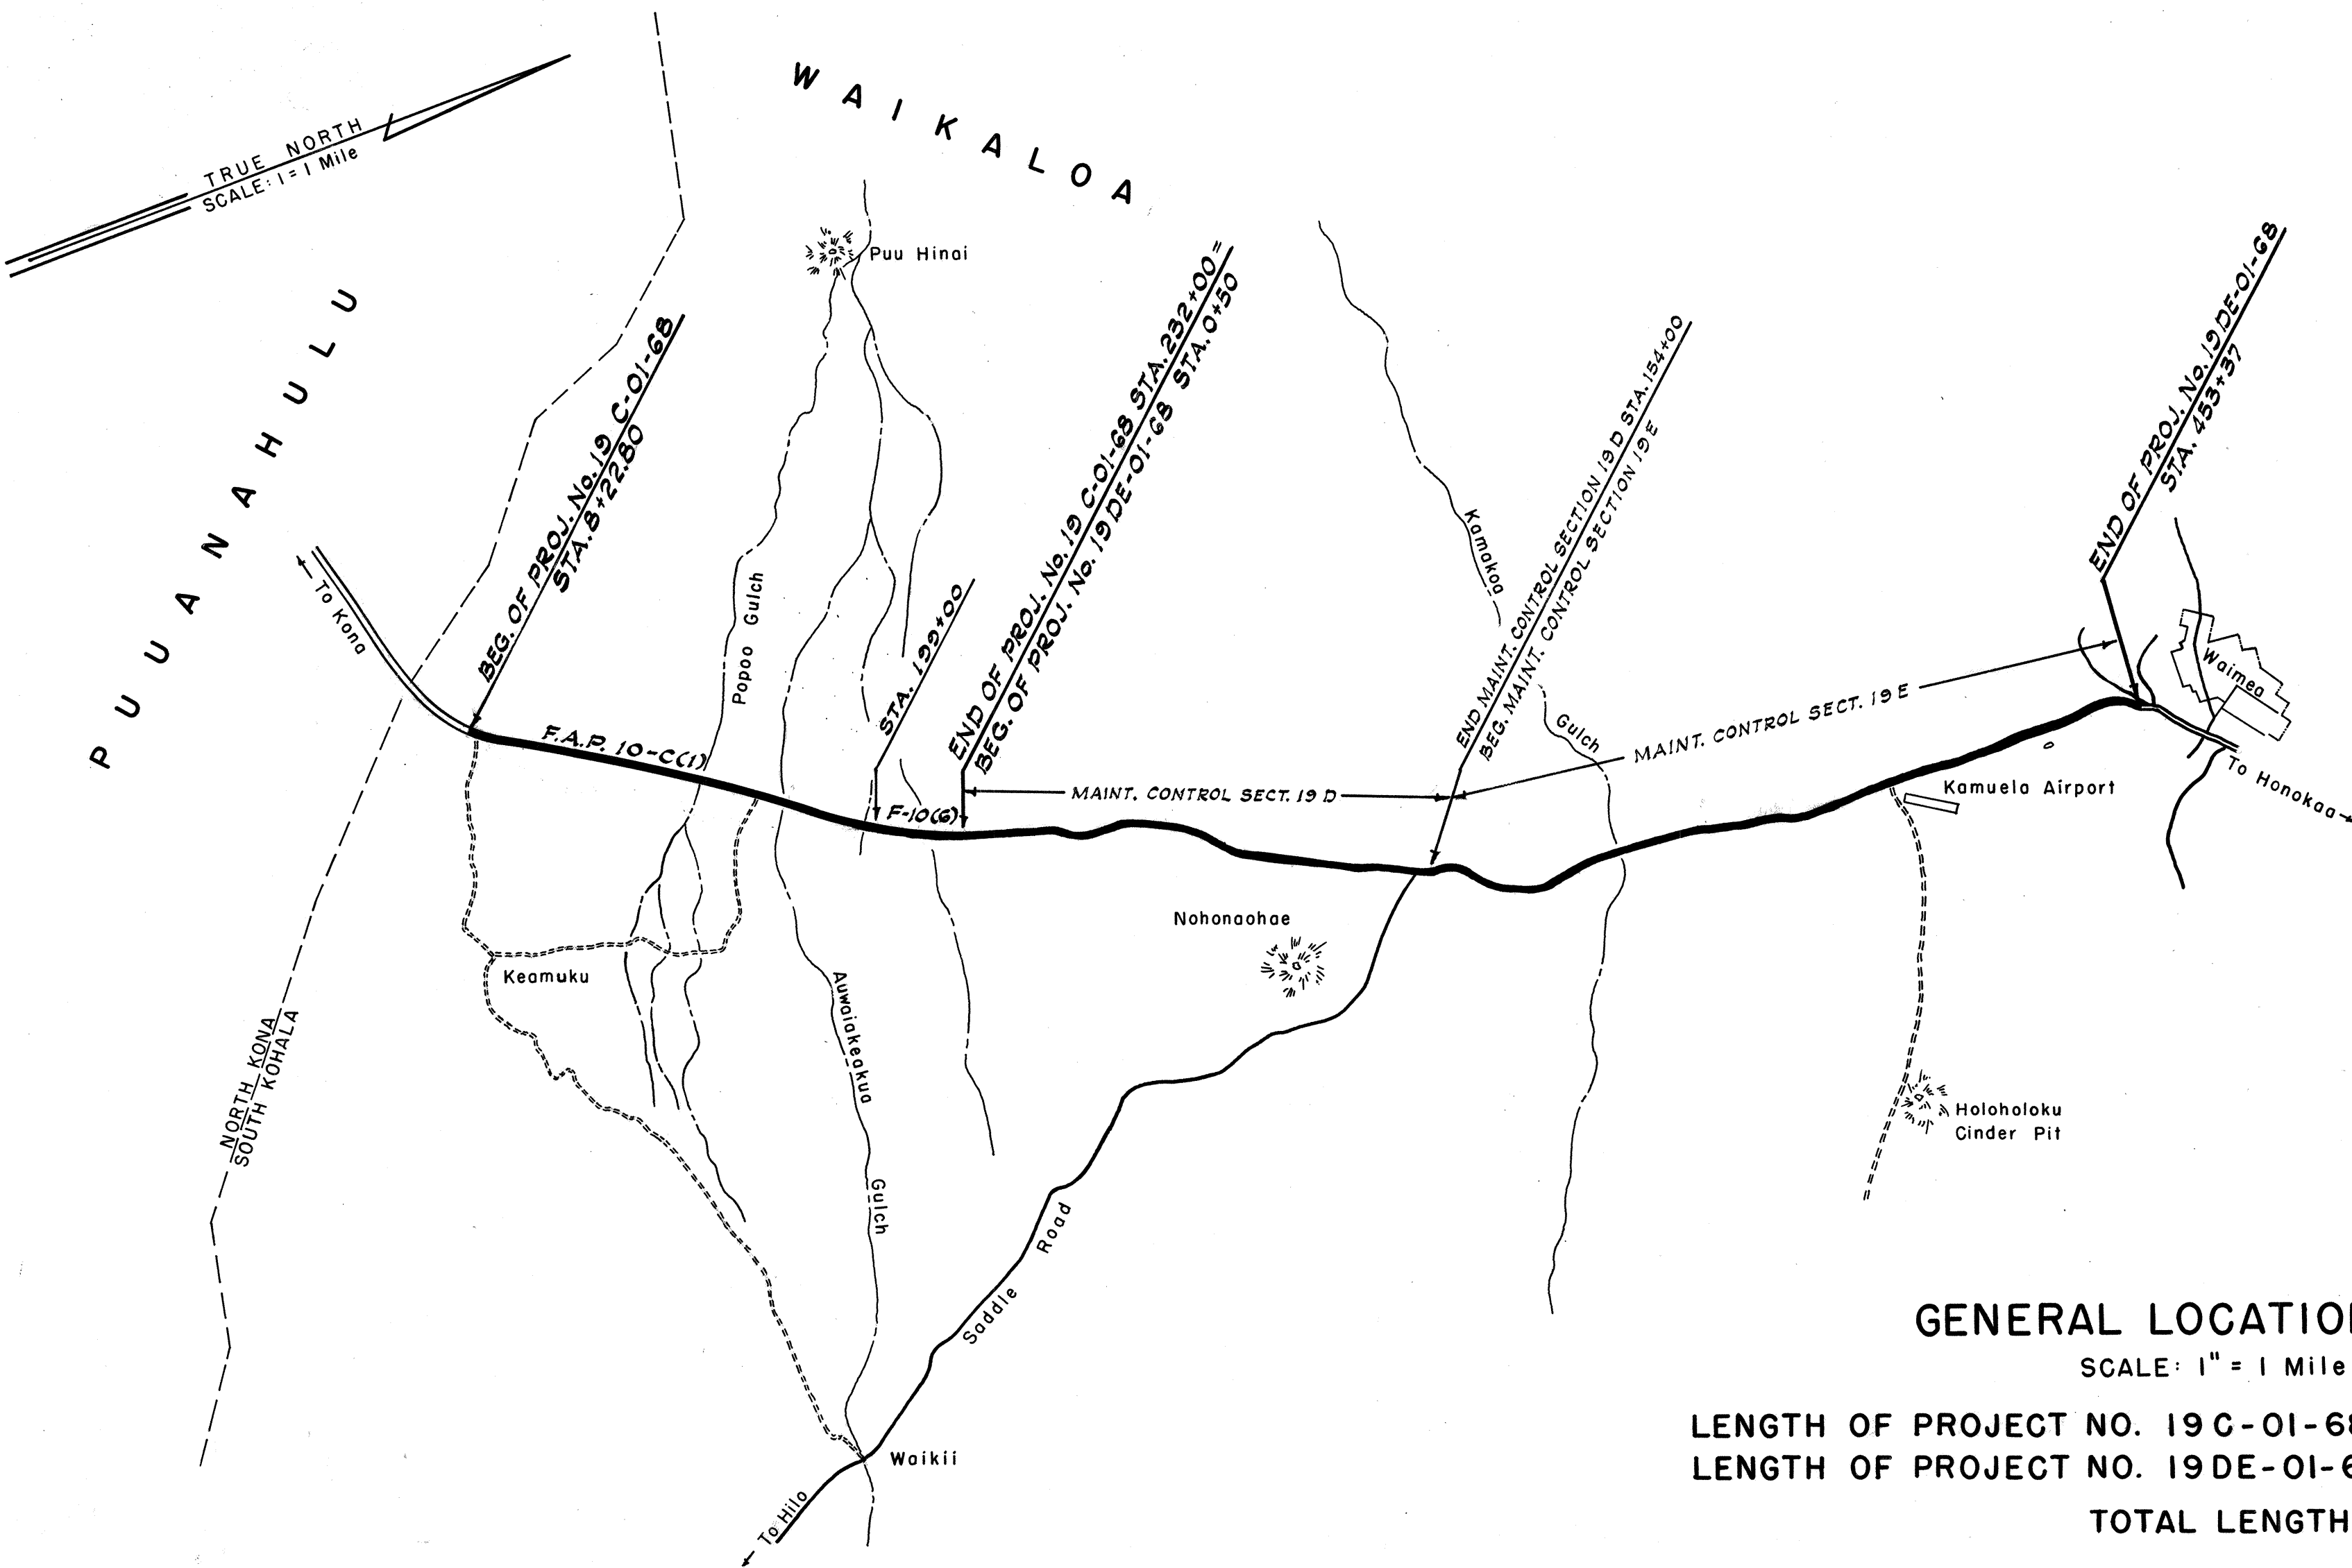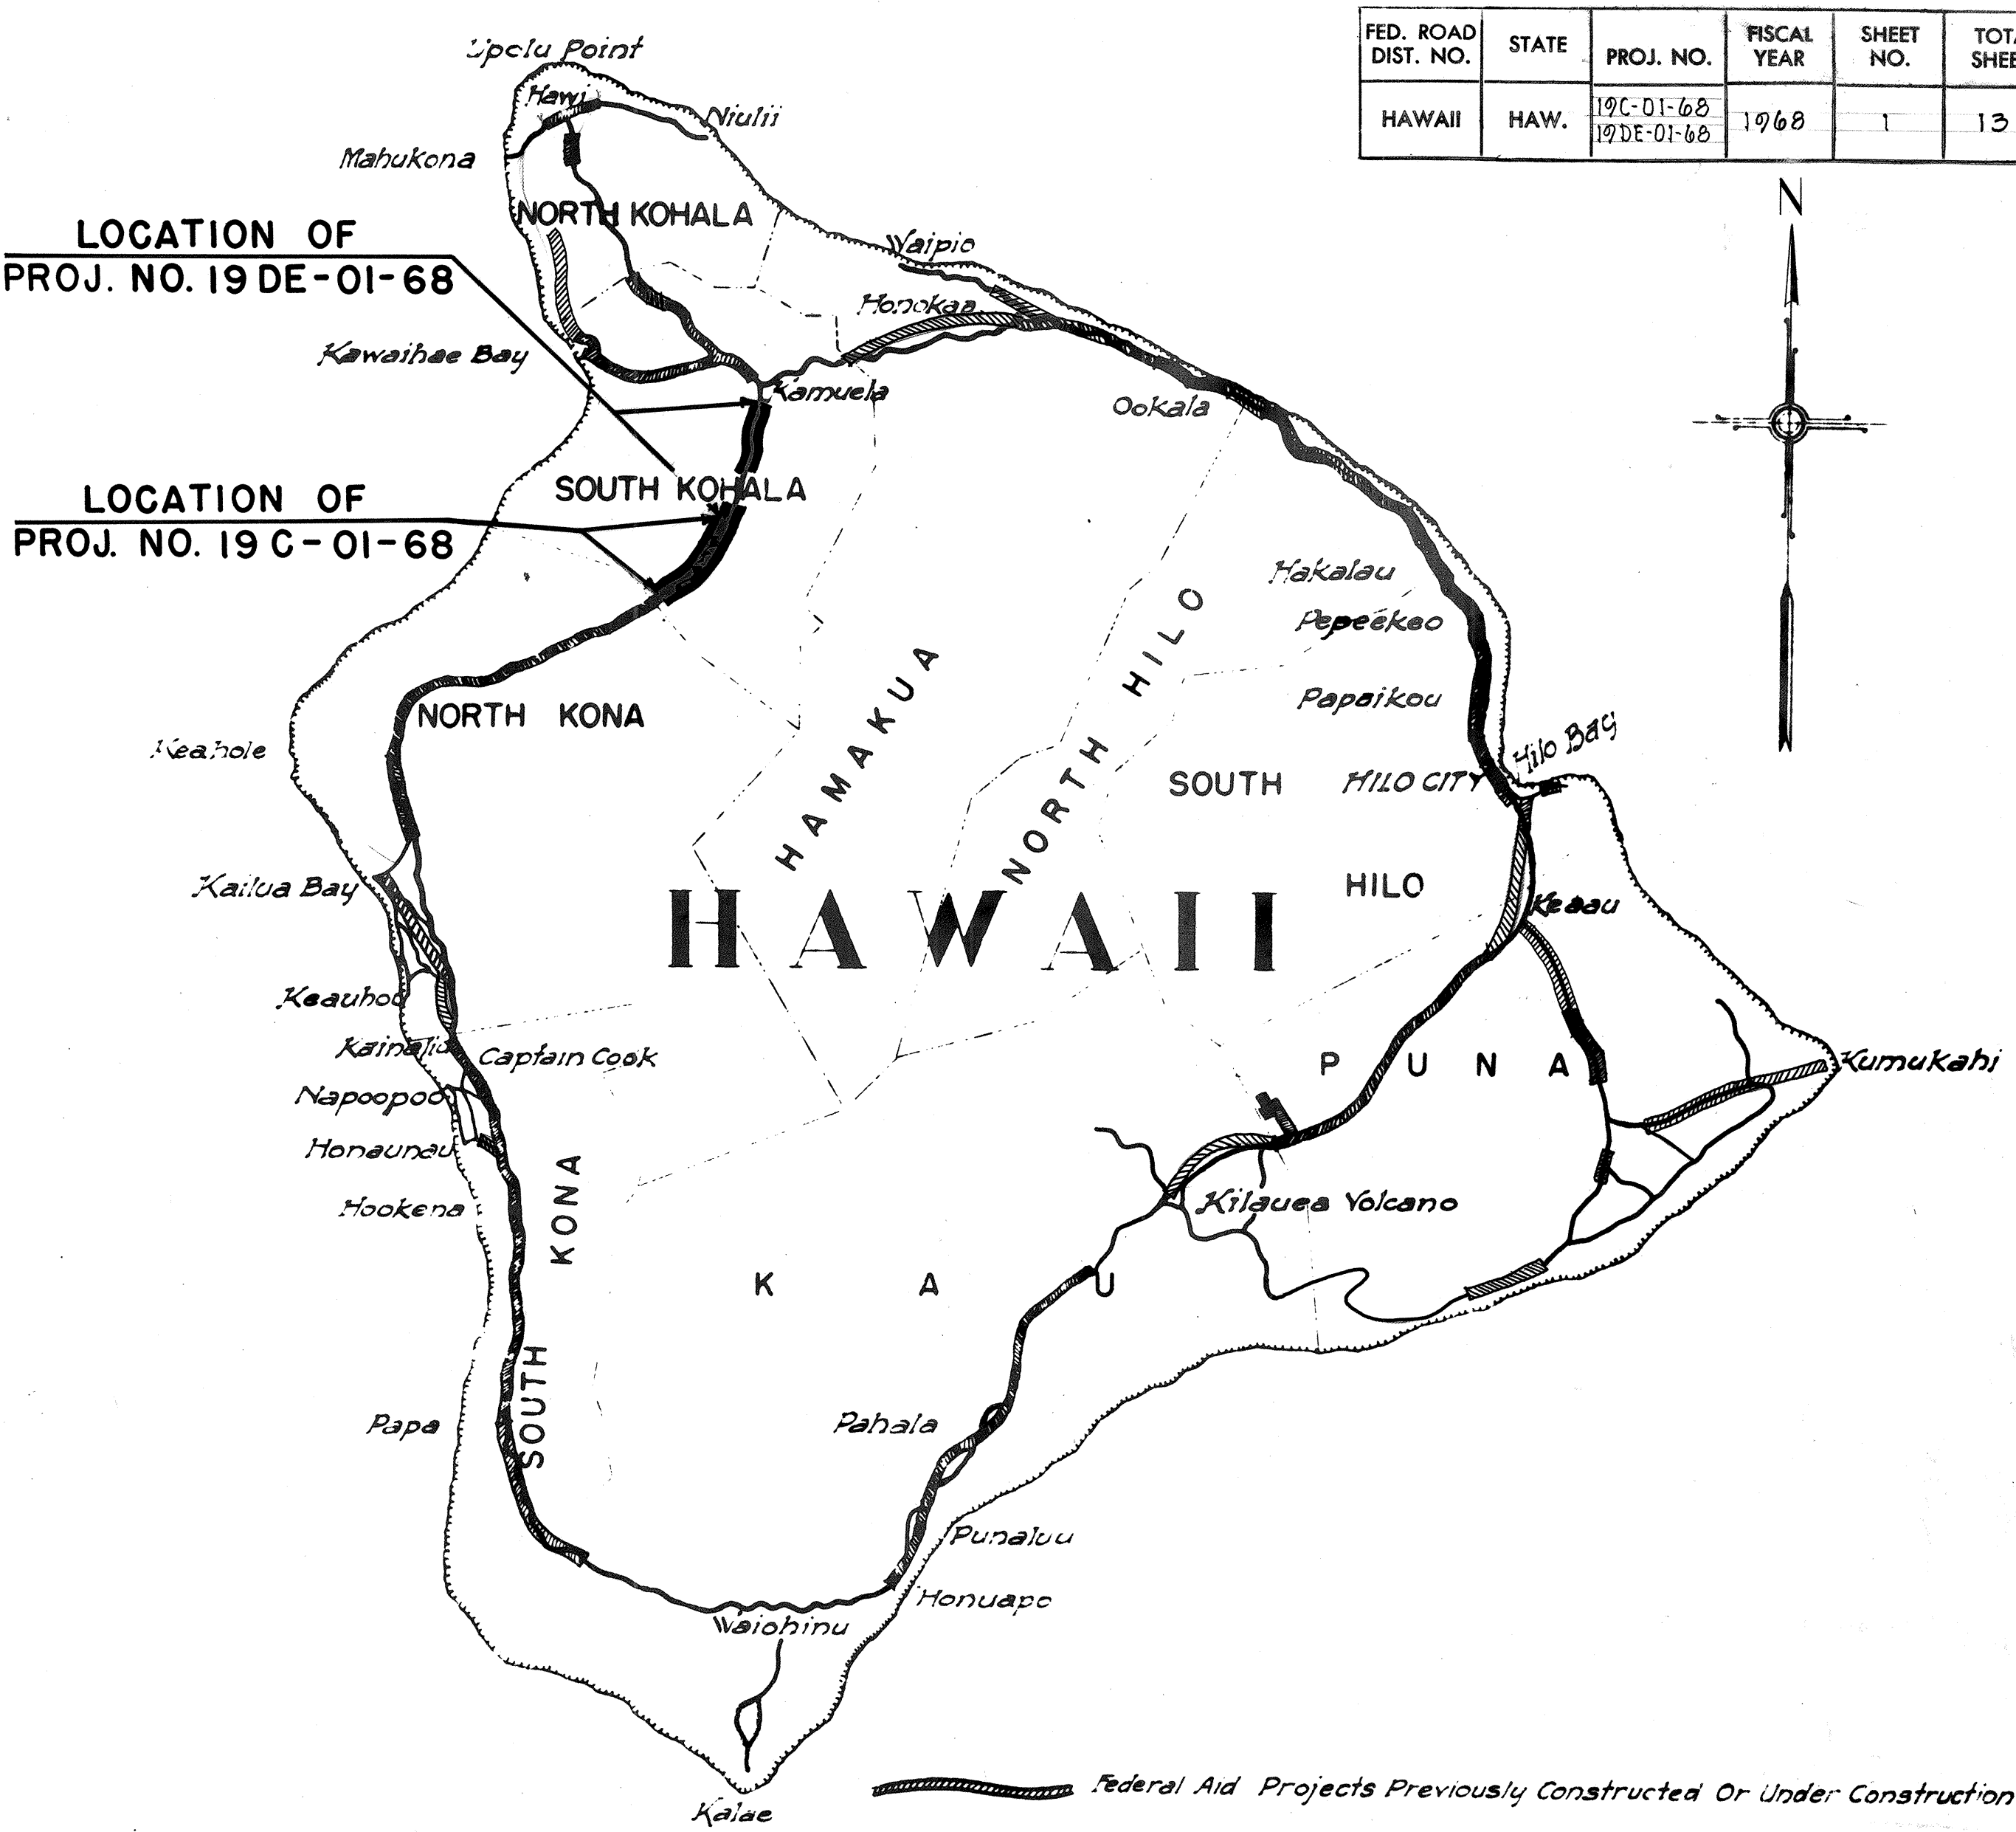

GENERAL LOCATION PLAN

SCALE: 1" = 1 Mile

LENGTH OF PROJECT NO. 19C-01-68
LENGTH OF PROJECT NO. 19DE-01-68
TOTAL LENGTH

4.238 Mi.
8.577 Mi.
12.815 Mi.

FED. ROAD DIST. NO.	STATE	PROJ. NO.	FISCAL YEAR	SHEET NO.	TOTAL SHEETS
HAWAII	HAW.	19C-01-68 19DE-01-68	1968	1	13

APPROVED:

John W. McArthur 3/1/68
For DIRECTOR OF TRANSPORTATION DATE

ORIGINAL PLAN
DESIGNED BY R. TERADA
CHECKED BY
DATE MAR 68