

FED. ROAD DIST. NO.	STATE	PROJ. NO.	FISCAL YEAR	SHEET NO.	TOTAL SHEETS
HAWAII	HAW.	190BC-01-05M	2005	3	13

GENERAL NOTES

- ORIGINAL  
PLAN

NOTED BY  
N. F. HARRIS

DESIGNED BY  
N. F. HARRIS

QUANTITIES BY  
N. F. HARRIS

CHECKED BY  
N. F. HARRIS

DATE  
1/1/05

AS-BUILT 12008.8.mamagr.dgn
1.

This project consists of pavement repairs of weakened pavement areas, replacing and installing pavement striping and reflector markers, furnishing equipment, tools, materials, labors and incidentals necessary to complete the work.

2.

The Contractor is reminded of the requirements of Subsection 108.01 - Subletting of Contract, which requires him to perform work amounting to not less than 30 percent of the total contract cost less deductible items. Non-compliance with this Subsection may be grounds for rejection of bid.

3.

The Contractor's attention is directed to the following Sections of the Special Provisions: Subsection 107.13 - Public Convenience and Safety, Subsection 107.21 - Contractor's Responsibility for Utility Property and Services, and Section 645 - Traffic Control.

4.

The Contractor shall notify the State in writing, two (2) weeks prior to starting paving repair operations.

5.

At the end of each day's work, the Contractor shall remove all equipment and other obstructions to permit free and safe passage of public traffic.

6.

The existence and location of underground utilities, manholes, monuments and structures may be determined from previous construction plans but the accuracy is not guaranteed. The encountering of other obstacles during the course of the work is possible. The Contractor shall be held liable for any damages incurred to the existing facilities and/or improvements as a result of his operations.

7.

The exact locations and limits of areas to be repaired and cold planed shall be determined in the field by the Engineer.

8.

The Contractor shall dispose of all removed raised pavement markers. This work shall be considered incidental to various contract items.

9.

Smooth riding connections shall be constructed at all limits of repair including the beginning and end of project shown on the plans and/or as directed by the Engineer.

10.

Existing drainage system will be functional at all times during construction. Contractor is to furnish materials, equipment, labor, tools and incidentals necessary to maintain flow. This work shall be considered incidental to the various contract items.

11.

Contractor shall provide for access to and from existing side streets and driveways at all times.

12.

Unprotected pavement dropoffs greater than 2" shall not be allowed during non-working hours, except where approved by the Engineer in writing.

13.

Public Notice is required for lane closures. Contractor shall submit notice to the Engineer for approval a minimum of three weeks prior to publication. Pre-approval of notice, with dates left blank, is permissible.

14.

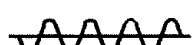

Cold-planing of 100-ft. transitions at project limits shall be considered incidental to Item No. 312.0100 - Plant Mix Glassphalt Concrete Base Course.

15.

Contractor shall maintain at least one paved shoulder free and clear of debris for pedestrian and bicycle traffic at all times.

16.

Contractor's attention is directed to Subsection 108.02 - Notice to Proceed that requires work to begin within 10 workings days from the date notice is issued to the Contractor.

LEGEND FOR AS-BUILT POSTINGS	
	Squiggly line for as-built deletion
	Double line for as-built deletion
Roadway	Text for as-built posting

STATE OF HAWAII DEPARTMENT OF TRANSPORTATION HIGHWAYS DIVISION	
GENERAL NOTES	
MAMALAHOA HIGHWAY, ROUTE 190 PAVEMENT REPAIRS - KA'UPULEHU TO PU'UANAHULU	
PROJECT NO. 190BC-01-05M	
Scale: As Shown	Date: April, 2005
SHEET No. 1 OF 1 SHEETS	