
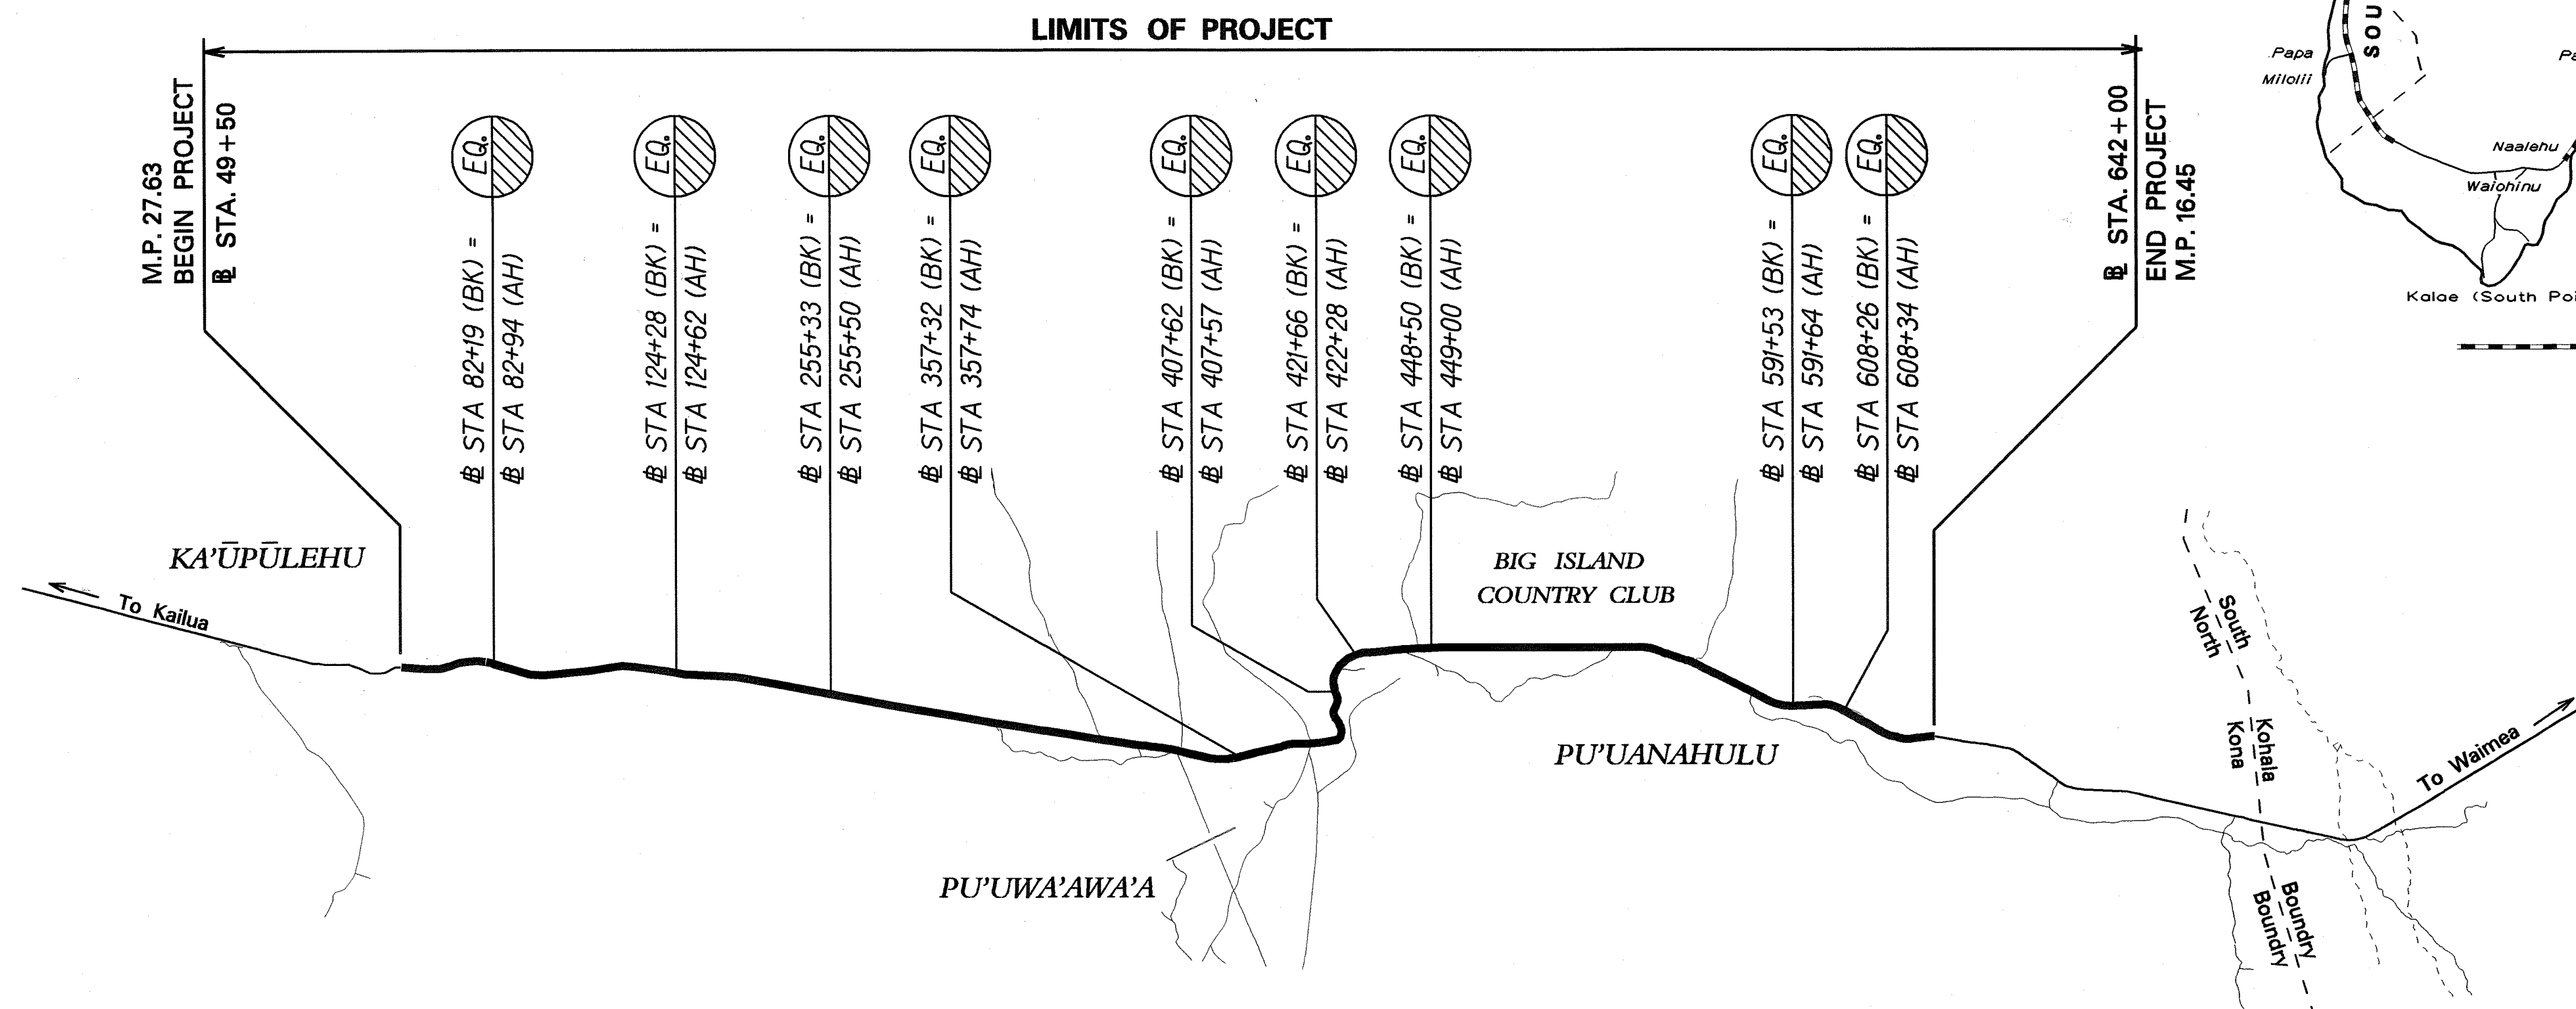
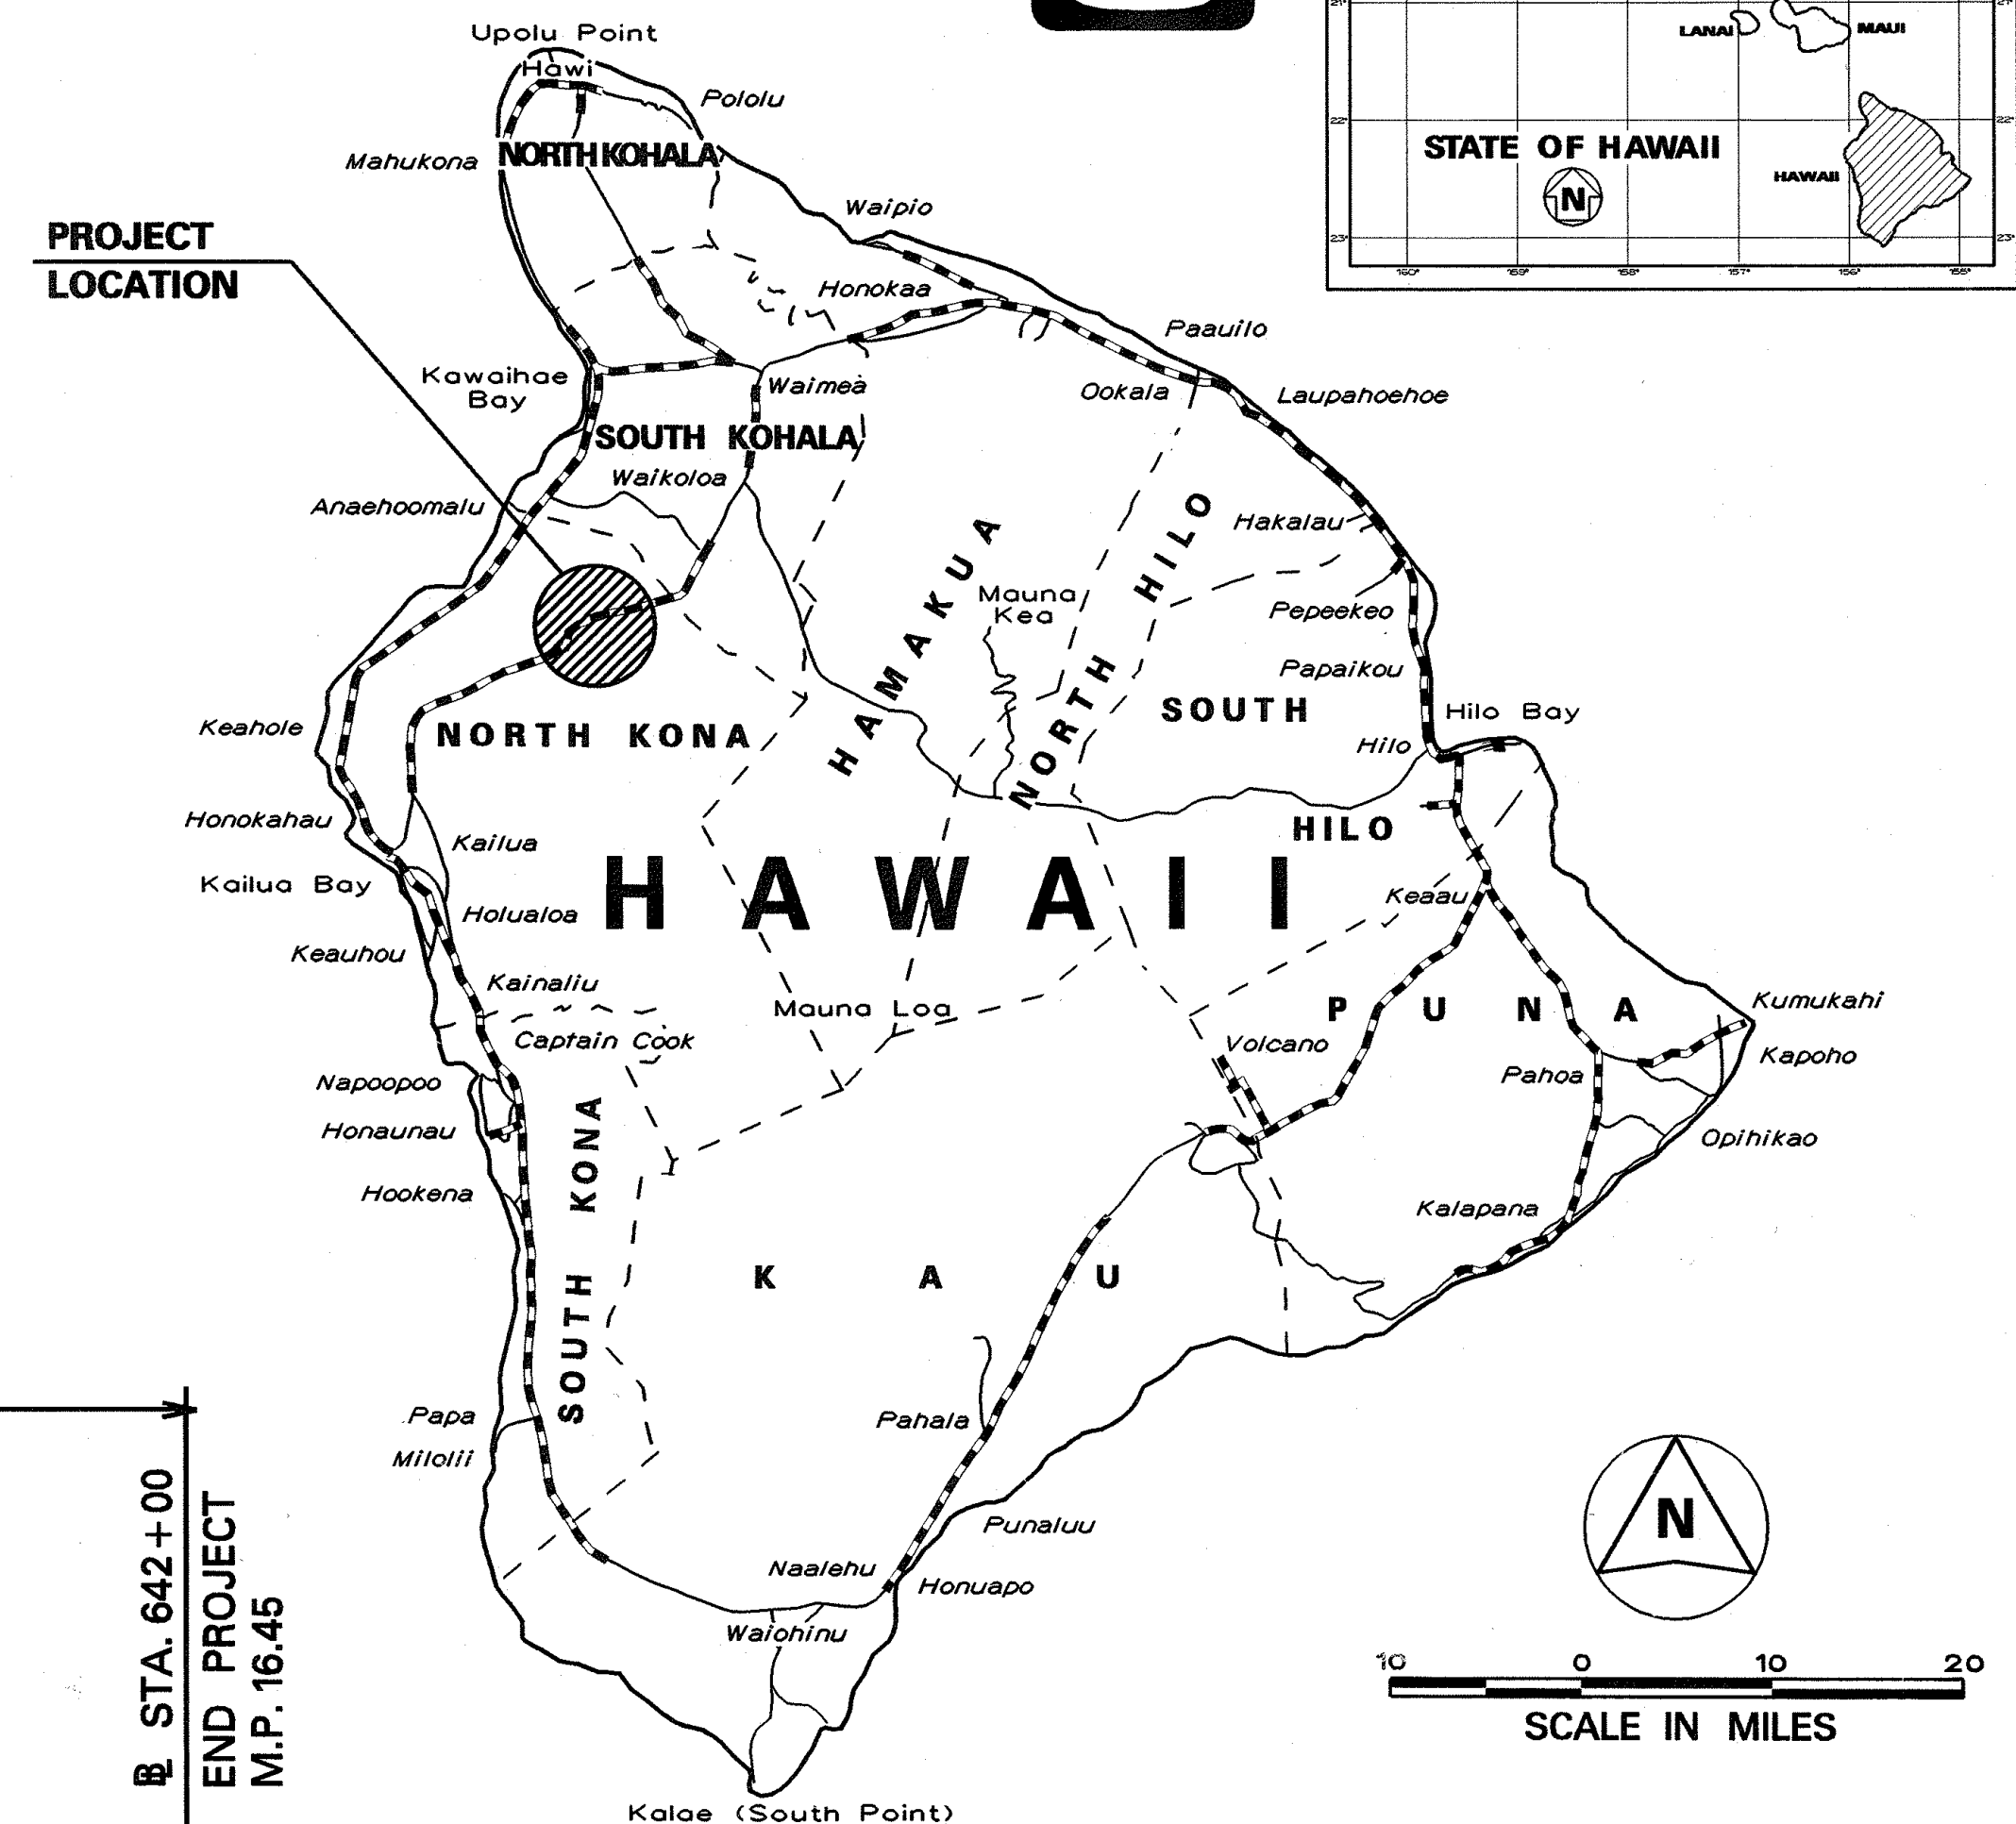


INDEX TO DRAWINGS	
SHEET NO.	DESCRIPTION
1	TITLE SHEET
2	STANDARD PLANS SUMMARY
3	GENERAL NOTES
4 - 5	WATER POLLUTION AND EROSION CONTROL NOTES
6	TYPICAL PAVEMENT REPAIR DETAIL SECTION
7 - 10	PAVEMENT REPAIR AREA SCHEDULE
11 - 12	STRIPING AND PAVEMENT MARKING SCHEDULE
13	CONSTRUCTION SIGN PLAN AND SCHEDULE

STATE OF HAWAII
DEPARTMENT OF TRANSPORTATION
HIGHWAYS DIVISION
HONOLULU, HAWAII
"AS-BUILT"
PLANS FOR
MAMALAHOA HIGHWAY, ROUTE 190
PAVEMENT REPAIRS
KA'UPULEHU TO PU'UANAHULU
PROJECT NO. 190BC-01-05M
DISTRICT OF NORTH KONA
ISLAND OF HAWAII

FED. ROAD DIST. NO.	STATE	PROJ. NO.	FISCAL YEAR	SHEET NO.	TOTAL SHEETS
HAWAII	HAW.	190BC-01-05M	2005	1	13

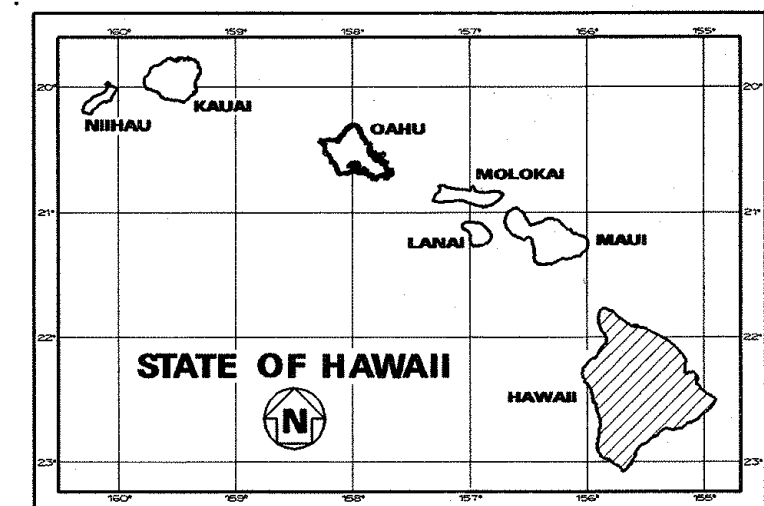

Hawaii District
DESIGNED BY

HWY. HE
MANAGED BY

933-9866
PHONE

April 2005
DATE

LAYOUT PLAN
GROSS LENGTH OF PROJECT.....11.18 MILES
NET LENGTH OF PROJECT.....11.18 MILES

FEDERAL AID PROJECTS PREVIOUSLY CONSTRUCTED OR UNDER CONSTRUCTION

MILE POST 27.63 TO MILE POST 16.45

CHANGES MADE DURING CONSTRUCTION HAVE BEEN INCORPORATED ON THESE PLANS EXCEPT CHANGES IN THE ORIGINAL THEORETICAL QUANTITIES. FOR ACTUAL QUANTITIES, REFER TO PROJECT LEDGER AND/OR COMPUTATION BOOK.
RESIDENT ENGINEER

DEPARTMENT OF TRANSPORTATION
STATE OF HAWAII
APPROVED:
4.27.05
DATE