



FED. ROAD DIST. NO.	STATE	PROJ. NO.	FISCAL YEAR	SHEET NO.	TOTAL SHEETS
HAWAII	HAW.	190BC-01-05M	2005	ADD.6	13

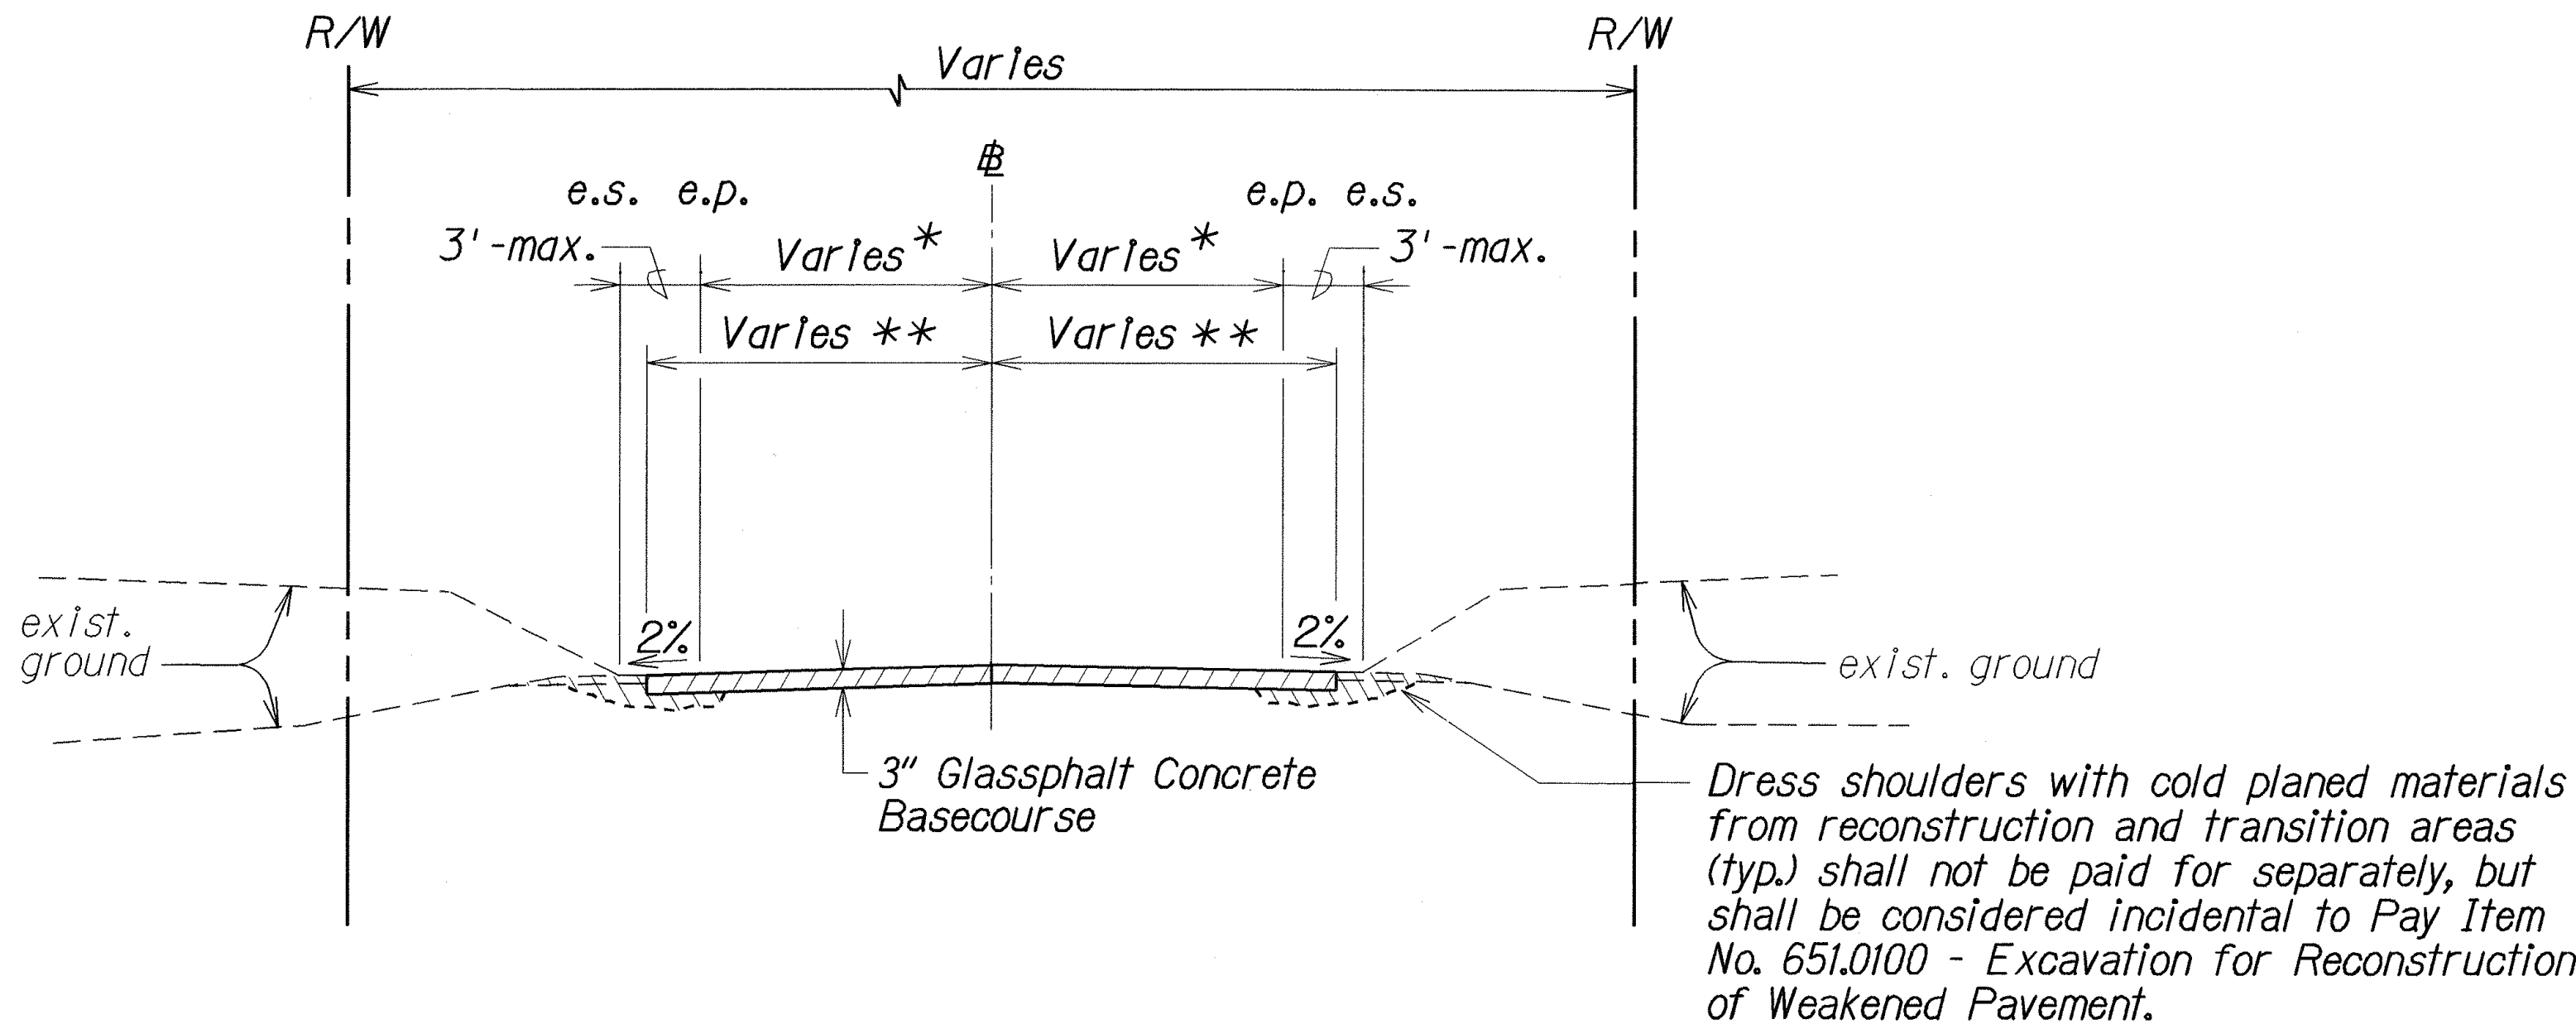


TYPICAL PAVEMENT REPAIR DETAIL SECTION
Not To Scale

- * 10ft. from Sta. 49+50 to Sta. 458+00
- * 10ft. from Sta. 458+00 to Sta. 642+00
- ** See Pavement Repair Area Schedule on Sheet ADD. 7.

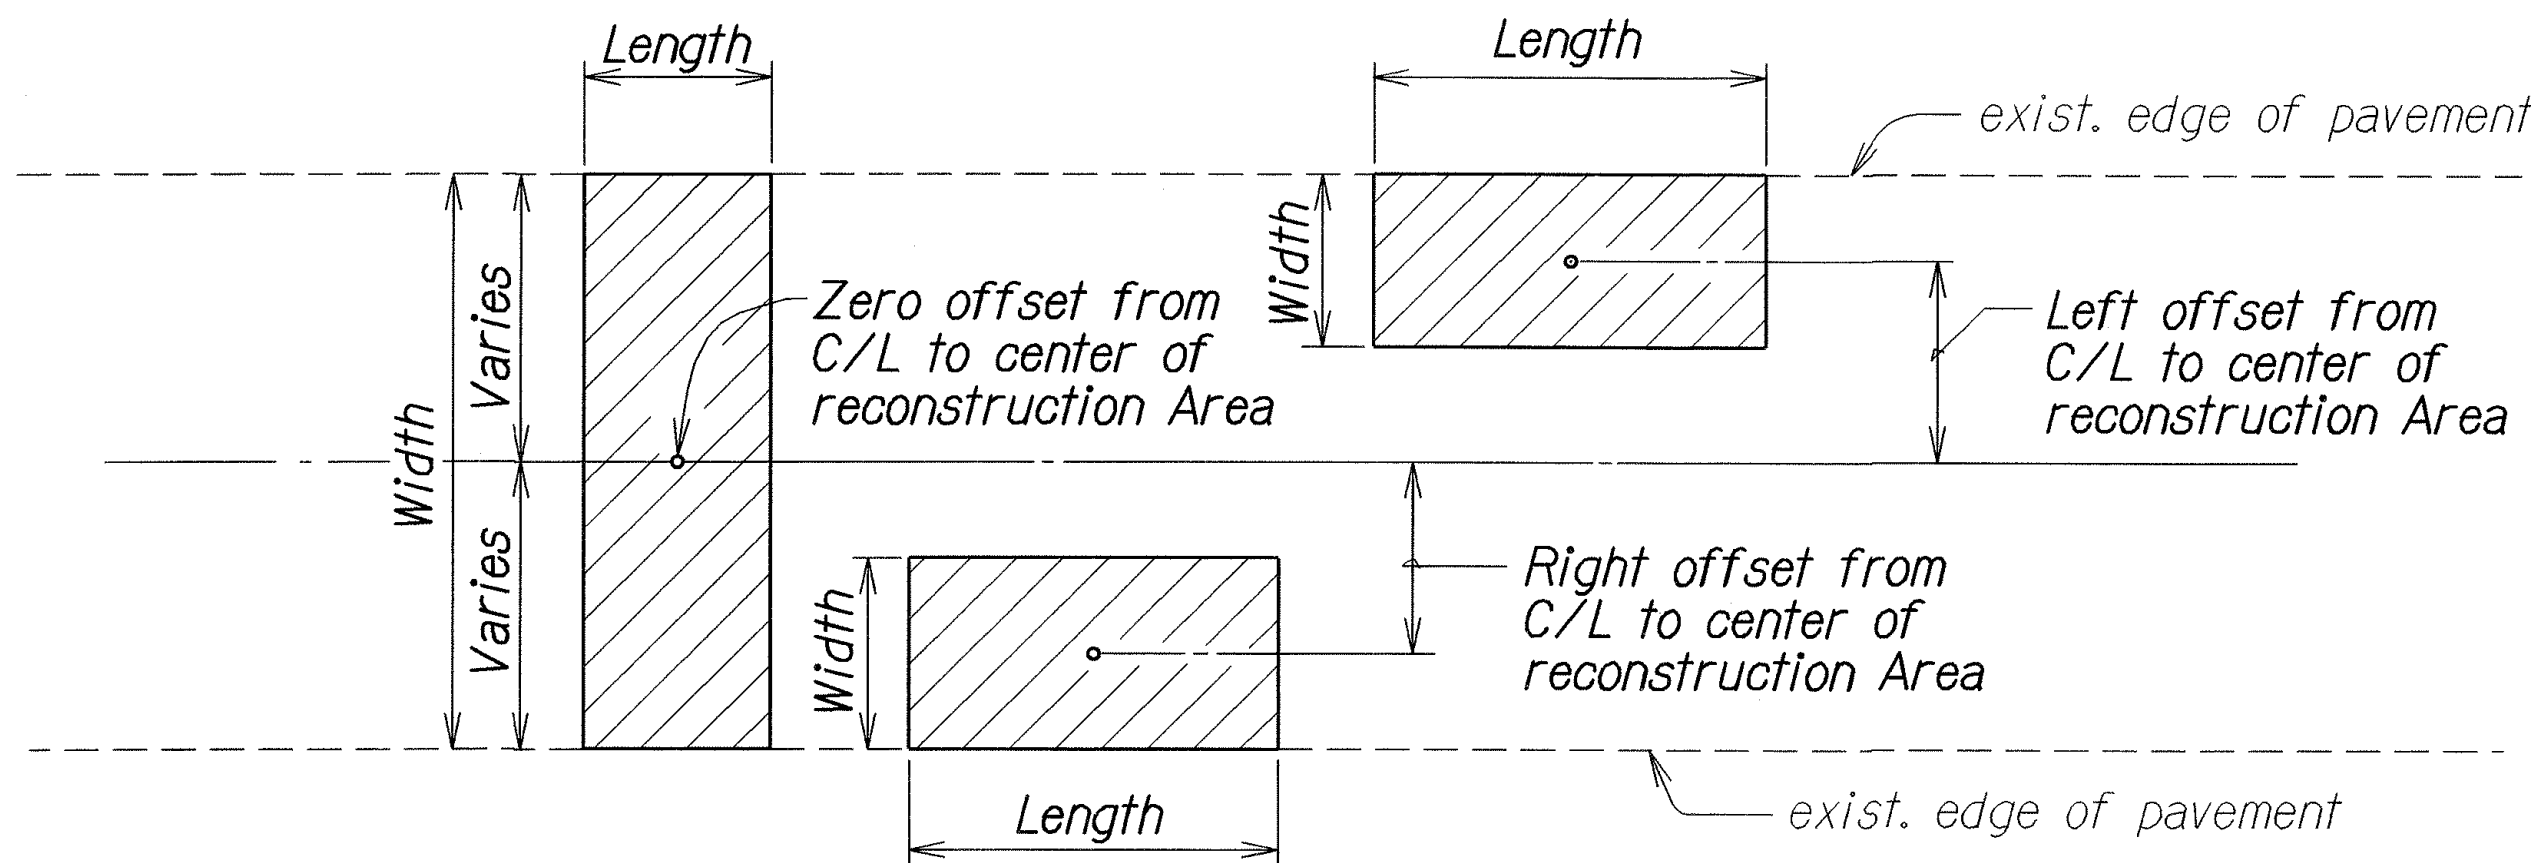

TYPICAL PLAN DETAIL "B"
Not To Scale

- NOTES**
- Dressing of shoulders shall consist of clearing, grubbing, grading reshaping and compacting the unpaved shoulders with suitable excavated material as shown on the plans and/or as directed by the Engineer. This work shall be considered incidental to the various contract items.
 - Suitable excavated materials, as determined by the Engineer, not used for fill or shoulder dressing purposes will be considered the property of the State and stockpiled at a location designated by the Engineer.
 - Excavating, placing, leveling, and compacting of suitable excavated material shall not be paid for separately, but shall be considered incidental to Pay Item No. 651.0100 - Excavation for Reconstruction of Weakened Pavement.
 - Compaction requirements of Cold Planed material shall be in accordance with Section 203 - Excavation and Embankment.
 - For location where existing shoulder are less than as shown in the typical section, Contractor's scope of work does not include roadway excavation outside the limits of existing shoulder areas. However, the scope of work in such areas, does include dressing of shoulder areas and pavement repair work within the limits shown on the plans or in areas designated by the Engineer.
 - The exact locations and limits of areas to be repaired and cold planed shall be determined in the field by the Engineer.

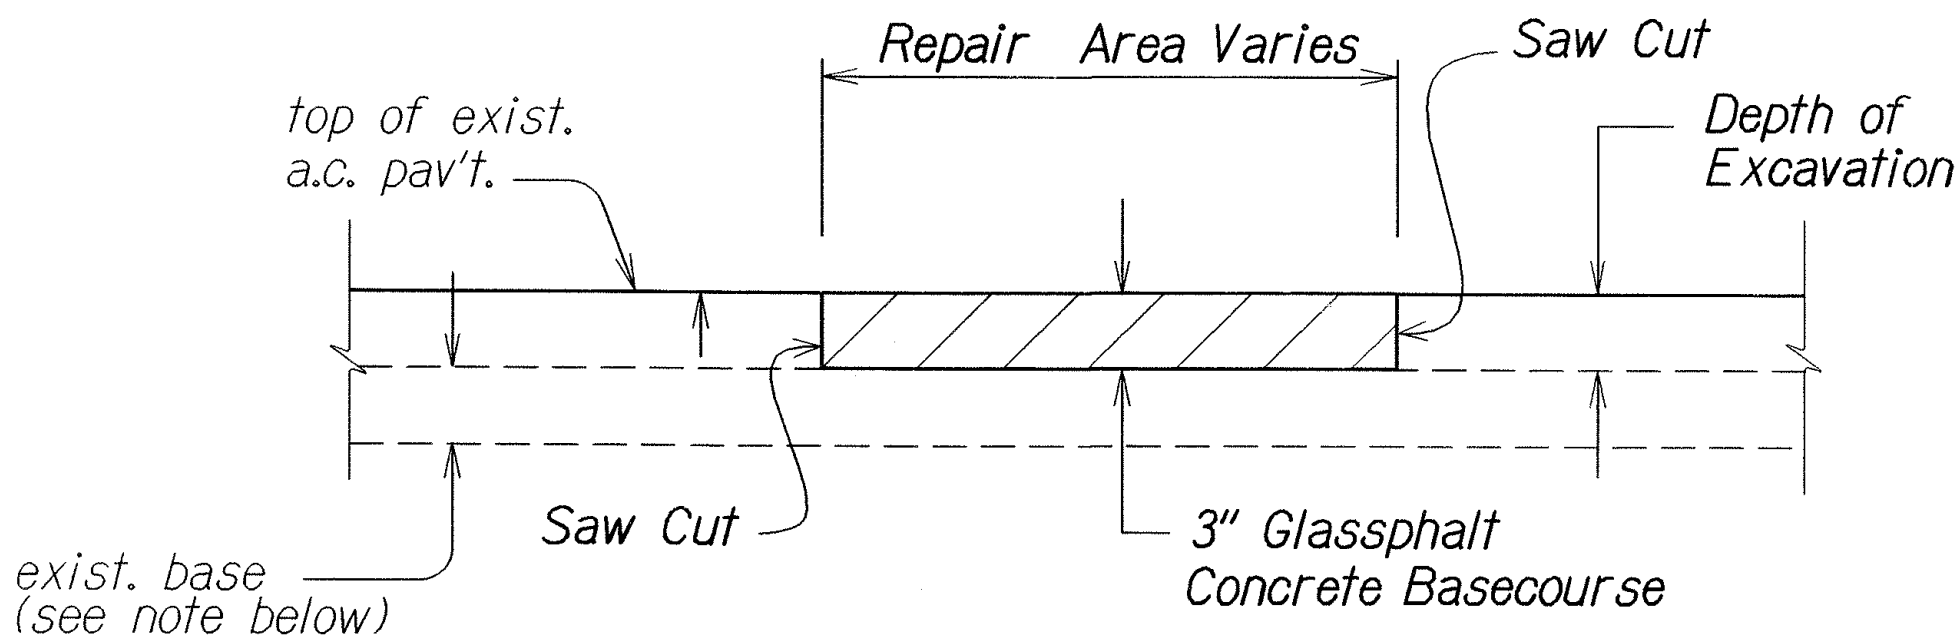

A.C. PAVEMENT REPAIR DETAIL
Not To Scale

Note: Contractor shall use caution to avoid disturbing macadam base in areas where such exists.

SURVEY PLOTTED BY	DATE
DRAWN BY	
NOTED BY	
CHECKED BY	
ORIGINAL PLAN	
NOTE BOOK	
QUANTITIES BY	
CHECKED BY	

LEGEND FOR AS-BUILT POSTINGS	
	Squiggly line for as-built deletion
	Double line for as-built deletion
Roadway	Text for as-built posting

06/14/05	Revised Typical Pavement Repair Detail Section and Notes.
DATE	REVISION
STATE OF HAWAII DEPARTMENT OF TRANSPORTATION HIGHWAYS DIVISION TYPICAL PAVEMENT REPAIR DETAIL SECTION MAMALAHOA HIGHWAY, ROUTE 190 PAVEMENT REPAIRS - KAUPULEHU TO PUUANAHULU PROJECT NO. 190BC-01-05M Scale: As Shown Date: April, 2005 SHEET No. 1 OF 1 SHEETS	