


FED. ROAD DIST. NO.	STATE	PROJ. NO.	FISCAL YEAR	SHEET NO.	TOTAL SHEETS
HAWAII	HAW.	190BC-01-06	2009	8	13

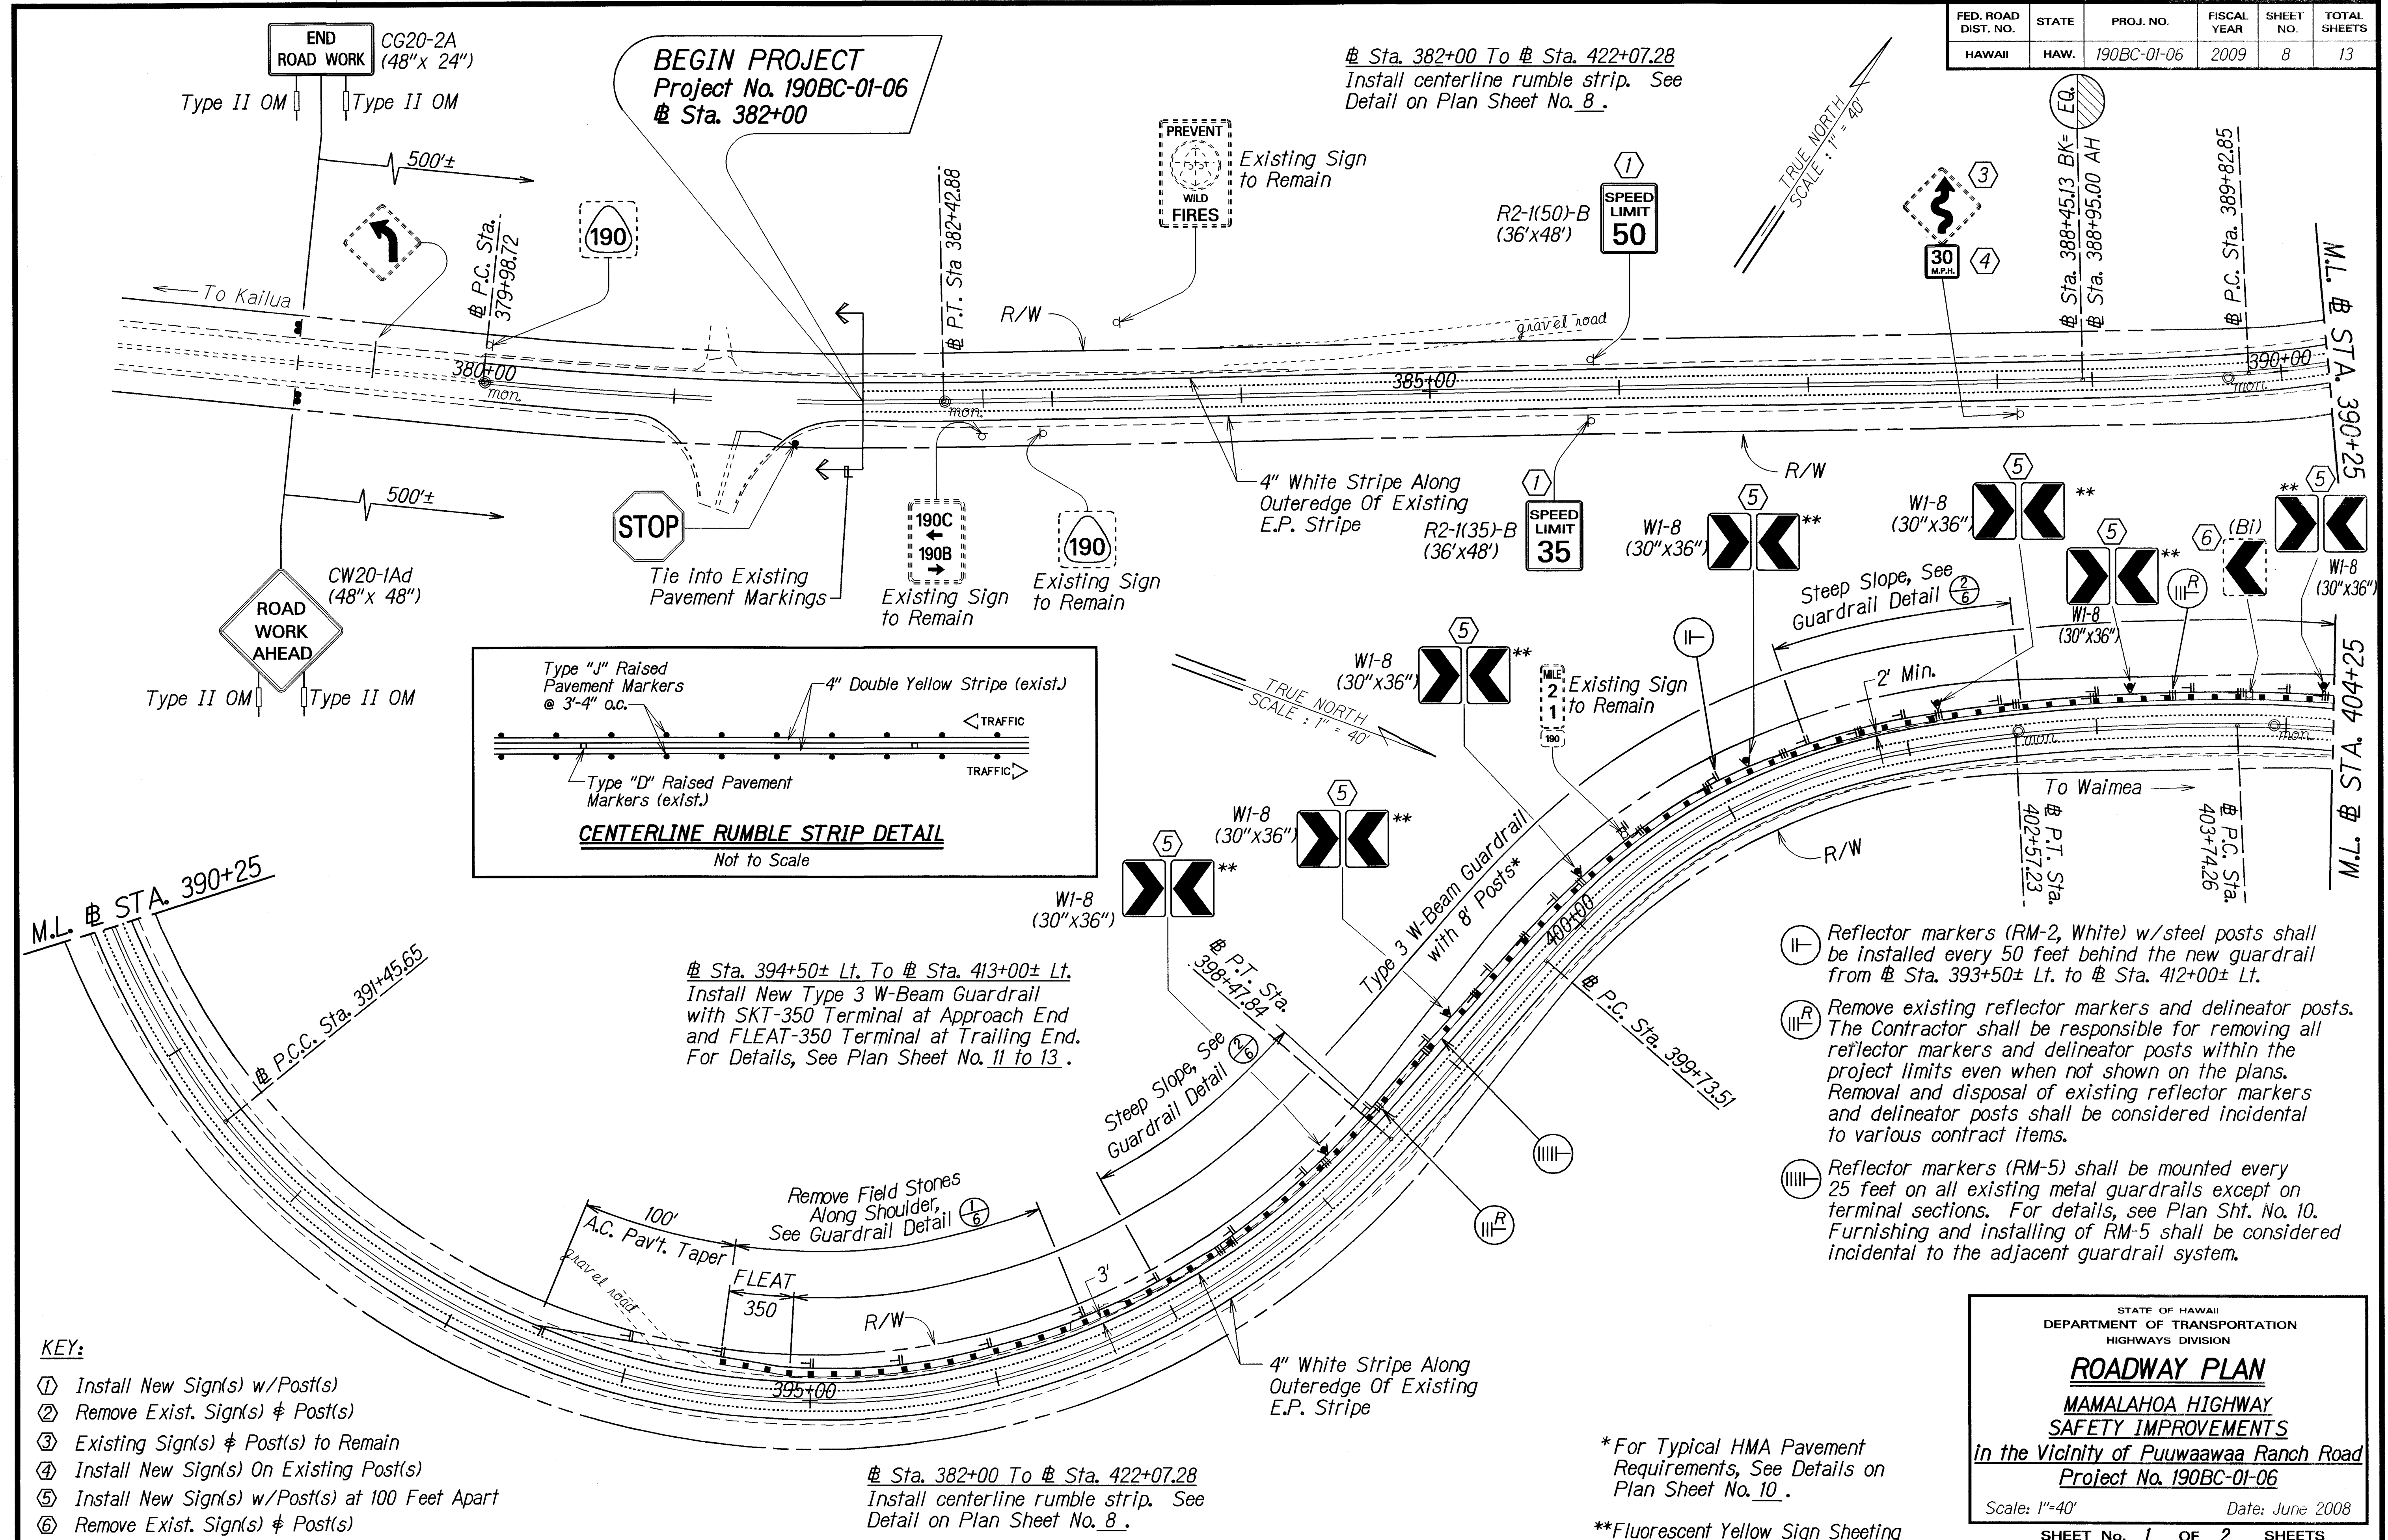

**Fluorescent Yellow Sign Sheeting

9