

INDEX TO DRAWINGS	
SHEET NO.	DESCRIPTION
1	TITLE SHEET
2	STANDARD PLANS SUMMARY
3	GENERAL NOTES
4 - 5	WATER POLLUTION AND EROSION CONTROL NOTES
6	TYPICAL SECTION AND DETAILS
7	WORK ZONE SIGNING PLAN, NOTES & DETAILS
8 - 9	ROADWAY PLANS
10 - 13	GUARDRAIL DETAILS & NOTES

STATE OF HAWAII

DEPARTMENT OF TRANSPORTATION

HIGHWAYS DIVISION

HONOLULU, HAWAII

"AS-BUILT"

PLANS FOR

MAMALAHOA HIGHWAY

SAFETY IMPROVEMENTS





IN THE VICINITY OF PU'UWA'AWA'A RANCH ROAD

PROJECT NO. 190BC-01-06

DISTRICT OF NORTH KONA

ISLAND OF HAWAII

FED. ROAD DIST. NO.	STATE	PROJ. NO.	FISCAL YEAR	SHEET NO.	TOTAL SHEETS
HAWAII	HAW.	190BC-01-06	2008	1	13

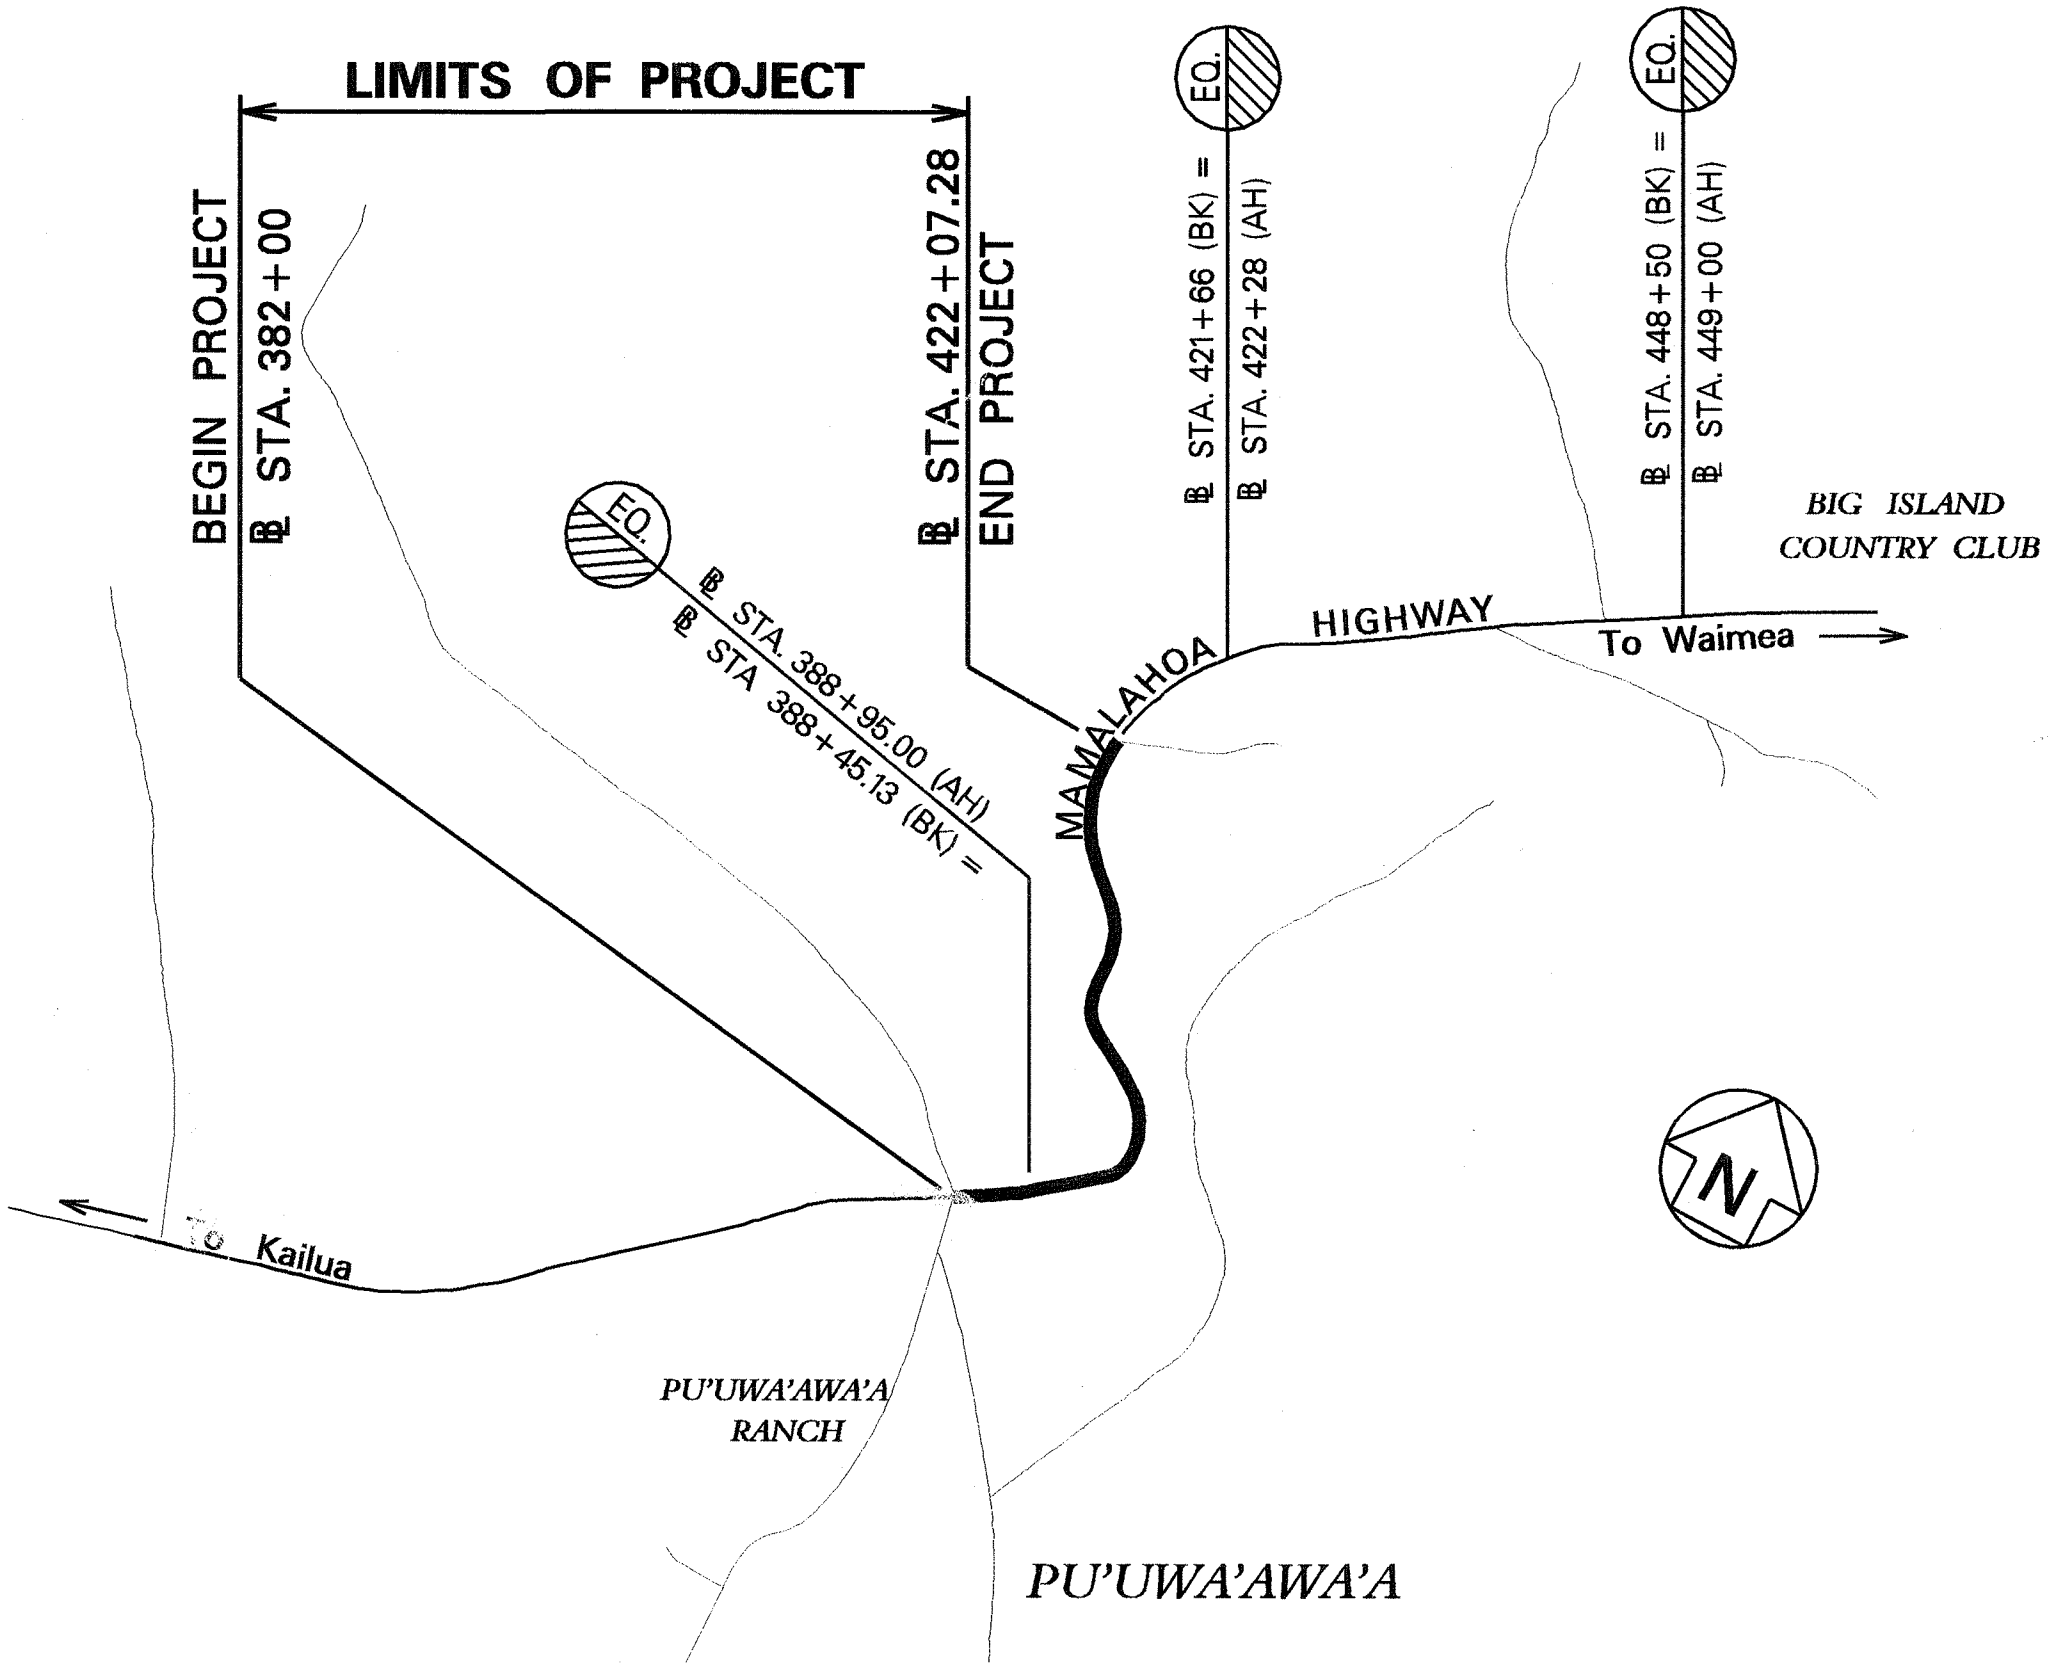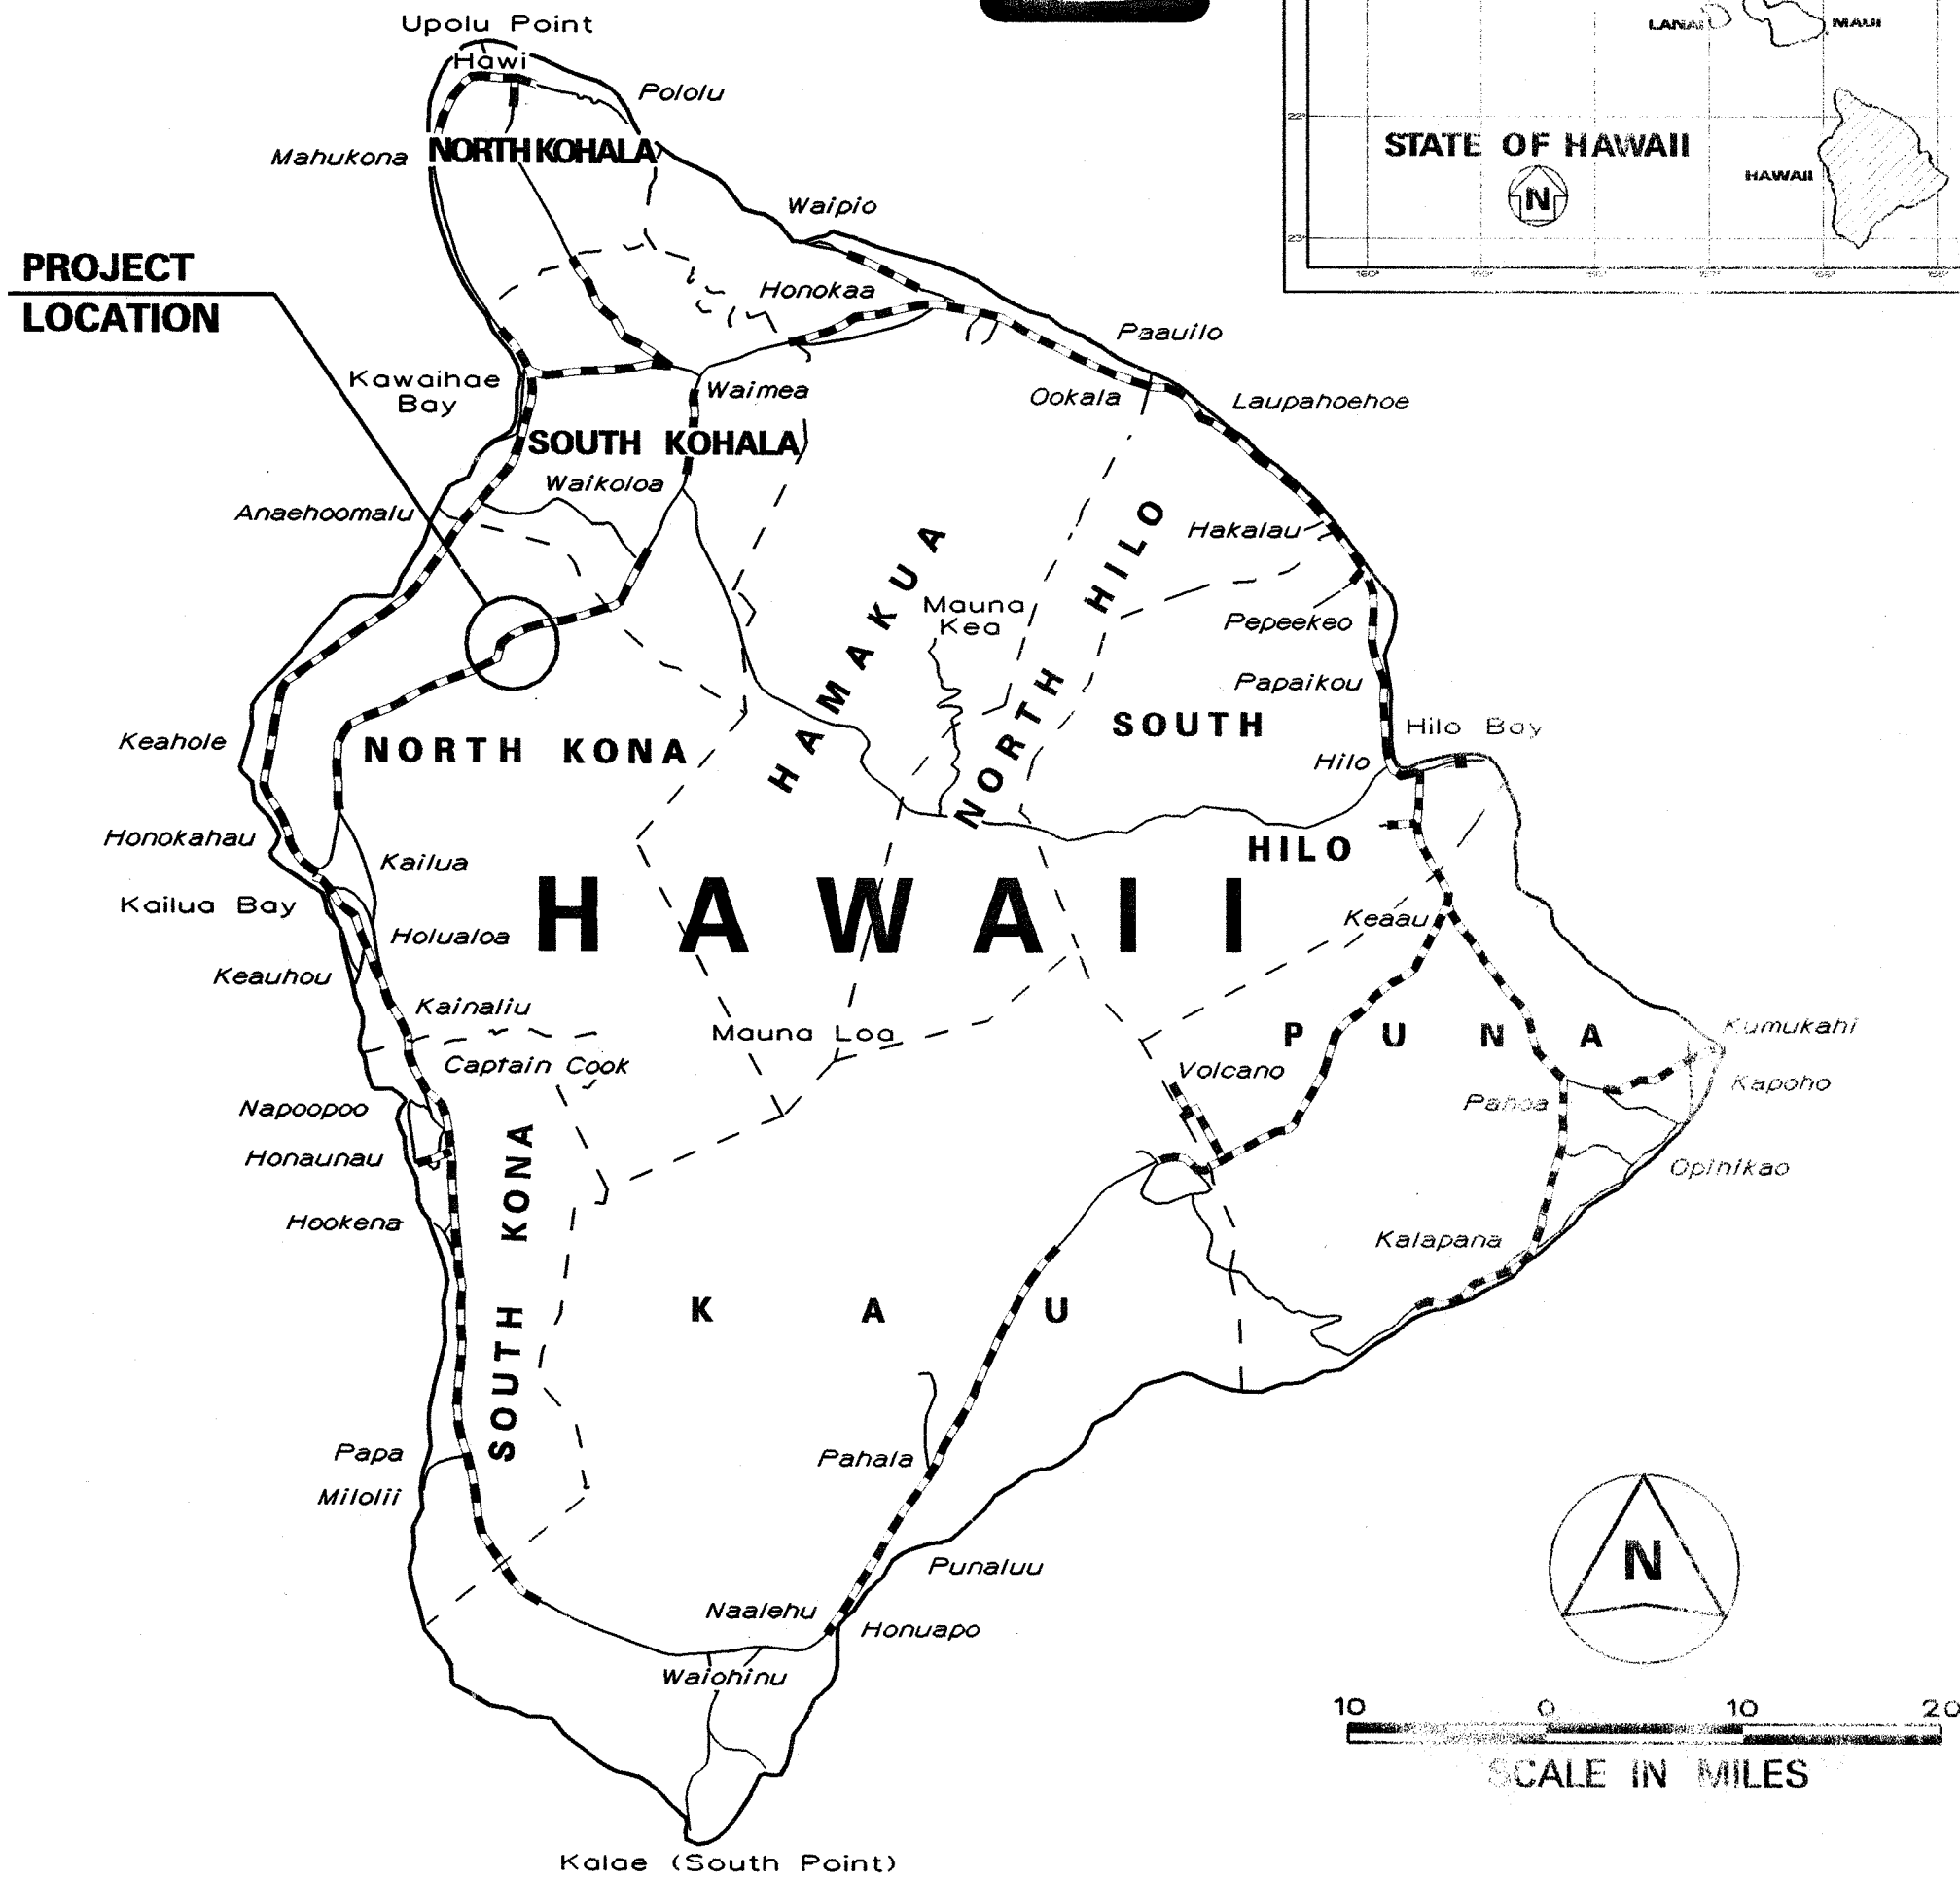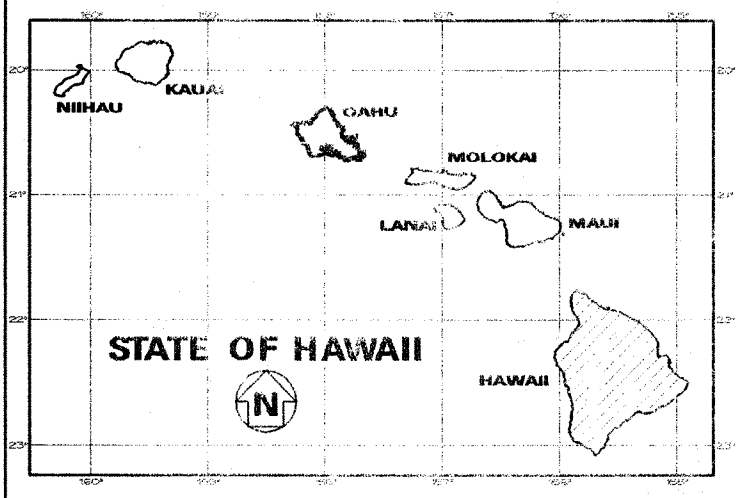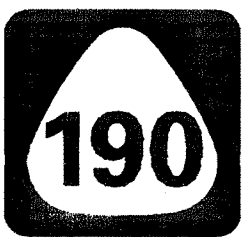

----- FEDERAL AID PROJECTS PREVIOUSLY CONSTRUCTED OR UNDER CONSTRUCTION

MILE POST 21.29 TO MILE POST 20.54


NO SIGNIFICANT CHANGES WERE MADE DURING CONSTRUCTION ON THESE PLANS EXCEPT CHANGES IN THE ORIGINAL THEORETICAL QUANTITIES. FOR ACTUAL QUANTITIES, REFER TO PROJECT LEDGER AND/OR COMPUTATION BOOK.

[Signature] 3/29/11
RESIDENT ENGINEER DATE

DEPARTMENT OF TRANSPORTATION
STATE OF HAWAII

APPROVED:
[Signature] 9-12-08
DIR. OF TRANSPORTATION DATE

DESIGNED BY
HWY-TD
MANAGED BY
692-7680
PHONE
SEPT. 2008
DATE

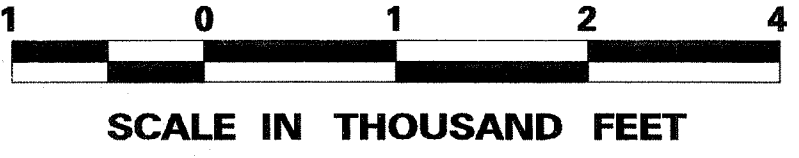

LAYOUT PLAN

GROSS LENGTH OF PROJECT.....0.76 MILES

NET LENGTH OF PROJECT.....0.76 MILES