

FED. ROAD DIST. NO.	STATE	PROJ. NO.	FISCAL YEAR	SHEET NO.	TOTAL SHEETS
HAWAII	HAW.	190BC-02-06M	2006	3	26

GENERAL NOTES

1. This project consists of leveling and resurfacing the existing pavement, cold planing transitions, construction of pullout areas, replacing and installing signs, pavement striping, and reflector markers.

2. The Contractor is reminded of the requirements of Subsection 108.01 - Subletting of Contract, which requires him to perform work amounting to not less than 30 percent of the total contract cost less deductible items. Non-compliance with this Subsection may be grounds for rejection of bid.

3. The Contractor's attention is directed to the following Sections of the Special Provisions: Subsection 107.13 - Public Convenience and Safety, Subsection 107.21 - Contractor's Responsibility for Utility Property and Services, and Section 645 - Traffic Control.

4. The Contractor shall notify the State in writing, two (2) weeks prior to starting paving repair operations.

5. At the end of each day's work, the Contractor shall remove all equipment and other obstructions to permit free and safe passage of public traffic.

6. The existence and location of underground utilities, manholes, monuments and structures may be determined from previous construction plans but the accuracy is not guaranteed. The encountering of other obstacles during the course of the work is possible. The Contractor shall be held liable for any damages incurred to the existing facilities and/or improvements as a result of his operations.

7. The exact locations and limits of areas to be repaired and cold planed shall be determined in the field by the Engineer.

8. Preformed Pavement Marking Tape shall be removed prior to resurfacing. Removal shall be by scraping, grinding or other method approved by the Engineer. Payment shall be incidental to Item No. 401.0400 - Asphalt Concrete Pavement, Mix No. IV.

9. The Contractor shall remove and dispose of all existing raised pavement markers prior to the overlaying of Asphalt Concrete. This work shall be considered incidental to Item No. 401.0400 - Asphalt Concrete Pavement, Mix No. IV.

10. Smooth riding connections shall be constructed at all limits of repair including the beginning and end of project shown on the plans and/or as directed by the Engineer.

11. Existing drainage system will be functional at all times during construction. Contractor is to furnish materials, equipment, labor, tools and incidentals necessary to maintain flow. This work shall be considered incidental to the various contract items.

12. Contractor shall provide for access to and from existing side streets and driveways at all times.

13. All saw cutting work shall be considered incidental to Item No. 401.0400 - Asphalt Concrete Pavement, Mix No. IV and will not be paid for separately.
14. Unprotected pavement dropoffs greater than 2" shall not be allowed during non-working hours, except where approved by the Engineer in writing.

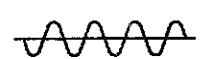
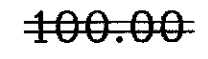
15. Public Notice is required for lane closures. Contractor shall submit notice to the Engineer for approval a minimum of three weeks prior to publication. Pre-approval of notice, with dates left blank, is permissible.

16. Cold-planing of 50-ft. transitions at project limits shall be considered incidental to Item No. 401.0400 - Asphalt Concrete Pavement, Mix No. IV.

17. Contractor shall maintain at least one paved shoulder free and clear of debris for pedestrian and bicycle traffic at all times.

18. Contractor is apprised of the proposed channelization of the Big Island County Club entrance, vicinity of Mile Post 20, timetable unknown. Contractor shall coordinate activities, as necessary, to minimize inconvenience to public traffic.

ORIGINAL PLAN	SURVEY PLOTTED BY	DATE
NOTE BOOK	DRAWN BY	
No. Delivered	DESIGNED BY	
	QUANTITIES BY	
	CHECKED BY	

LEGEND FOR AS-BUILT POSTINGS	
	Squiggly line for as-built deletion
	Double line for as-built deletion
Roadway	Text for as-built posting

STATE OF HAWAII
DEPARTMENT OF TRANSPORTATION
HIGHWAYS DIVISION

GENERAL NOTES

MAMALAHOA HIGHWAY
PAVEMENT PREVENTIVE MAINTENANCE
PU'UWA'AWA RANCH TO PU'UANAHULU

PROJECT NO. 190BC-02-06M

Scale: None

Date: April, 2006

SHEET No. 1 OF 1 SHEETS