

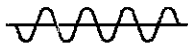
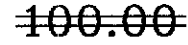
FED. ROAD DIST. NO.	STATE	PROJ. NO.	FISCAL YEAR	SHEET NO.	TOTAL SHEETS
HAWAII	HAW.	190BC-02-06M	2006	25	26

CENTERLINE AND REFERENCE SURVEY MONUMENT SCHEDULE					
STATION	MONUMENT TYPE	ADJUST CENTERLINE AND REFERENCE MON. (ITEM NO. 613.0110)	RECONSTRUCT CENTERLINE AND REFERENCE MON. (ITEM NO. 613.0120)	CENTERLINE OFFSET (FT.)	EXISTING DEPTH (FT.)
End Project - Sta. 642+00					
640+57.10	P.C.	1			
640+56.30	P.T.	1			
625+70.25	P.C.	1			
608+33.70 AH 608+26.41 BK	P.T.	1			
603+33.70	P.C.	1			
591+63.80 AH 591+53.05 BK	P.T.	1			
581+48.90	P.C.	1			
553+25.24	P.T.	1			
551+09.75	P.C.	1			
536+95.18	P.T.	1			
531+66.00	P.C.	1			
508+80.3	P.O.T.	1			
495+11.44	P.O.T.	1			
477+00.39	P.O.T.	1			
460+52.18	P.T.	1			
459+51.87	P.C.	1			
425+59.10	P.C.	1			
430+00.65	P.T.	1			
407+64.20 AH 407+57.70 BK	P.T.	1			
405+52.59	P.C.	1			
405+12.44	P.T.	1			
403+52.59	P.C.	1			
402+16.7	P.T.	1			
389+21.08	P.C.	1			
382+42.48	P.T.	1			
379+98.72	P.C.	1			
Begin Project - Sta. 380+00					
TOTALS		24			

ROUTE MARKER SCHEDULE						
STATION	SOUTH BOUND LAND	NORTH BOUND LAND	ROUTE MARKER SIGN NO. (ROUTE NO.)	REMOVE	INSTALL TYPE A ASSEMBLY	RM-3 WO/ POST
380+00		●	M1-6 (190)	1	1	
382+95	●		M1-6 (190)	1	1	
			TOTALS	2	2	
CONTRACT ITEM NUMBER					621B.6110	

MILEPOST MARKER SCHEDULE						
STATION	SOUTH BOUND LAND	NORTH BOUND LAND	MILE POST D10-2 (12"X36") MILE POST NO. (RTE. NO.)	REMOVE	INSTALL WITH POST (Bi-Dir)	RM-3 WO/ POST
613+10		●	17 (190)	1	1	
560+20		●	18 (190)	1	1	
505+05		●	19 (190)	1	1	
454+43		●	20 (190)	1	1	
400+50	●		21 (190)	1	1	
			TOTALS	5	5	
CONTRACT ITEM NUMBER					621C.7610	

ORIGINAL PLAN	SURVEY PLOTTED BY	DATE
NOTE BOOK	DESIGNED BY	
IN	QUANTITIES BY	
	CHECKED BY	

LEGEND FOR AS-BUILT POSTINGS	
	Squiggly line for as-built deletion
	Double line for as-built deletion
Roadway	Text for as-built posting

STATE OF HAWAII DEPARTMENT OF TRANSPORTATION HIGHWAYS DIVISION
MISCELLANEOUS SCHEDULES
MAMALAHOA HIGHWAY PAVEMENT PREVENTIVE MAINTENANCE PU'UWA'AWA'A RANCH TO PU'UANAHULU PROJECT NO. 190BC-02-06M
Scale: None Date: April, 2006
SHEET No. 1 OF 1 SHEETS