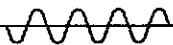
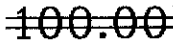


FED. ROAD DIST. NO.	STATE	PROJ. NO.	FISCAL YEAR	SHEET NO.	TOTAL SHEETS
HAWAII	HAW.	190BC-01-06M	2006	23	26

REFLECTOR AND OBJECT MARKER SCHEDULE																
STATION		South Bound Lane	North Bound Lane	RM-2 (White)			RM-3 (Yellow)		RM-3 (Bi-dir) (Yellow)		RM-4		TYPE II (Bi-dir)		RM-5	REMARKS
FROM	TO			STEEL POST	FLEX POST	W/OUT POST	FLEX POST	W/OUT POST	FLEX POST	W/OUT POST	STEEL POST	W/OUT POST	FLEX POST	W/OUT POST	W/OUT POST	
640+20			●						1							
638+35			●						1							
636+35			●						1							
635+55			●				1									
634+60		●							1							
628+30	629+80	●	⊗				4									
621+30	623+80	●					3									
621+35	622+65		●				2									
612+55		●					1									
610+55	612+70		●				3									
610+45		●					1									
605+00	607+10	●					3									
553+55	554+40	●					2									
534+65	535+70	●					2									
525+90			●						1							
521+50	525+50	●			4											
491+75		●					1									
472+35			●				1									
469+85	472+25	●					3									
466+25		●					1									
461+50	463+85	●					3									
455+73		⊗							±							
426+15	427+55		●				5									
425+60			●				1									
407+44		●							1							
406+87		●					1									
406+37		●							1							
405+85		●							1							
405+00		●							1							
404+61		●							1							
405+40		●							1							
400+00		●					1									
403+53		●							1							

(Continued)

LEGEND FOR AS-BUILT POSTINGS	
	Squiggly line for as-built deletion
	Double line for as-built deletion
Roadway	Text for as-built posting

STATE OF HAWAII
DEPARTMENT OF TRANSPORTATION
HIGHWAYS DIVISION
REFLECTOR AND OBJECT MARKER SCHEDULE
MAMALAHOA HIGHWAY
PAVEMENT PREVENTIVE MAINTENANCE
PU'UWA'AWA RANCH TO PU'UANAHULU
PROJECT NO. 190BC-02-06M

Scale: As Shown Date: April, 2006

SHEET No. 1 OF 2 SHEETS

"AS-BUILT"



23

ORIGINAL PLAN	SURVEY PLOTTED BY	DATE
NOTED	DRAWN BY	
DESIGNED BY	TRACED BY	
QUANTITIES BY		
CHECKED BY		

FED. ROAD DIST. NO.	STATE	PROJ. NO.	FISCAL YEAR	SHEET NO.	TOTAL SHEETS
HAWAII	HAW.	190BC-01-06M	2006	24	26

REFLECTOR AND OBJECT MARKER SCHEDULE																
STATION		South Bound Lane	North Bound Lane	RM-2 (White)			RM-3 (Yellow)		RM-3 (Bi-dir) (Yellow)		RM-4		TYPE II (Bi-dir)		RM-5	REMARKS
FROM	TO			STEEL POST	FLEX POST	W/OUT POST	FLEX POST	W/OUT POST	FLEX POST	W/OUT POST	STEEL POST	W/OUT POST	FLEX POST	W/OUT POST	W/OUT POST	
402+73		●							1							
401+52	402+08	●							2							
400+58	400+86	●							2							
399+15	399+80	●							2							
398+10	410+50	●					32									
397+43		●							1							
Totals					4		71		202±							

ORIGINAL PLAN	SURVEY PLOTTED BY	DATE
NOTE BOOK	DRAWN BY	
DESIGNED BY	TRACED BY	
CHECKED BY	DESIGNED BY	
	CHECKED BY	

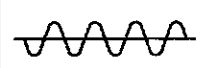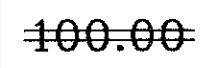LEGEND FOR AS-BUILT POSTINGS	
	Squiggly line for as-built deletion
	Double line for as-built deletion
Roadway	Text for as-built posting

STATE OF HAWAII
DEPARTMENT OF TRANSPORTATION
HIGHWAYS DIVISION

REFLECTOR AND OBJECT
MARKER SCHEDULE

MAMALAHOA HIGHWAY
PAVEMENT PREVENTIVE MAINTENANCE
PU'UWA'AWA RANCH TO PU'UANAHULU
PROJECT NO. 190BC-02-06M

Scale: As Shown Date: April, 2006

SHEET No. 2 OF 2 SHEETS