

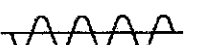
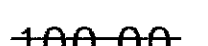
FED. ROAD DIST. NO.	STATE	PROJ. NO.	FISCAL YEAR	SHEET NO.	TOTAL SHEETS
HAWAII	HAW.	190BC-02-06M	2006	20	26

SIGN REPLACEMENT, REMOVAL, AND INSTALLATION SCHEDULE

STATION	South Bound Lane	North Bound Lane	TYPE	SIGN TO REMAIN	REMOVE	INSTALL (10 SQ. FT. OR LESS)		INSTALL (GREATER THAN 10 SQ. FT.)		RM-3 W/O POST
						W/POST	W/O POST	W/POST(S)	W/O POST	
End Project Sta. 642+00										
619+06		●	W1-5 (30"x 30")		1	1				1
613+68	●		"Adopt-A-Highway"		2		1	1		2
613+50	●		W1-2R (30"x 30")		1	1				1
597+90		●	W1-2R (30"x 30")		1	1				1
506+15	●	●	"Adopt-A-Highway"		2		2±	2±		2
474+20	●		W3-5(35) (48" X 48")					1		1
467+12	●		W11-3(1) (30"x 30")/W11-3(1)P (18"X24")		1	1		1		1
466+00	●		R2-1(35) (36" X 40")							1
466+00	●		R2-1(50) (36" X 40")							1
462+18	●		W2-2 (30"x 30")		1	1				1
455+73	●		R1-1 (30"x 30")		1	1				1
450+70		●	W2-2 (30"x 30")		1	1				1
446+15	●		W2-2 (30"x 30")		1	1				1
443+00	●		W3-5(35) (48" x 48")					1		1
441+22		●	R1-1 (30"x 30")		1	1				1
440+78	●		W2-2 (30"x 30")		1	1				1
436+60		●	W2-2 (30"x 30")		1	1				1
436+00	●		R2-1(35) (36"x 48")					1		1
436+00		●	R2-1(50) (36"x 48")					1		1
435+21	●		R1-1 (30"x 30")		1	1				1
434+52	●		W1-2 (30"x 30")/ W13-1(35) (24"x 24")		2					
430+20		●	W2-2 (30"x 30")		1	1				1
429+98	●		W1-8 (18"x 24")		1	1				1
428+95	●		W1-8 (18"x 24")		1	1				1
428+27	●		W1-8 (18"x 24")		1	1				1
427+38	●		W1-8 (18"x 24")		1	1				1
426+37	●		W1-8 (18"x 24")		1	1				1
425+43	●		W1-2 (30"x 30")/ W13-1(35) (24"x 24")		2					
424+67		●	W11-3(1) (30"x 30")/W11-3(1)P (18"X24")		1	1	1			1
421+25	●		W1-8 (18"x 24")		1	1				1
420+38	●		W1-8 (18"x 24")		1	1				1
419+39	●		W1-8 (18"x 24")		1	1				1
416+48	●		W1-8 (18"x 24")		1	1				1
415+32	●		W1-8 (18"x 24")		1	1				1
414+50	●		W1-8 (18"x 24")		1	1				1
413+11		●	"Adopt-A-Highway"		2		1	1		2
412+87	●		W1-5 (30"x 30")/ W13-1(35) (24"x 24")		2					

STATION	South Bound Lane	North Bound Lane	TYPE	SIGN TO REMAIN	REMOVE	INSTALL (10 SQ. FT. OR LESS)		INSTALL (GREATER THAN 10 SQ. FT.)		RM-3 W/O POST
						W/POST	W/O POST	W/POST(S)	W/O POST	
412+45	●		W1-8 (18"x 24")		1	1	1			1
404+56	●		"Adopt-A-Highway"		2		1	1		2
404+30	●		W1-8 (18"x 24")		1	1	1			1
403+78	●		W1-8 (18"x 24")		1	1	1			1
387+97		●	W1-5 (30"x 30")/ W13-1(35) (24"x 24")		2					
385+85	●		R2-1(50) (36"x 48")						1	1
385+85		●	R2-1(35) (36"x 48")						1	1
382+95		●	M1-6 (24"x 24")		1	1				1
382+63		●	"190C -> / 190B <- "	1						
381+55		●	R1-1 (30"x 30")		1	1				1
380+00	●		M1-6 (24"x 24")		1	1				1
Begin Project Sta. 380+00										
Totals				1	47	31	9	9		44

ORIGINAL PLAN	SURVEY PLOTTED BY	DATE
NOTE BOOK	DRAWN BY	
DESIGNED BY	TRACED BY	
CHECKED BY	DESIGNED BY	
	CHECKED BY	

LEGEND FOR AS-BUILT POSTINGS	
	Squiggly line for as-built deletion
	Double line for as-built deletion
Roadway	Text for as-built posting

STATE OF HAWAII
DEPARTMENT OF TRANSPORTATION
HIGHWAYS DIVISION

SIGN SCHEDULE

MAMALAHOA HIGHWAY
PAVEMENT PREVENTIVE MAINTENANCE
PU'UWA'AWA RANCH TO PU'UANAHULU
PROJECT NO. 190BC-02-06M

Scale: None

Date: April, 2006

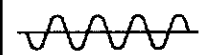
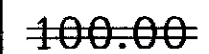
SHEET No. 1 OF 2 SHEETS

"AS-BUILT"

FED. ROAD DIST. NO.	STATE	PROJ. NO.	FISCAL YEAR	SHEET NO.	TOTAL SHEETS
HAWAII	HAW.	190BC-02-06M	2006	21	26

SIGN REPLACEMENT, REMOVAL, AND INSTALLATION SCHEDULE										
STATION	South Bound Lane	North Bound Lane	TYPE	SIGN TO REMAIN	REMOVE	INSTALL (10 SQ. FT. OR LESS)		INSTALL (GREATER THAN 10 SQ. FT.)		RM-3 W/O POST
						W/POST	W/O POST	W/POST(S)	W/O POST	
Additional Work Beyond the Project Limits										
429+18	●		R2-1(50) (36"x 48")					1		1
429+18	●		R2-1(55)a		1					
426+50		●	W3-5 (48"x 48")					1		1
426+50		●	R2-5a		1					
594+00		●	W13-1(45) (48"x 48")							
253+00	●		R2-1(50) (36"x 48")					1		1
253+00		●	R2-1(50) (36"x 48")					1		1
253+00	●		R2-1(55) (36"x 48")		1					
253+00		●	R2-1(55) (36"x 48")		1					
157+00		●	W1-4 (30"x 30")/ W13-1(35) (24"x 24")					1		1
157+00		●	W1-2 (30"x 30")/ W13-1(25) (24"x 24")		1					
115+00	●		R2-1(50) (36"x 48")					1		1
229+00		●	R2-1(50) (36"x 48")					1		1
229+00	●		R2-1(50) (36"x 48")					1		1
229+00		●	R2-1(55) (36"x 48")		1					
229+00	●		R2-1(55) (36"x 48")		1					
147+50		●	R2-1(50) (36"x 48")					1		1
125+00	●		R2-1(50) (36"x 48")					1		1
110+00 117+50	●		R2-1(50) (36"x 48")					1		1
110+00 117+50		●	R2-1(50) (36"x 48")					1		1
110+00 117+50	●		R2-1(55) (36"x 48")		1					
110+00 117+50		●	R2-1(55) (36"x 48")		1					
665+95	●		R2-1(50) (36"x 48")					1		1
665+95		●	R2-1(50) (36"x 48")					1		1
665+95	●		R2-1(55) (36"x 48")		1					
665+95		●	R2-1(55) (36"x 48")		1					
664+60	●		R2-4(40) (36"x 48")		1					
664+50		●	R2-1(55) (36"x 48")		1					
663+00	●		R2-1(55) (36"x 48")		1					
656+35	●		R2-4(40) (36"x 48")		1					
Totals					15			14		14

DESIGNED BY	DATE
DRAWN BY	
CHECKED BY	
NOTED BY	
QUANTITIES BY	
REVISIONS	

LEGEND FOR AS-BUILT POSTINGS	
	Squiggly line for as-built deletion
	Double line for as-built deletion
Roadway	Text for as-built posting

STATE OF HAWAII DEPARTMENT OF TRANSPORTATION HIGHWAYS DIVISION
SIGN SCHEDULE
MAMALAHOA HIGHWAY PAVEMENT PREVENTIVE MAINTENANCE PU'UWA'AWA RANCH TO PU'UANAHULU PROJECT NO. 190BC-02-06M
Scale: None Date: April, 2006
SHEET No. 2 OF 2 SHEETS