

| INDEX TO DRAWINGS |                                           |
|-------------------|-------------------------------------------|
| SHEET NO.         | DESCRIPTION                               |
| 1                 | TITLE SHEET                               |
| 2                 | STANDARD PLANS SUMMARY                    |
| 3                 | GENERAL NOTES                             |
| 4 - 5             | WATER POLLUTION AND EROSION CONTROL NOTES |
| 6                 | PAVEMENT MARKING LEGEND AND NOTES         |
| ① 7               | TYPICAL SECTION AND DETAILS               |
| 8-19              | ROADWAY PLANS                             |
| 20 - 21           | SIGN SCHEDULE                             |
| 22                | STRIPING AND PAVEMENT MARKING SCHEDULE    |
| 23 - 24           | REFLECTOR AND OBJECT MARKER SCHEDULE      |
| 25                | MISCELLANEOUS SCHEDULES                   |
| 26                | CONSTRUCTION SIGN PLAN AND SCHEDULE       |

Sheet No. ① is a Supplementary Sheet to this project. Total sheet count after "AS-BUILT" posting is 27 sheets.

STATE OF HAWAII

DEPARTMENT OF TRANSPORTATION

HIGHWAYS DIVISION

HONOLULU, HAWAII

"AS-BUILT"

PLANS FOR

MAMALAHOA HIGHWAY

PAVEMENT PREVENTIVE MAINTENANCE




PU'UWA'AWA'A RANCH TO PU'UANAHULU

PROJECT NO. 190BC-02-06M

DISTRICT OF NORTH KONA

ISLAND OF HAWAII

| FED. ROAD DIST. NO. | STATE | PROJ. NO.    | FISCAL YEAR | SHEET NO. | TOTAL SHEETS |
|---------------------|-------|--------------|-------------|-----------|--------------|
| HAWAII              | HAW.  | 190BC-02-06M | 2006        | 1         | 26           |

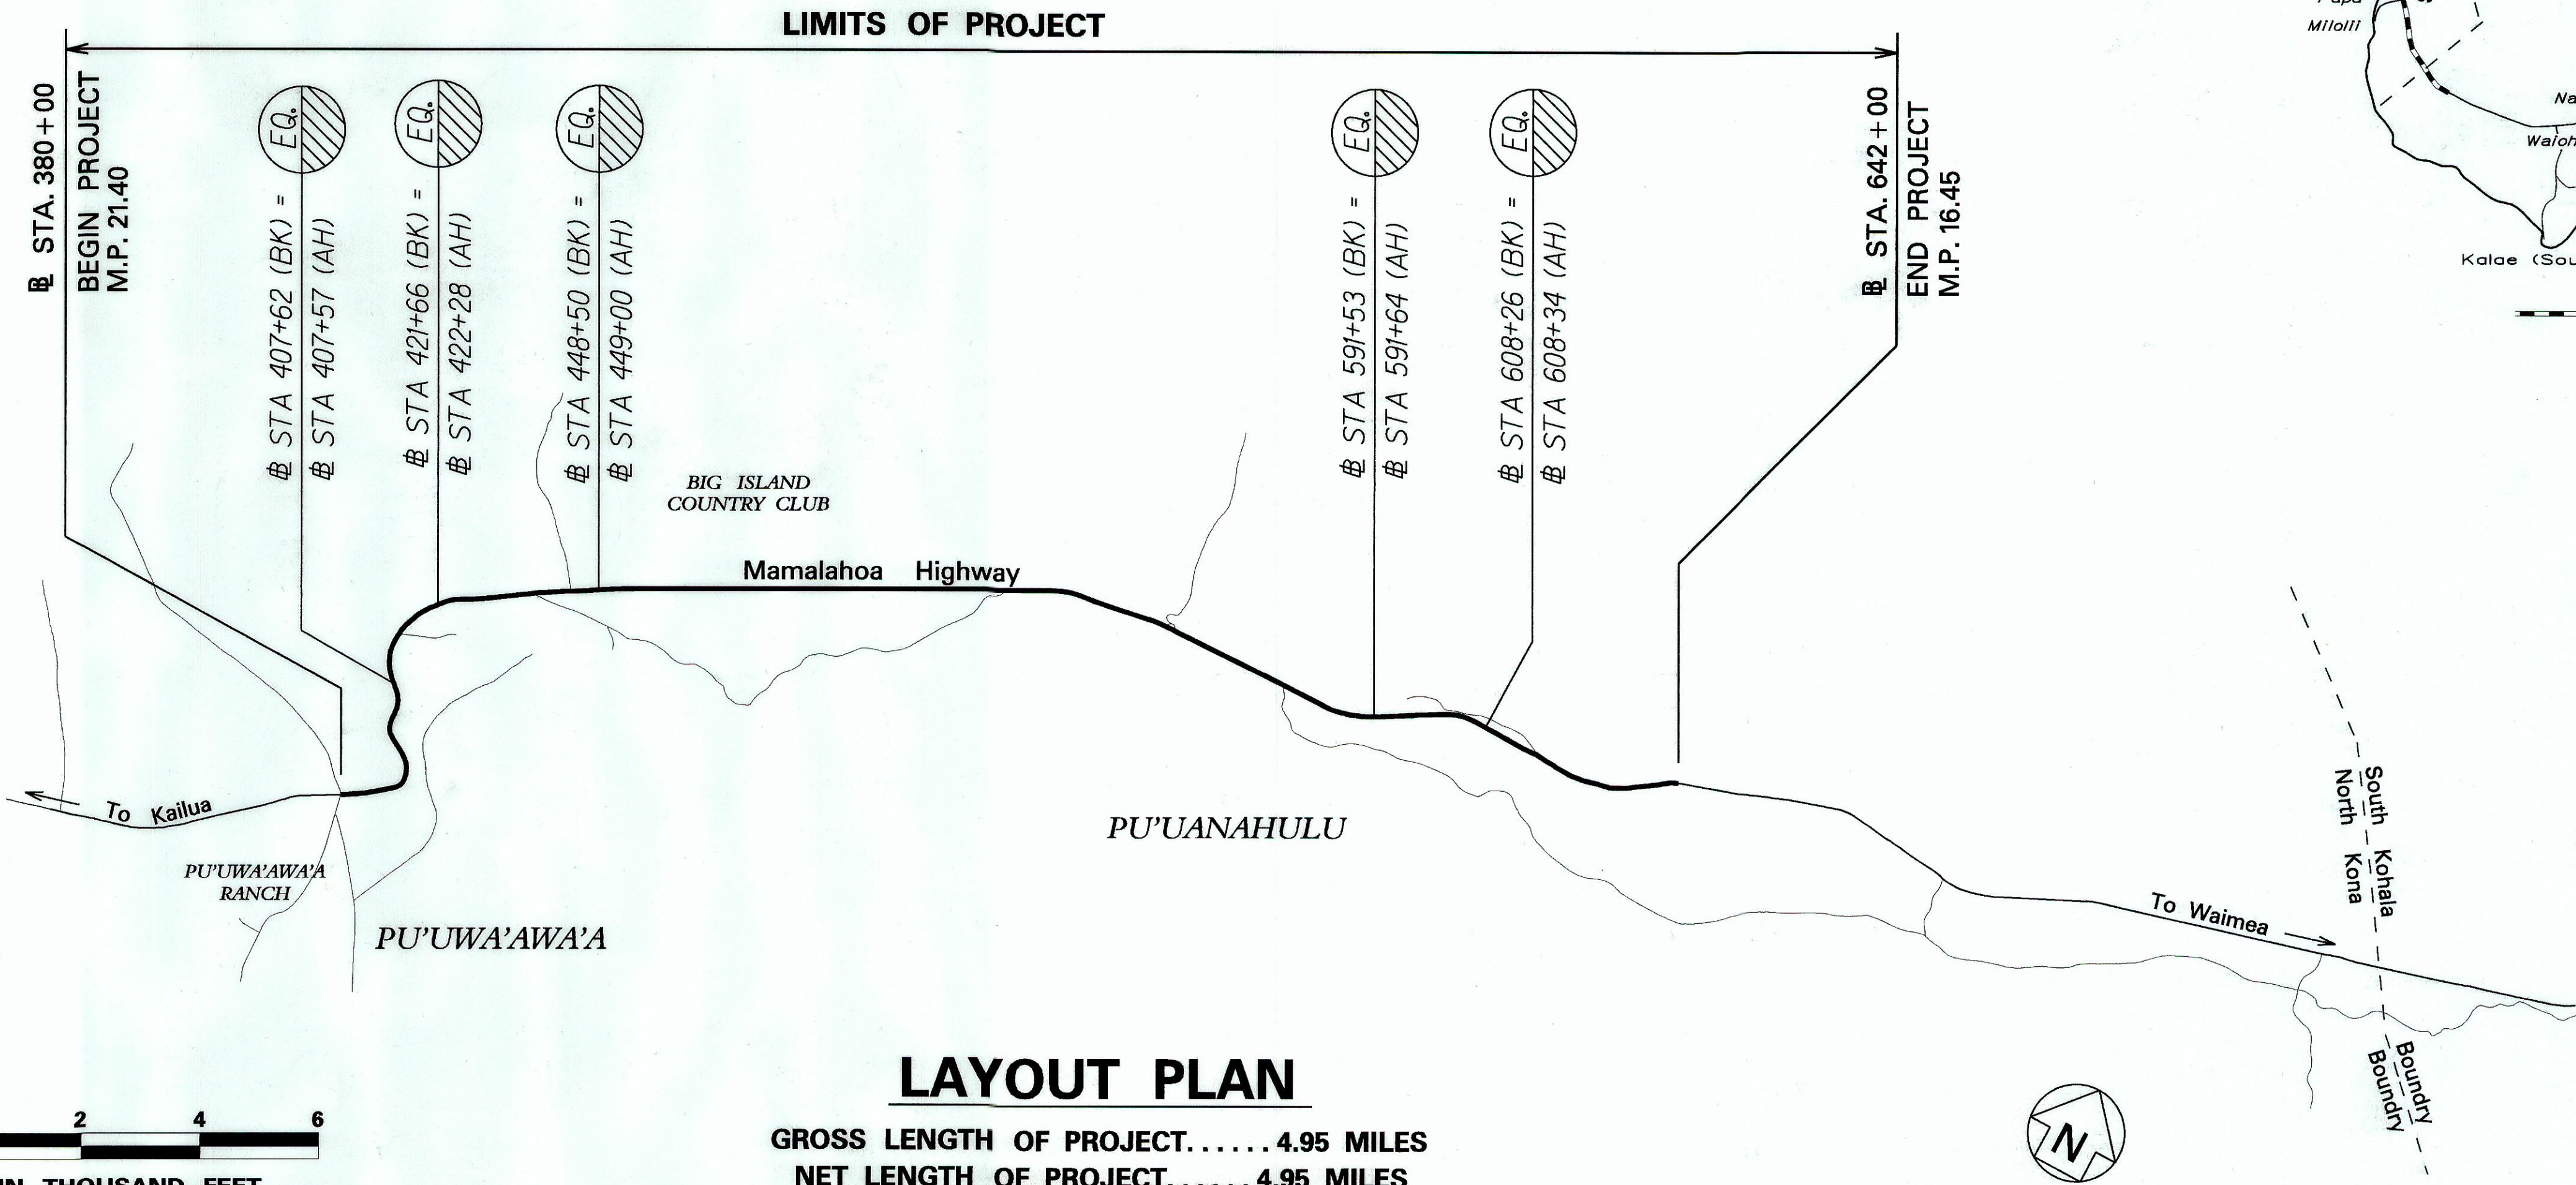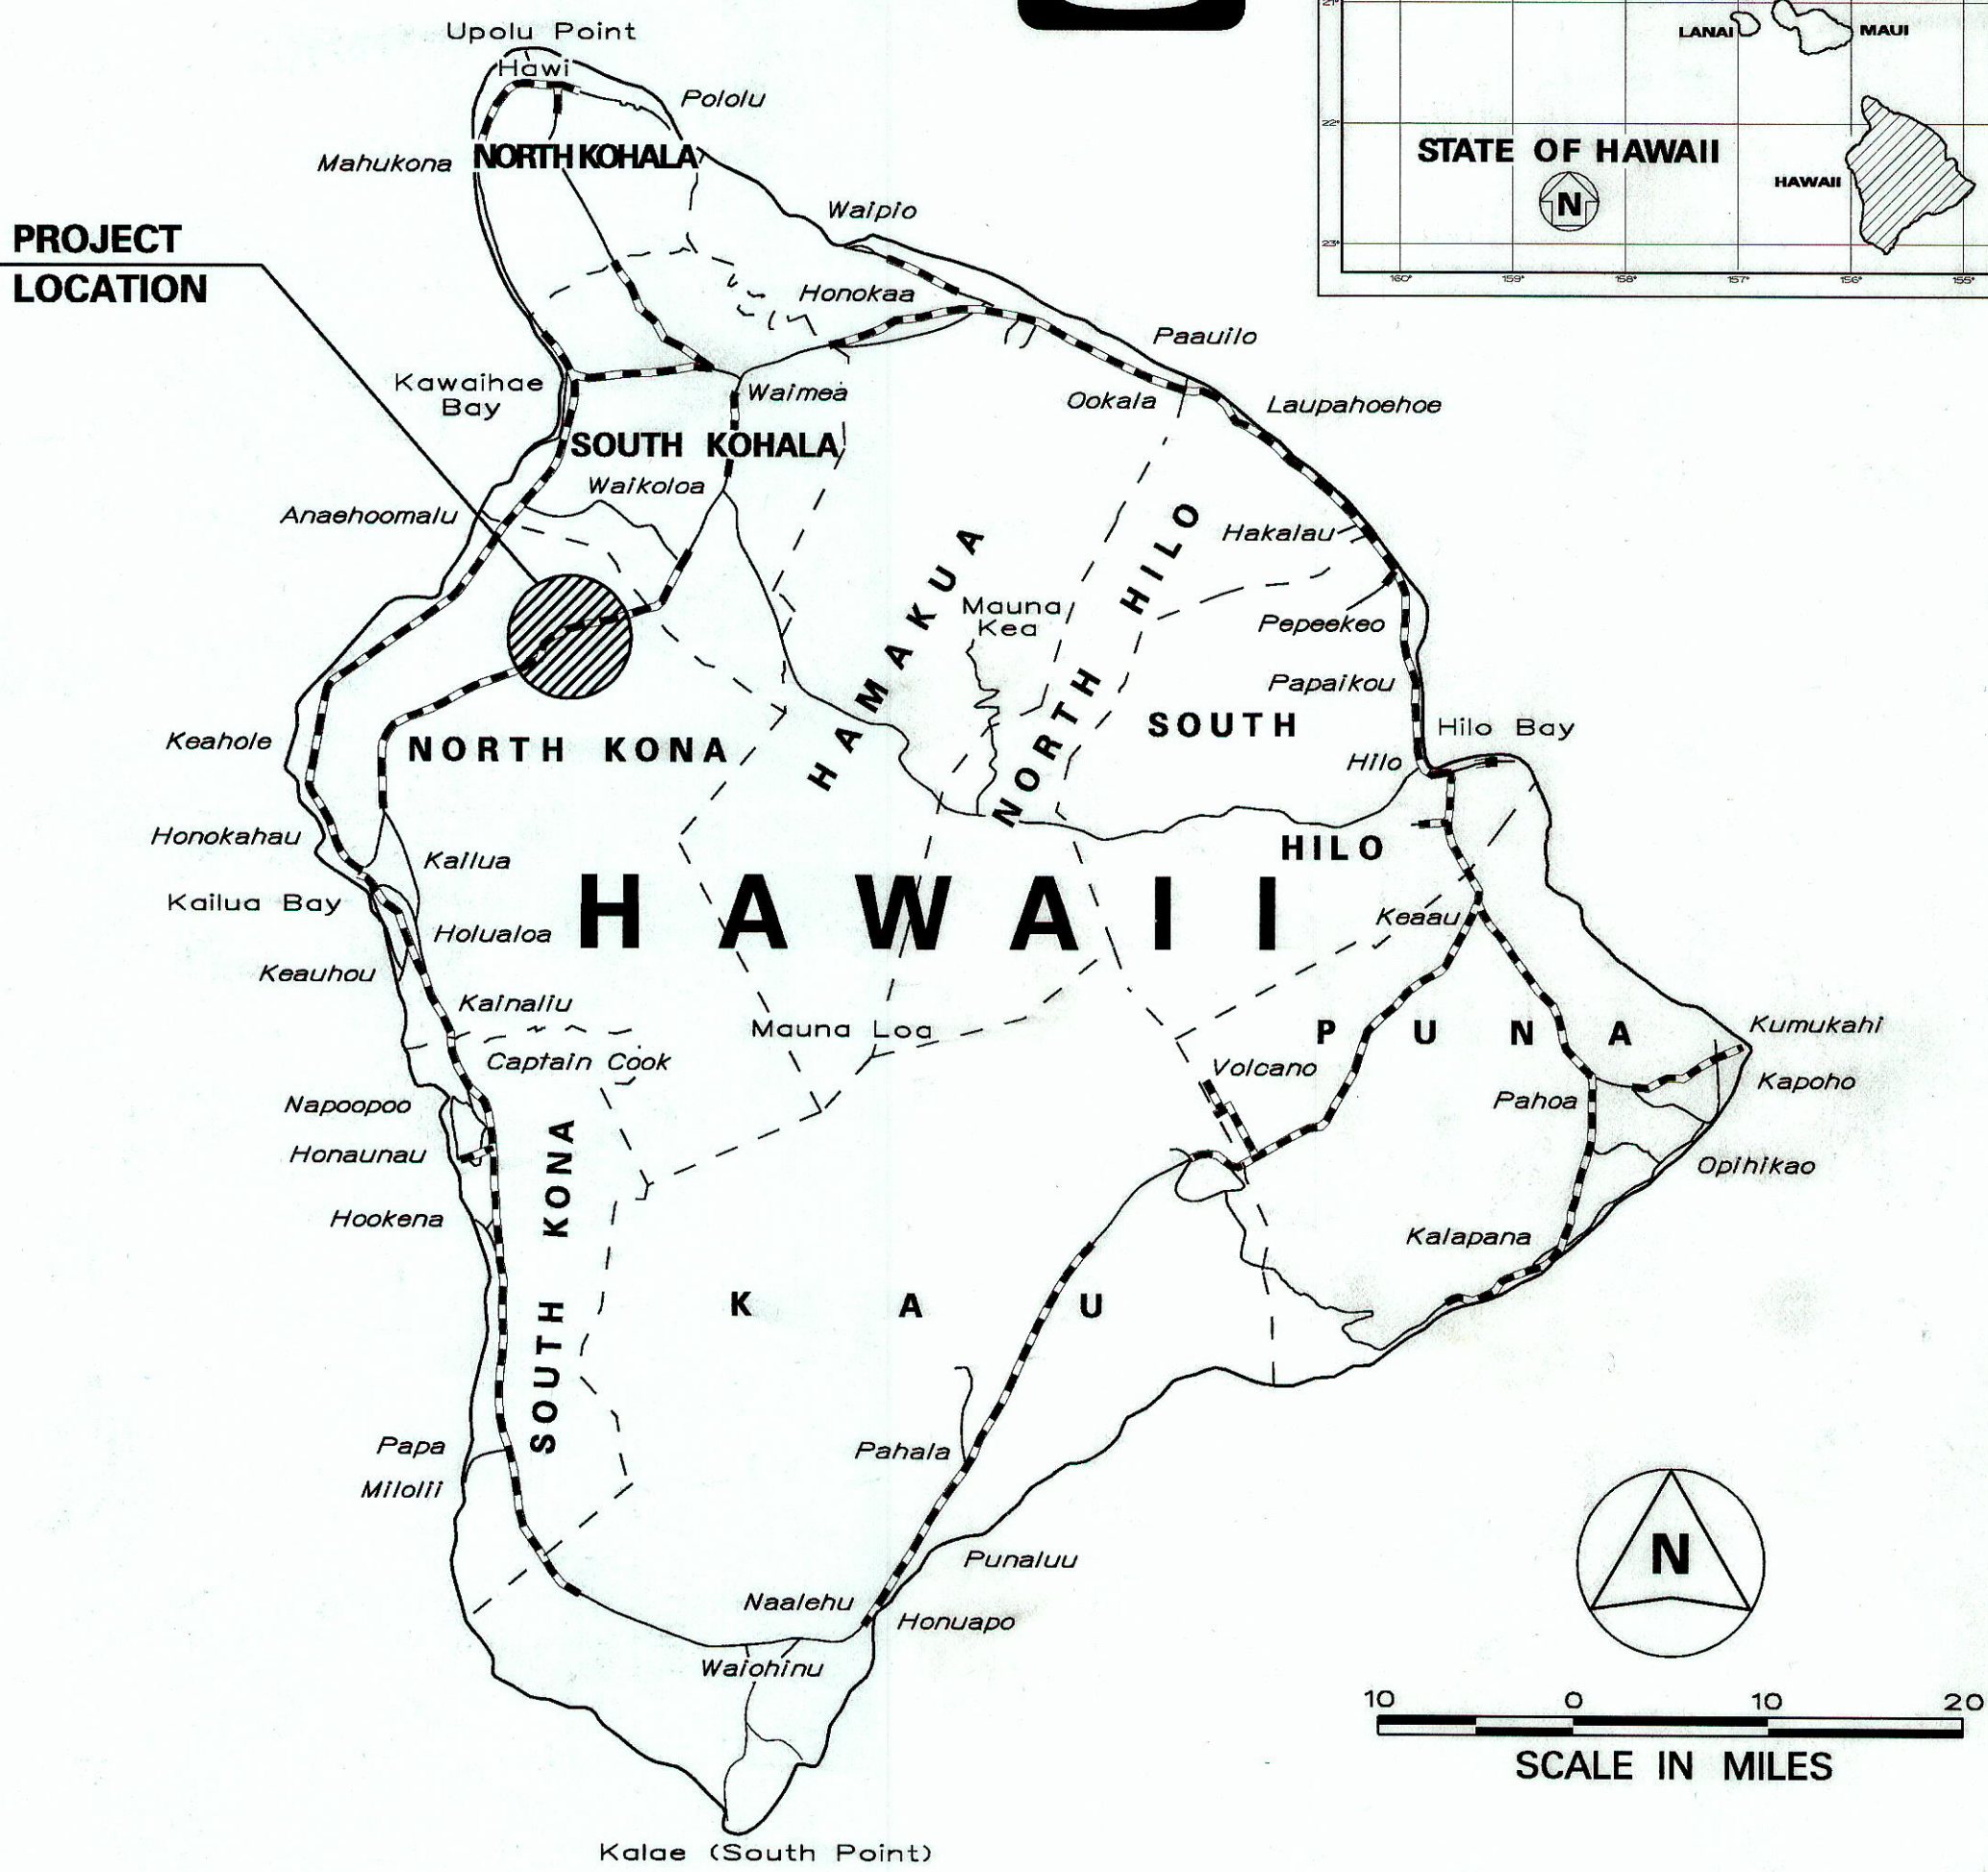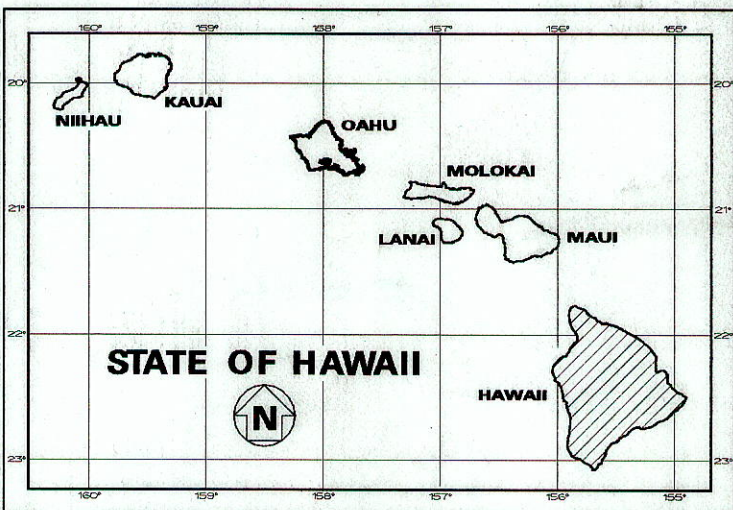

FEDERAL AID PROJECTS PREVIOUSLY CONSTRUCTED OR UNDER CONSTRUCTION

MILE POST 21.40 TO MILE POST 16.45

CHANGES MADE DURING CONSTRUCTION HAVE BEEN INCORPORATED ON THESE PLANS EXCEPT CHANGES IN THE ORIGINAL THEORETICAL QUANTITIES. FOR ACTUAL QUANTITIES, REFER TO PROJECT LEADER AND/OR COMPUTATION BOOK.

Rob Lu  
RESIDENT ENGINEER

4/20/16  
DATE

DEPARTMENT OF TRANSPORTATION  
STATE OF HAWAII

APPROVED:

4-18-06  
DATE

Hawaii District  
DESIGNED BY

HWY-HE  
MANAGED BY

933-8866  
PHONE

April, 2006  
DATE

LAYOUT PLAN

GROSS LENGTH OF PROJECT..... 4.95 MILES

NET LENGTH OF PROJECT..... 4.95 MILES