



FED. ROAD DIST. NO.	STATE	PROJ. NO.	FISCAL YEAR	SHEET NO.	TOTAL SHEETS
HAWAII	HAW.	190B-02-04M	2006		30

SEGMENT	STATION		LENGTH L.F.	WIDTH L.F.	APPROX. AREA (SQ. FT.)
	FROM	TO			
A	50+00 Rt.	52+20 Rt.	220	10	2,200
B	329+50 Lt.	331+70 Lt.	220	10	2,200
C	378+90 Rt.	381+10 Rt.	220	10	2,200
TOTAL					6,600

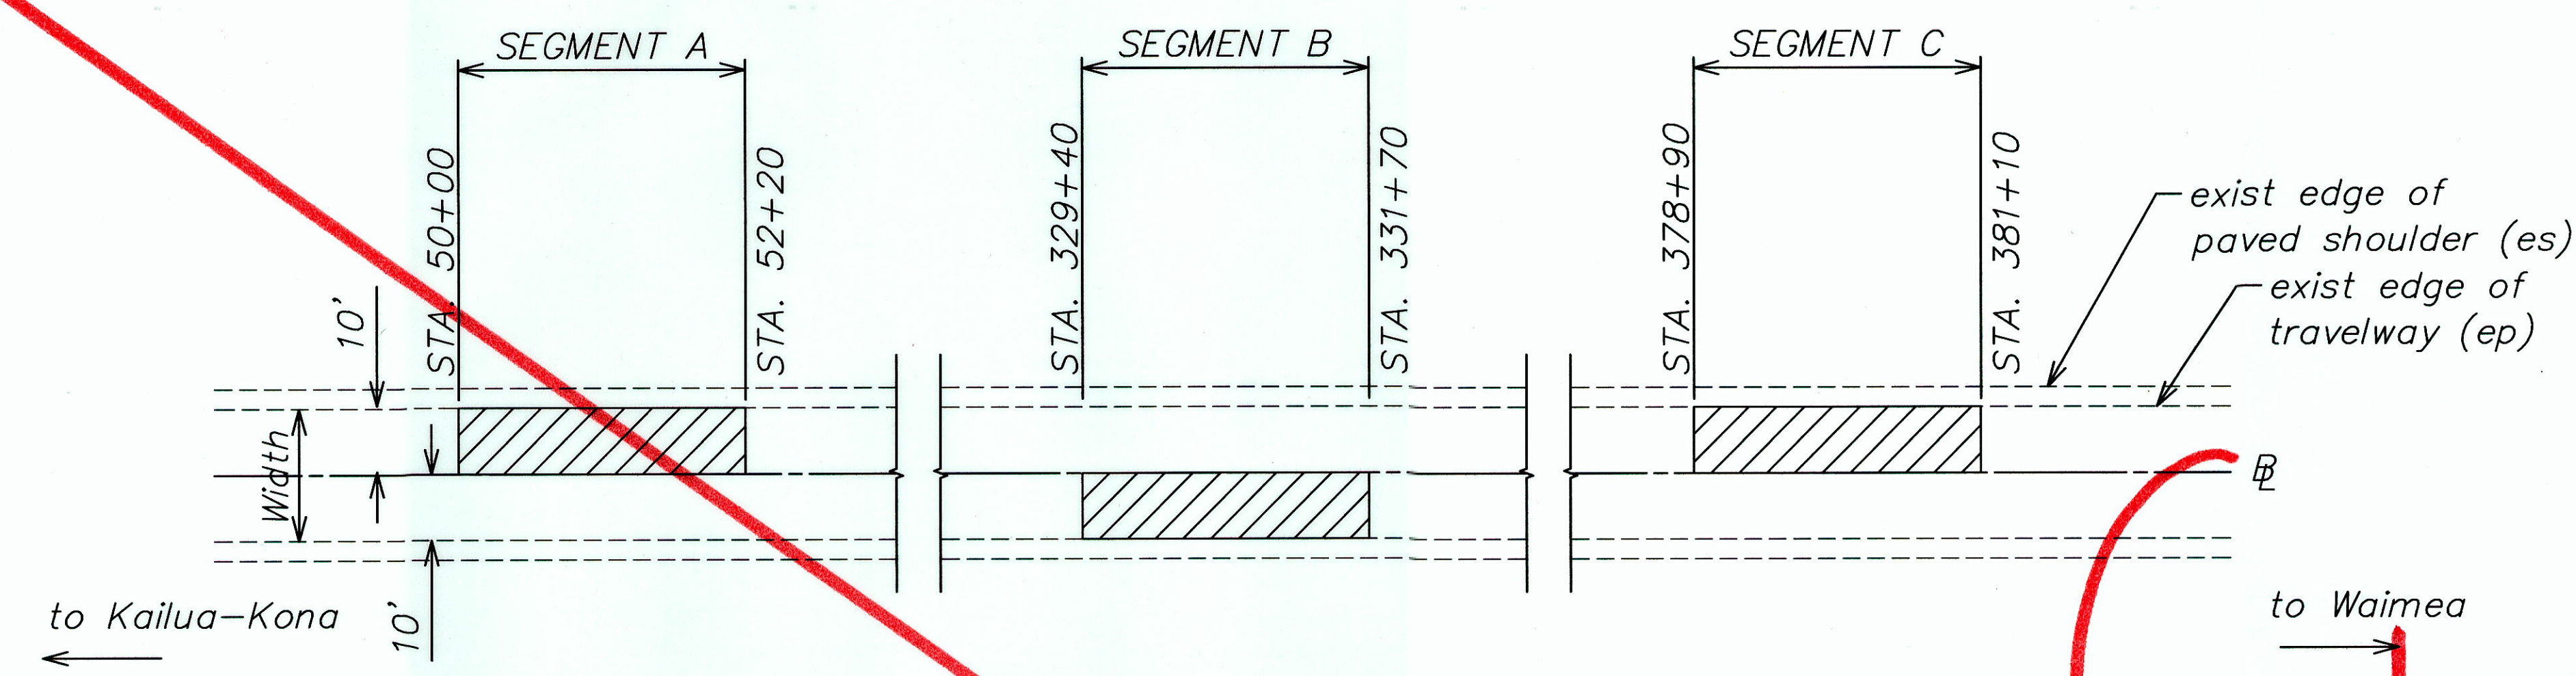

1
7
TYPICAL RECONSTRUCTION PLAN
SCALE: NOT TO SCALE

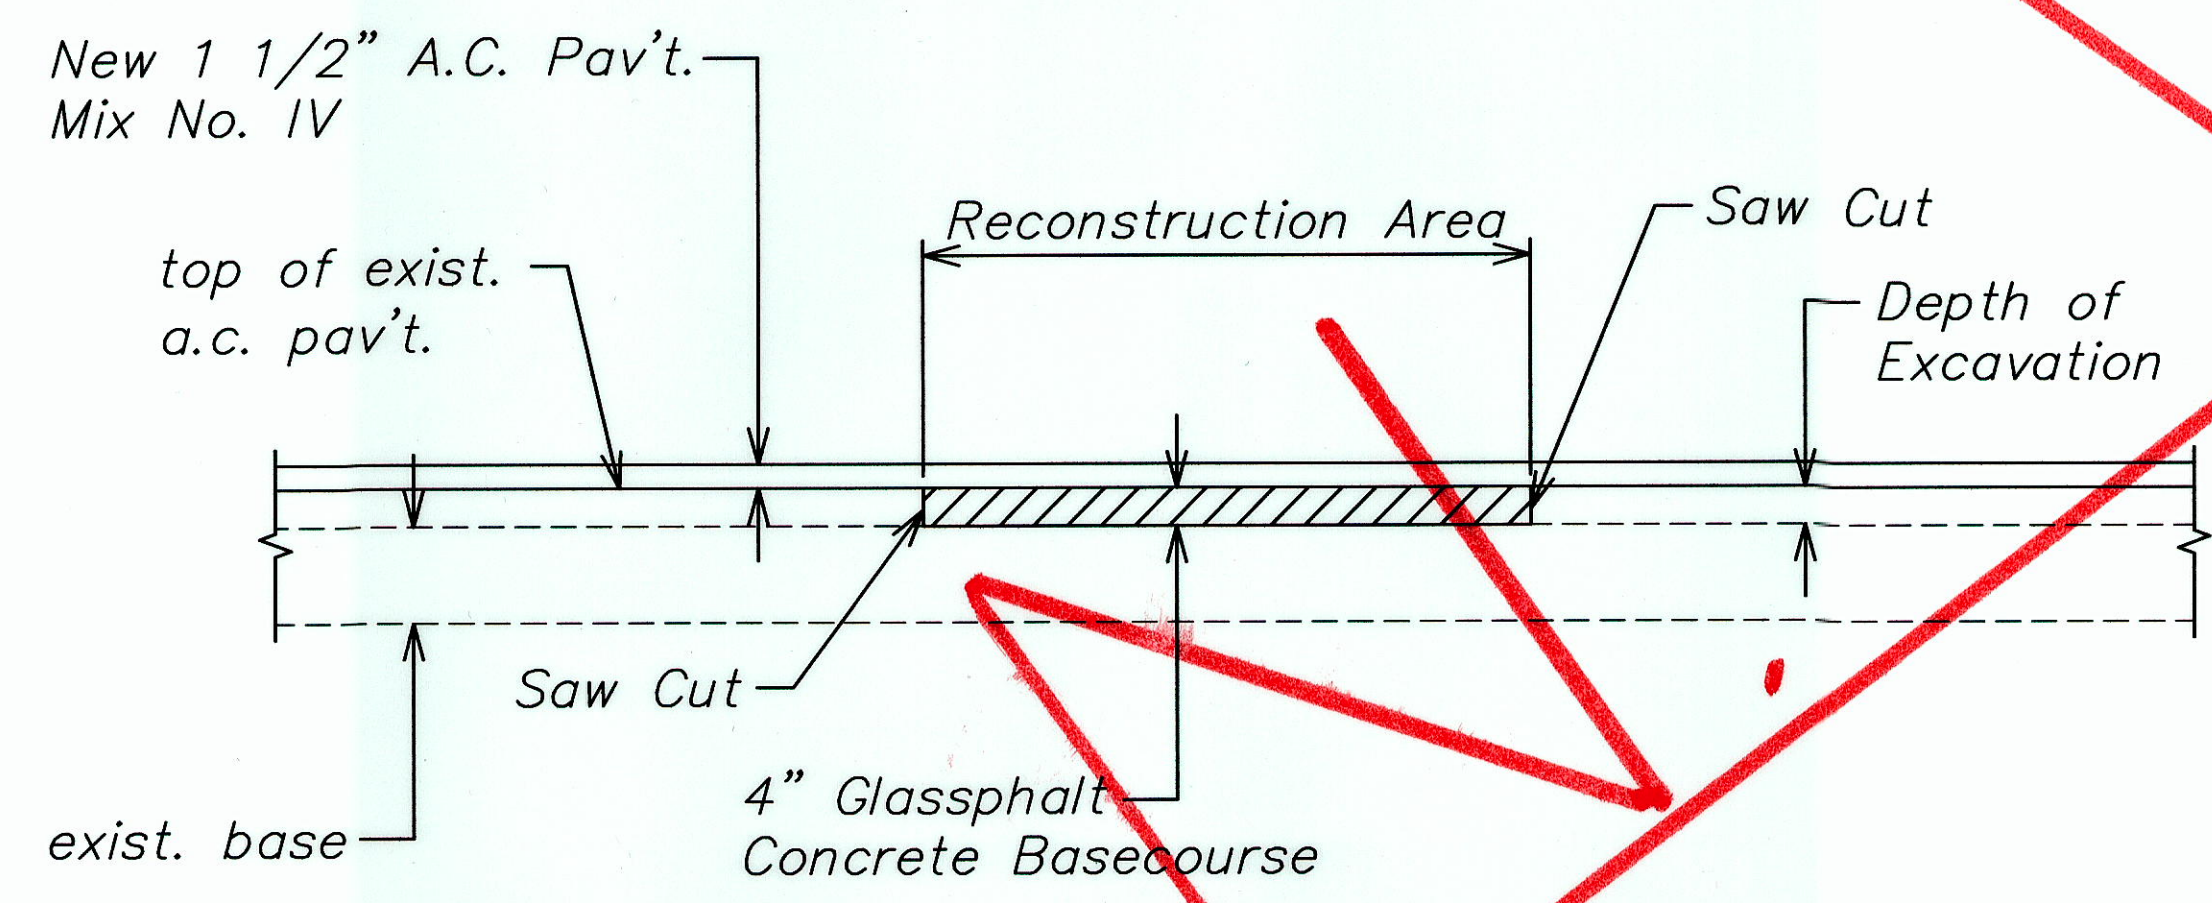

2
7
A.C. PAVEMENT RECONSTRUCTION DETAIL
SCALE: NOT TO SCALE

Sheet Title: RECONSTRUCTION AREA SCHEDULE AND DETAILS
 Last Save by: RQq
 Last Saved: 4/11/2006
 Plotted on: 5/4/2006
 G:\DOT\H04-02\ACAD\ROUTE190\dwg\Sheets\DOT04207.dwg

ORIGINAL PLAN	DATE
DRAWN BY	
DESIGNED BY	
QUANTITIES BY	
CHECKED BY	

RYAN G. QUITORIANO
LICENSED PROFESSIONAL ENGINEER
No. 11122-C
HAWAII, U.S.A.

STATE OF HAWAII
DEPARTMENT OF TRANSPORTATION
HIGHWAYS DIVISION

**RECONSTRUCTION AREA
SCHEDULE AND DETAILS**

MAMALAHOA HIGHWAY PAVEMENT
PREVENTIVE MAINTENANCE

Puu Waawaa Ranch to Kaupulehu
Project No. 190B-02-04M

Scale: As Shown Date: April 2006

SHEET NO. 1 OF 1 SHEETS

"AS-BUILT"