




FED. ROAD DIST. NO.	STATE	PROJ. NO.	FISCAL YEAR	SHEET NO.	TOTAL SHEETS
HAWAII	HAW.	190B-02-04M	2006	6	30

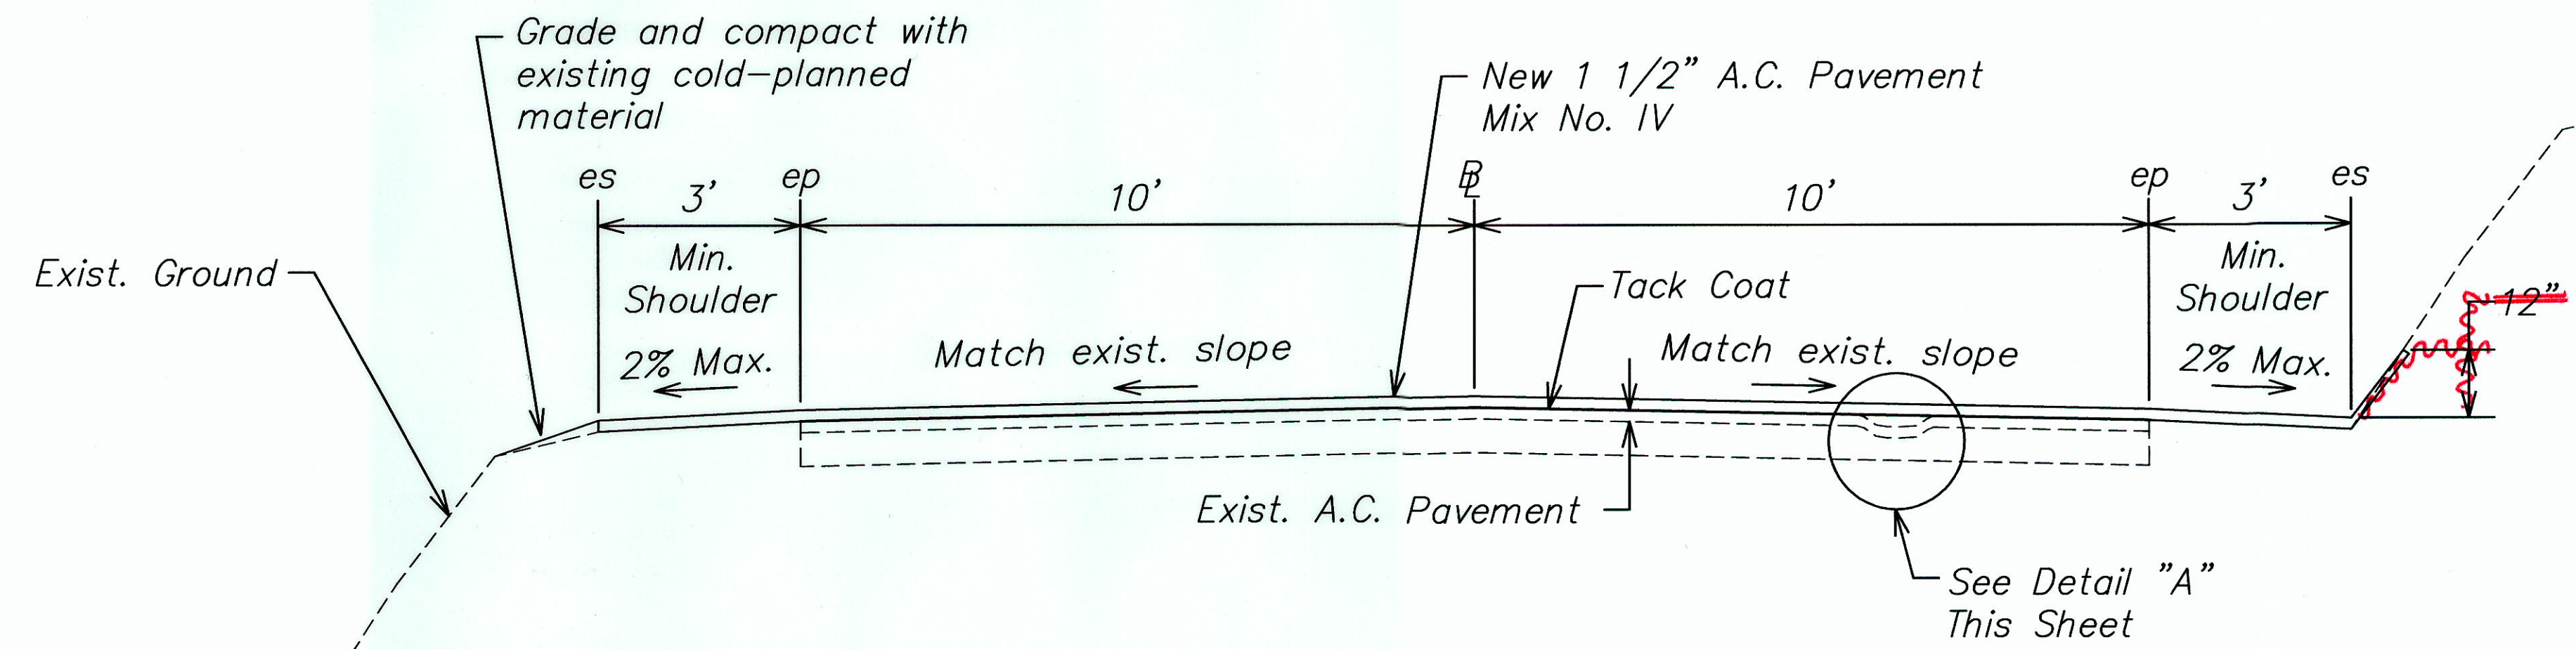


1
6 TYPICAL ROAD DETAIL
SCALE: 1/2" = 1'-0"

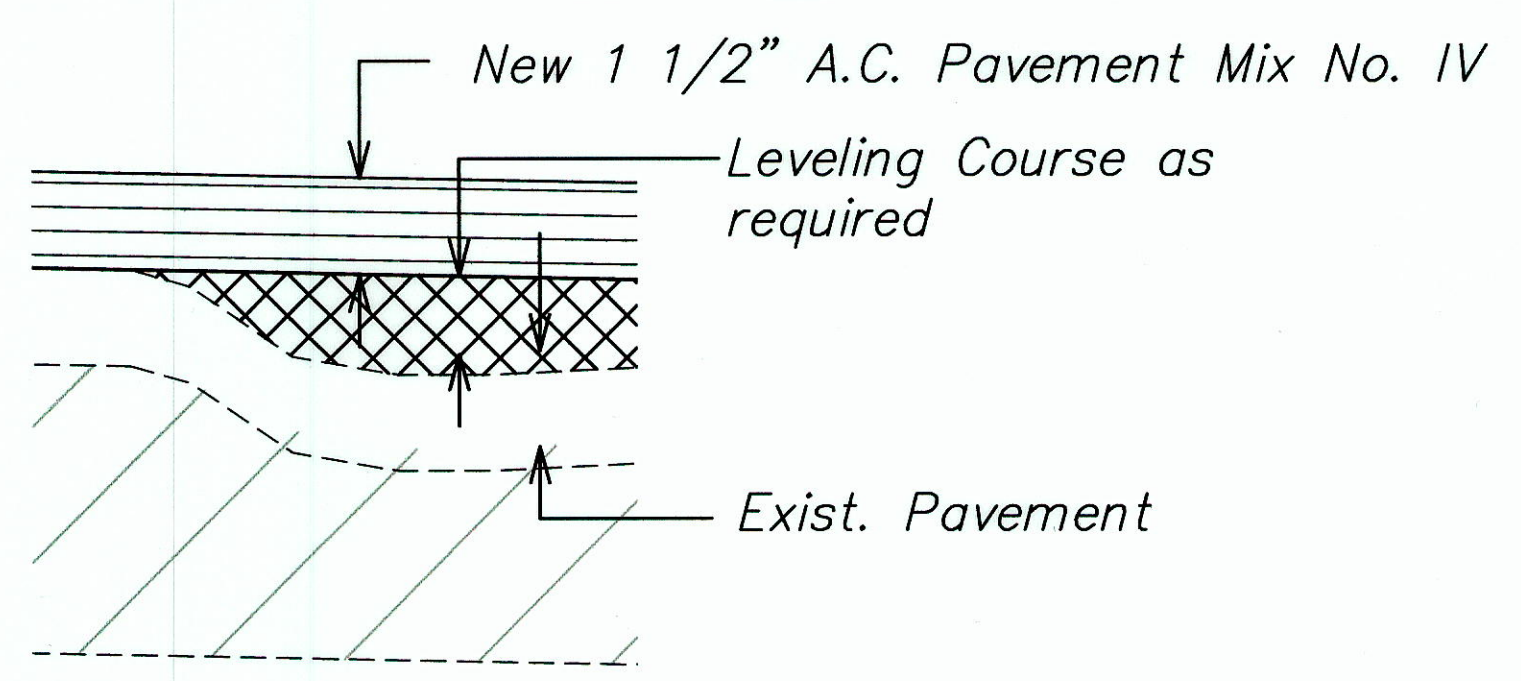


DETAIL A
SCALE: 3" = 1'

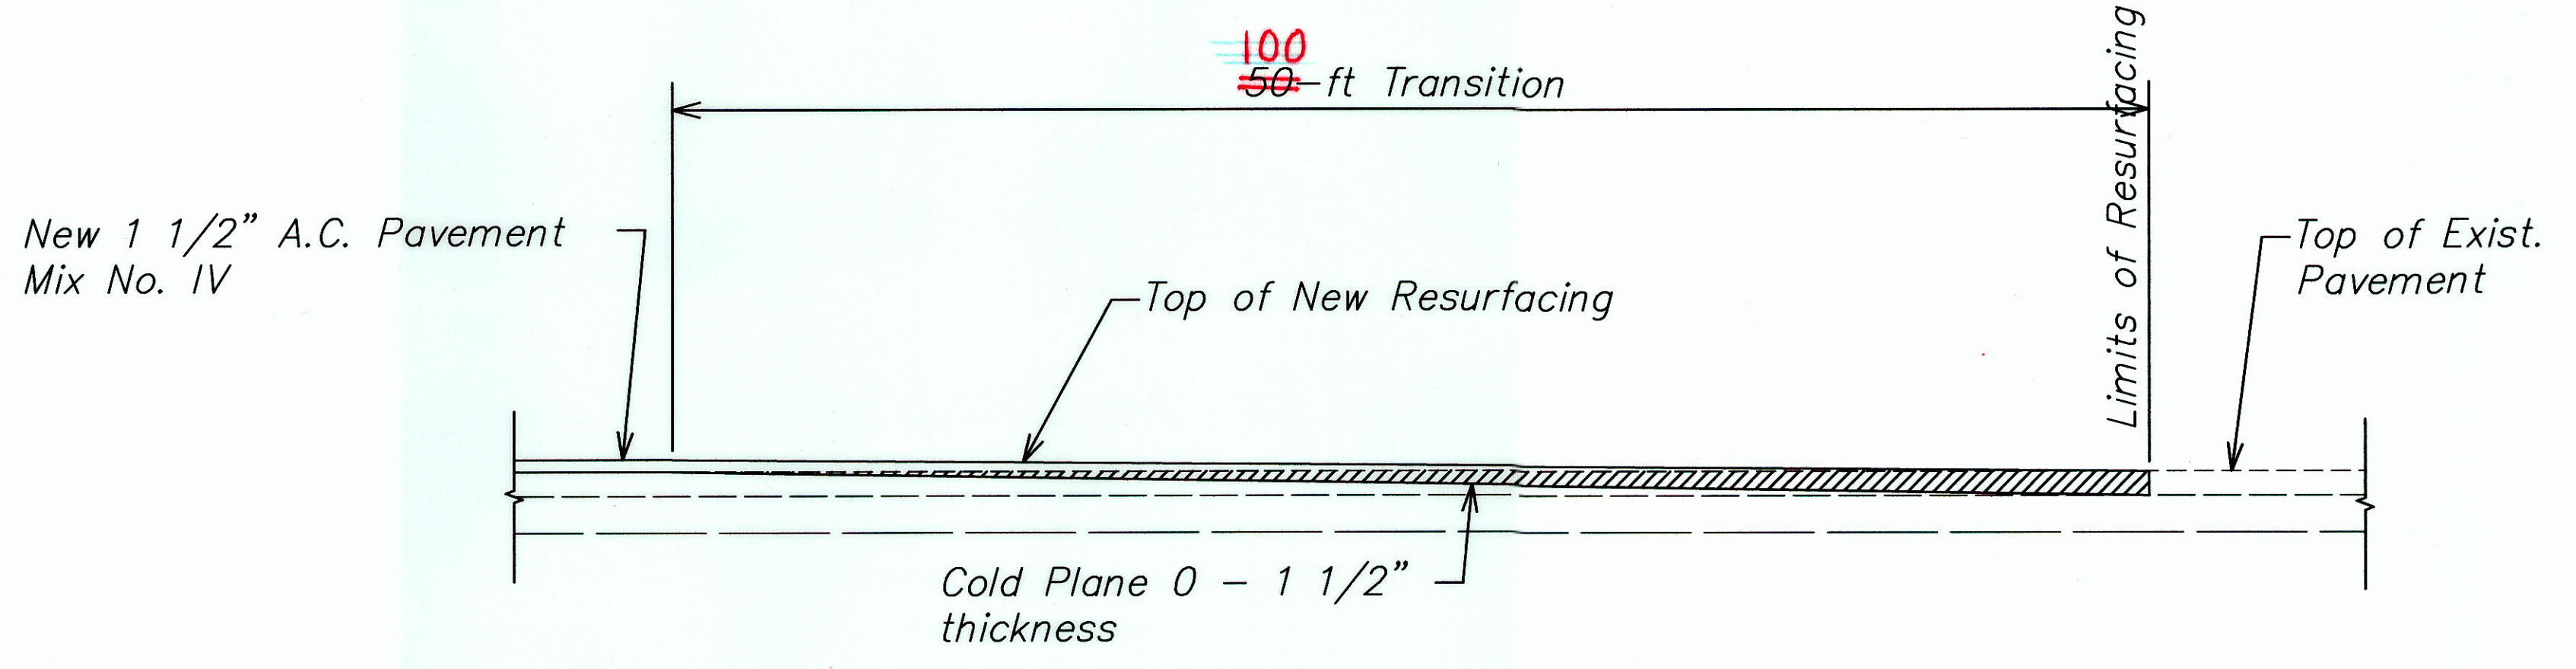

2
6 COLD PLANED TRANSITION TO EXISTING PAVEMENT
SCALE: Not to Scale Sta. 49+50 to Sta. 50+50

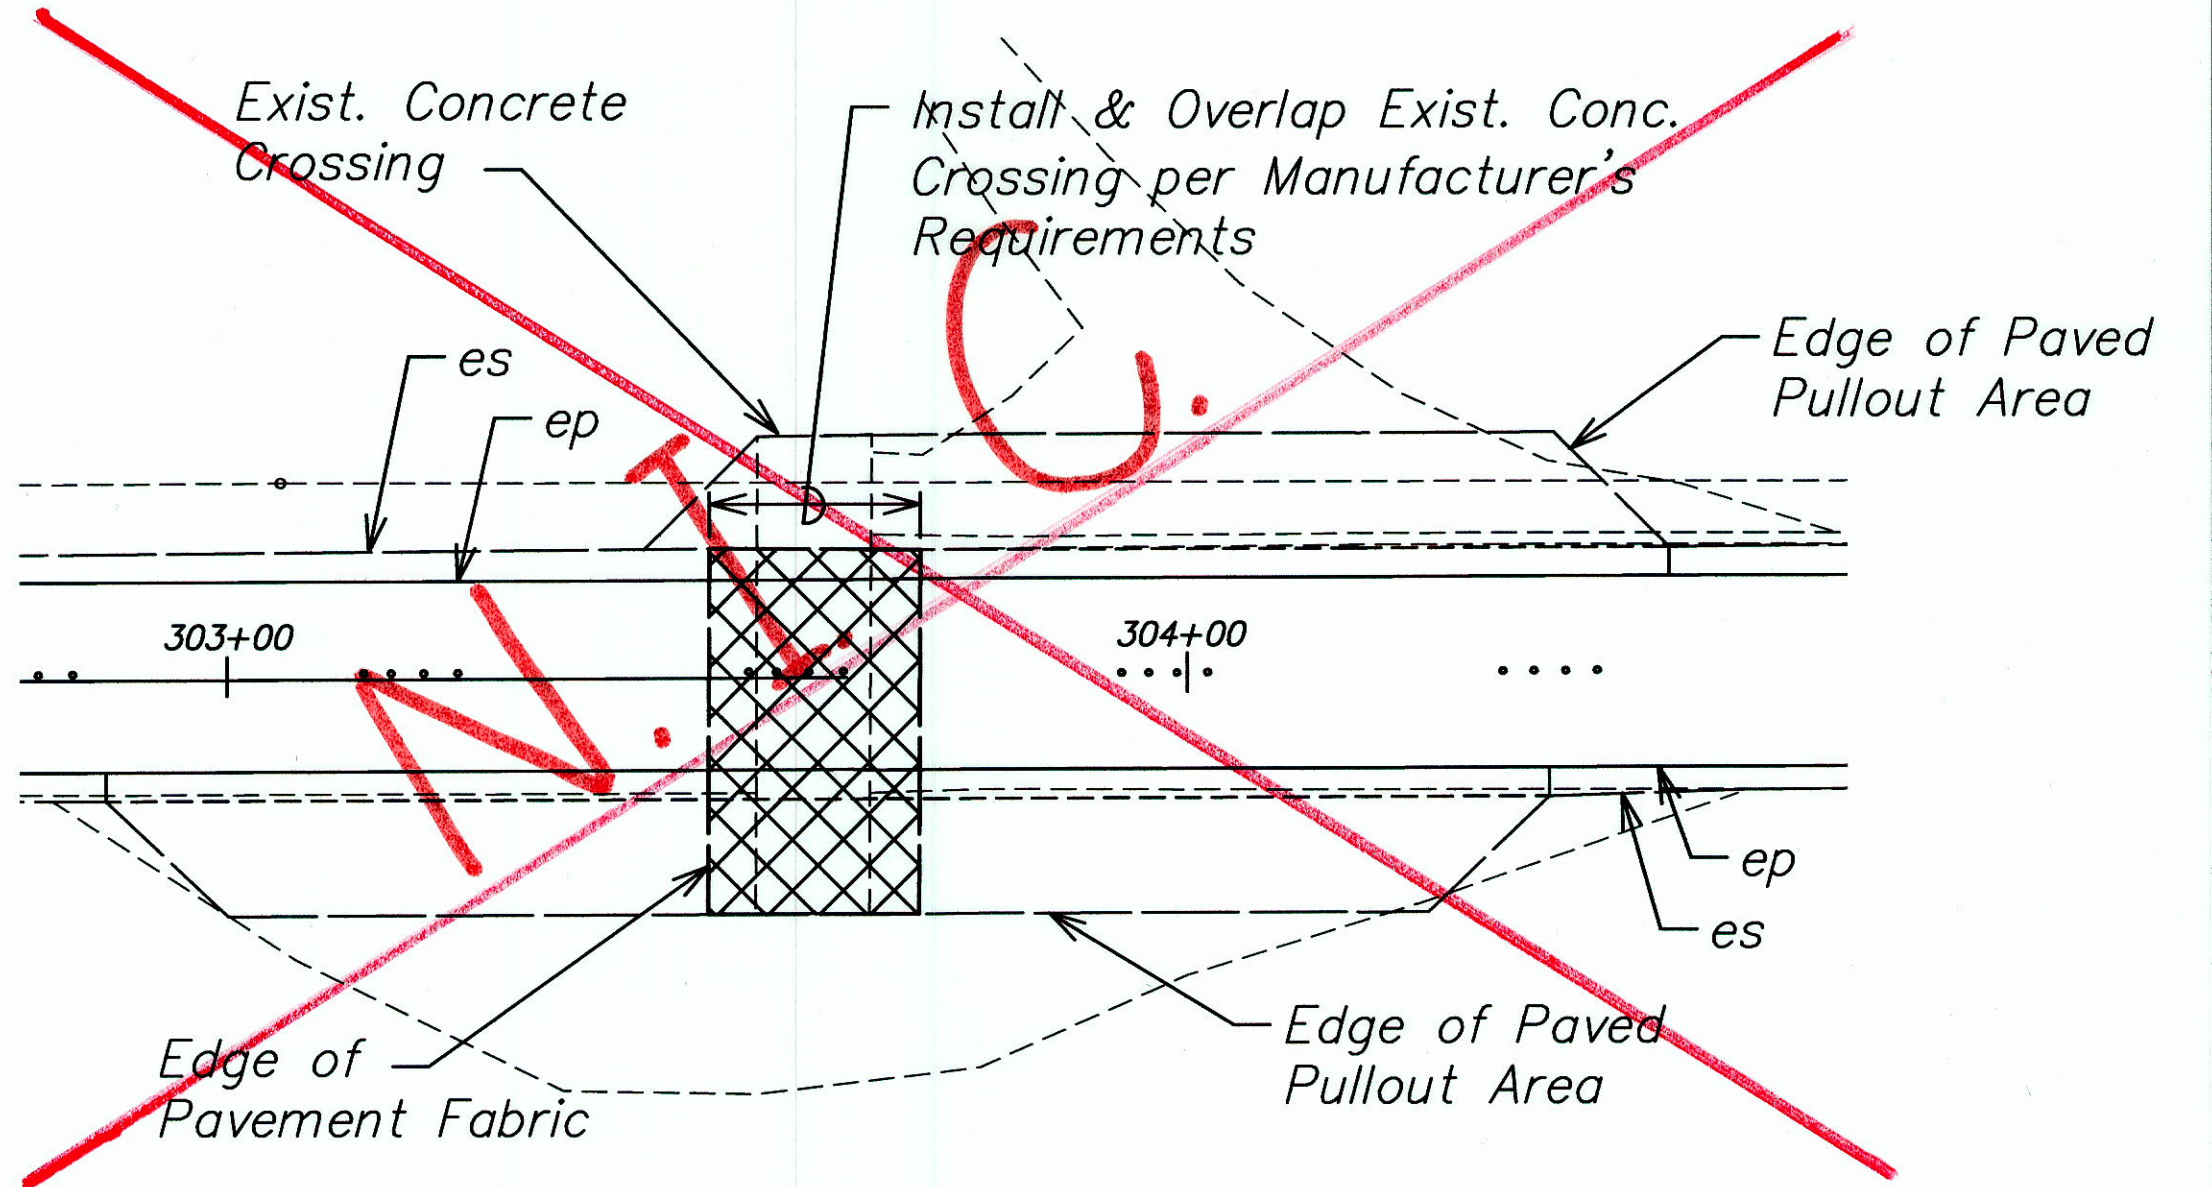

~~**4**~~
~~**6**~~ PAVEMENT FABRIC DETAIL
SCALE: 1/20"

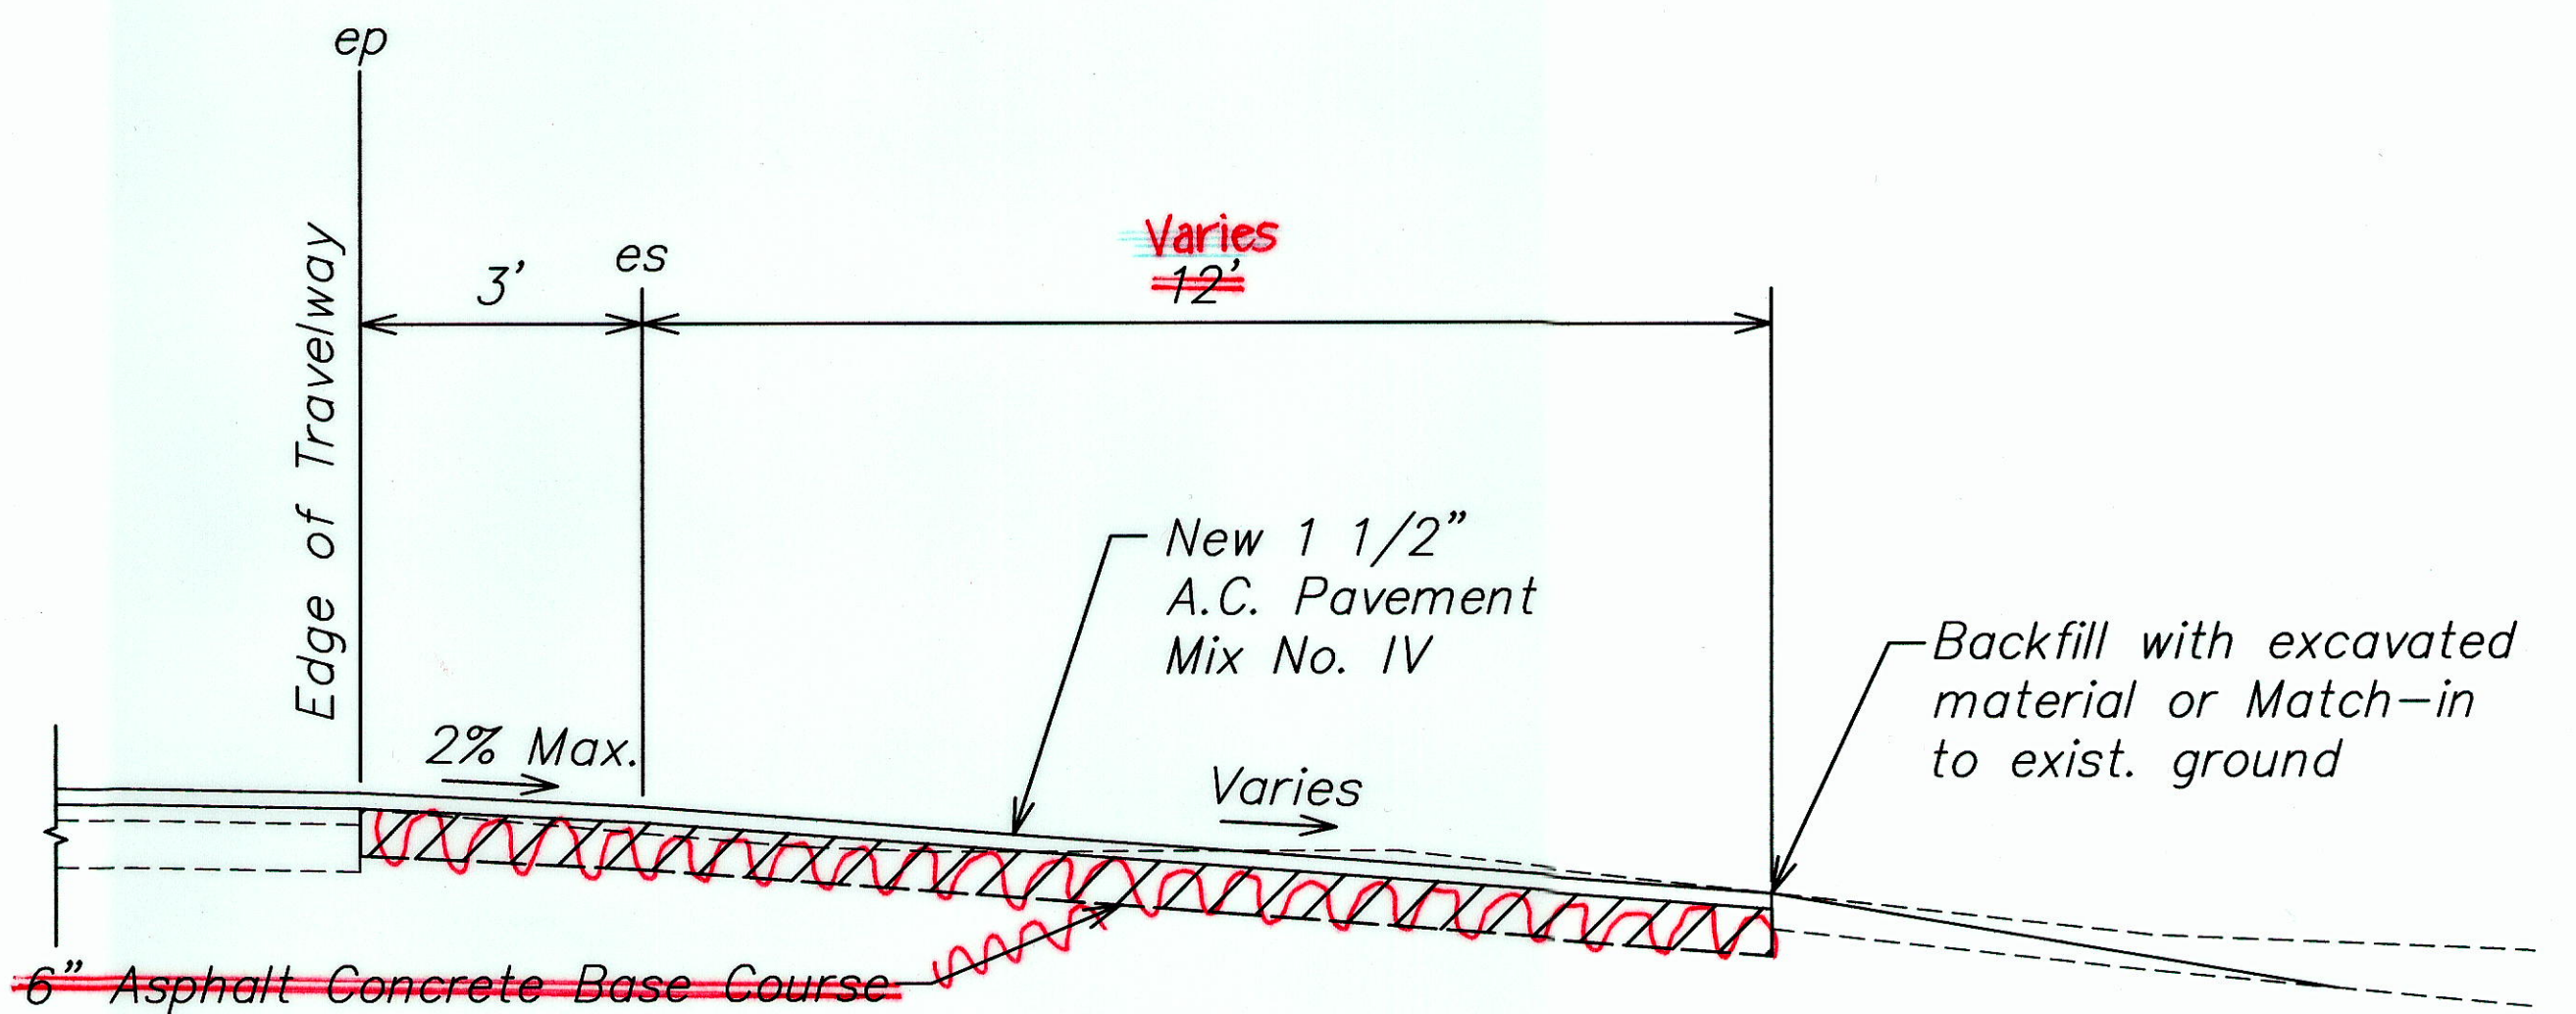

3
6 PULLOUT PAVEMENT DETAIL
SCALE: 1/2" = 1'-0"

4" 0 4" 8"
SCALE: 3" = 1'-0"

2' 0 2' 4'
SCALE: 1/2" = 1'-0"



STATE OF HAWAII
DEPARTMENT OF TRANSPORTATION
HIGHWAYS DIVISION
TYPICAL SECTION AND DETAILS
MAMALAOHA HIGHWAY PAVEMENT
PREVENTIVE MAINTENANCE
Puu Waawaa Ranch to Kaupulehu
Project No. 190B-02-04M
Scale: As Shown Date: April 2006
SHEET NO. 1 OF 1 SHEETS

"AS-BUILT"

Sheet Title: TYPICAL SECTION AND DETAILS
Last Save by: RGQ
Last Saved: 5/4/2006
Plotted on: 5/4/2006
G:\DOT\04-02\ACAD\ROUTE190\dwg\Sheets\DOT04206.dwg
SURVEY PLOTTED BY: _____ DATE: _____
DRAWN BY: _____
CHECKED BY: _____
ORIGINAL PLAN: _____
NOTED BY: _____
QUANTITIES BY: _____
CHECKED BY: _____