




FED. ROAD DIST. NO.	STATE	FEDERAL PROJ. NO.	FISCAL YEAR	SHEET NO.	TOTAL SHEETS
HAWAII	HAWAII	STP-0190(015)	2011	45	59

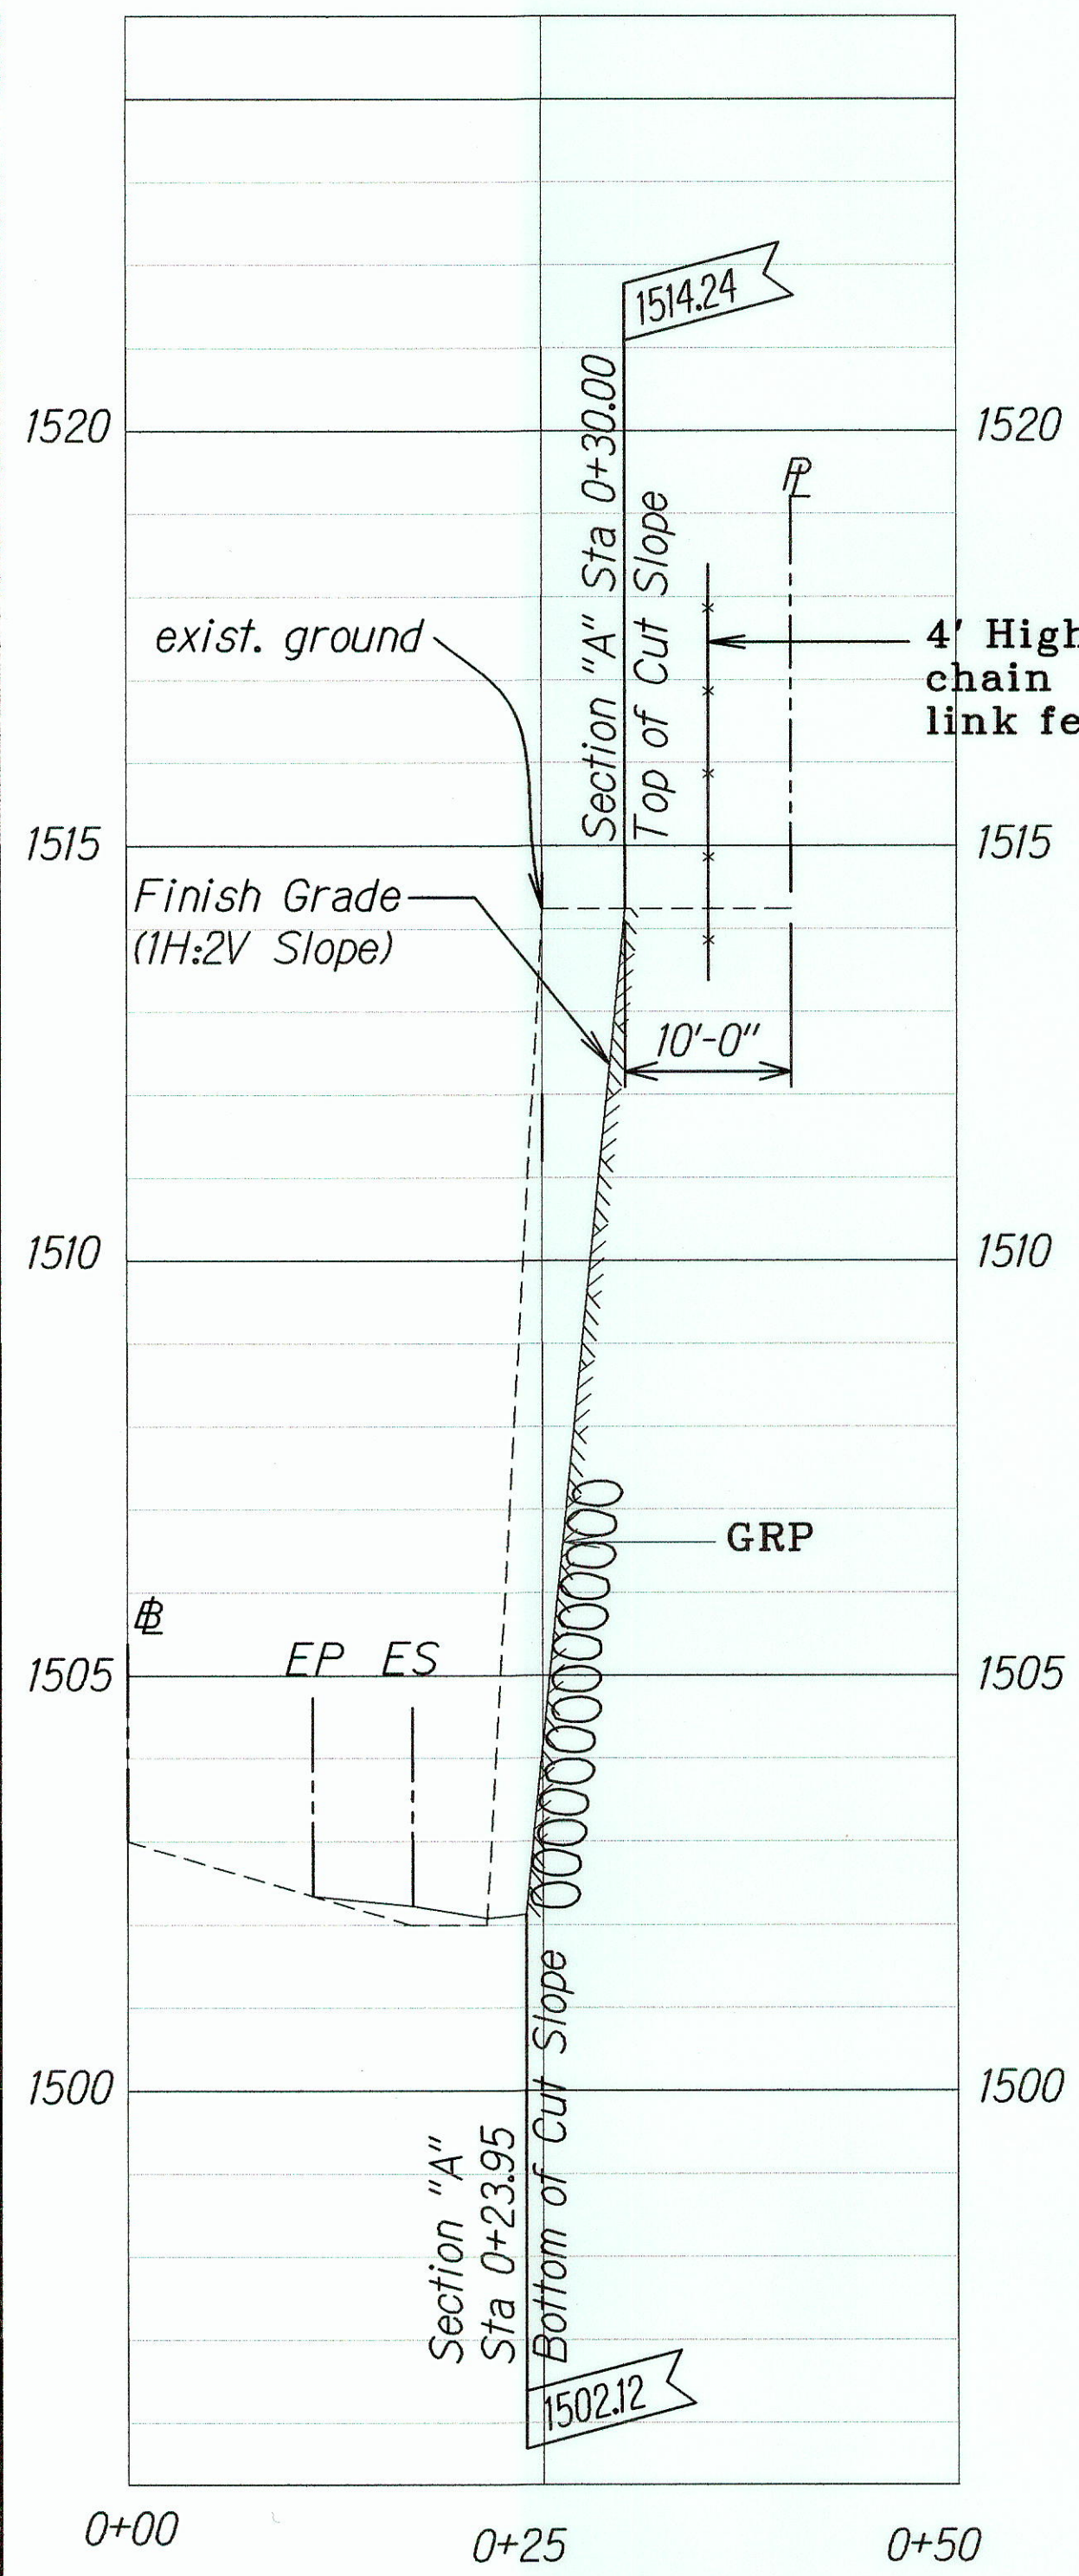


SECTION "A" @ STA 95+14 A
 SCALE: Horiz.: 1"= 10'
 Vert.: 1"= 2' C-30 | C-43

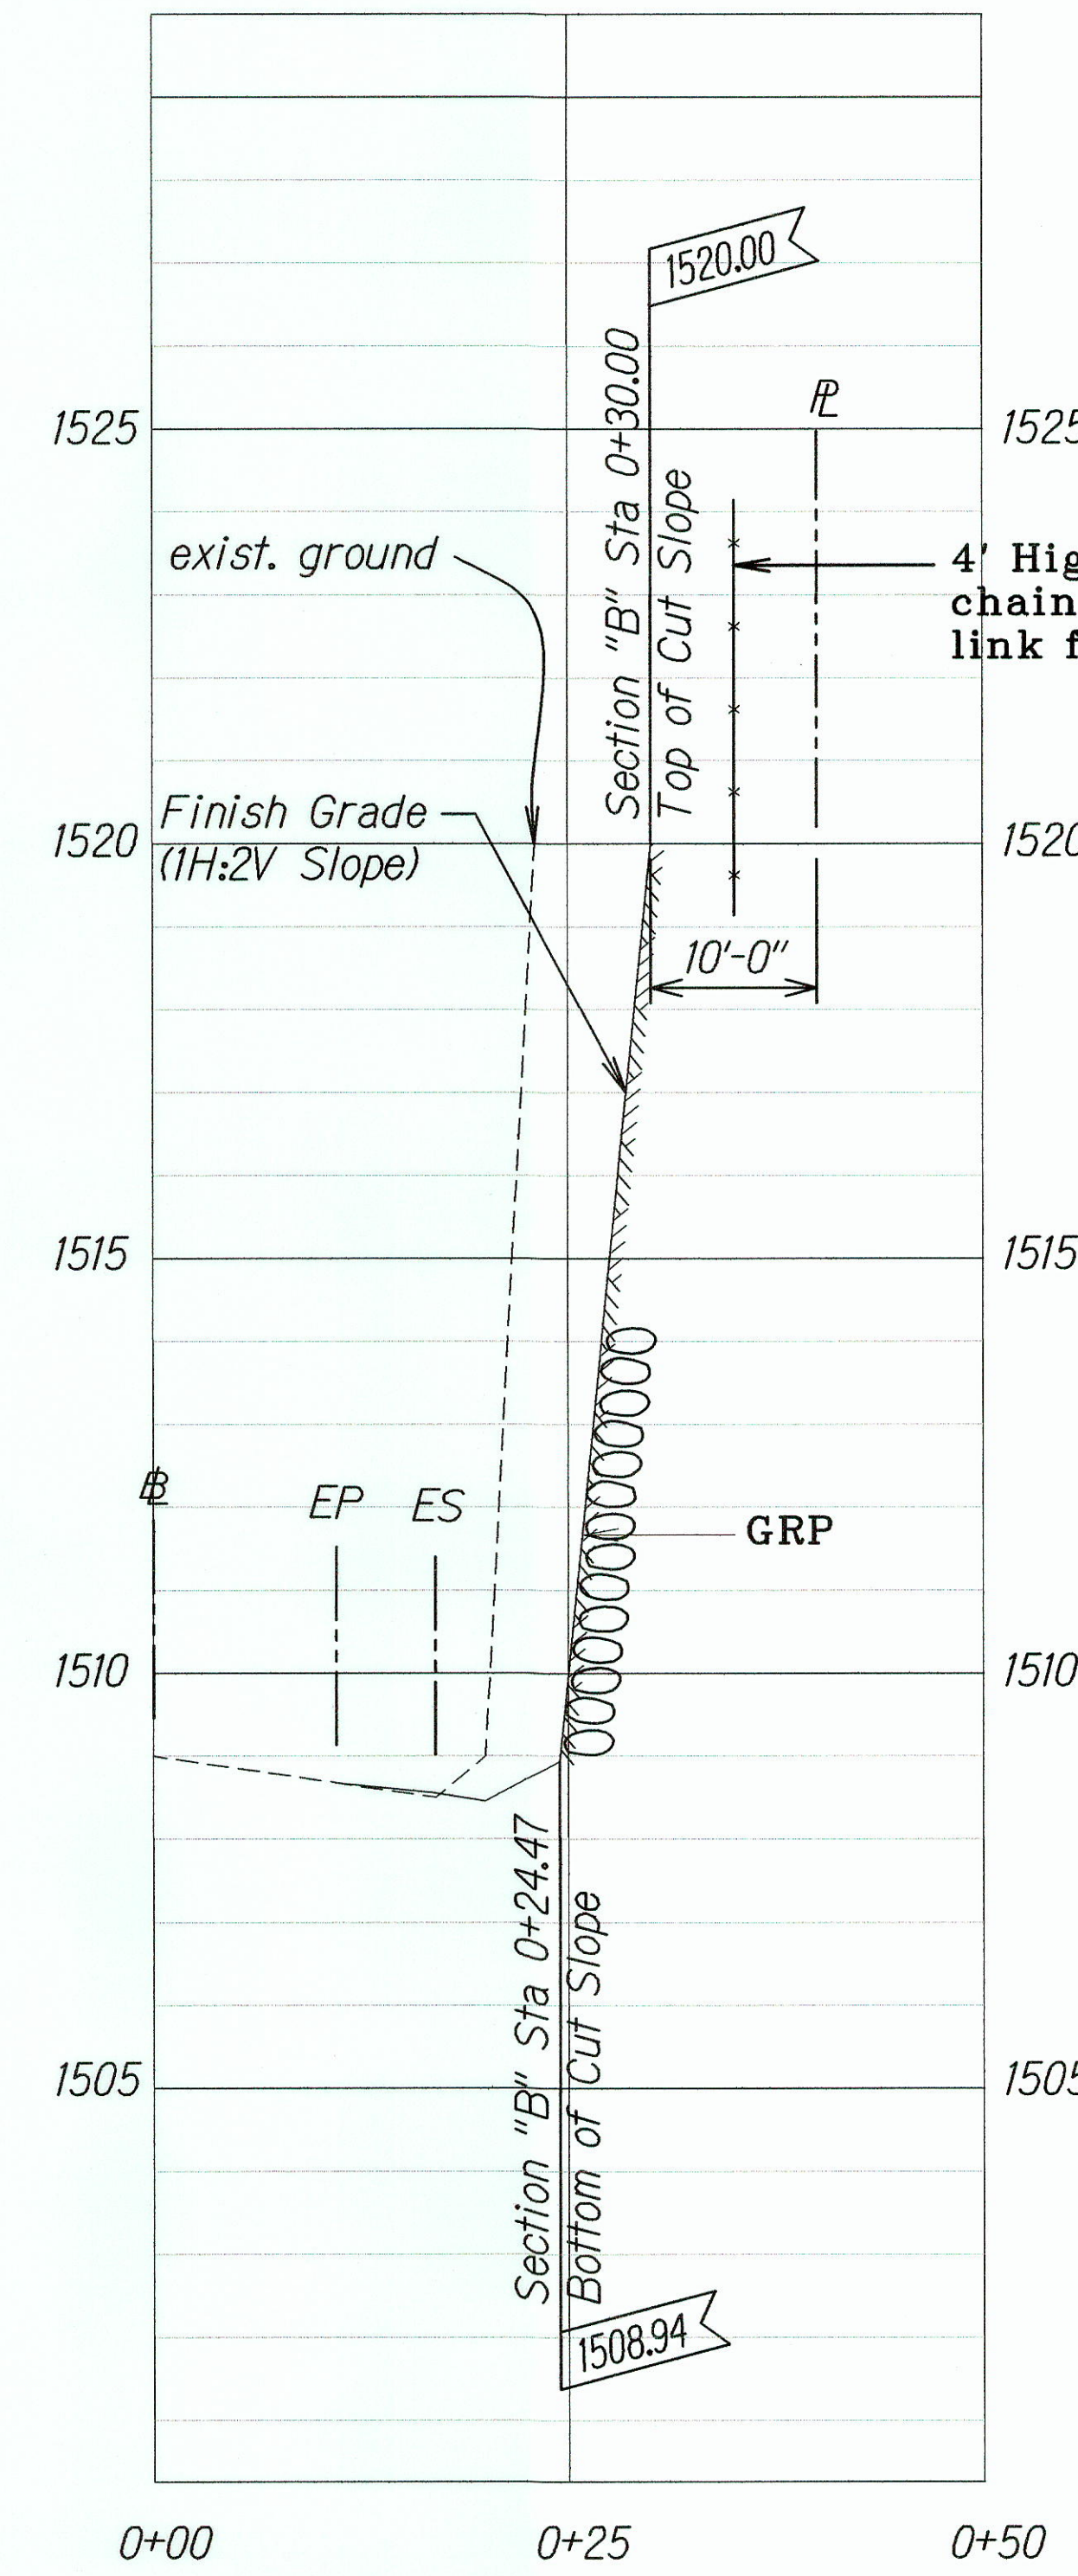

SECTION "B" @ STA 96+00 B
 SCALE: Horiz.: 1"= 10'
 Vert.: 1"= 2' C-30 | C-43

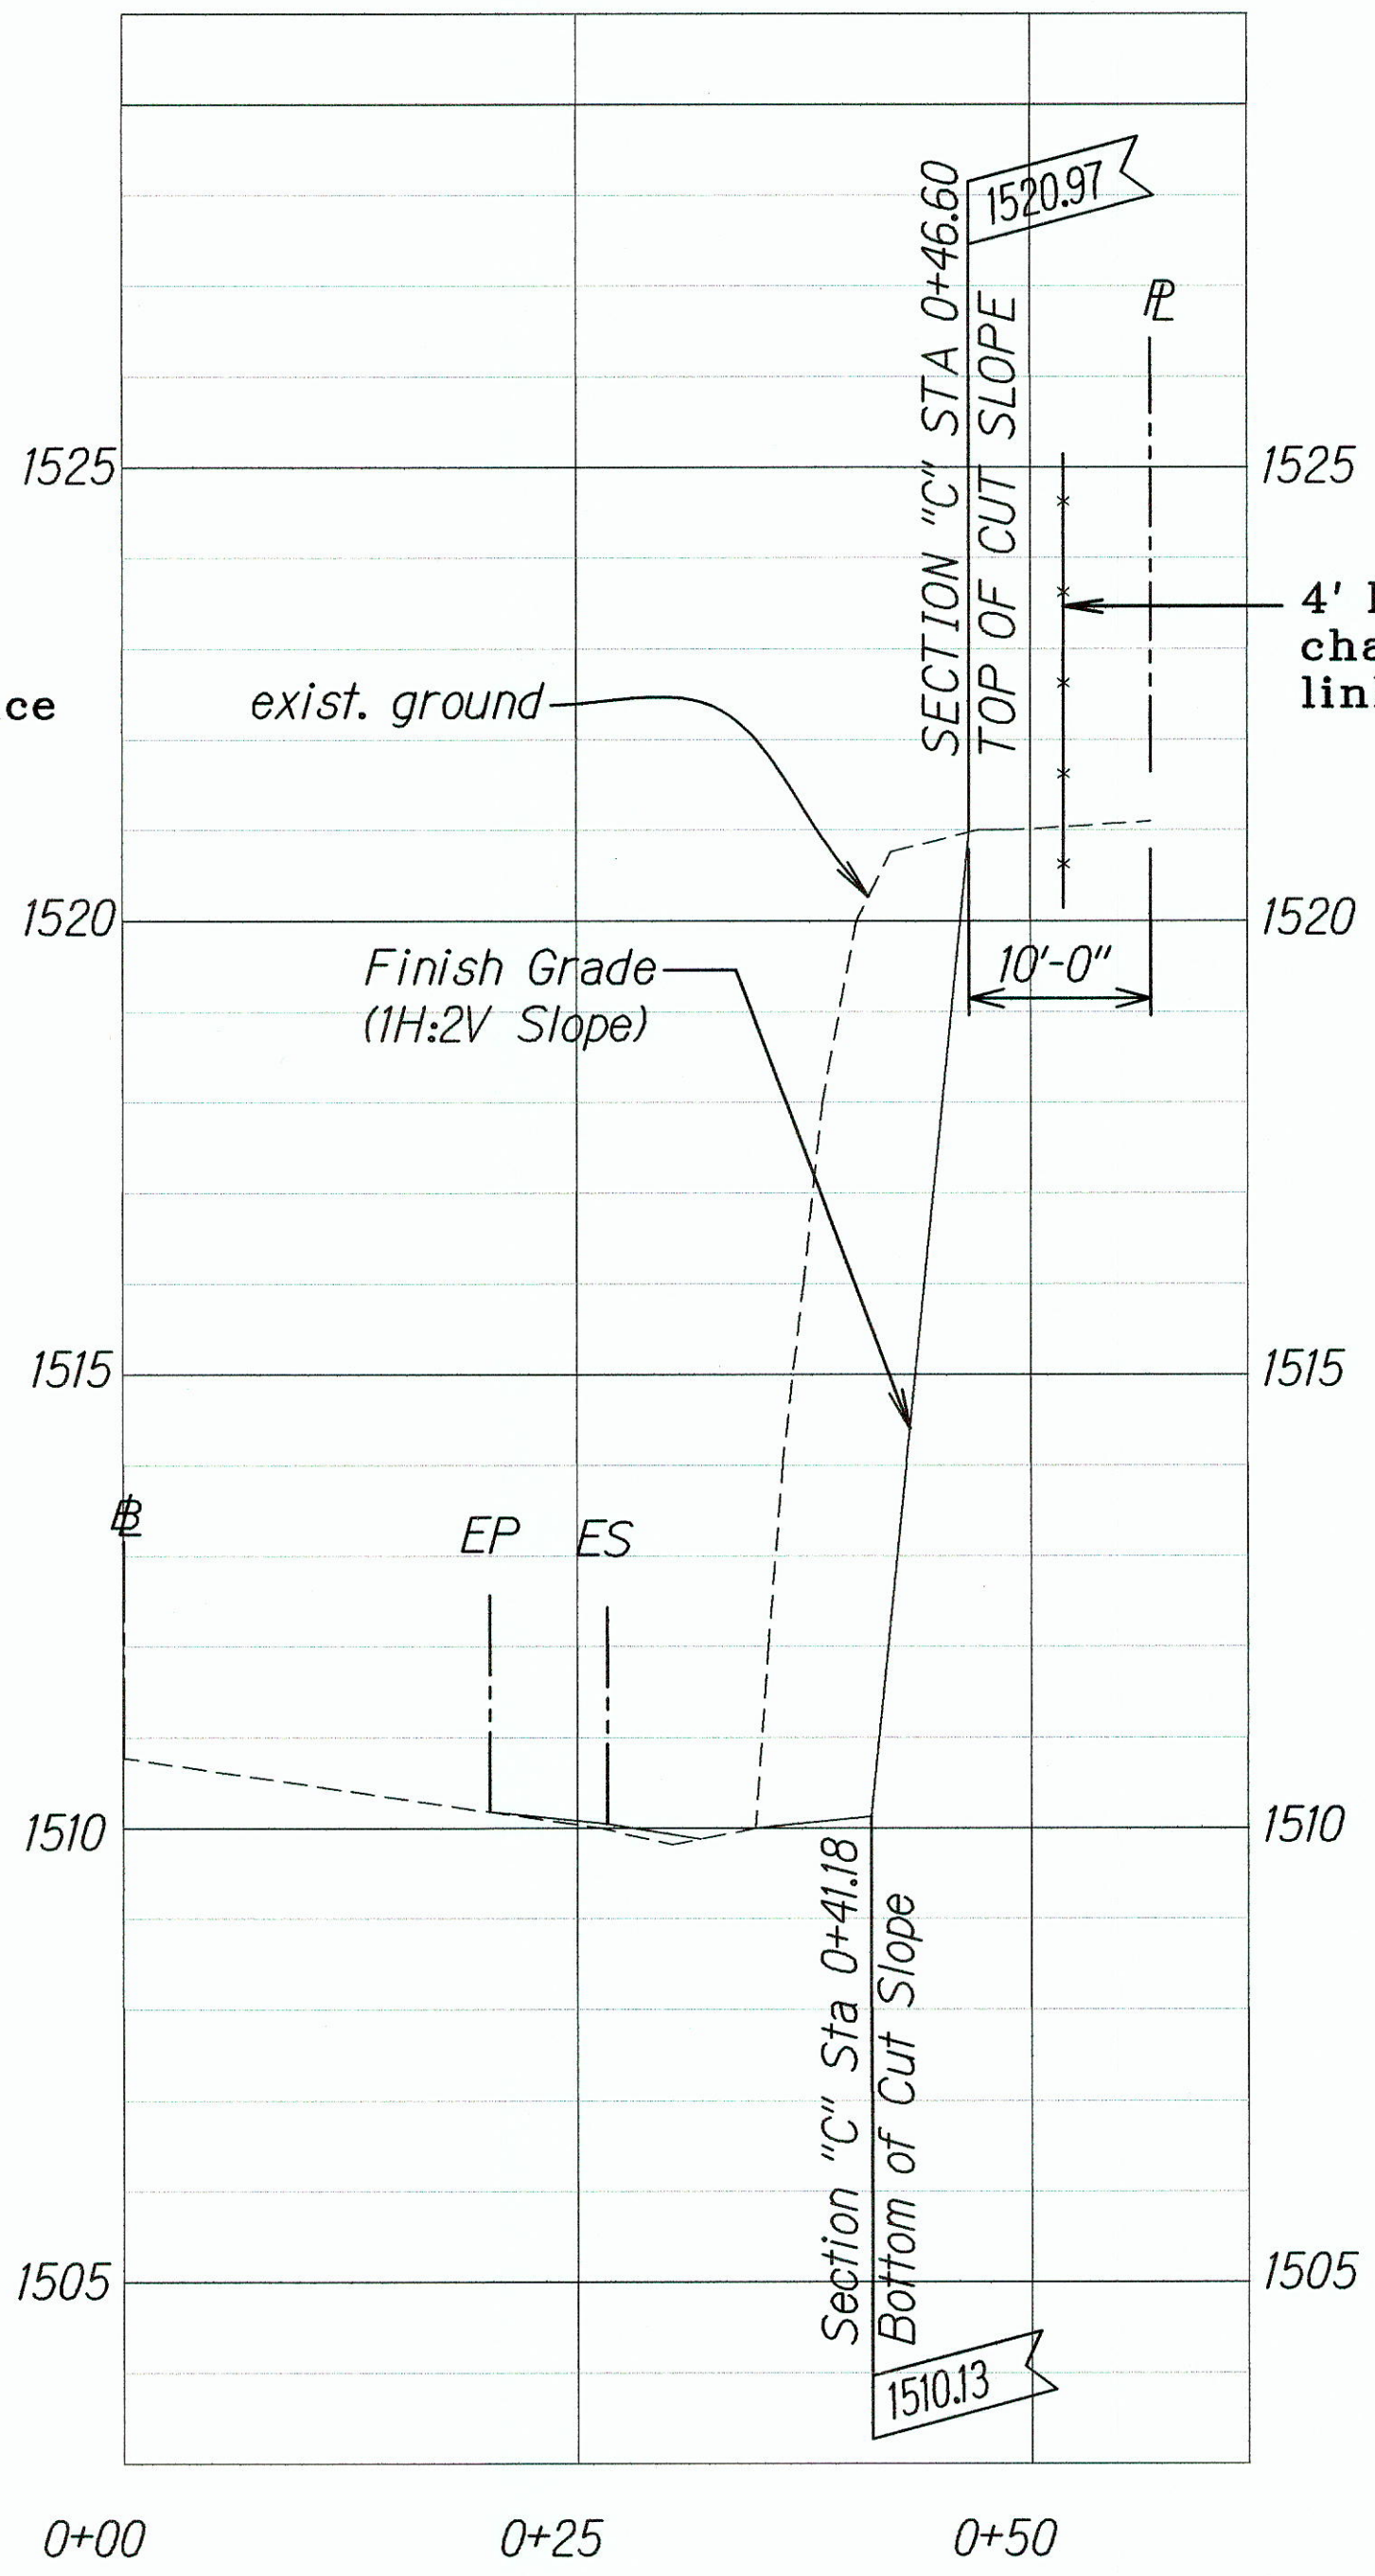


SECTION "C" @ STA 96+40 C
 SCALE: Horiz.: 1"= 10'
 Vert.: 1"= 2' C-30 | C-43

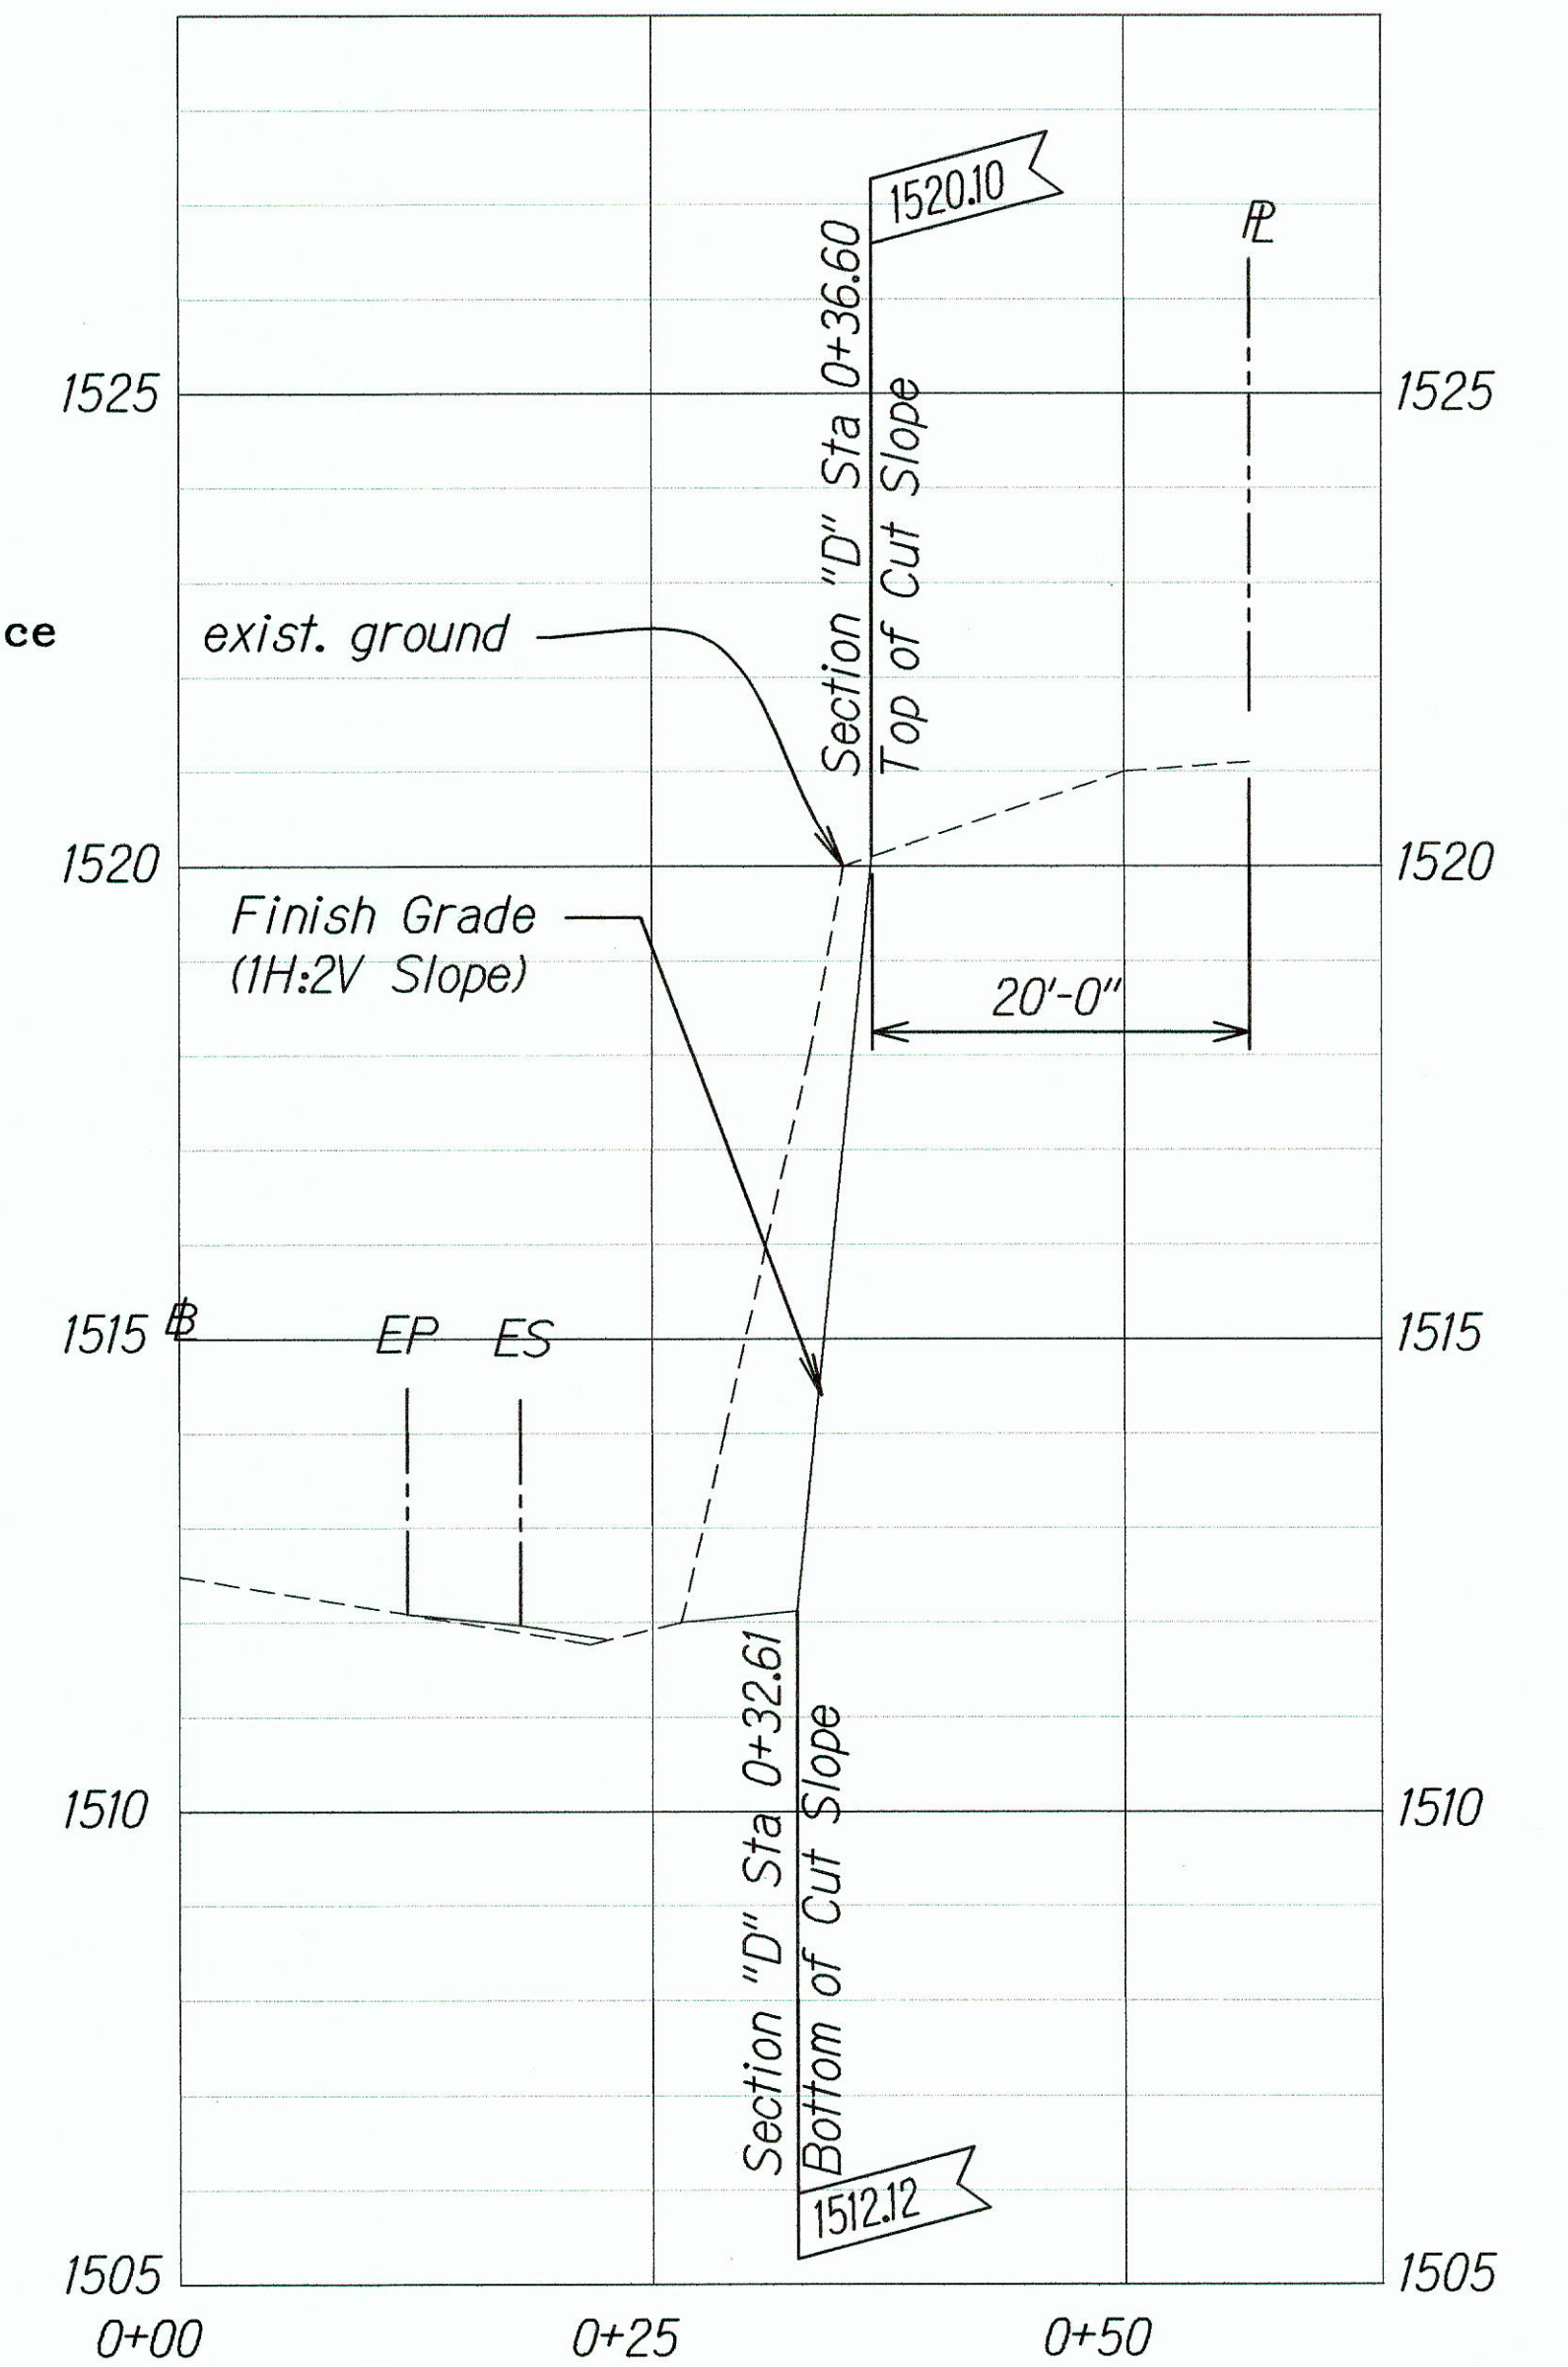

SECTION "D" @ KALOKO DR. D
 SCALE: Horiz.: 1"= 10'
 Vert.: 1"= 2' C-30 | C-43

SURVEY PLOTTED BY	DATE
DRAWN BY	AUG. 2011
TRACED BY	AUG. 2011
QUANTITIES BY	AUG. 2011
CHECKED BY	AUG. 2011
ORIGINAL PLAN	
NOTE BOOK	
No.	

LEGEND FOR AS-BUILT POSTING
 Squiggly line for as-built deletion
 Double line for as-built deletion
 Roadway Text for as-built posting

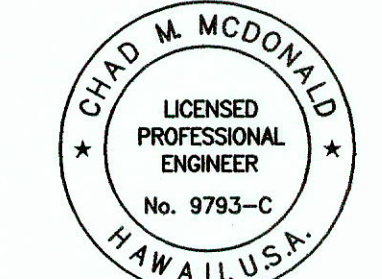

This work was prepared by me or under my supervision
 Chad M. McDonald 4/30/2016
 MITSUNAGA & ASSOCIATES, INC. EXP. DATE
 NOTE: Contractor to check and verify dimensions at job before proceeding with work.

STATE OF HAWAII
 DEPARTMENT OF TRANSPORTATION
 HIGHWAYS DIVISION
SECTIONS AT
KALOKO DRIVE
 MAMALAHOA HIGHWAY RESURFACING
 MAKALEI TO PALANI ROAD JUNCTION
 F.A. Project No. STP-0190(015)
 Scale: As Noted Date: November 2011
 SHEET No. **C-43** OF **59** SHEETS

"AS-BUILT"