

INDEX TO DRAWINGS	
SHEET NO.	DESCRIPTION
1	TITLE SHEET
2	STANDARD PLANS SUMMARY
3	GENERAL NOTES AND LEGEND
4 - 5	WATER POLLUTION AND EROSION CONTROL NOTES
6 - 8	TYPICAL SECTIONS
9 - 20	GUARDRAIL DETAILS
21	GENERAL PLAN
22 - 29	ROADWAY PLAN
30 - 34	ROADWAY PLAN INSETS
35	SIGNAGE NOTES & DETAILS
36	PAVEMENT MARKINGS LEGEND, DETAILS & NOTES
37 - 44	SIGNAGE AND STRIPING PLANS
45	SECTIONS AT KALOKO DRIVE
46	SECTIONS AT ONAONA DRIVE
47 - 48	CONSTRUCTION SIGN DETAILS
49 - 59	SCHEDULES

STATE OF HAWAII

DEPARTMENT OF TRANSPORTATION

HIGHWAYS DIVISION

HONOLULU, HAWAII

"AS-BUILT"

PLANS FOR



MAMALAHOA HIGHWAY RESURFACING

MAKALEI TO PALANI ROAD JUNCTION

Federal-Aid Project No. STP-0190(015)

DISTRICT OF NORTH KONA

ISLAND OF HAWAII

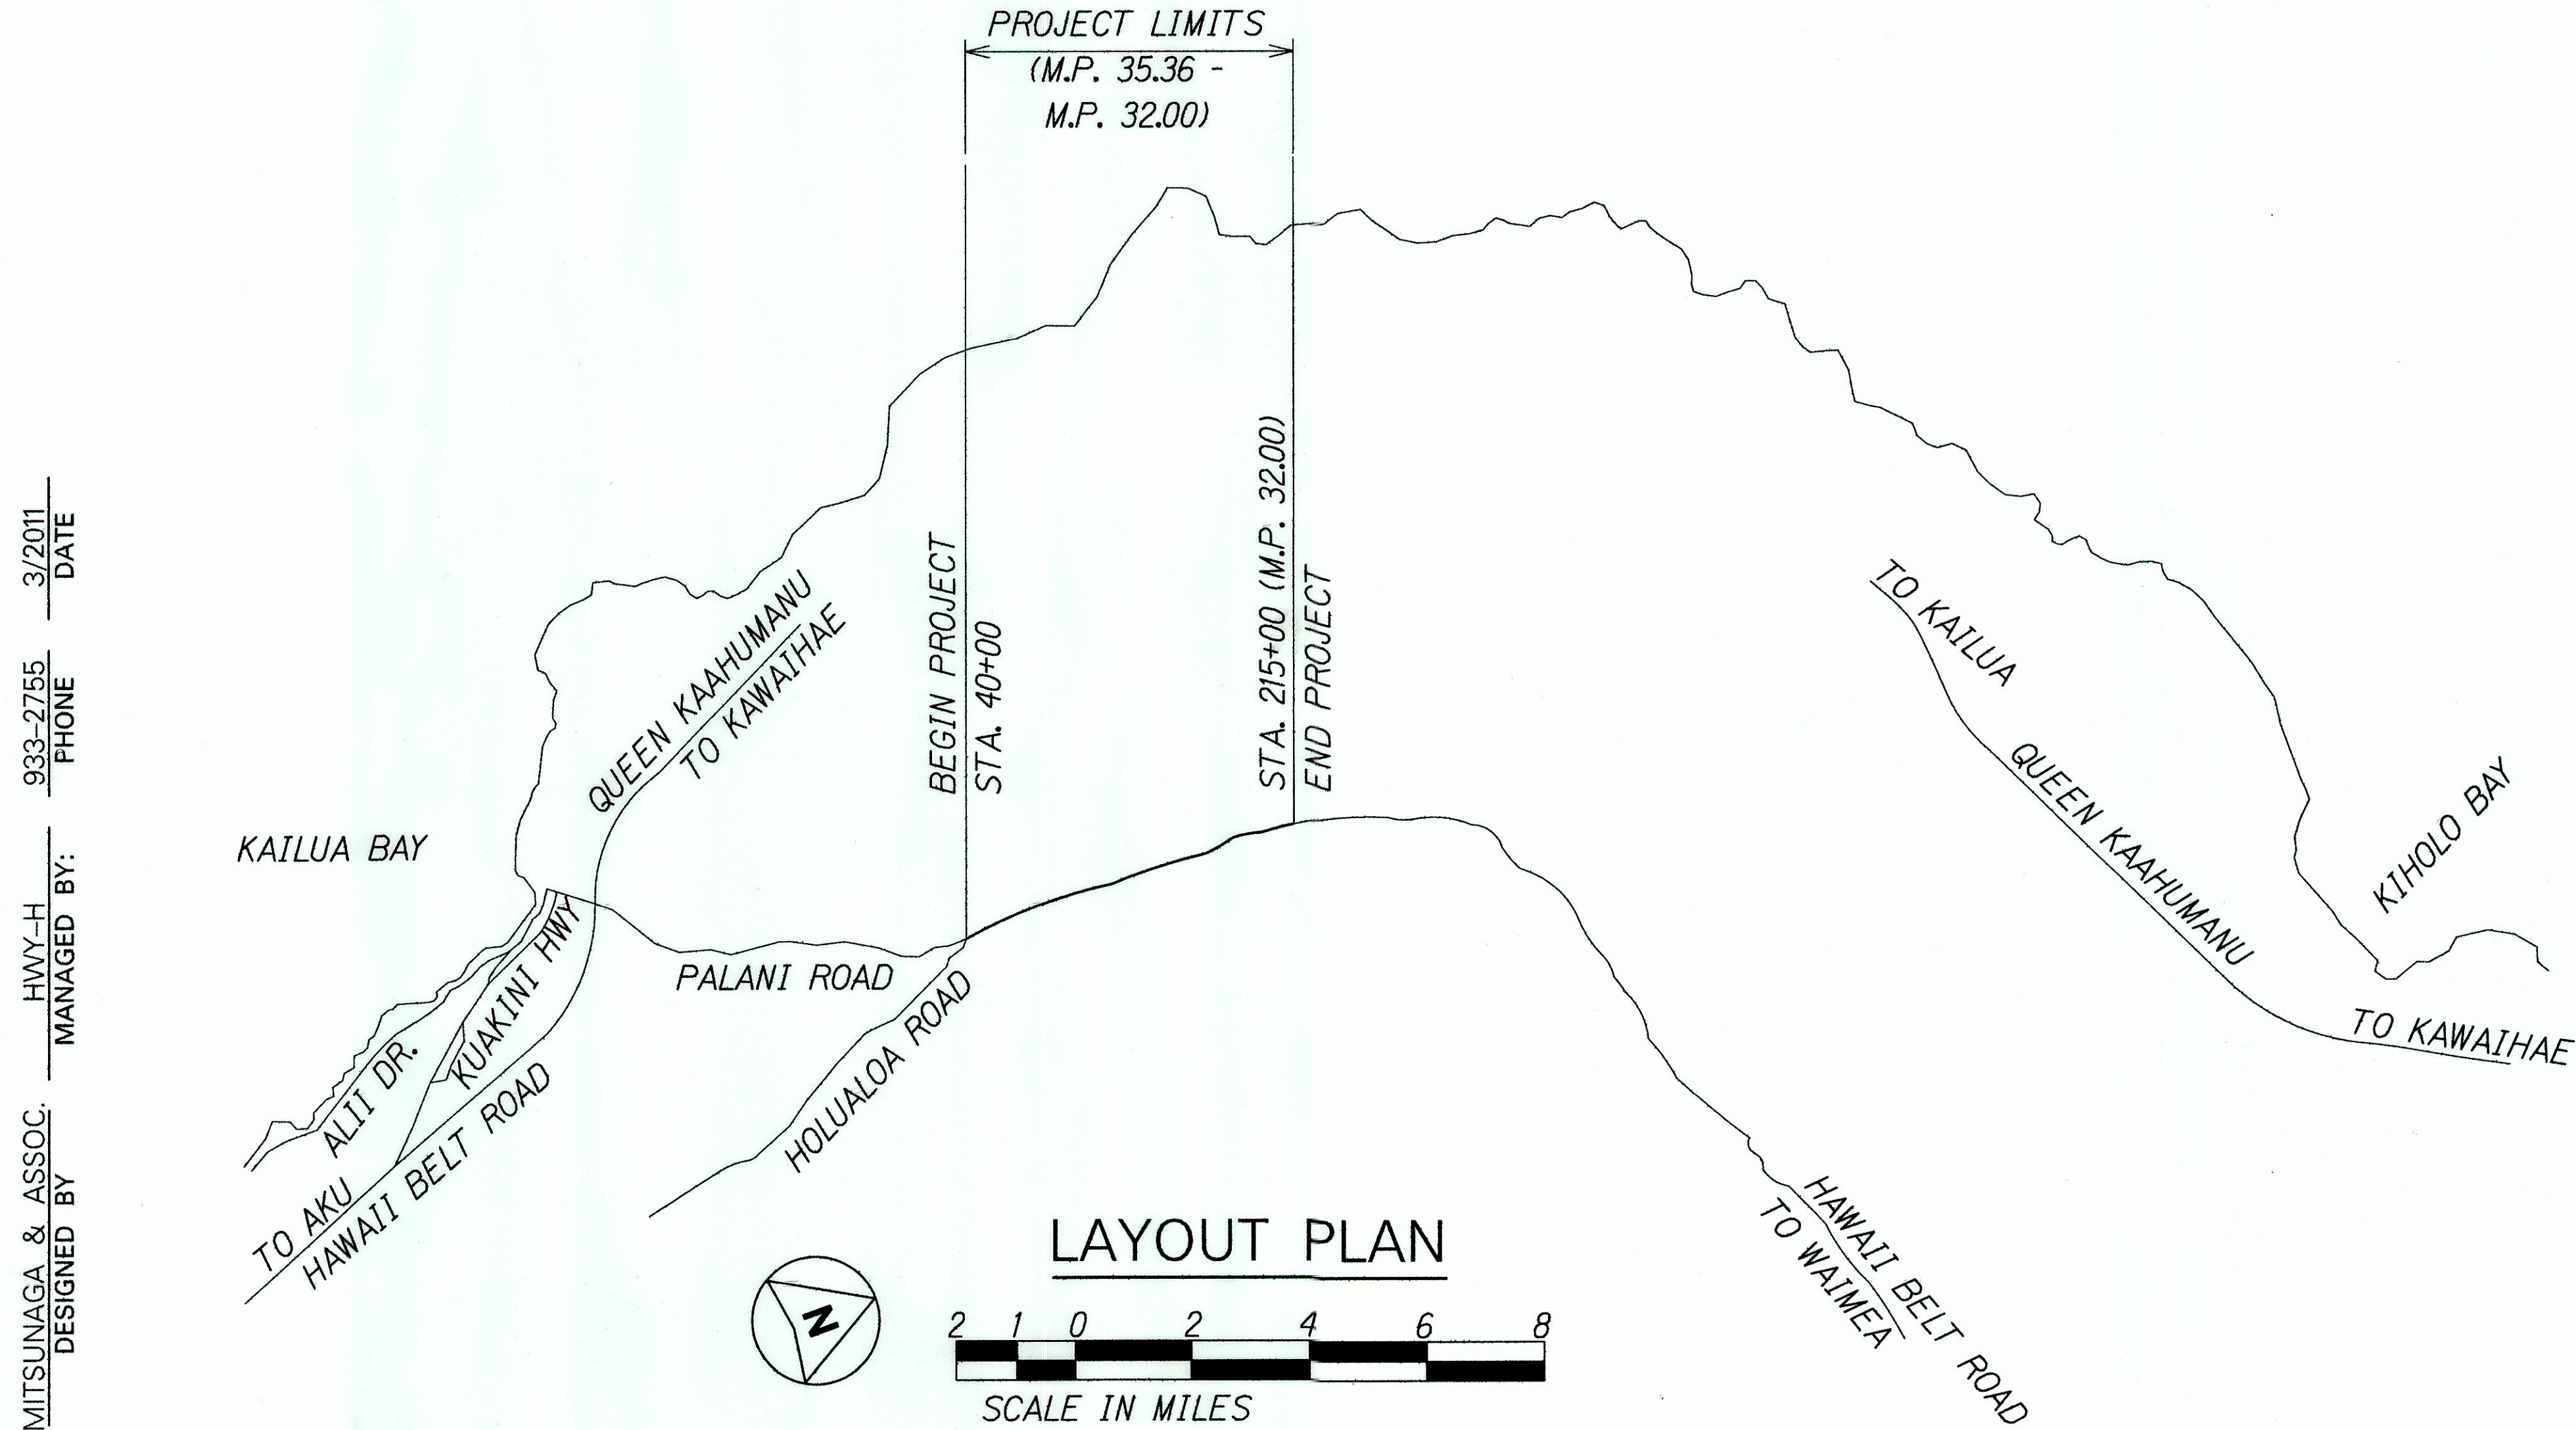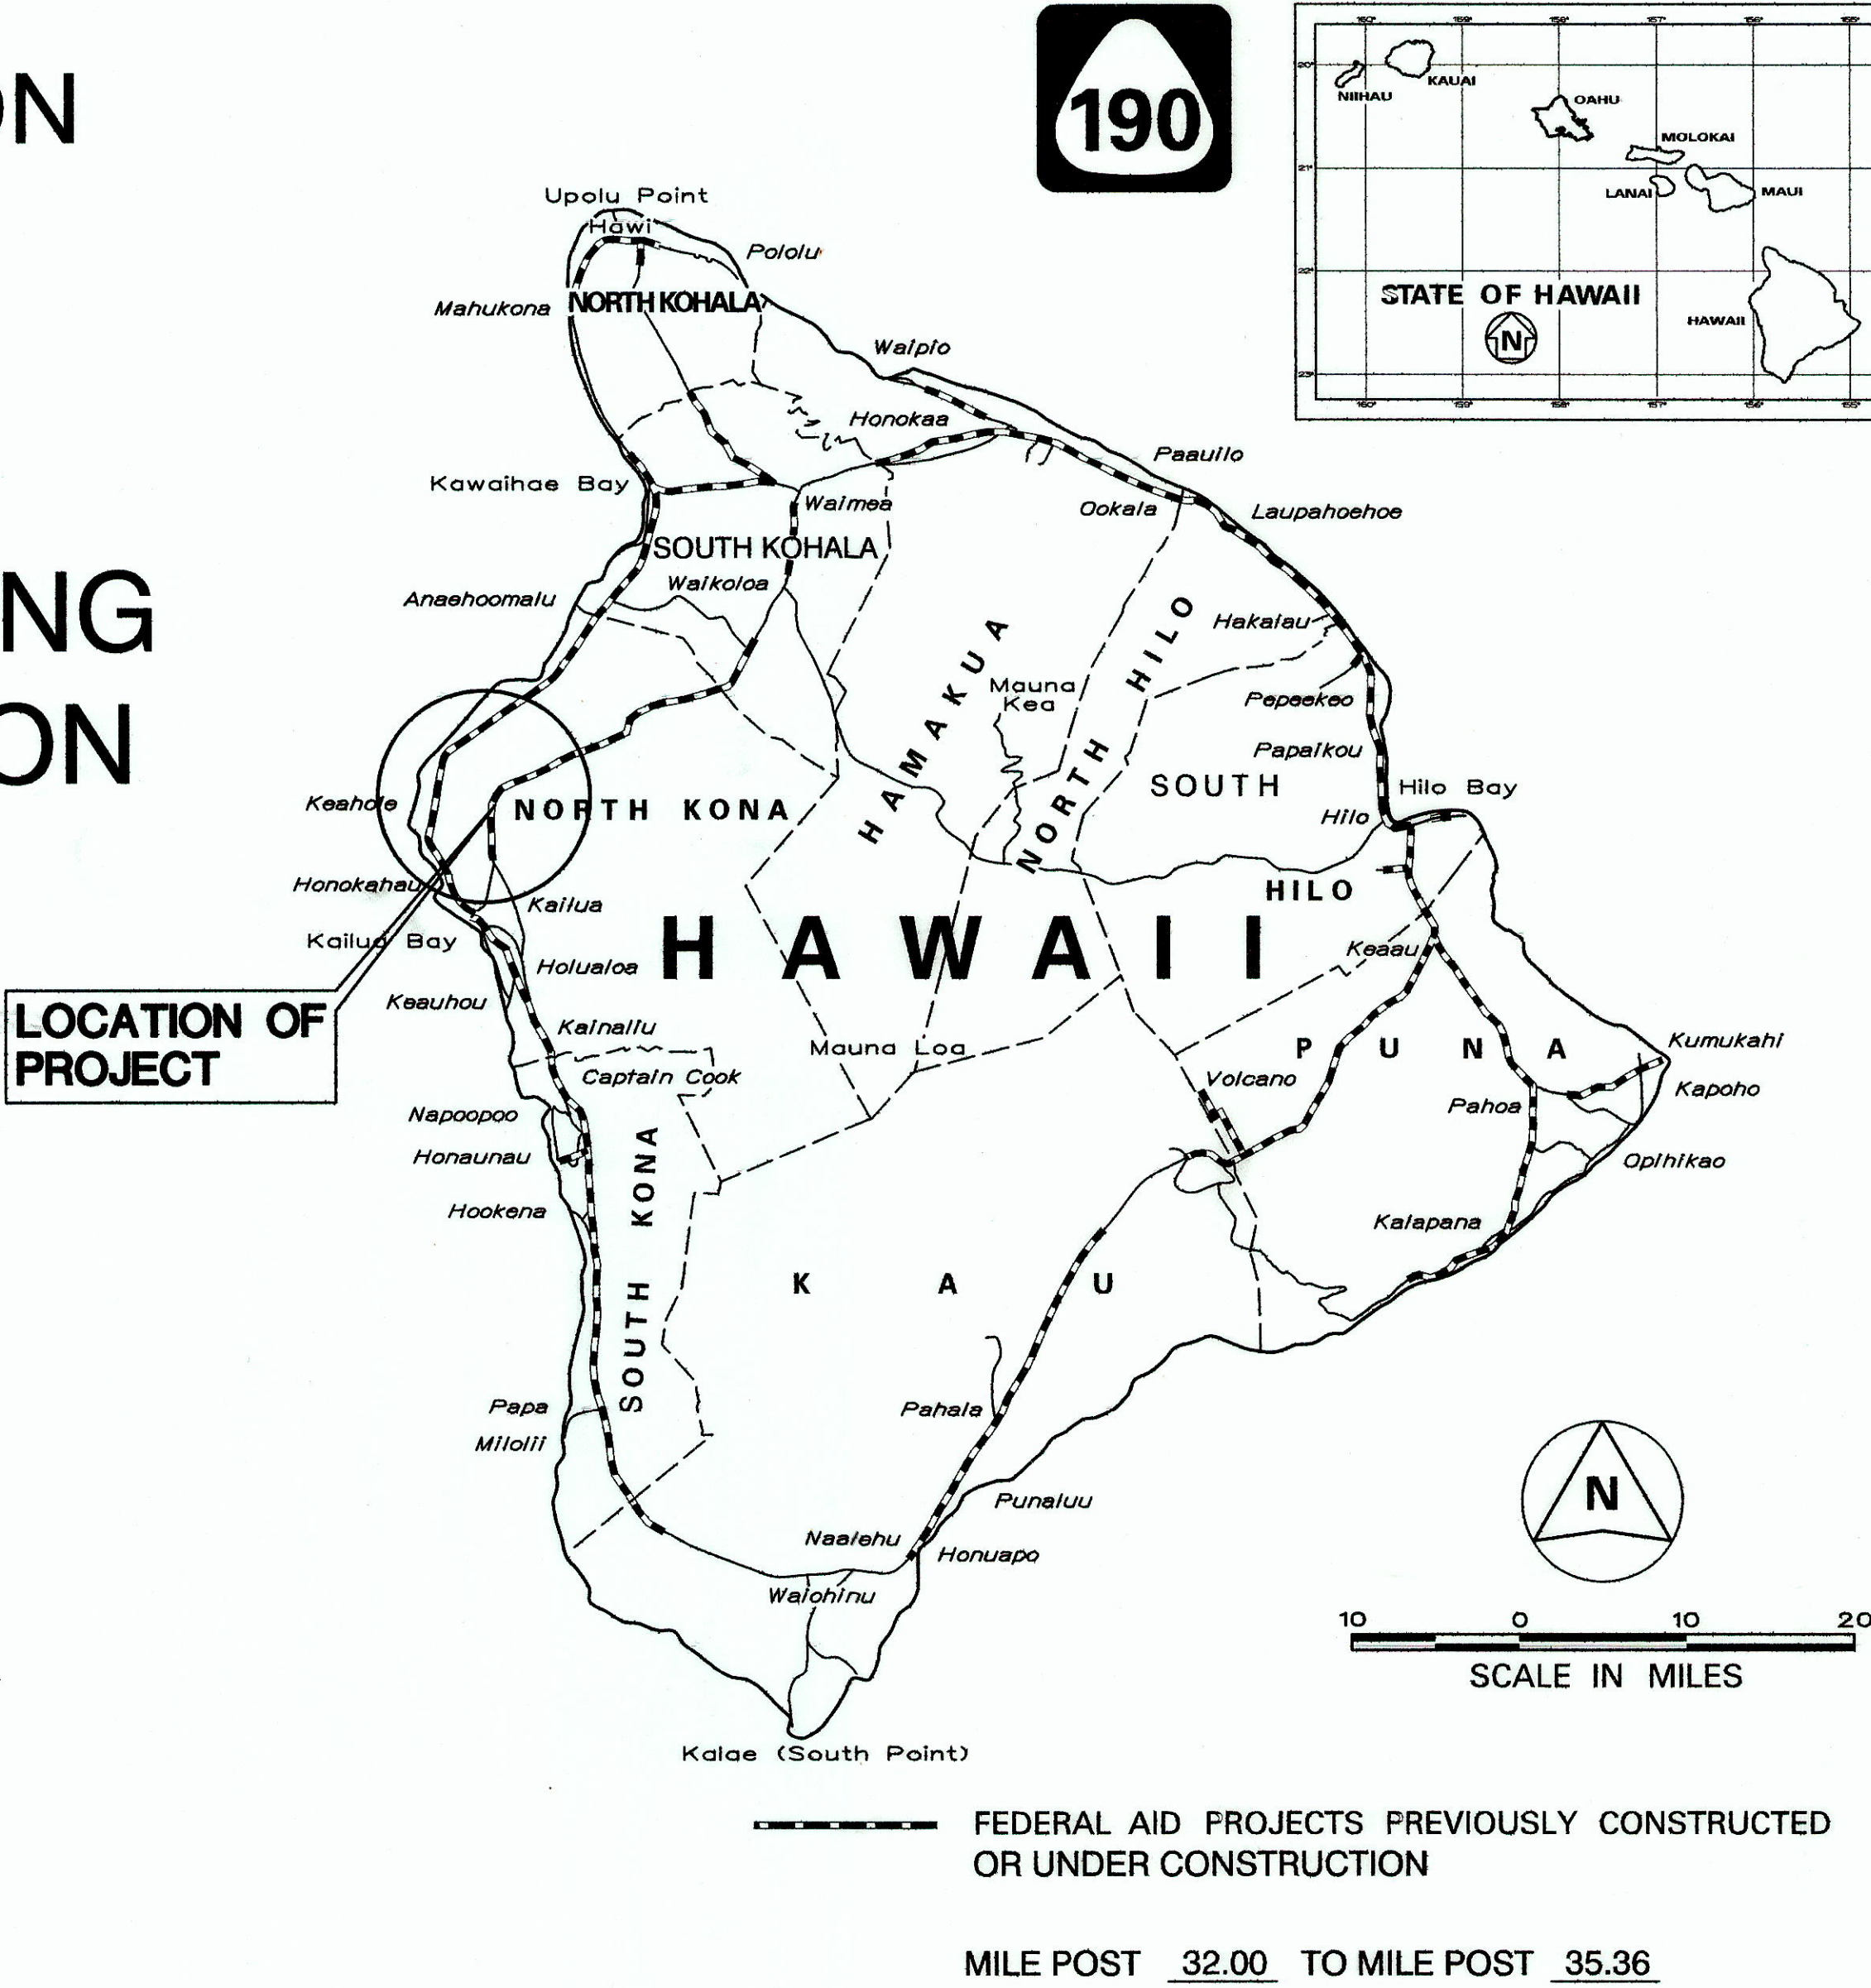

DESIGN DESIGNATION

SECTION	WORK AREA
DATA	
ADT (2011)	15,900
ADT (2021)	20,200
DHV (2021)	1,820
D	70/30
T	6.0
T24	4.5
V	60 M.P.H.

CHANGES MADE DURING CONSTRUCTION HAVE BEEN INCORPORATED ON THESE PLANS EXCEPT CHANGES IN THE ORIGINAL THEORETICAL QUANTITIES. FOR ACTUAL QUANTITIES, REFER TO PROJECT LEDGER AND/OR COMPUTATION BOOK.

RESIDENT ENGINEER 1-28-15 DATE

DEPARTMENT OF TRANSPORTATION
STATE OF HAWAII
APPROVED: *[Signature]* 11/08/11
DIR. OF TRANSPORTATION DATE