


FED. ROAD DIST. NO.	STATE	FED. AID PROJ. NO.	FISCAL YEAR	SHEET NO.	TOTAL SHEETS
HAWAII	HAW.	STP-0190(016)	2016	9	36

LEGEND FOR AS-BUILT POSTINGS

-  Squiggly line for as-built deletion
-  Double line for as-built deletion
-  Text for as-built posting

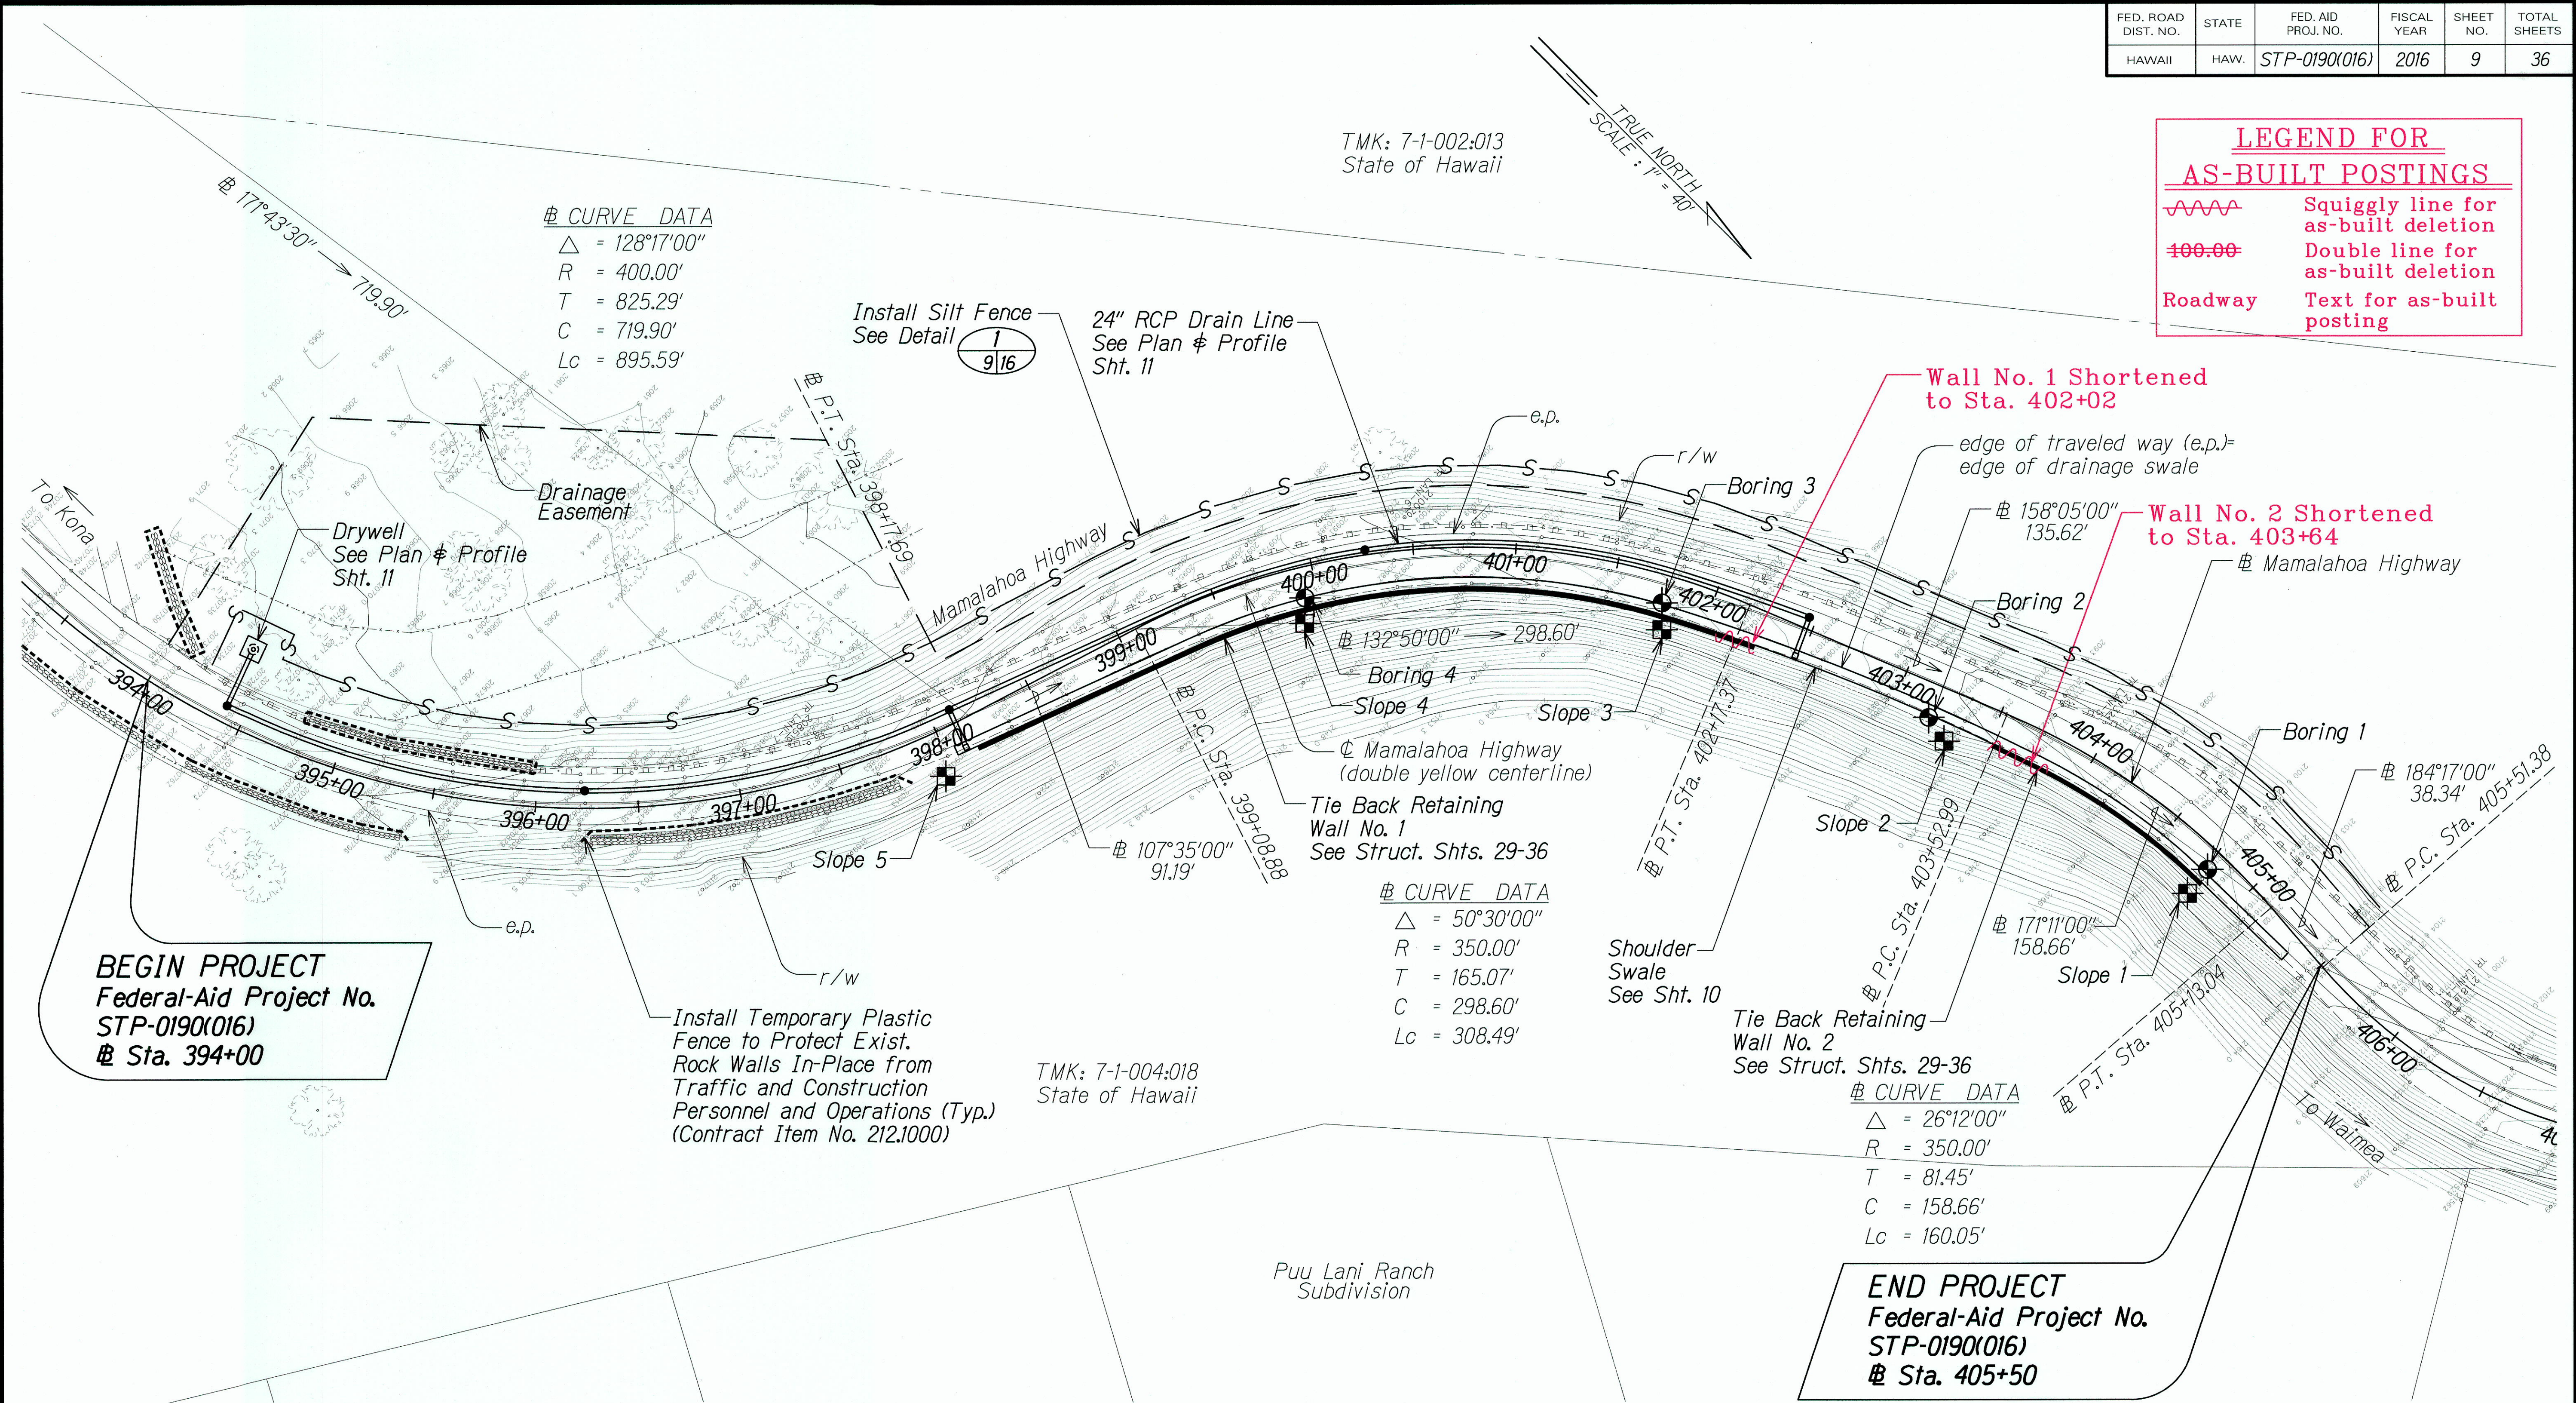


LEGEND

-  Silt Fence
-  Temporary Plastic Fence
-  *Approximate Fewell Geotechnical Engineering, Ltd. Boring Location
-  *Approximate Fewell Geotechnical Engineering, Ltd. Slope Location
- *See Boring and Slope Logs, Sheets 24-28

SITE PLAN Scale: 1"=40'

Notes:

- The new swale will begin at the edge of the existing travel lane. Existing travel lane widths will remain the same.
- The Mamalahoa baseline (B) is not equivalent to the double yellow centerline (C) striping.

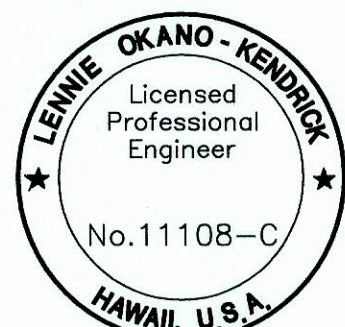

This work was prepared by me or under my supervision.
Lennie Okano-Kendrick
 Expiration Date of License 4/18

STATE OF HAWAII
DEPARTMENT OF TRANSPORTATION
HIGHWAYS DIVISION

SITE PLAN
MAMALAHOA HIGHWAY
DRAINAGE IMPROVEMENTS
Vicinity of Puuwaawaa Ranch Road
Federal-Aid Project No. STP-0190(016)
Scale: 1"=40' Date: April 2016

SHEET No. 1 OF 1 SHEETS

"AS-BUILT"