





INDEX TO DRAWINGS	
SHEET NO.	DESCRIPTION
1	TITLE SHEET
2	STANDARD PLANS SUMMARY
3	GENERAL NOTES AND LEGEND
4-5	TYPICAL SECTIONS
6	PAVEMENT RECONSTRUCTION DETAILS
7-11	RECONSTRUCTION AREA SCHEDULE ① ② ③ ④ ⑤
12-13	GUARDRAIL SCHEDULE
14-19	GUARDRAIL DETAILS
20-38	ROADWAY PLANS
39	PAVEMENT MARKING LEGEND, DETAILS AND NOTES
40-58	SIGNS AND PAVEMENT MARKING PLANS
59	SIGN SCHEDULE
60	SIGN DETAILS
61-62	REFLECTOR AND OBJECT MARKER SCHEDULE ⑥ ⑦
63-64	STRIPING AND PAVEMENT MARKING DETAILS
65-66	MISCELLANEOUS SCHEDULES

Sheet Nos. 115^①, 115^②, 115^③, 115^④, 115^⑤, 625^①, and 625^② are supplementary sheets to this project. Sheets 7 through 11, 61, and 62 are Not In Contract. Total sheet count after "As Built" posting is 73 sheets.

STATE OF HAWAII
DEPARTMENT OF TRANSPORTATION
HIGHWAYS DIVISION
HONOLULU, HAWAII
"AS-BUILT"
PLANS FOR
ROUTE 190
HAWAII BELT ROAD
RESURFACING

VICINITY OF KEAMUKU TO PUUANAHULU
M.P. 9.74 TO M.P. 16.45
PROJECT NO. 190C-01-00M
DISTRICTS OF SOUTH KOHALA AND NORTH KONA
ISLAND OF HAWAII

FED. ROAD DIST. NO.	STATE	PROJ. NO.	FISCAL YEAR	SHEET NO.	TOTAL SHEETS
HAWAII	HAW.	190C-01-00M	2000	ADD. I	66

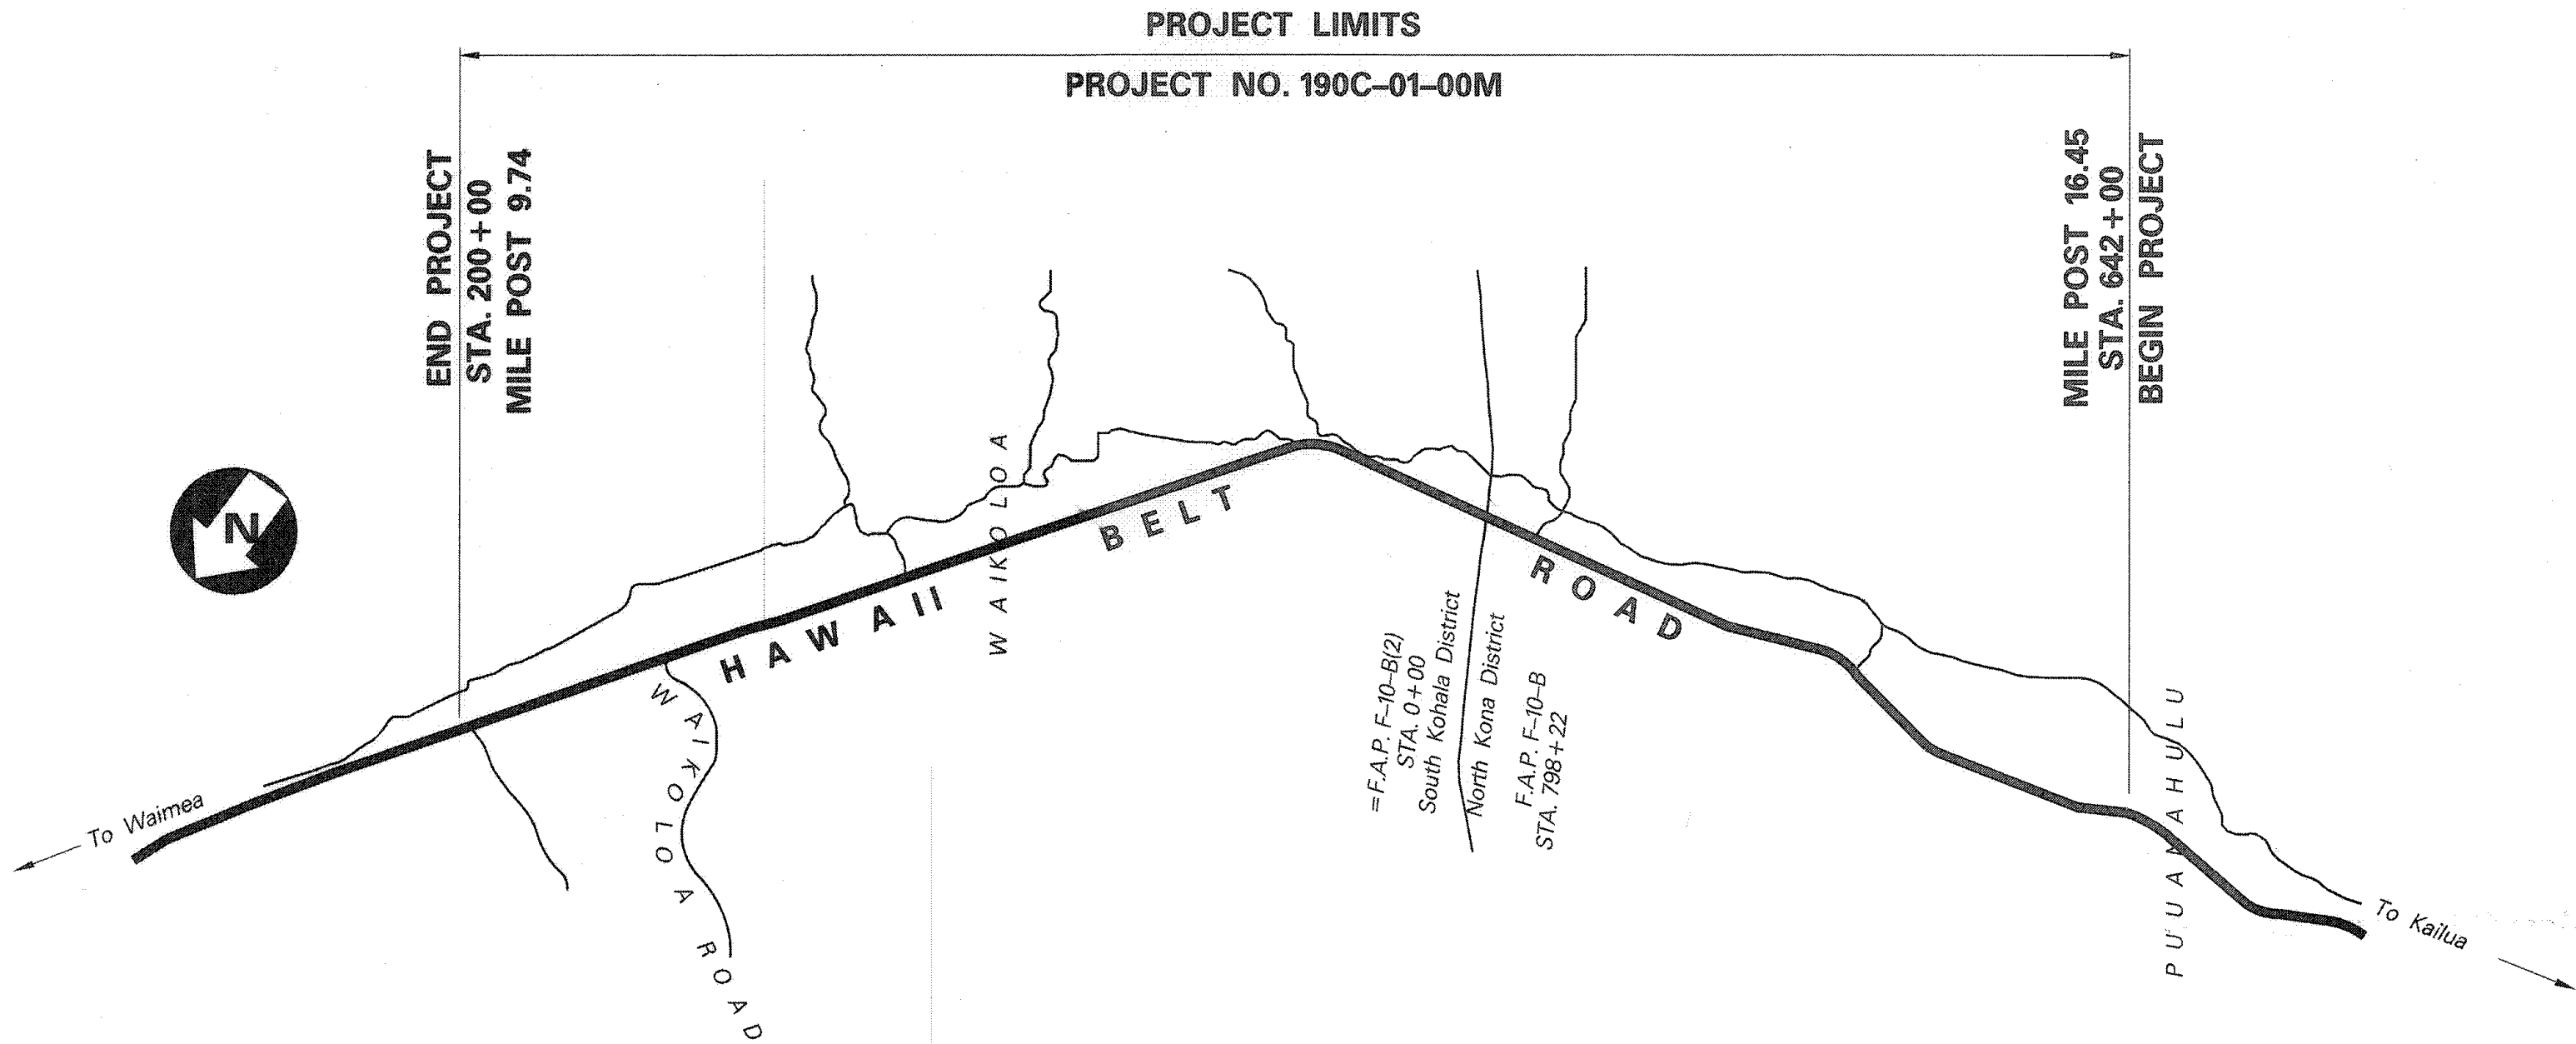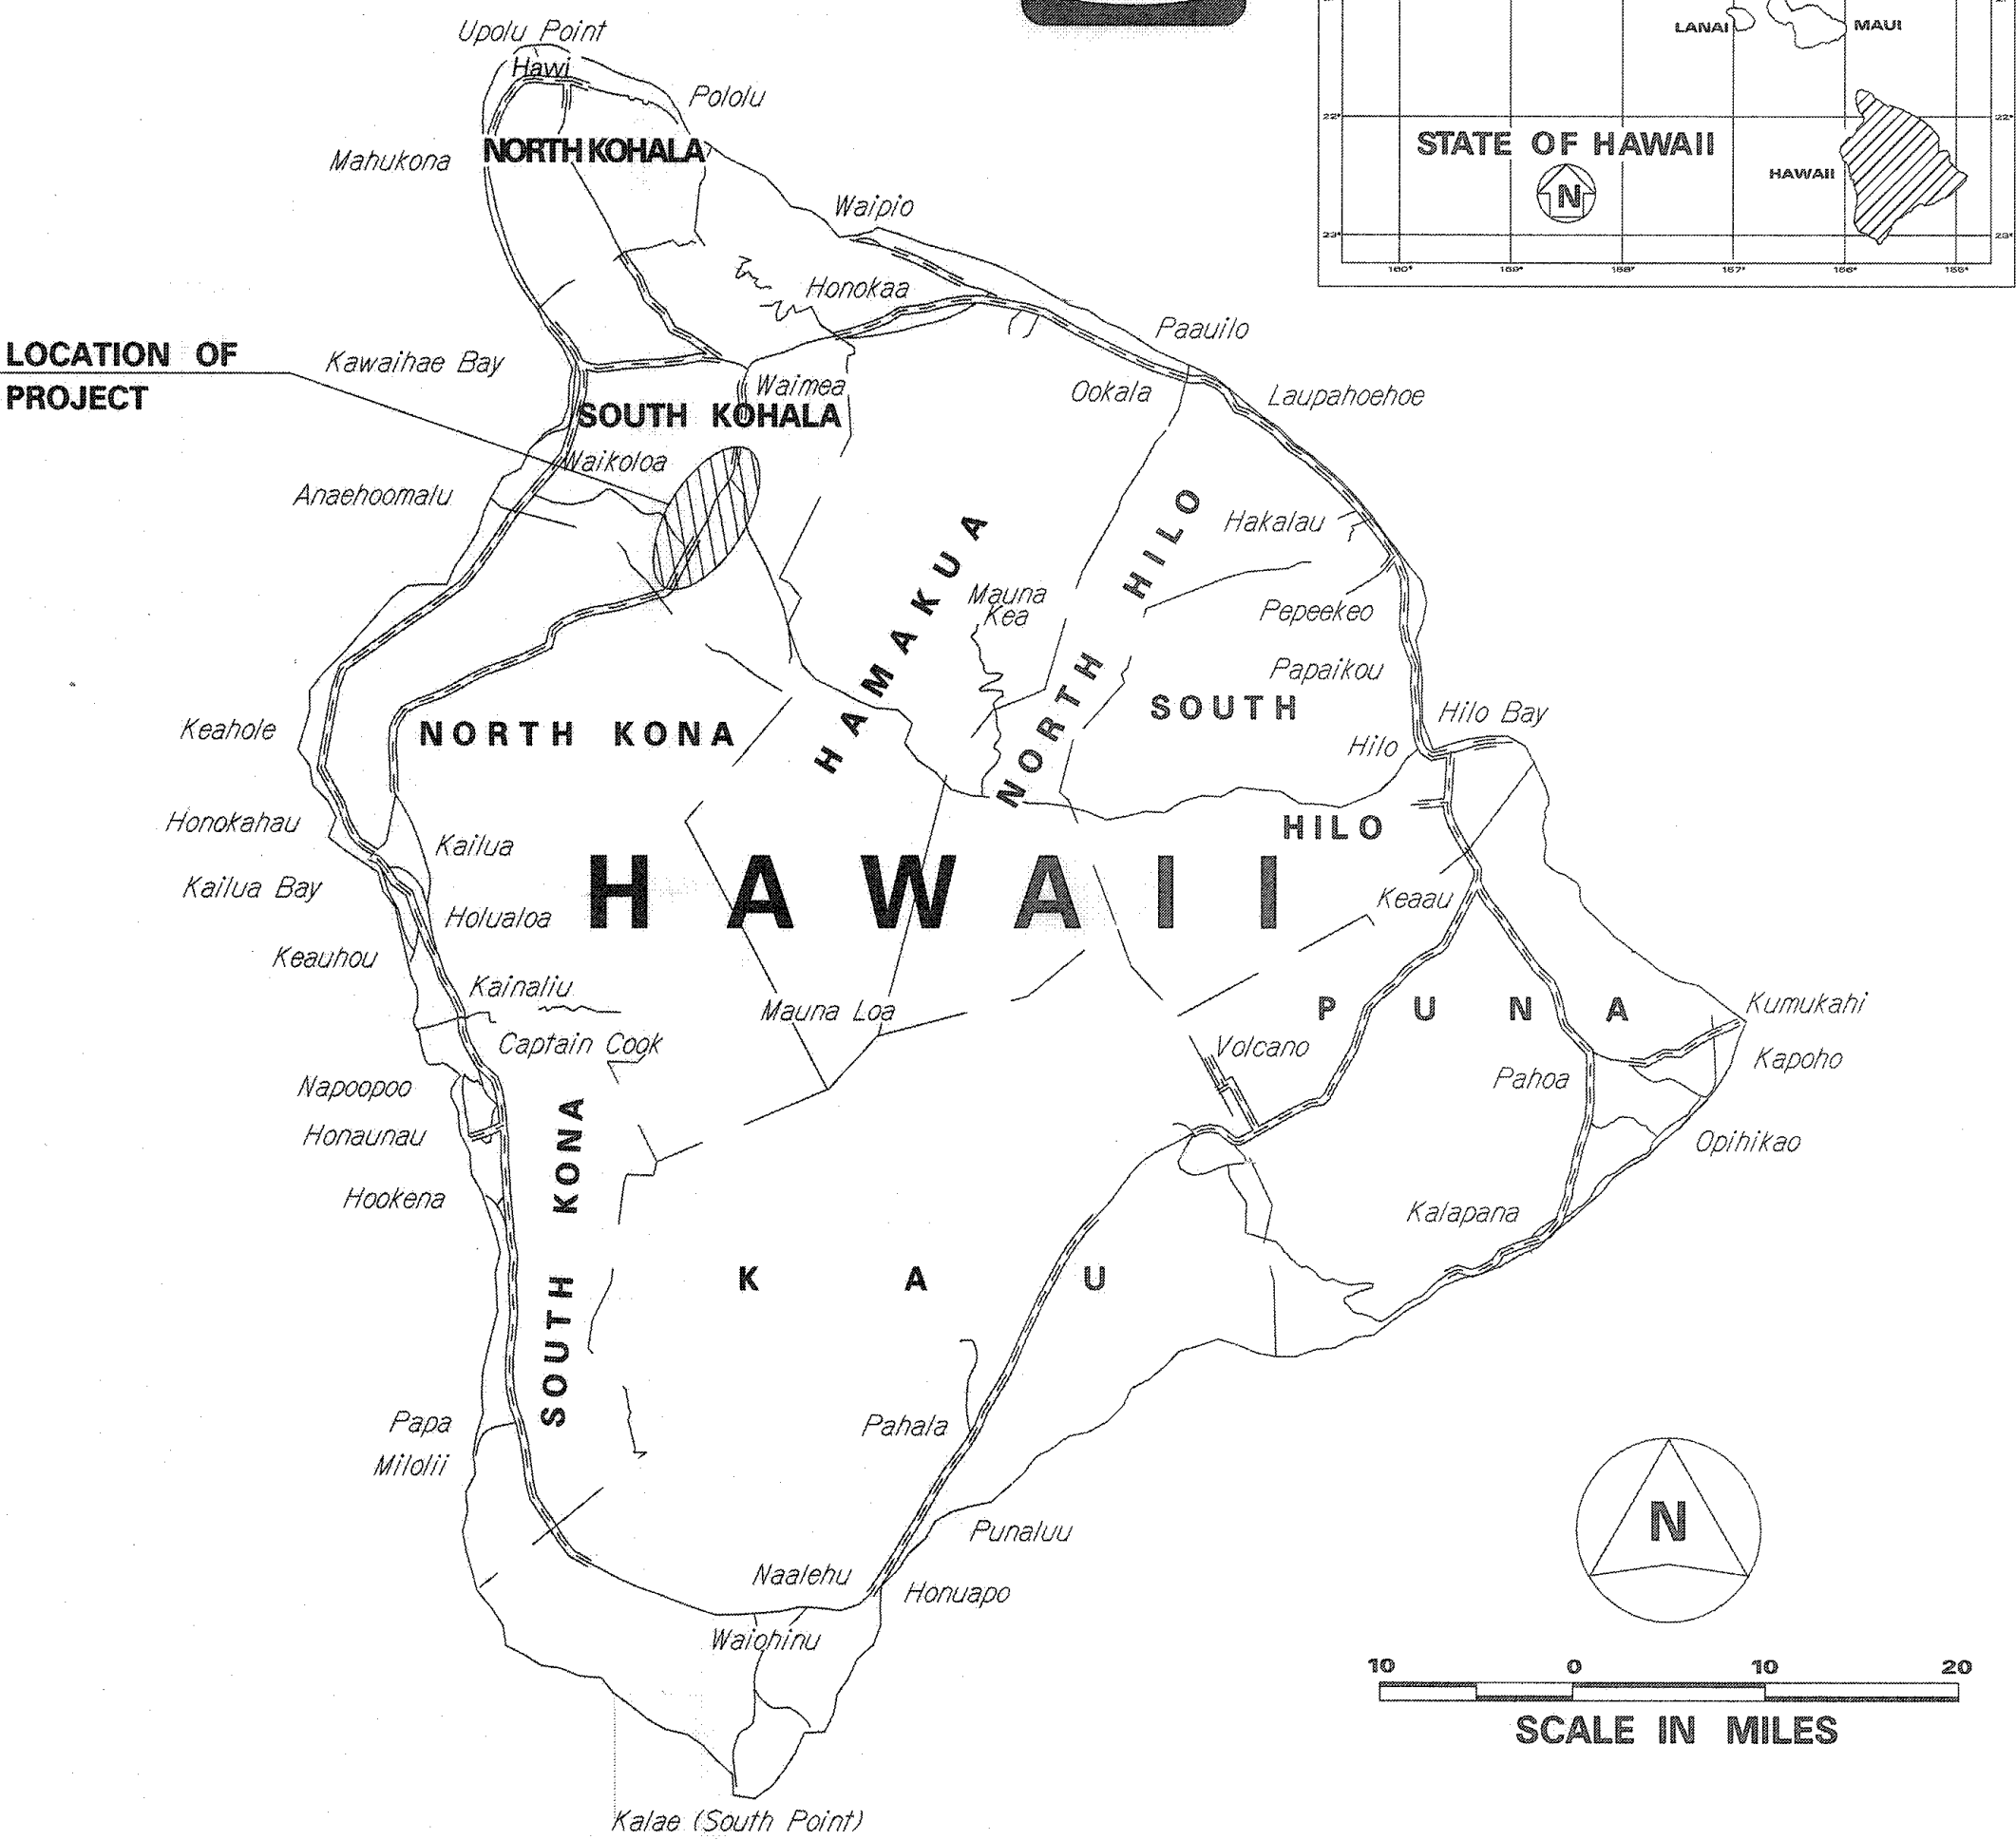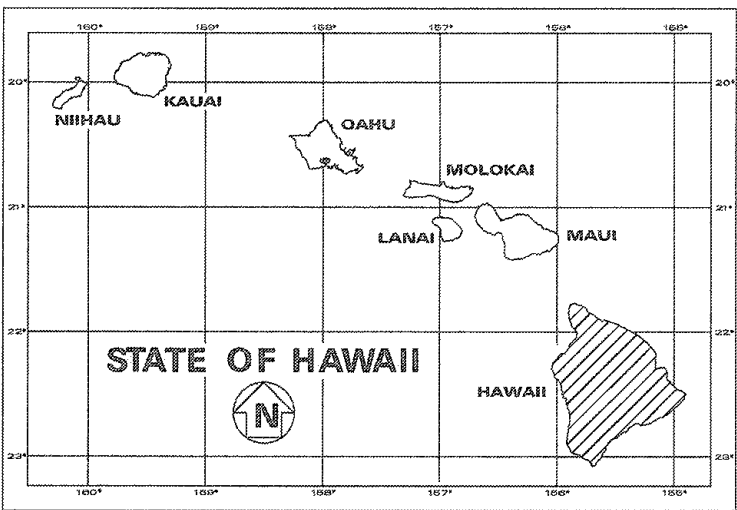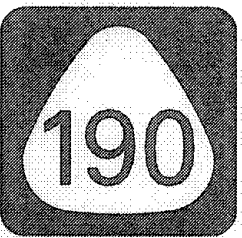

FEDERAL AID PROJECTS PREVIOUSLY CONSTRUCTED OR UNDER CONSTRUCTION

MILE POST 9.74 TO MILE POST 16.45

CHANGES MADE DURING CONSTRUCTION HAVE BEEN INCORPORATED ON THE PLANS EXCEPT CHANGES IN THE ORIGINAL THEORETICAL QUANTITIES. FOR ACTUAL QUANTITIES, REFER TO PROJECT LEDGER AND/OR COMPUTATION BOOK.

RESIDENT ENGINEER 4-25-08 DATE

DEPARTMENT OF TRANSPORTATION
STATE OF HAWAII
APPROVED: *Kayn Uyehiro* 5/18/00
DIR. OF TRANSPORTATION DATE

6/6/00	Signed Title Sheet
DATE	REVISION

Imata & Assoc., Inc.
DESIGNED BY
R. Taira
P.S. & E. BY
933-8866
PHONE
Apr. 2000
DATE