




FED. ROAD DIST. NO.	STATE	FED. AID PROJECT NO.	FISCAL YEAR	SHEET NO.	TOTAL SHEETS
HAWAII	HAW.	ER15-(22)	2009	10	88

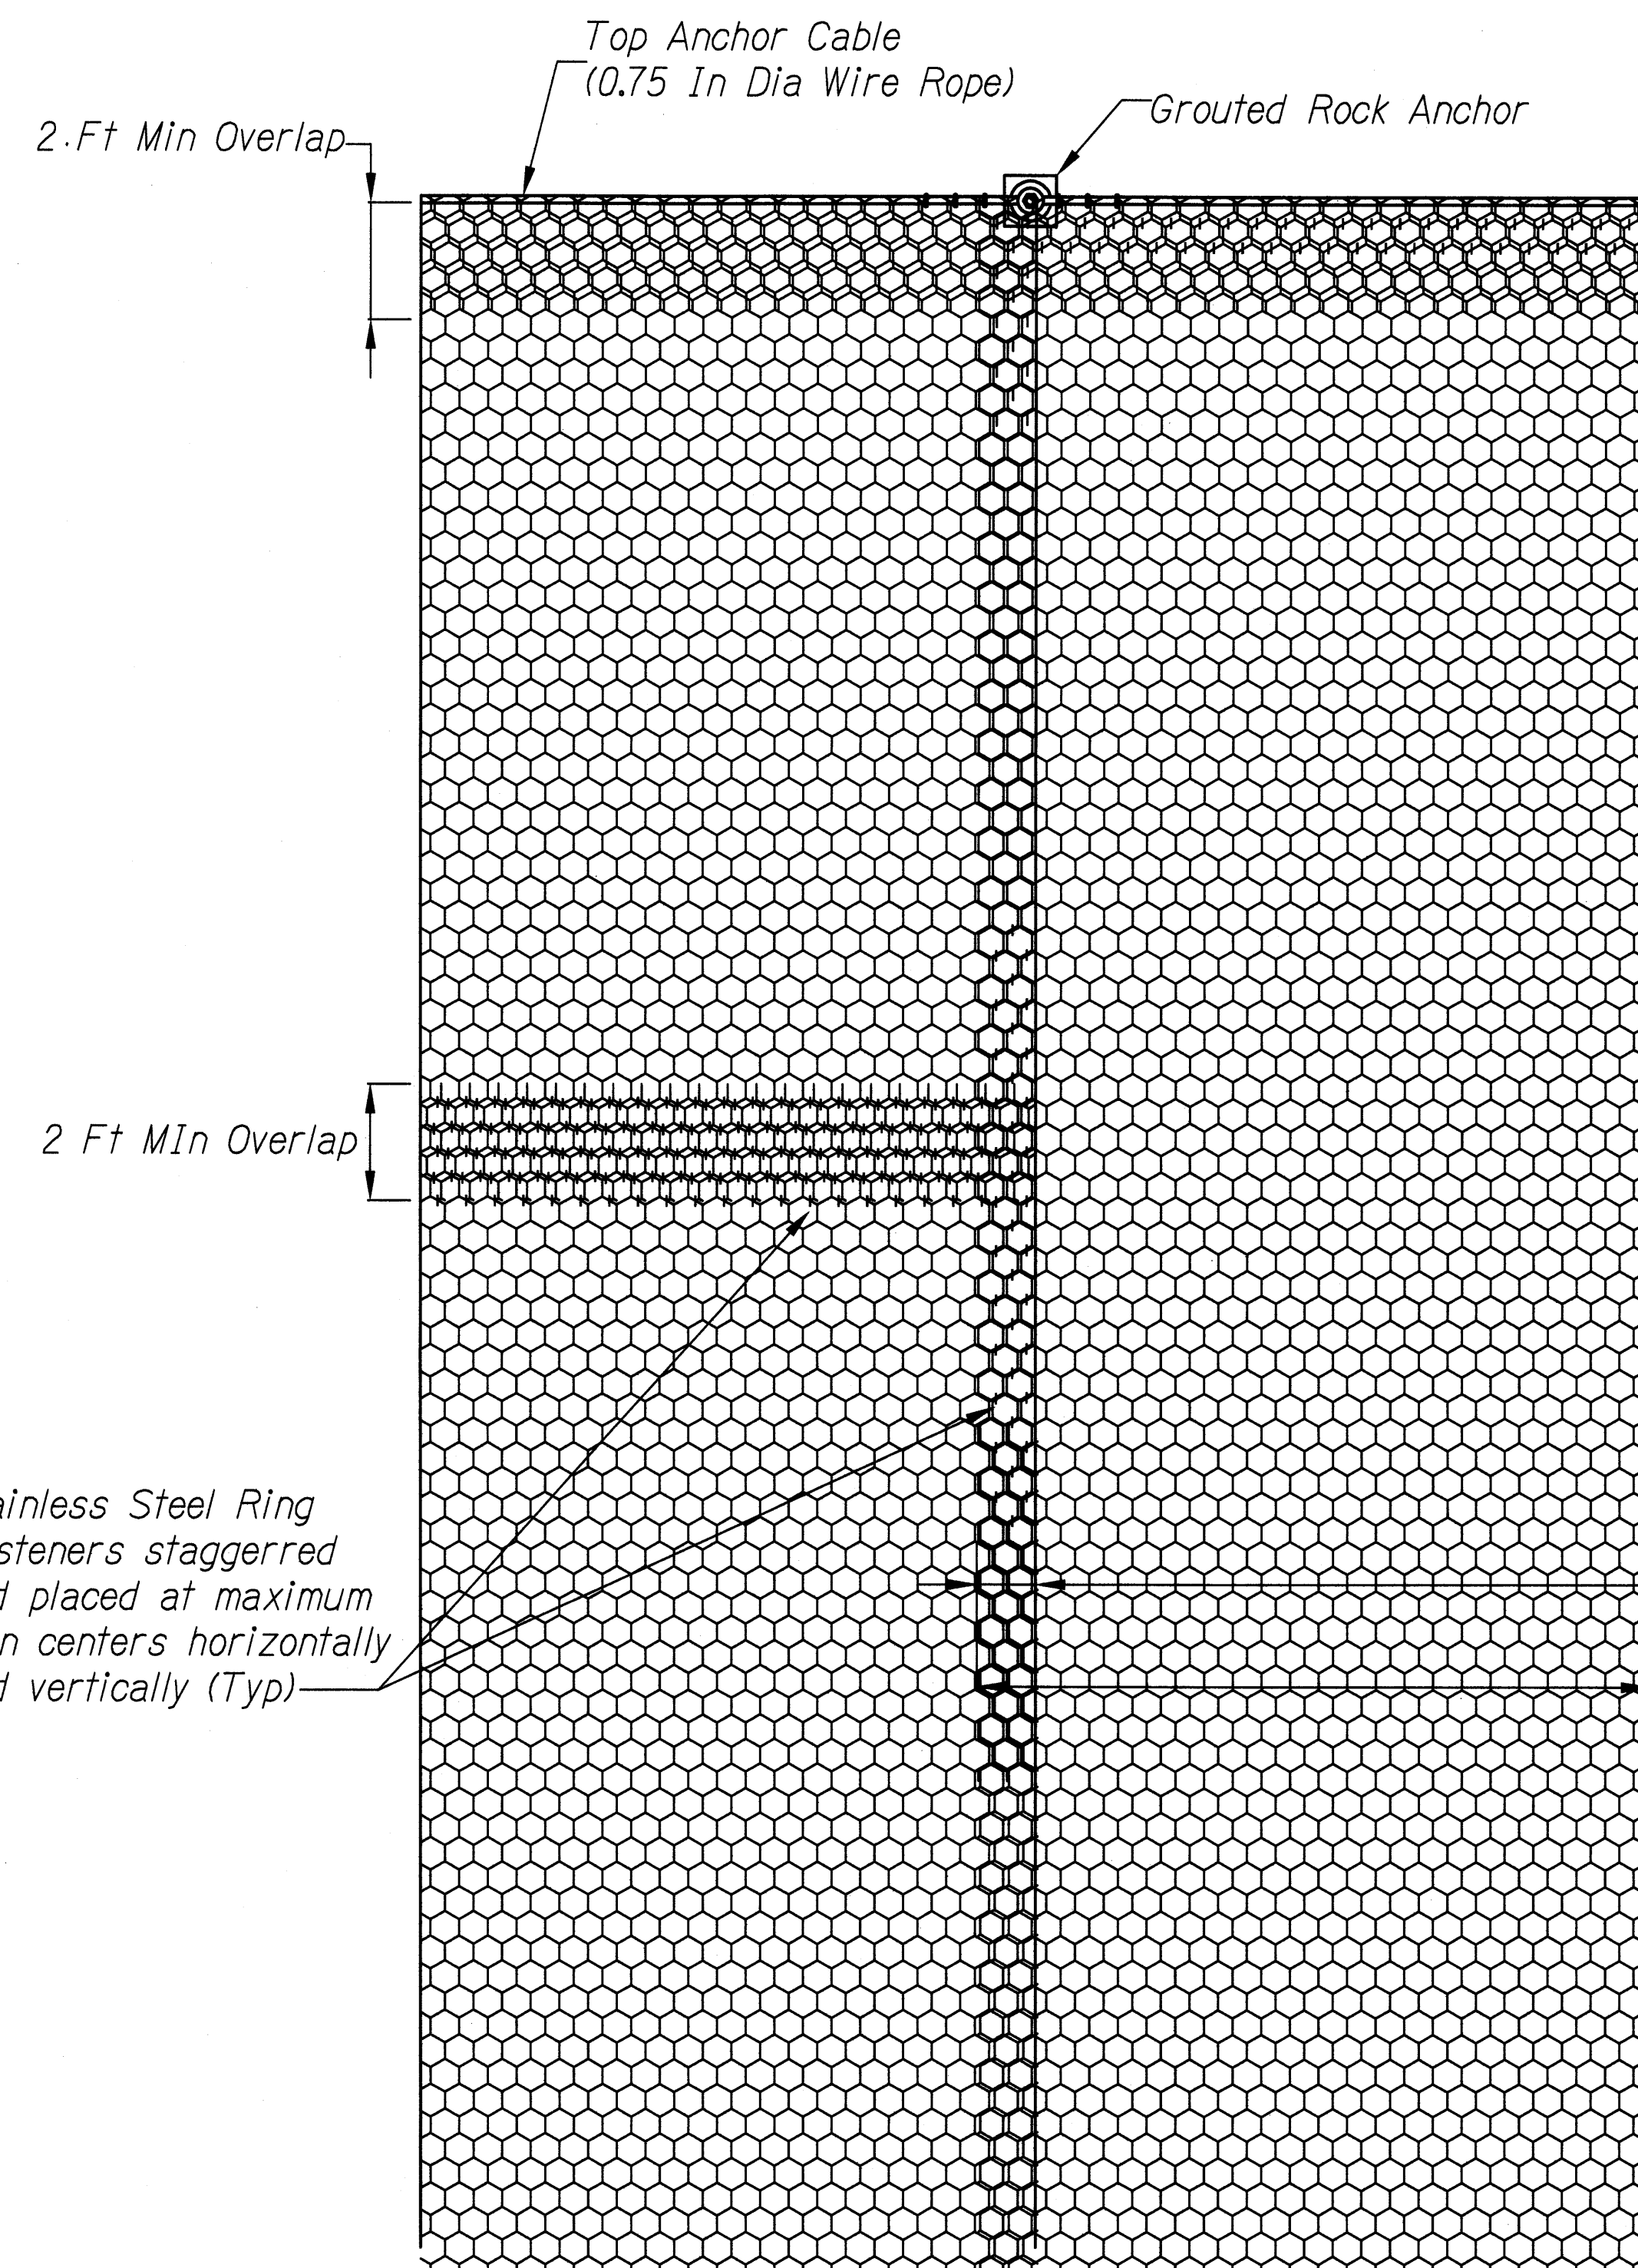


WIRE MESH OVERLAP
Not To Scale

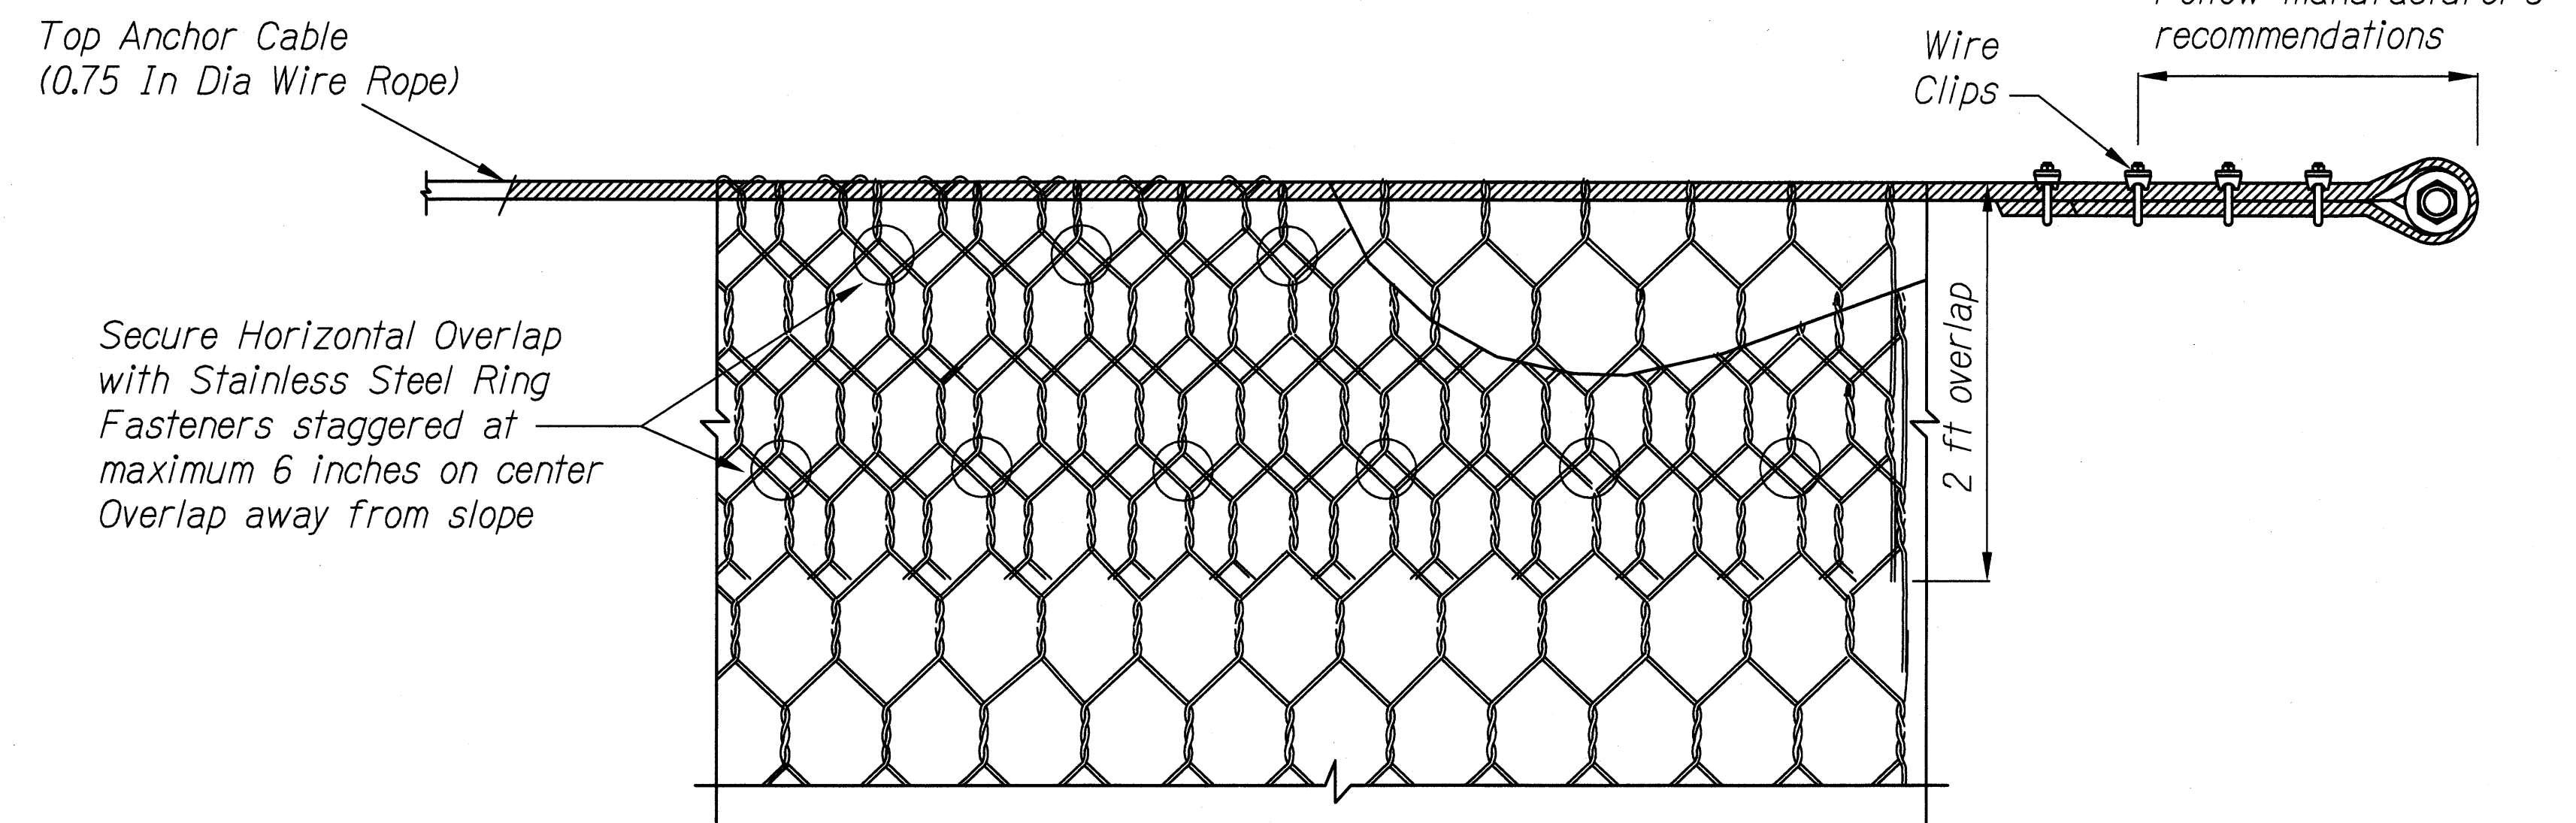

**TOP ANCHOR CABLE DETAIL
AND HORIZONTAL TOP OVERLAP**
Not To Scale

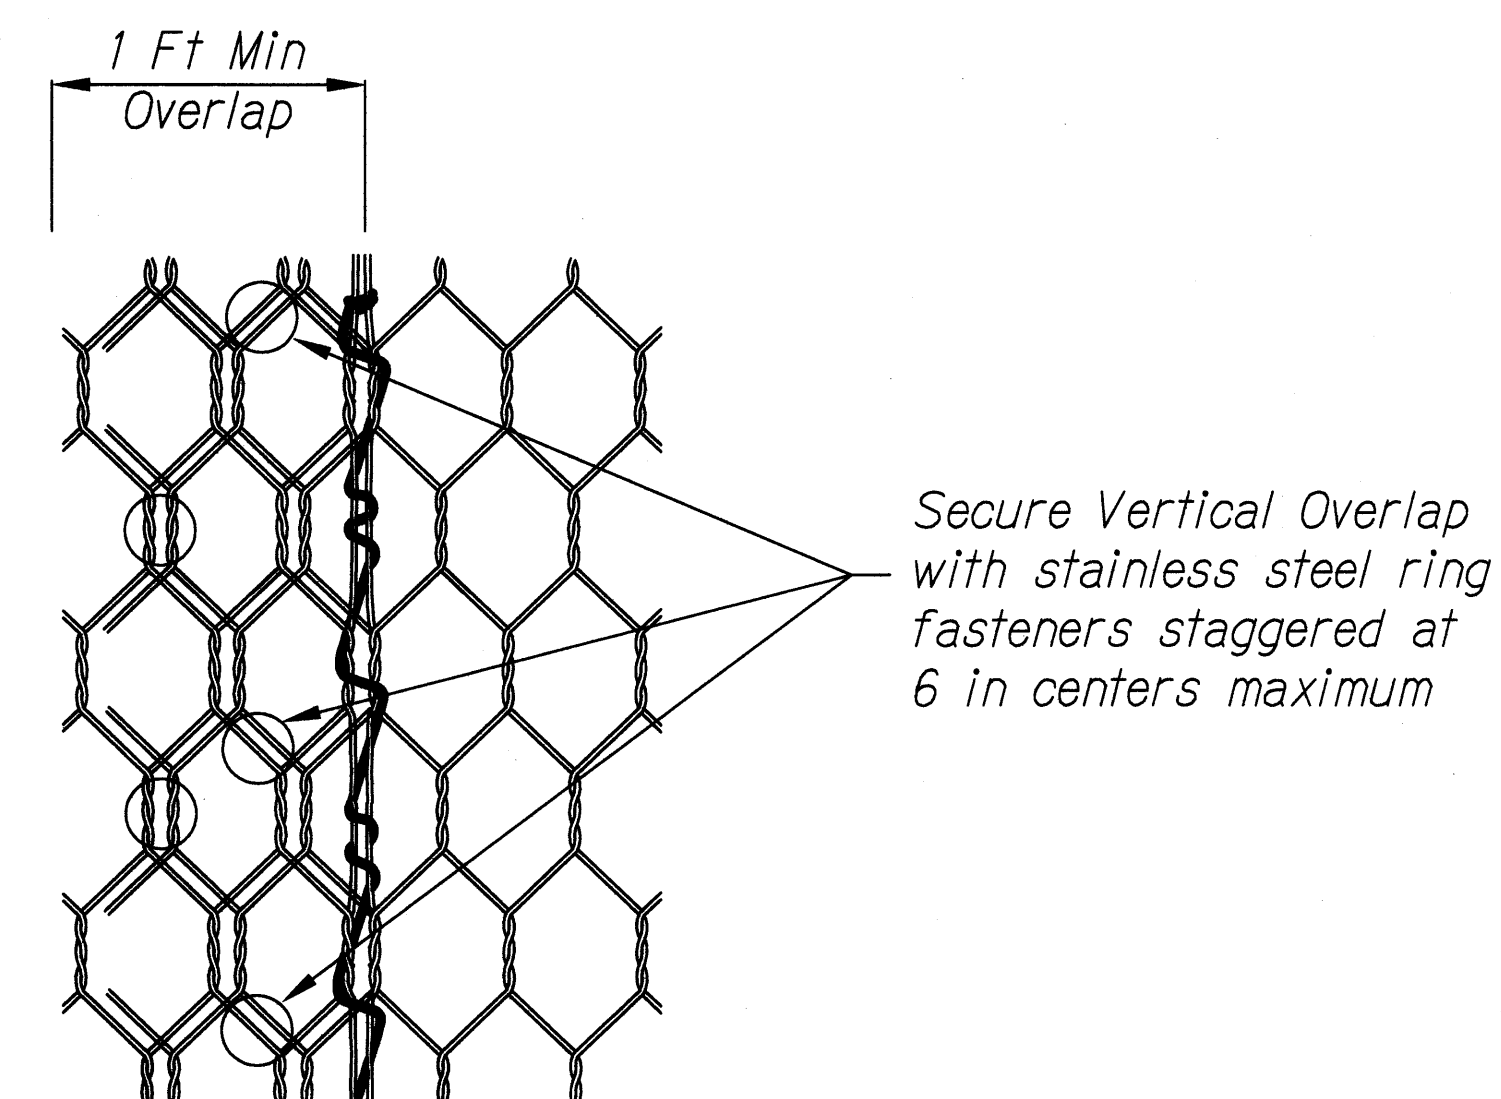

**TYPICAL OVERLAP DETAIL
AT VERTICAL SEAMS**
Not To Scale




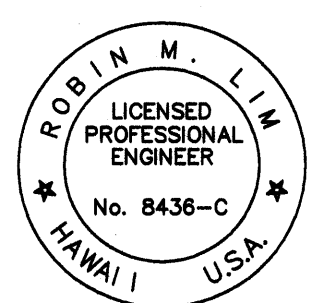


This work was prepared by me
or under my supervision.
Exp. 04-30-10
Robin M. Lim
Geolabs, Inc.

STATE OF HAWAII
DEPARTMENT OF TRANSPORTATION
HIGHWAYS DIVISION
DRAPED WIRE MESH DETAILS - 2
EMERGENCY EARTHQUAKE ROCKFALL REPAIRS
VARIOUS LOCATIONS ON HAWAII, UNIT 4
Federal Aid Project No. ER-15(22)
Scale: As Shown Date: December 2009
SHEET No. G-0.4 OF 7 SHEETS


SURVEY PLOTTED BY	DATE
DRAWN BY	
DESIGNED BY	
QUANTITIES BY	
CHECKED BY	
ORIGINAL PLAN	
NOTE BOOK	
No.	

FED. ROAD DIST. NO.	STATE	FED. AID PROJECT NO.	FISCAL YEAR	SHEET NO.	TOTAL SHEETS
HAWAII	HAW.	ER15-(22)	2009	11R	88

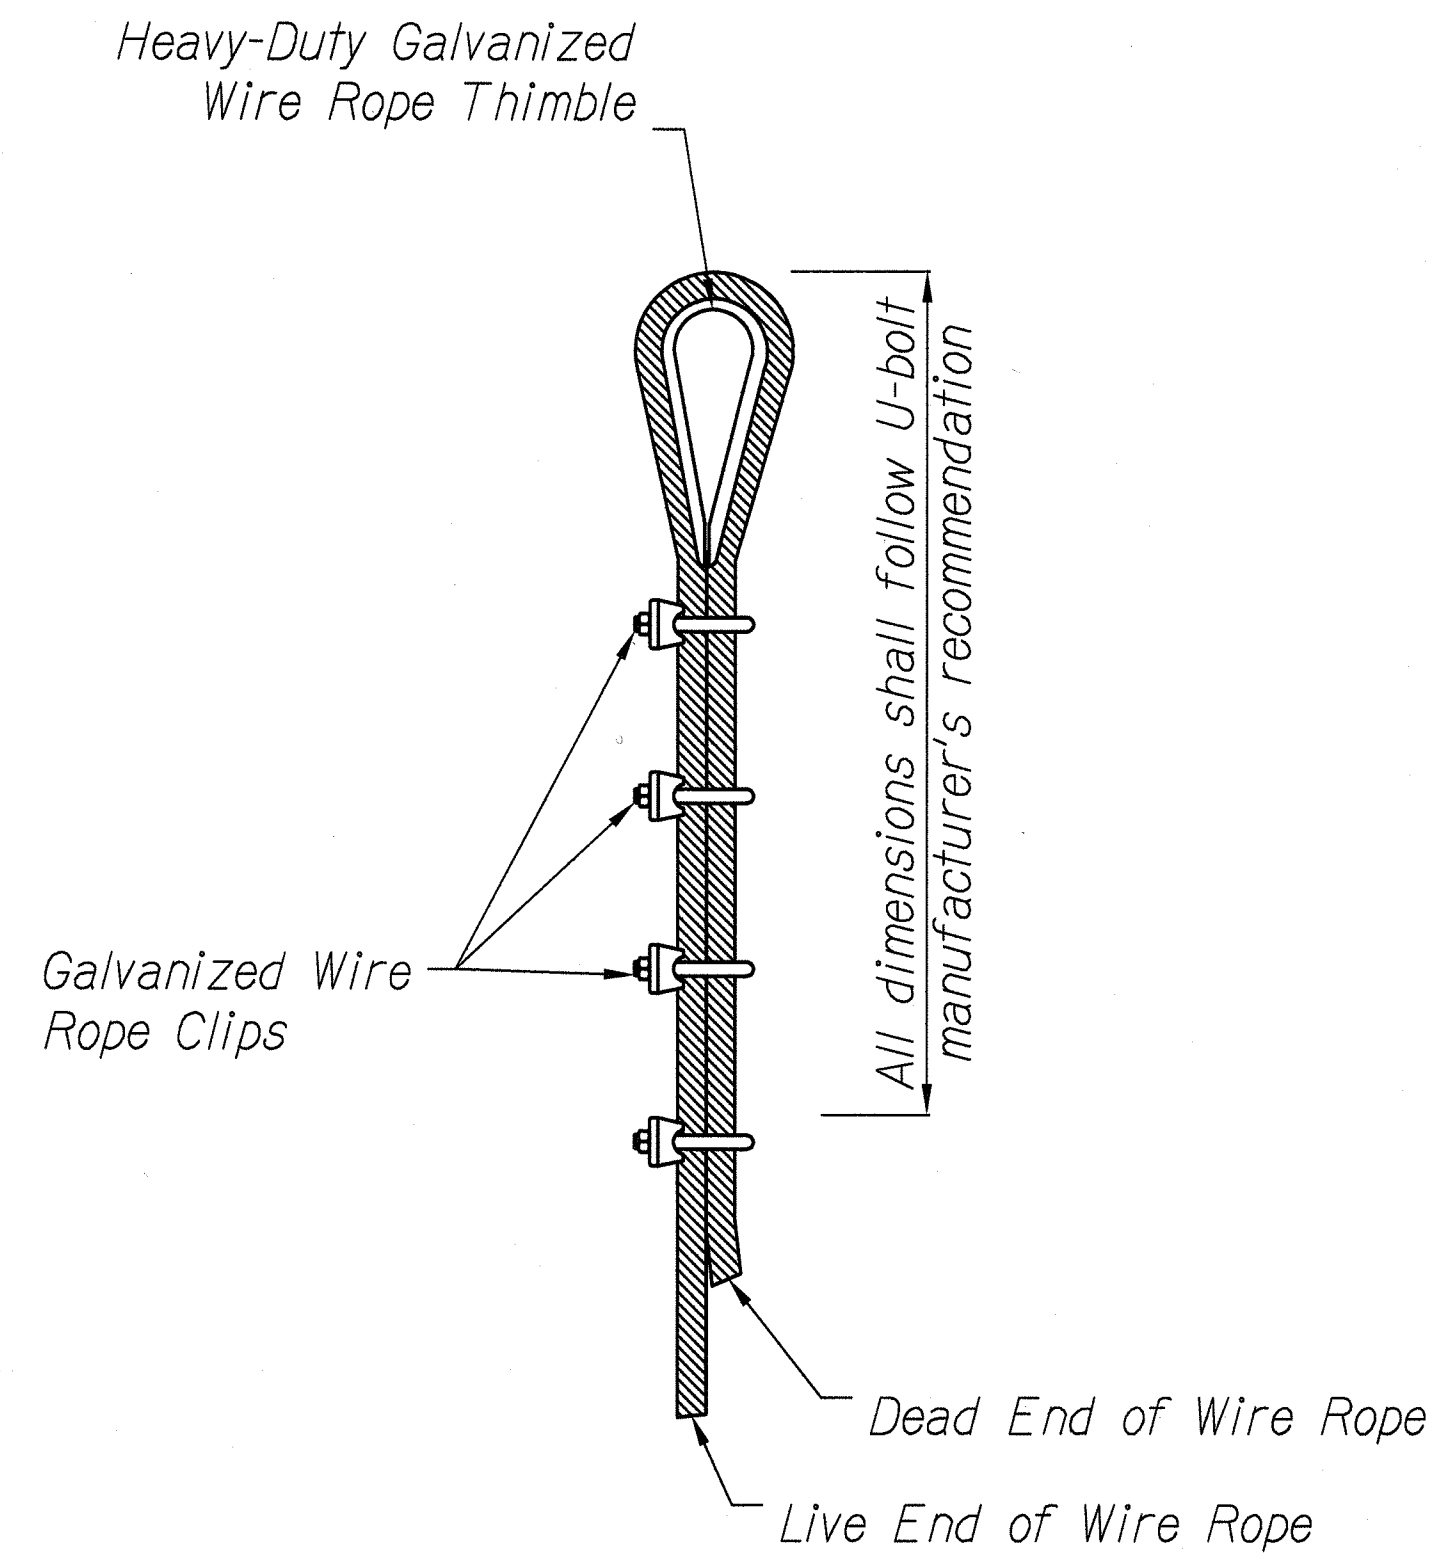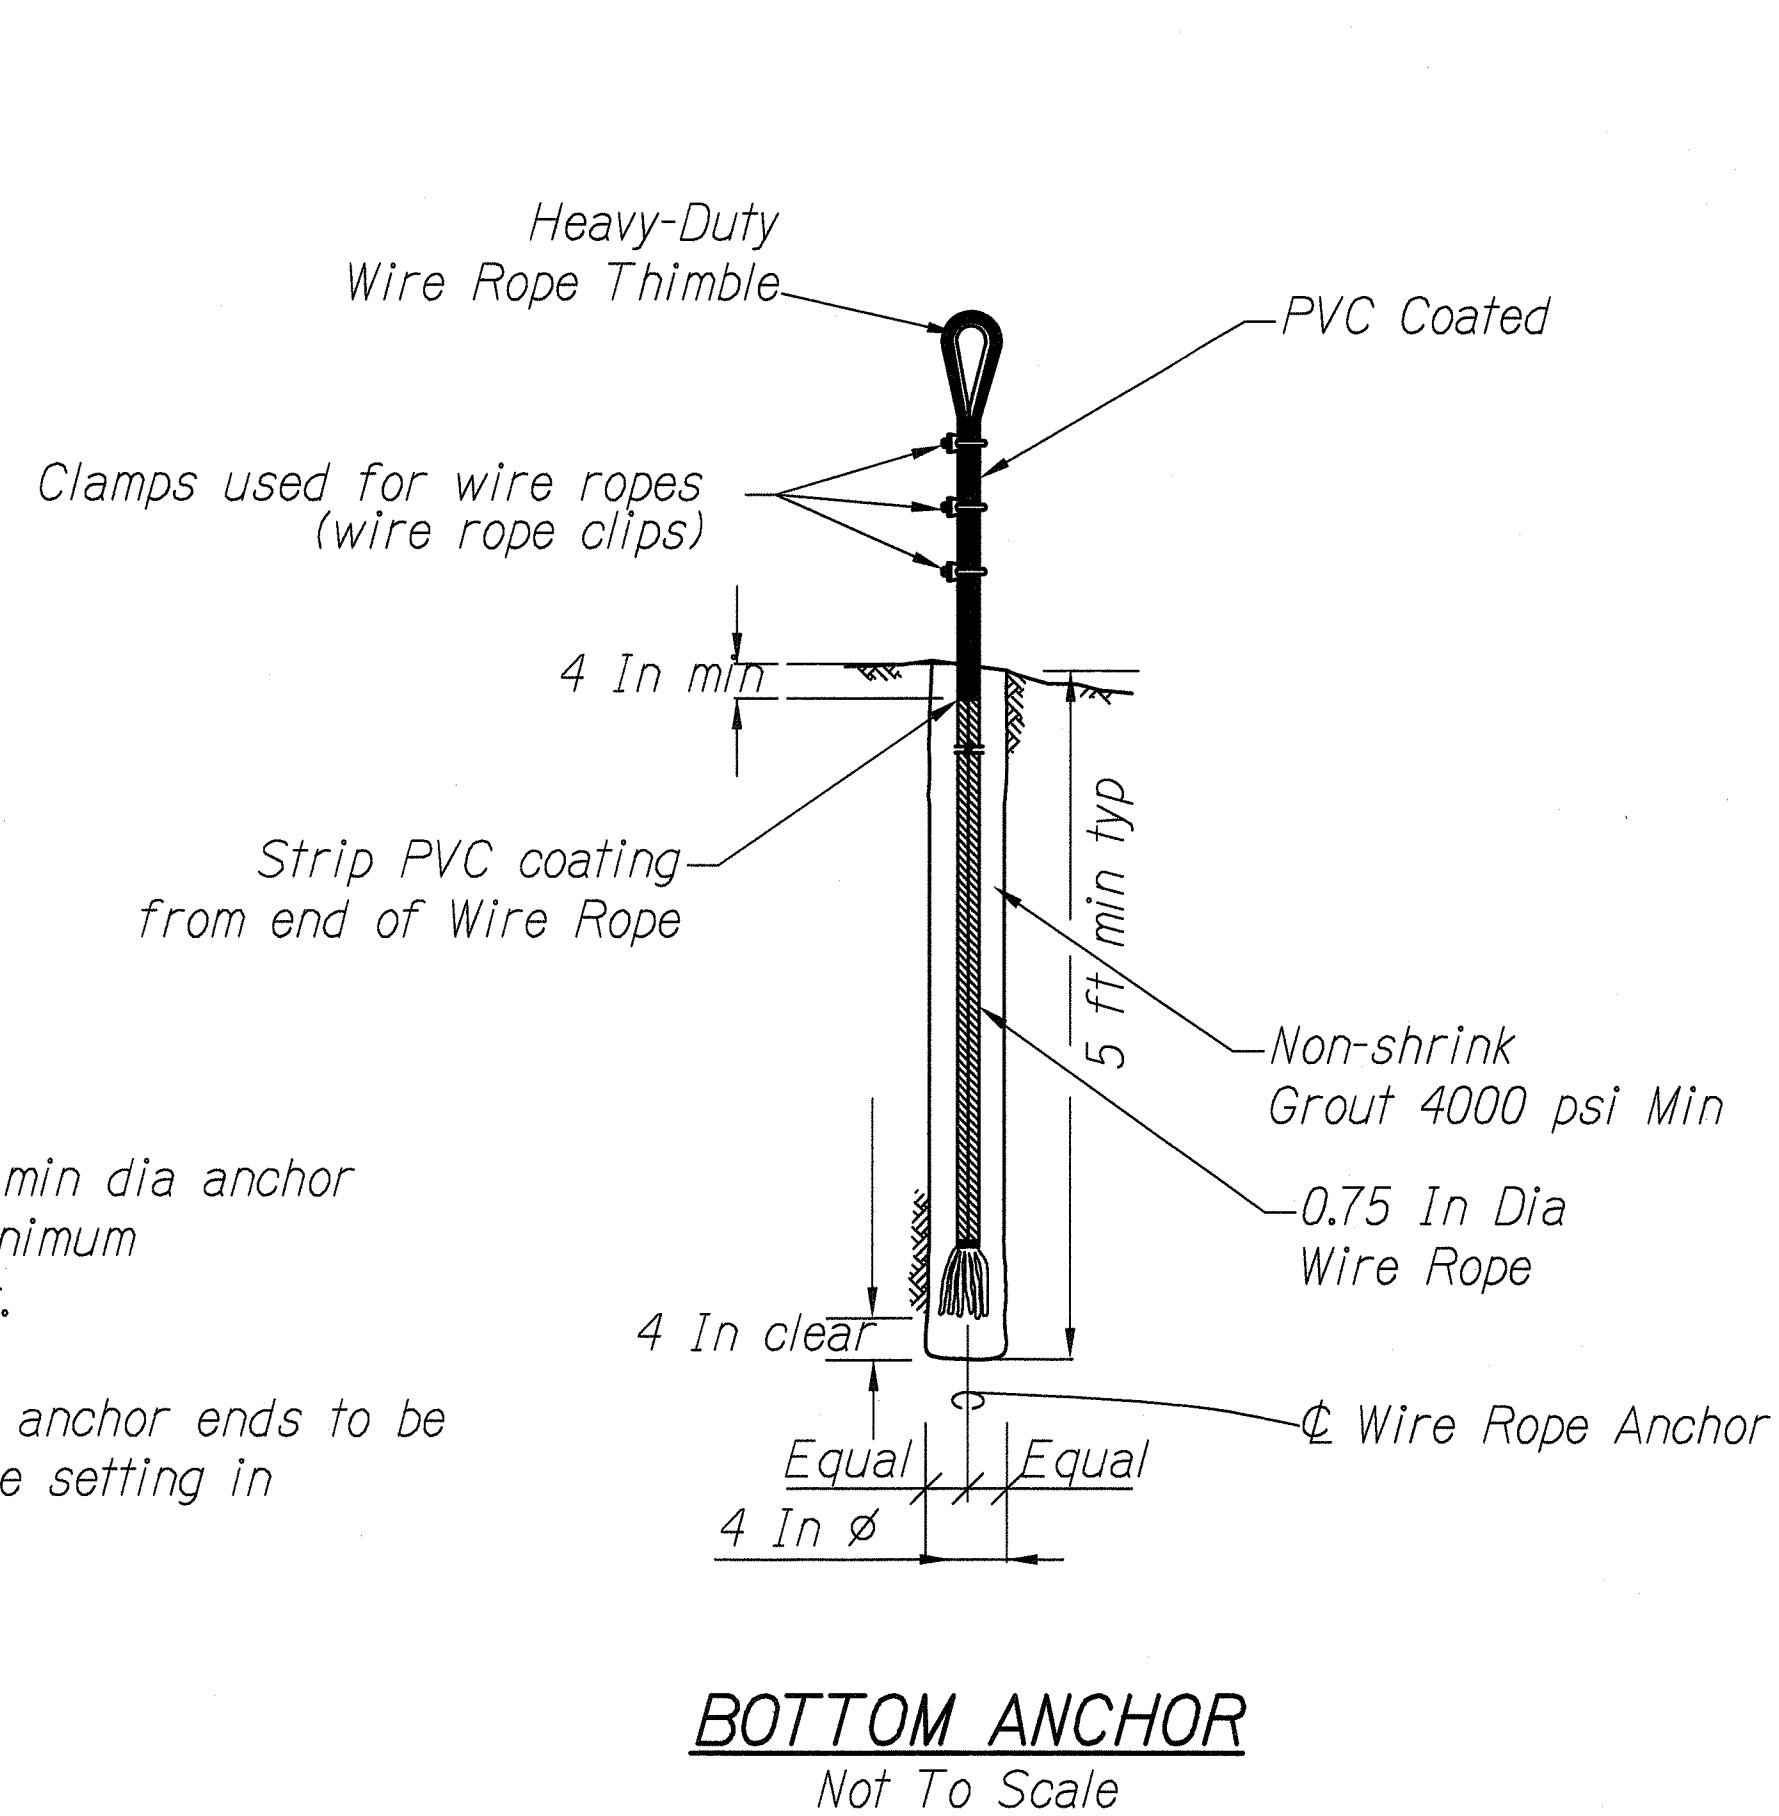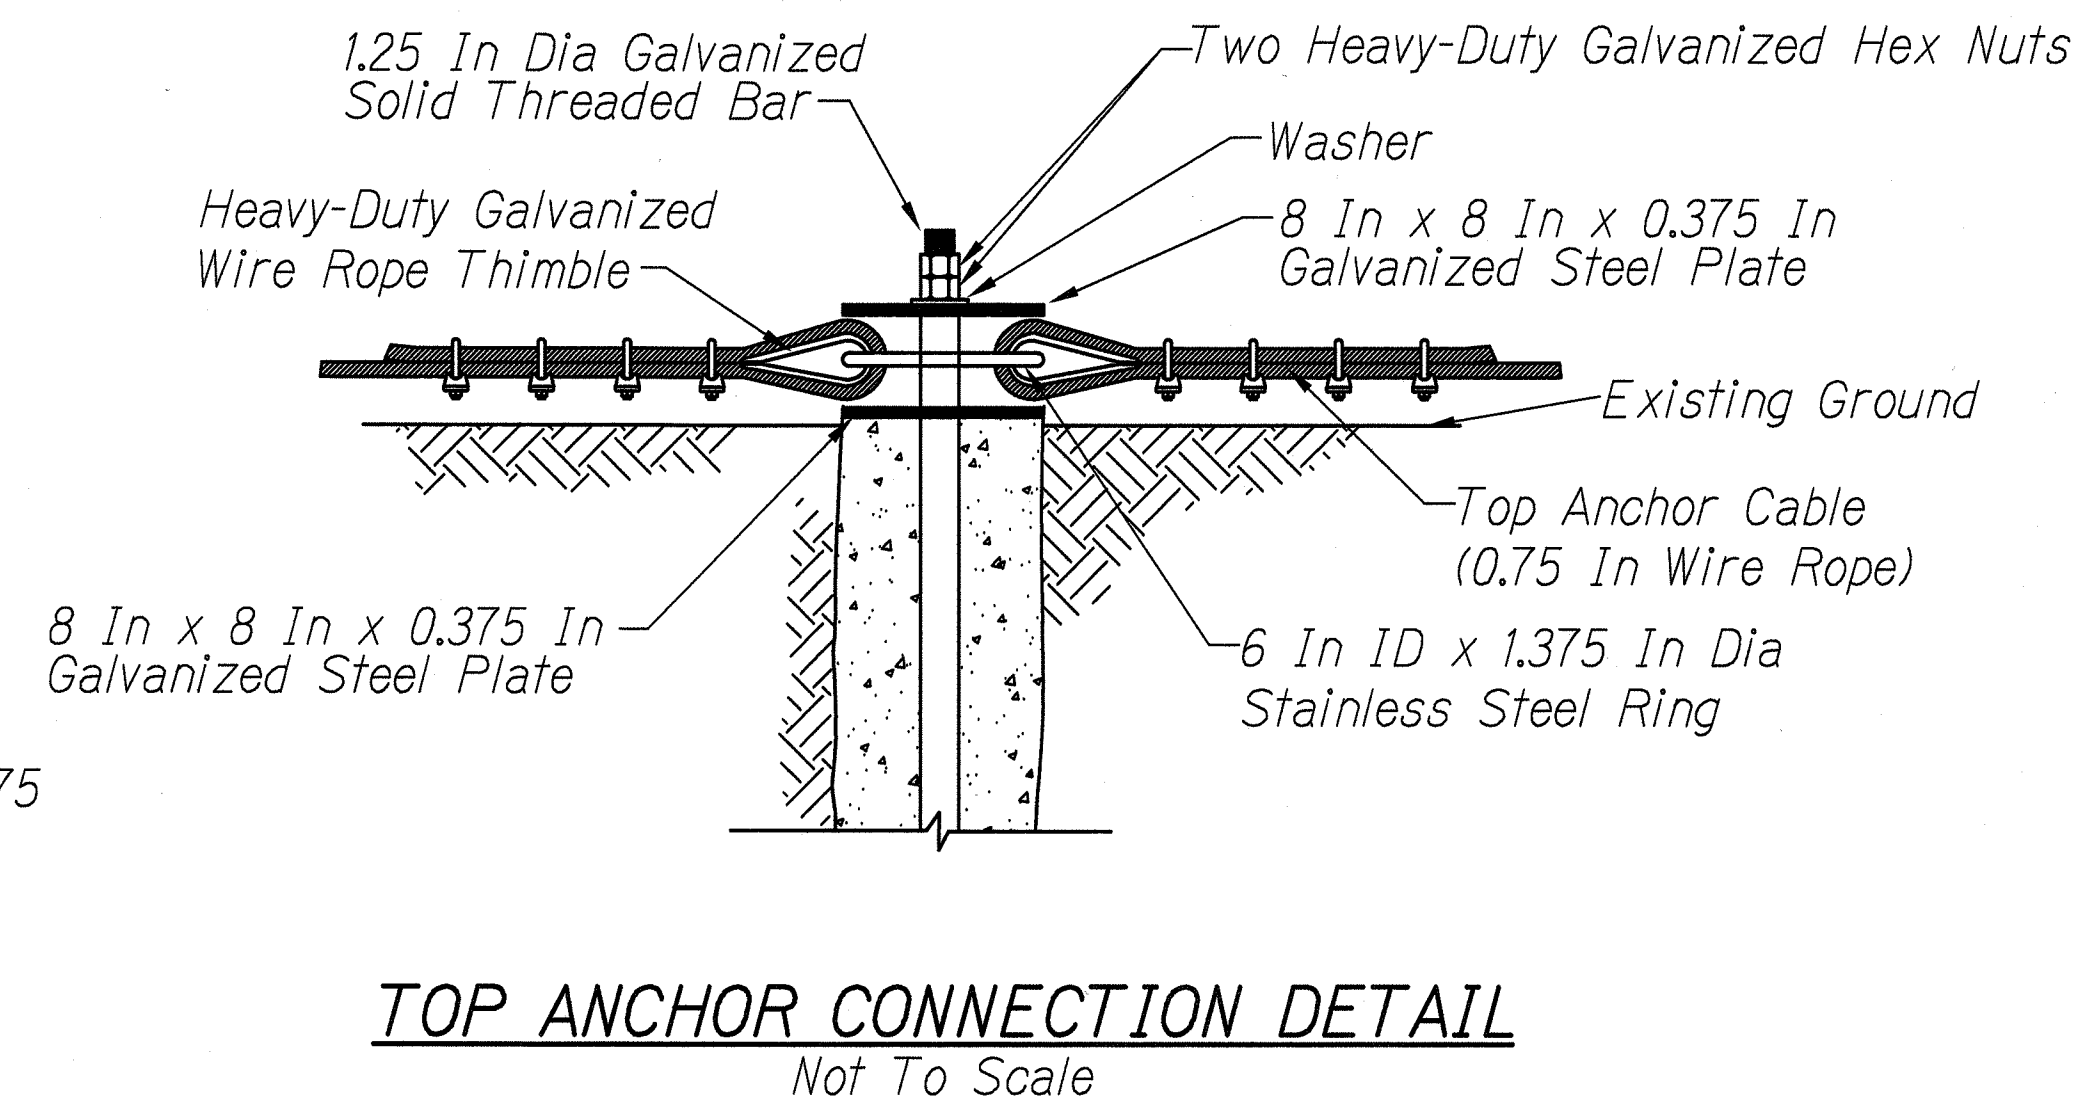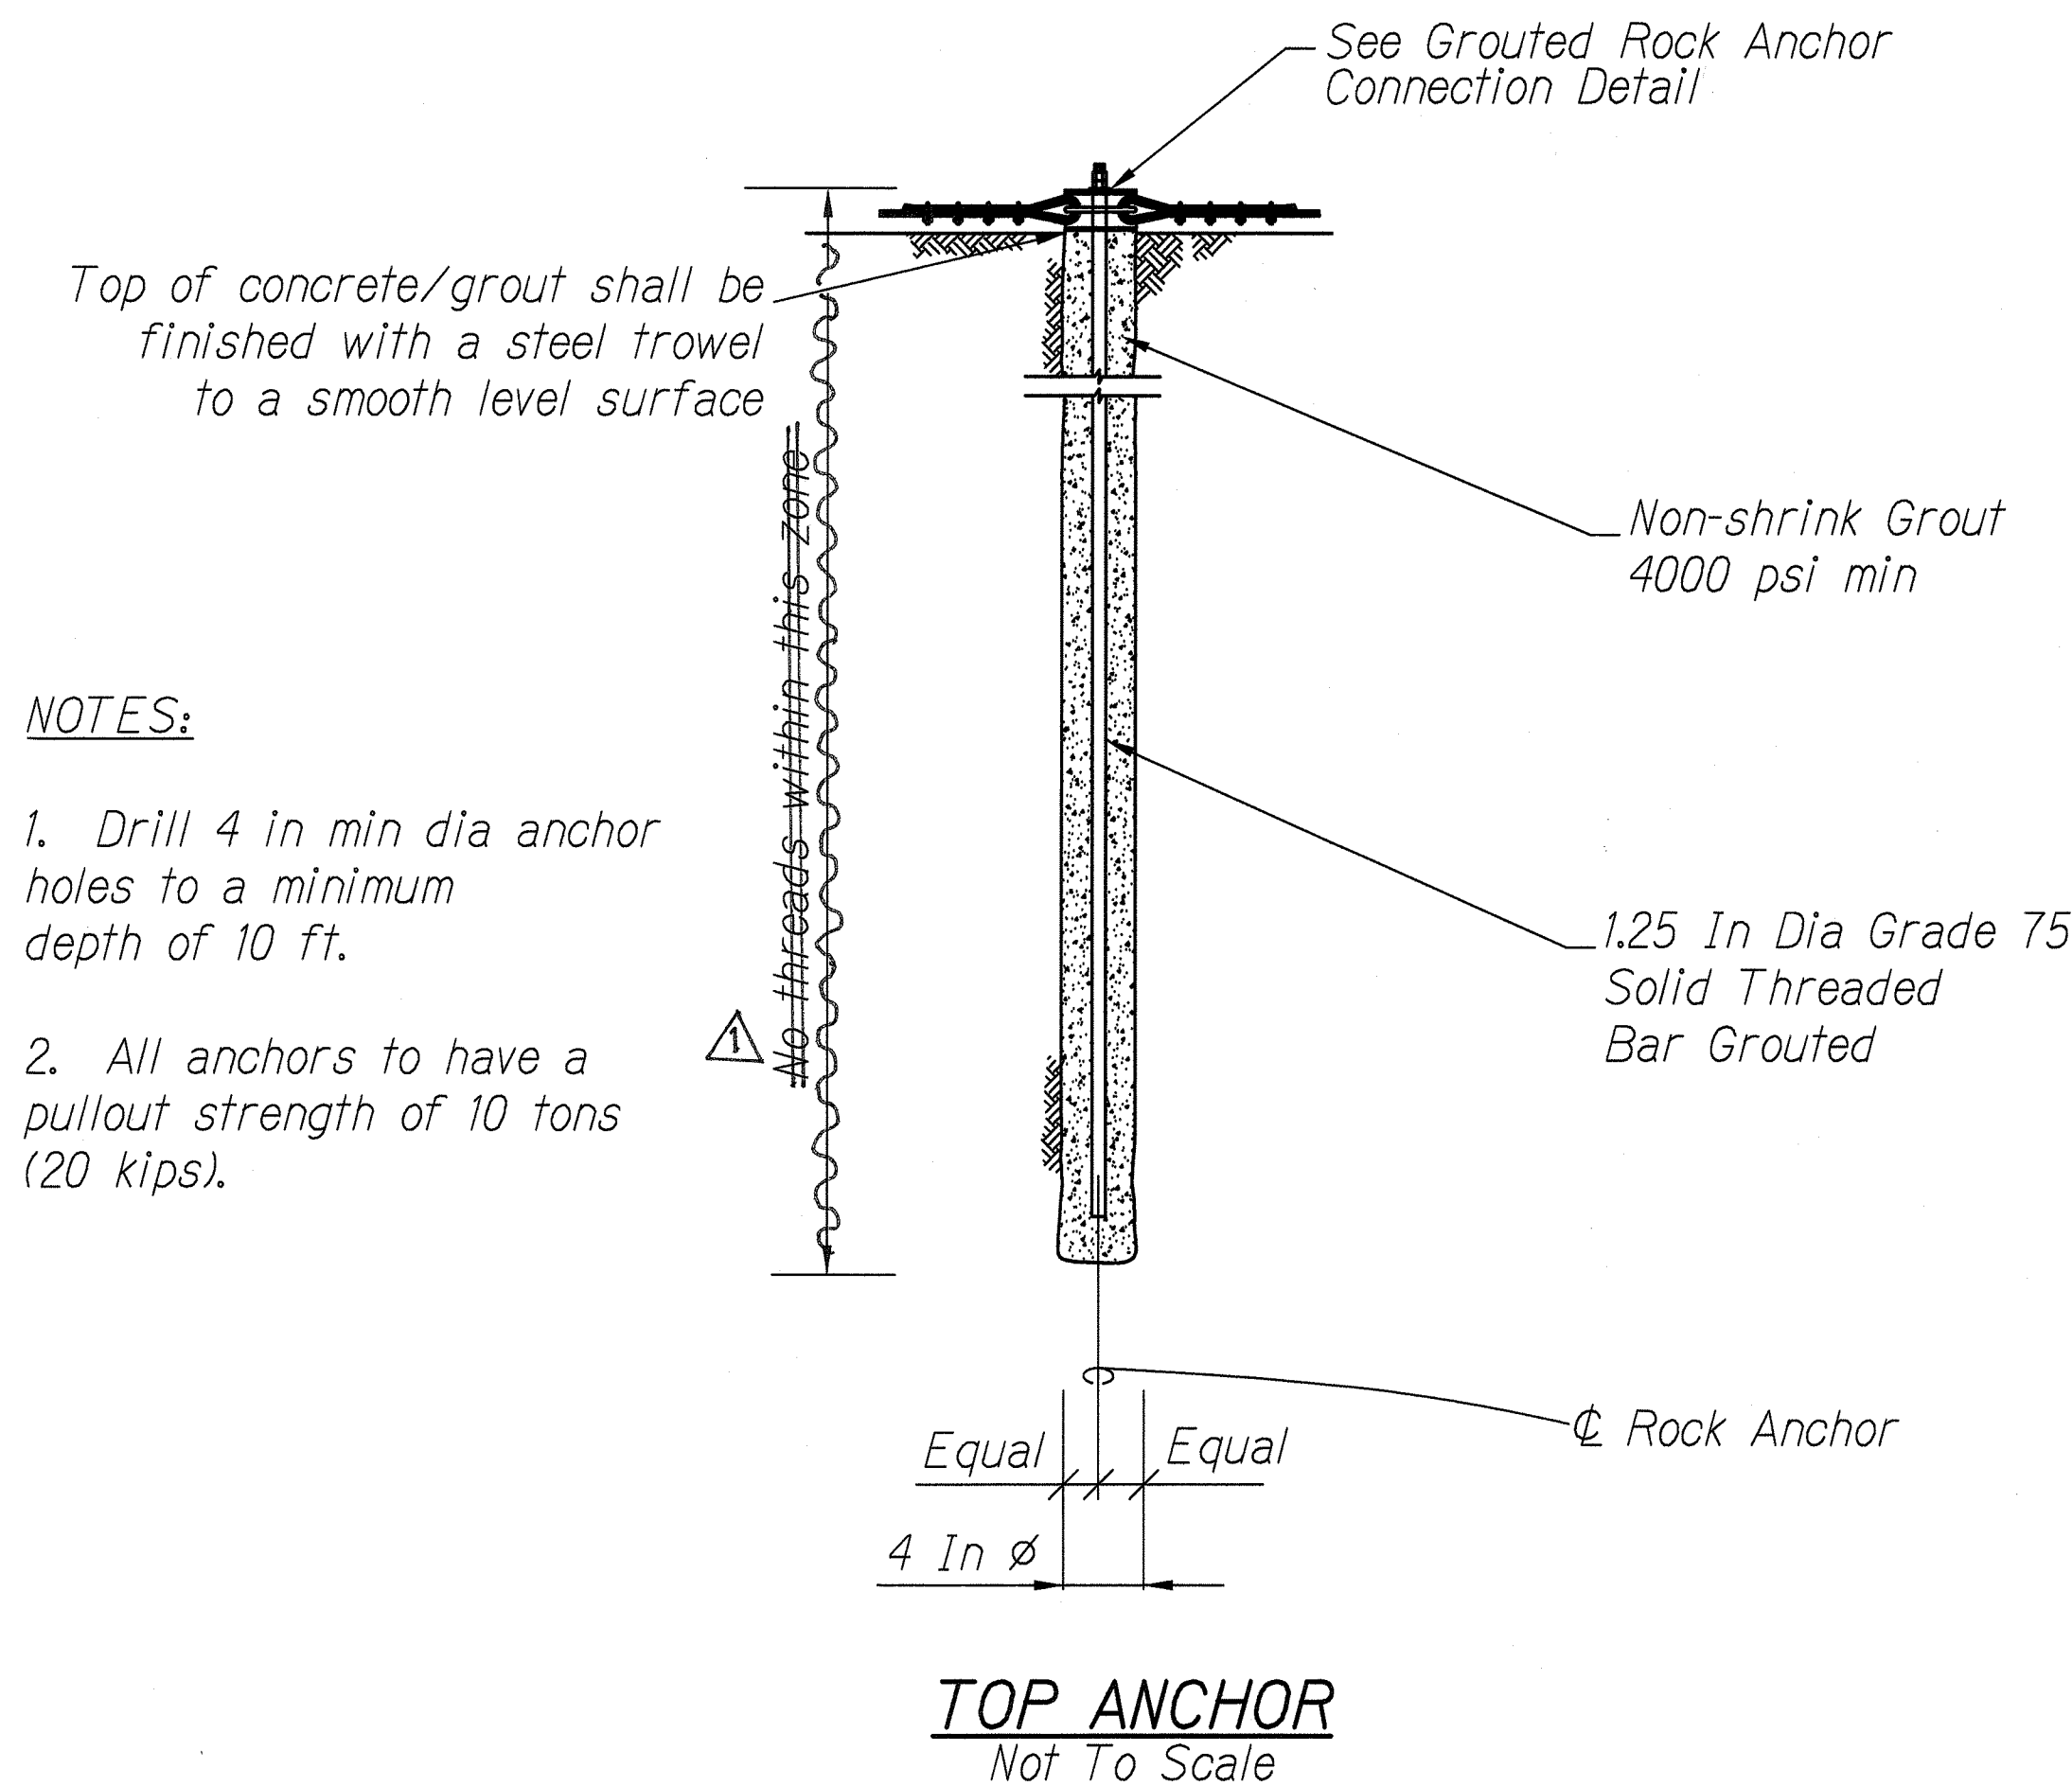

NOTES:

1. Drill 4 in min dia anchor holes to a minimum depth of 5 ft.
2. Wire rope anchor ends to be splayed before setting in concrete.

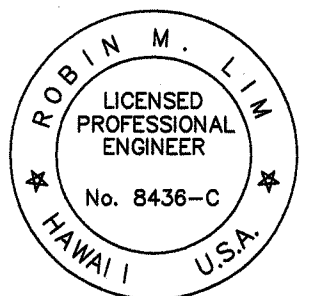

This work was prepared by me or under my supervision.
Exp. 04-30-10
Robin M. Lim
Geolabs, Inc.

STATE OF HAWAII
DEPARTMENT OF TRANSPORTATION
HIGHWAYS DIVISION

DRAPED WIRE MESH DETAILS - 3

EMERGENCY EARTHQUAKE ROCKFALL REPAIRS
VARIOUS LOCATIONS ON HAWAII, UNIT 4

Federal Aid Project No. ER-15(22)

Scale: As Shown Date: December 2009

SHEET No. G-0.5 OF 7 SHEETS

07/28/10	Deleted vertical note on TOP ANCHOR detail per Addendum 1
DATE	REVISION