



FED. ROAD DIST. NO.	STATE	FED. AID PROJ. NO.	FISCAL YEAR	SHEET NO.	TOTAL SHEETS
HAWAII	HAW.	ER-15(22)	2009	20	88

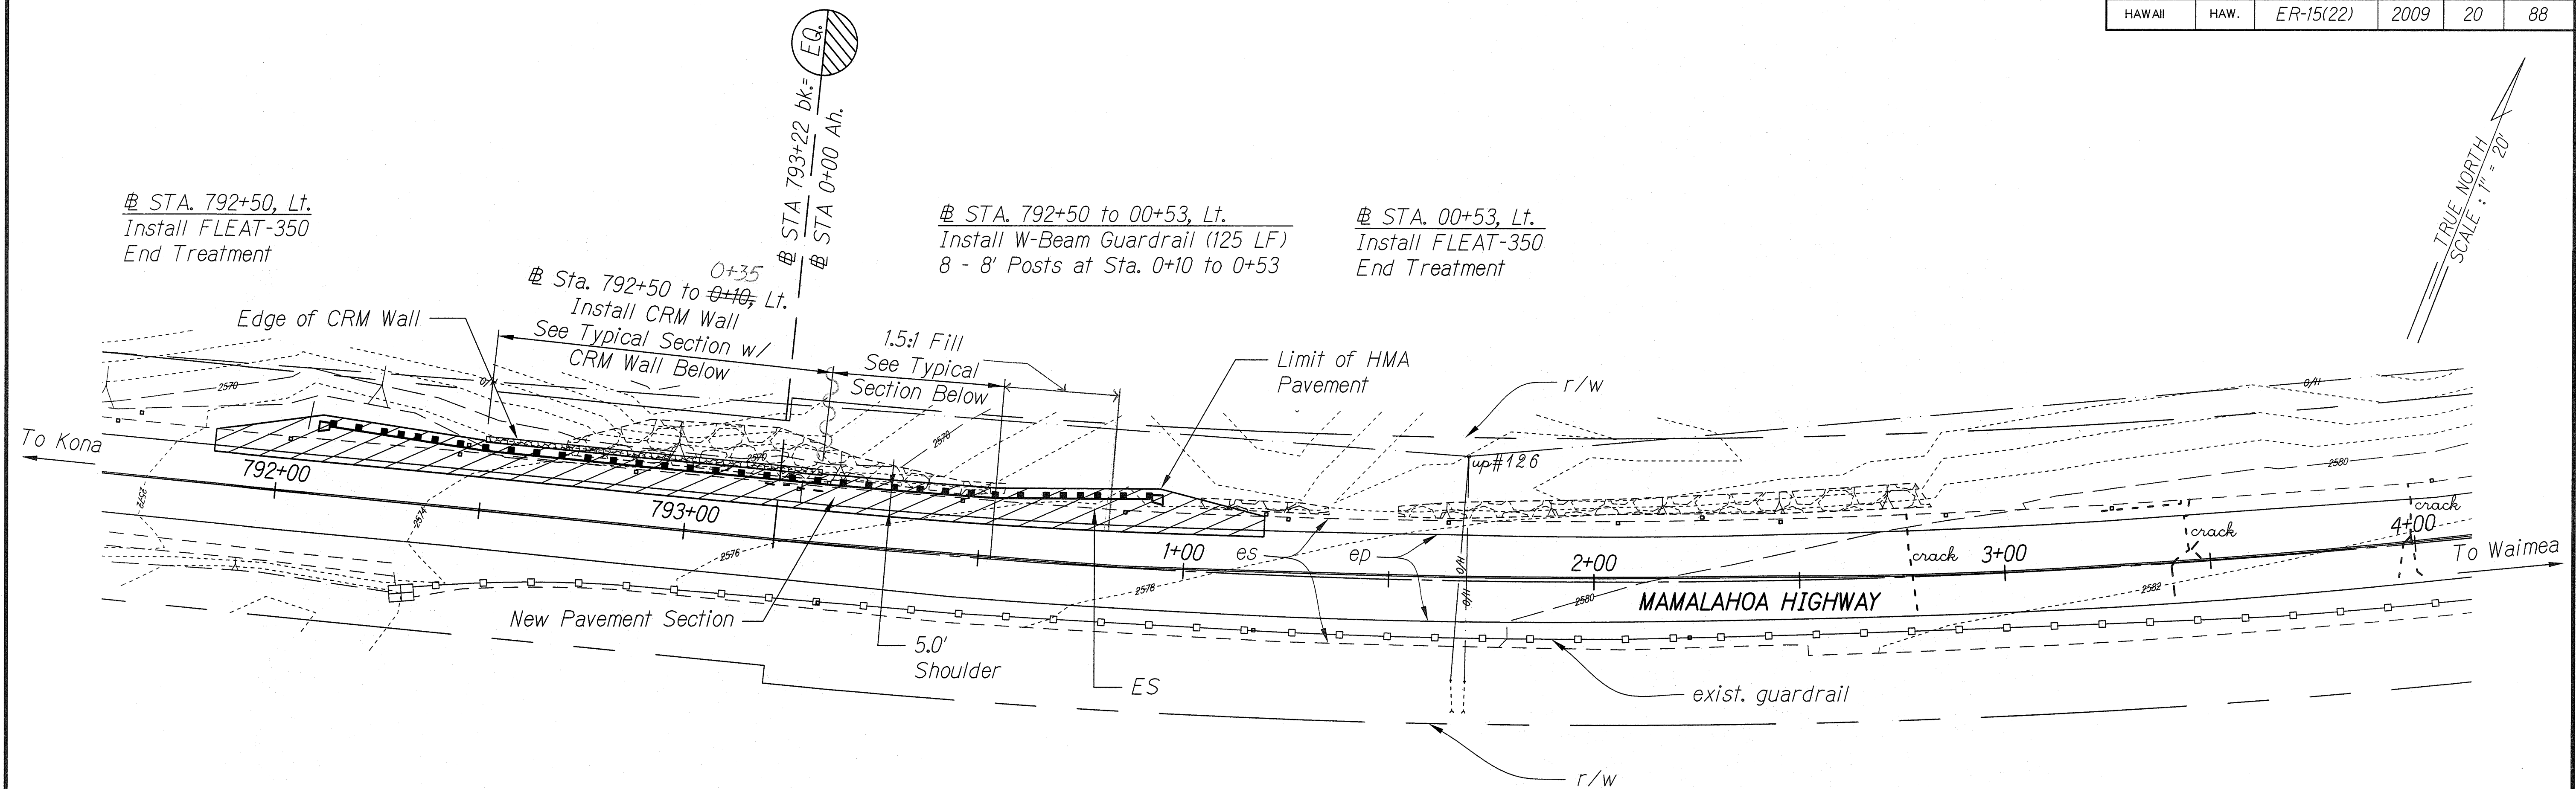


PLAN - MP 13.4
Scale: 1"=20'

NOTE:

Seal All Existing Cracks in Pavement Labeled "crack", Except Where Pavement is Noted to be Reconstructed.

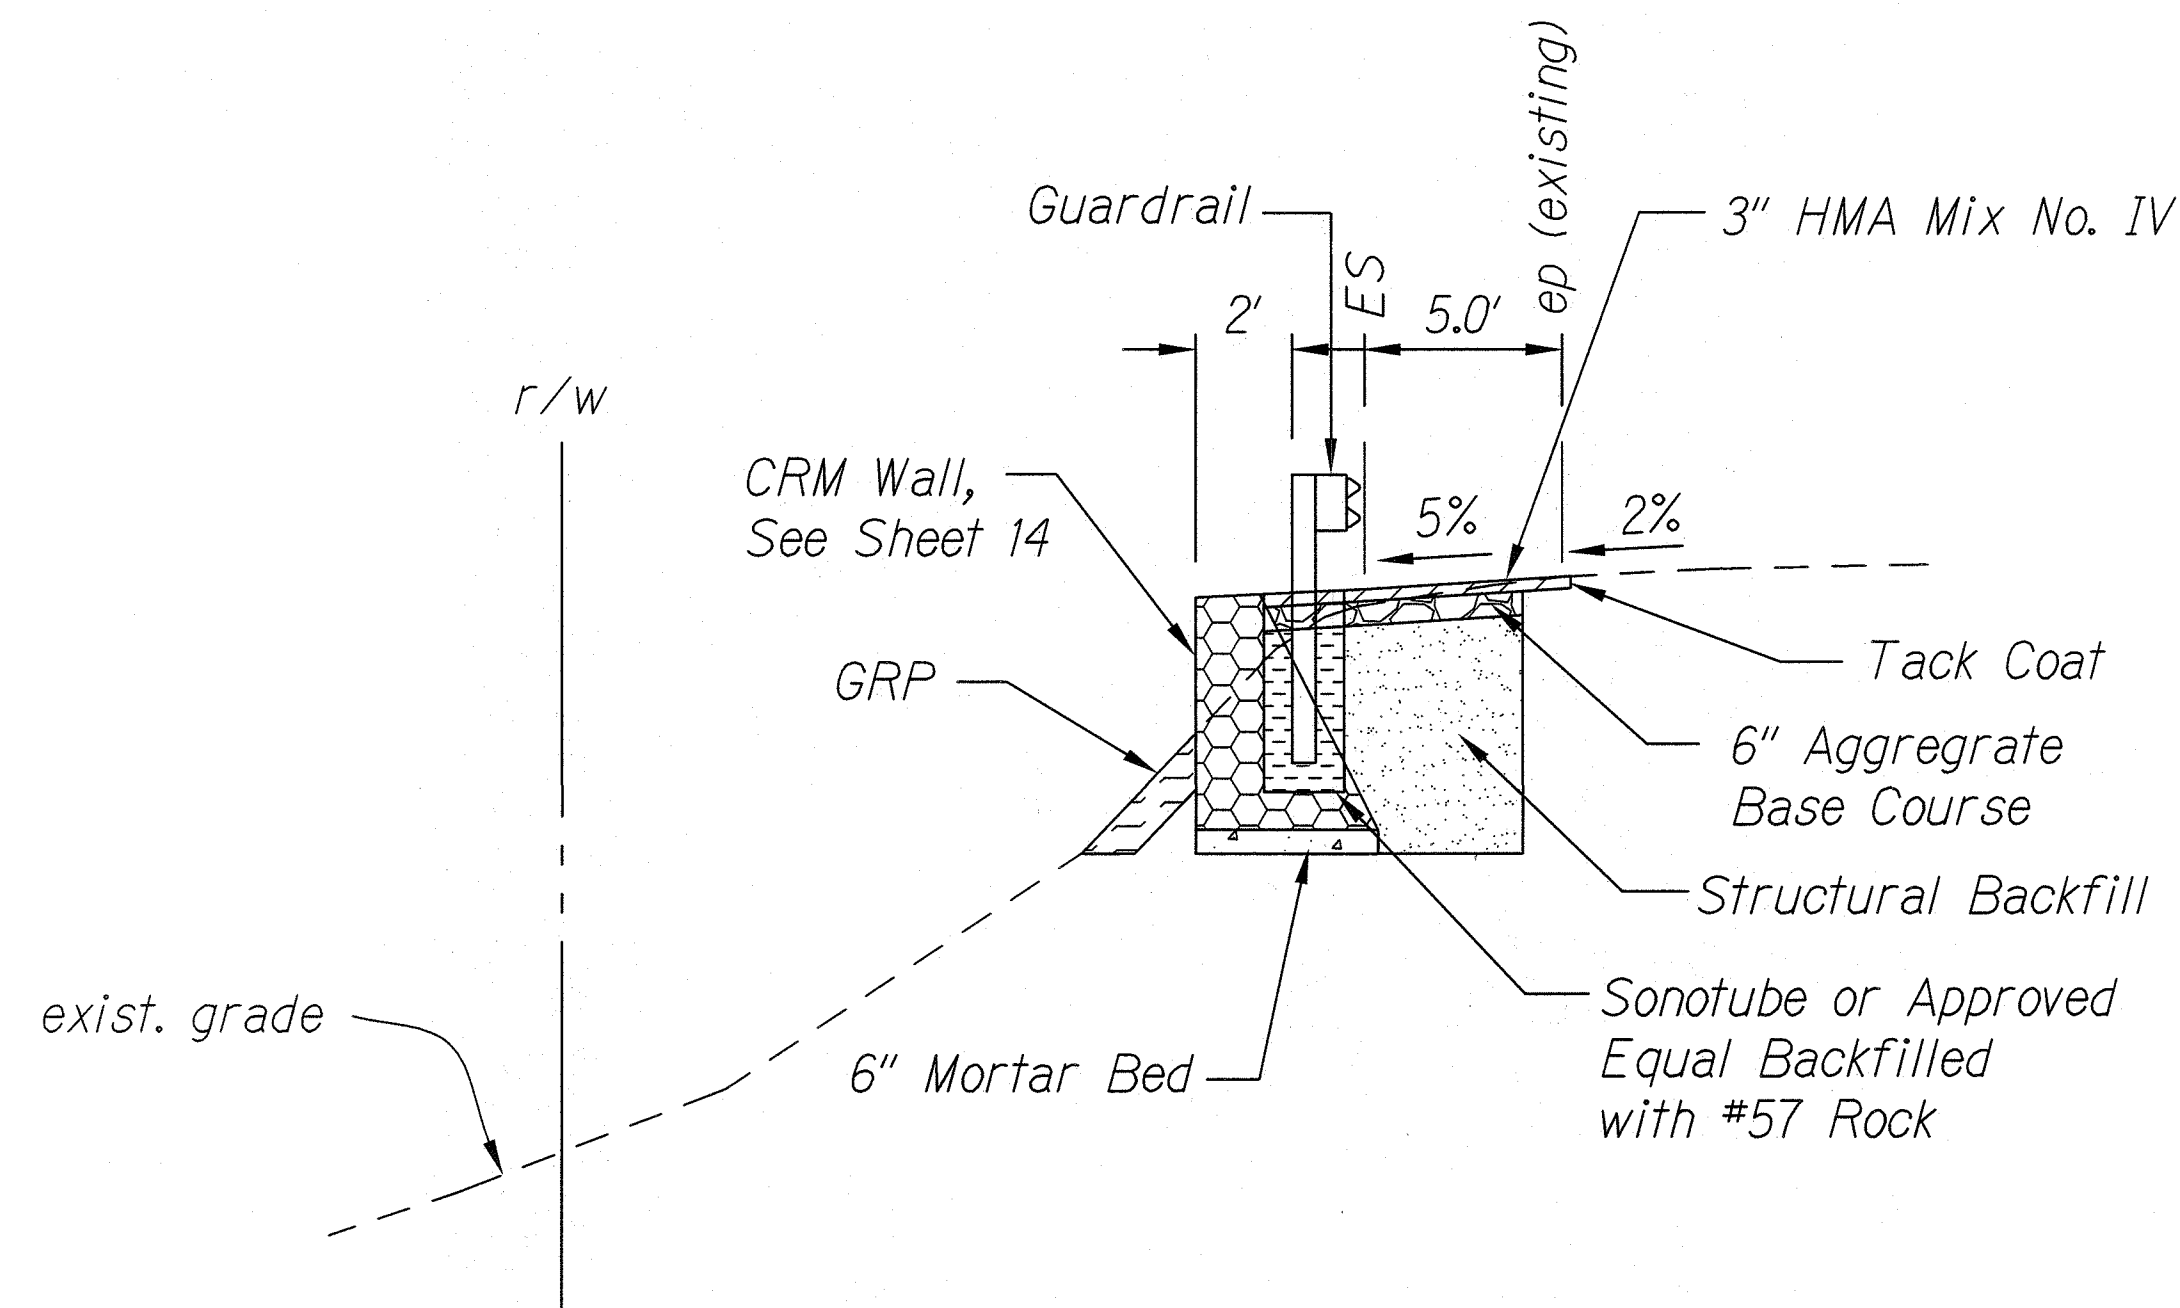


TYPICAL SECTION w/CRM WALL
Scale: Not to Scale

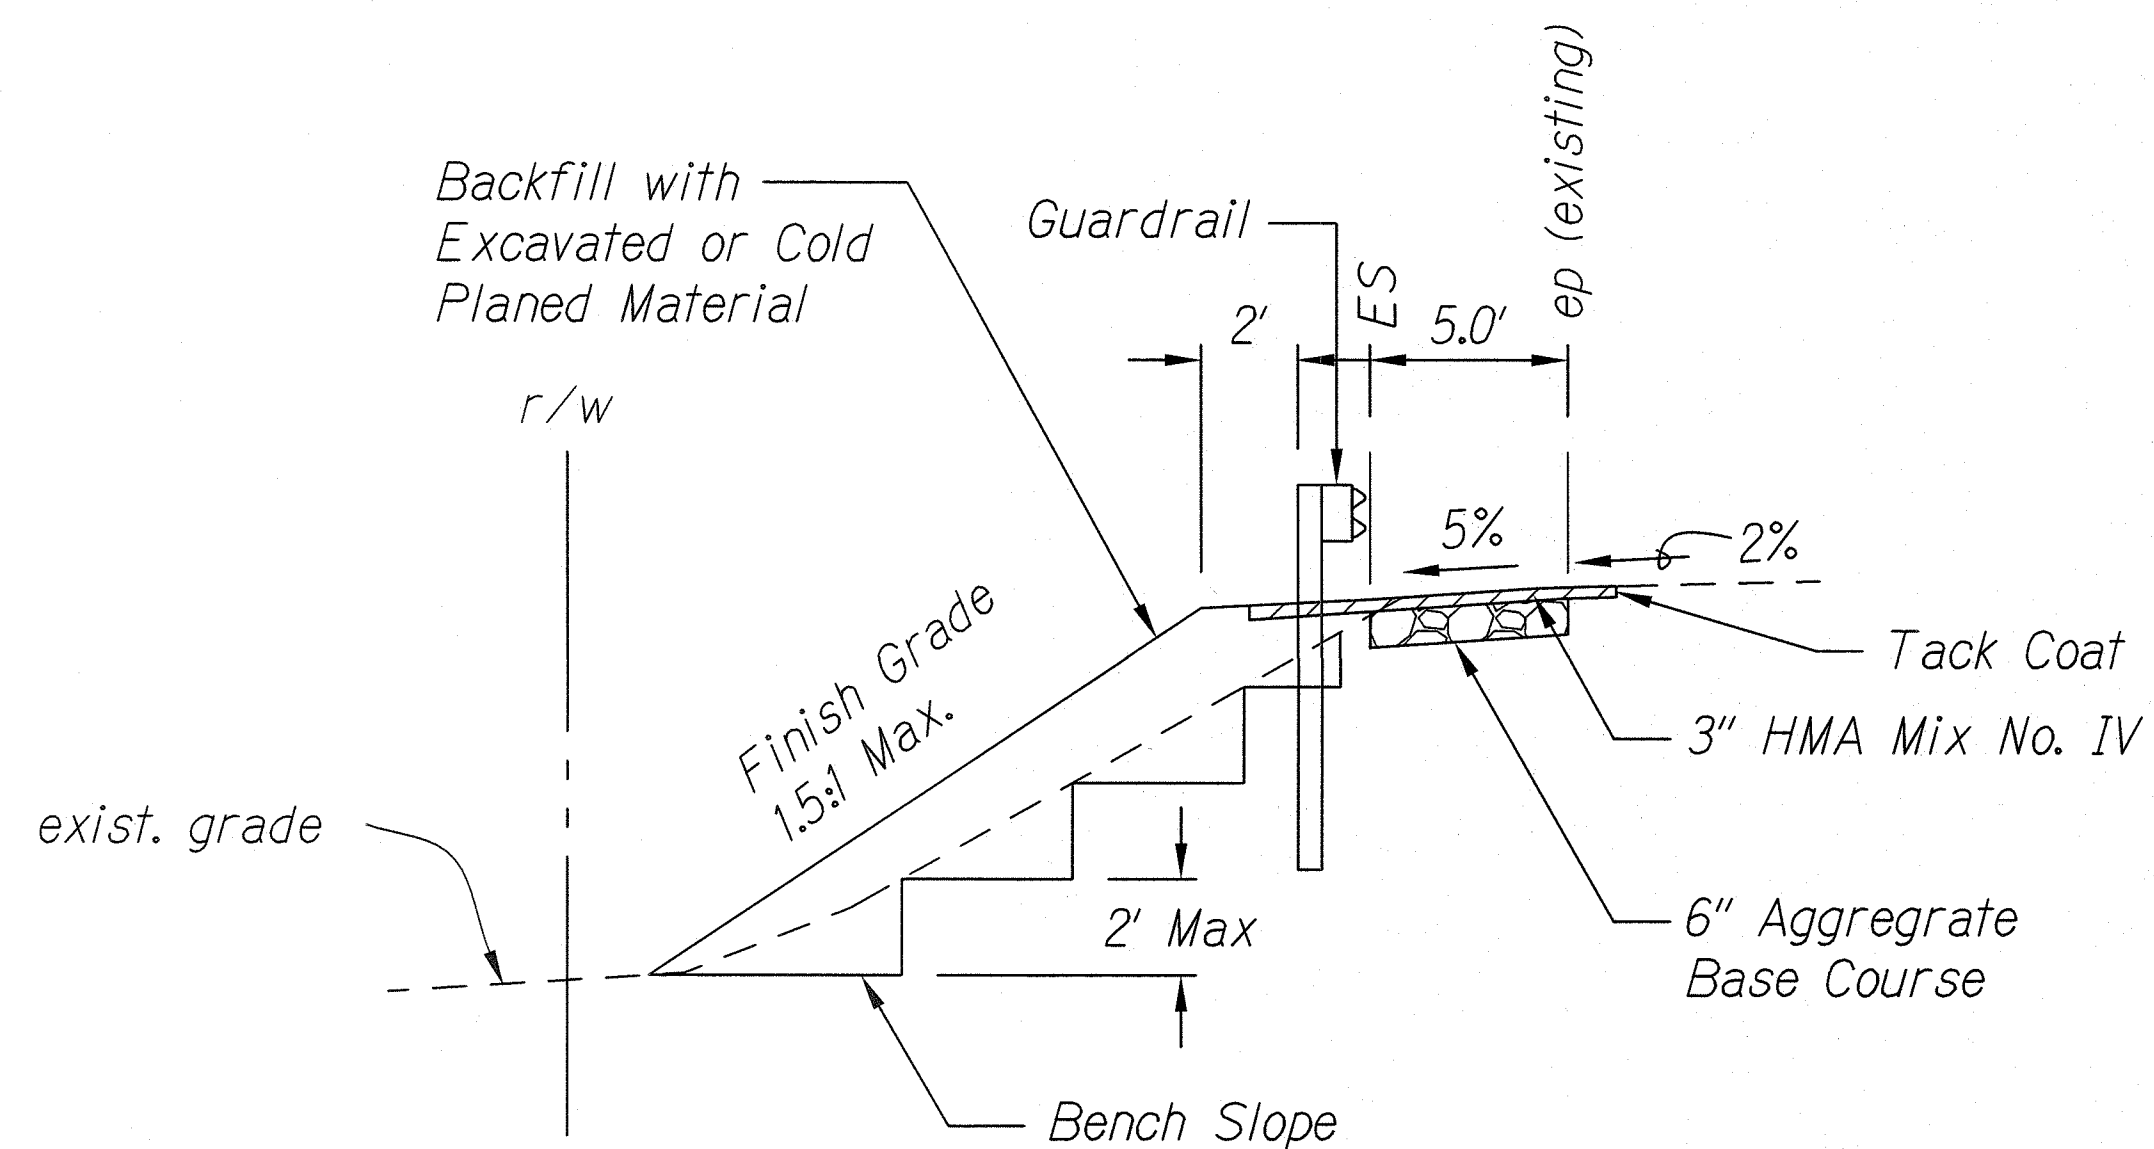

TYPICAL FILL SECTION
Scale: Not to Scale

Scale: 1"=20' 20' 0 20' 40'

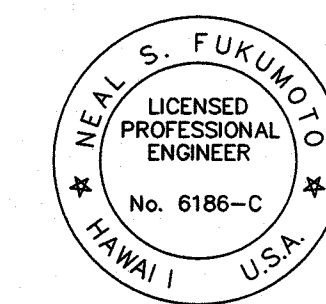


This work was prepared by me or under my supervision.
Exp. 04-30-10
Wesley G. Segawa & Associates, Inc.

STATE OF HAWAII
DEPARTMENT OF TRANSPORTATION
HIGHWAYS DIVISION
SITE PLAN
SITE 2 - MP 13.4
EMERGENCY EARTHQUAKE ROCKFALL REPAIRS
VARIOUS LOCATIONS ON HAWAII, UNIT 4
Federal Aid Project No. ER-15(22)
Scale: As Shown Date: December 2009
SHEET No. 21 OF 23 SHEETS

"AS-BUILT"


FED. ROAD DIST. NO.	STATE	FED. AID PROJ. NO.	FISCAL YEAR	SHEET NO.	TOTAL SHEETS
HAWAII	HAW.	ER-15(22)	2009	21	88

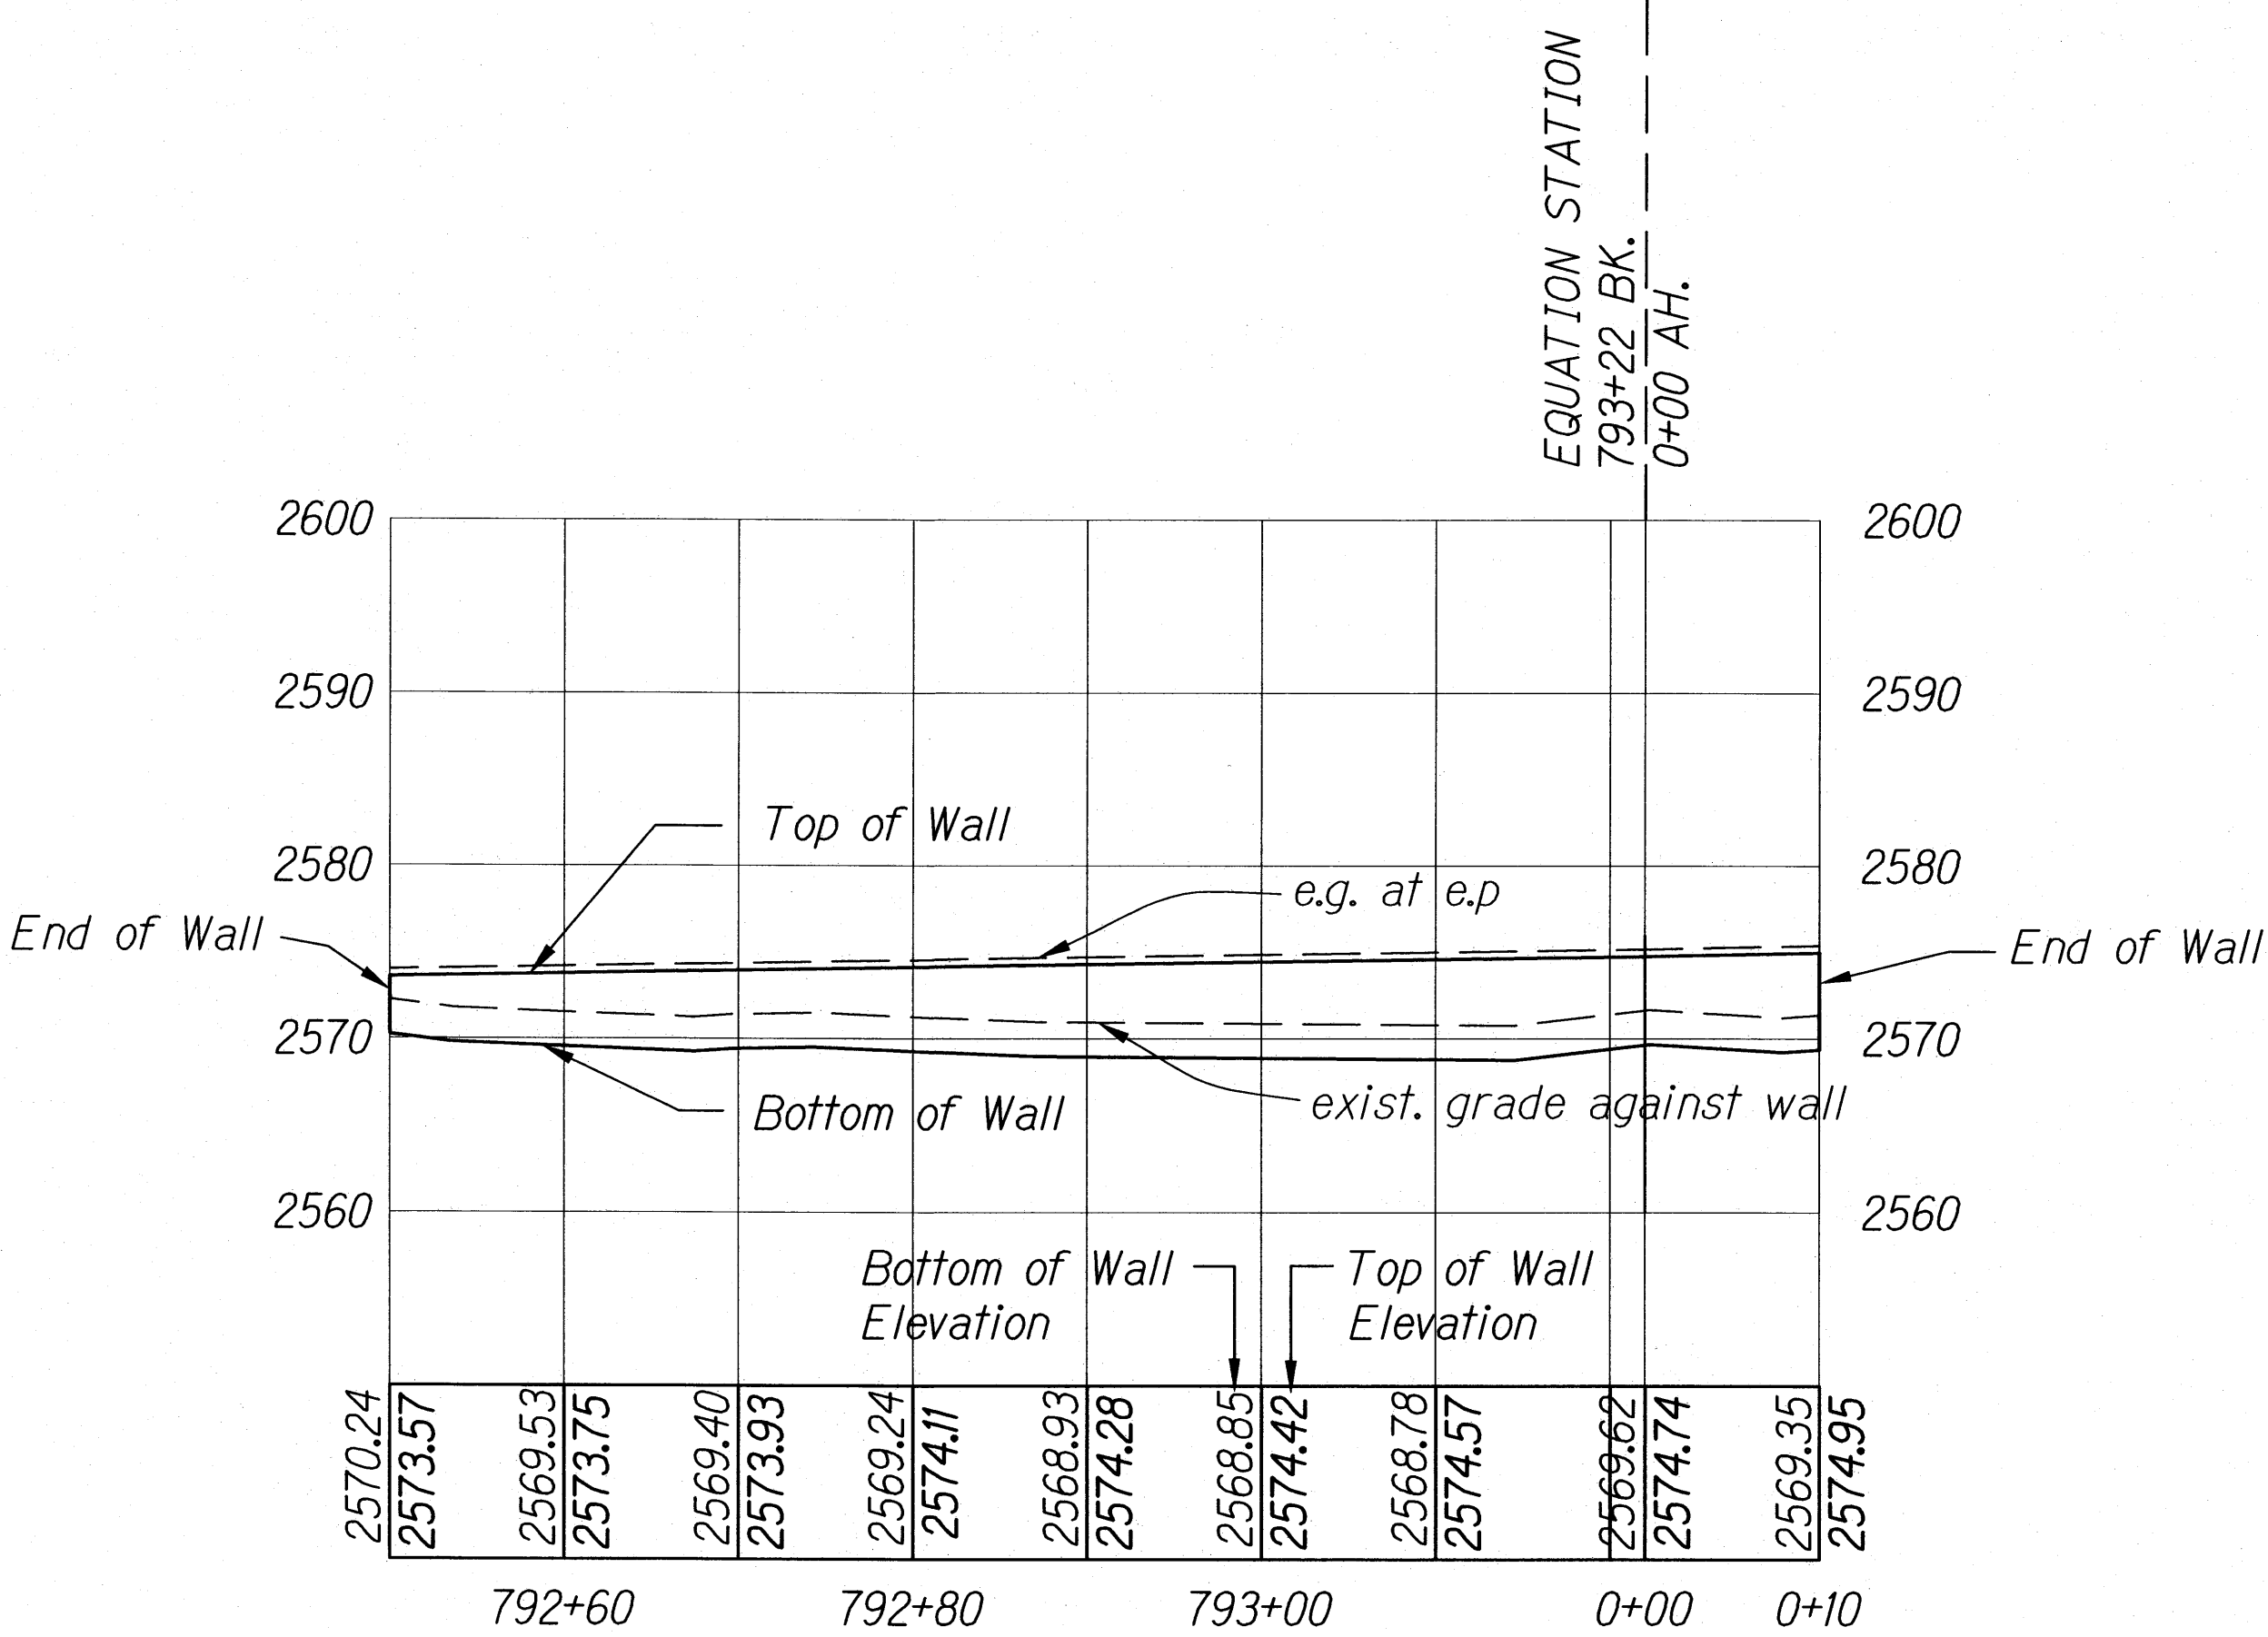

CRM WALL PROFILE - MP 13.4 MAKAI
 Scale: 1"=10'

ORIGINAL PLAN	DRAWN BY	DATE
NOTE BOOK	DESIGNED BY	
	CHECKED BY	

Scale: 1"=10'

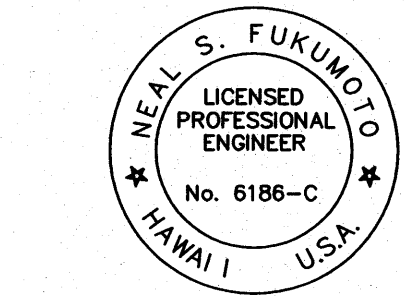


This work was prepared by me
 or under my supervision.
 Exp. 04-30-10
Wesley R. Segawa
 Wesley R. Segawa & Associates, Inc.

STATE OF HAWAII
DEPARTMENT OF TRANSPORTATION
HIGHWAYS DIVISION
CRM WALL PROFILE
SITE 2 - MP 13.4
EMERGENCY EARTHQUAKE ROCKFALL REPAIRS
VARIOUS LOCATIONS ON HAWAII, UNIT 4
Federal Aid Project No. ER-15(22)
Scale: 1"=10' Date: Dec. 2009
SHEET No. 2.2 OF 2.3 SHEETS


21

FED. ROAD DIST. NO.	STATE	FED. AID PROJ. NO.	FISCAL YEAR	SHEET NO.	TOTAL SHEETS
HAWAII	HAW.	ER-15(22)	2009	22	88

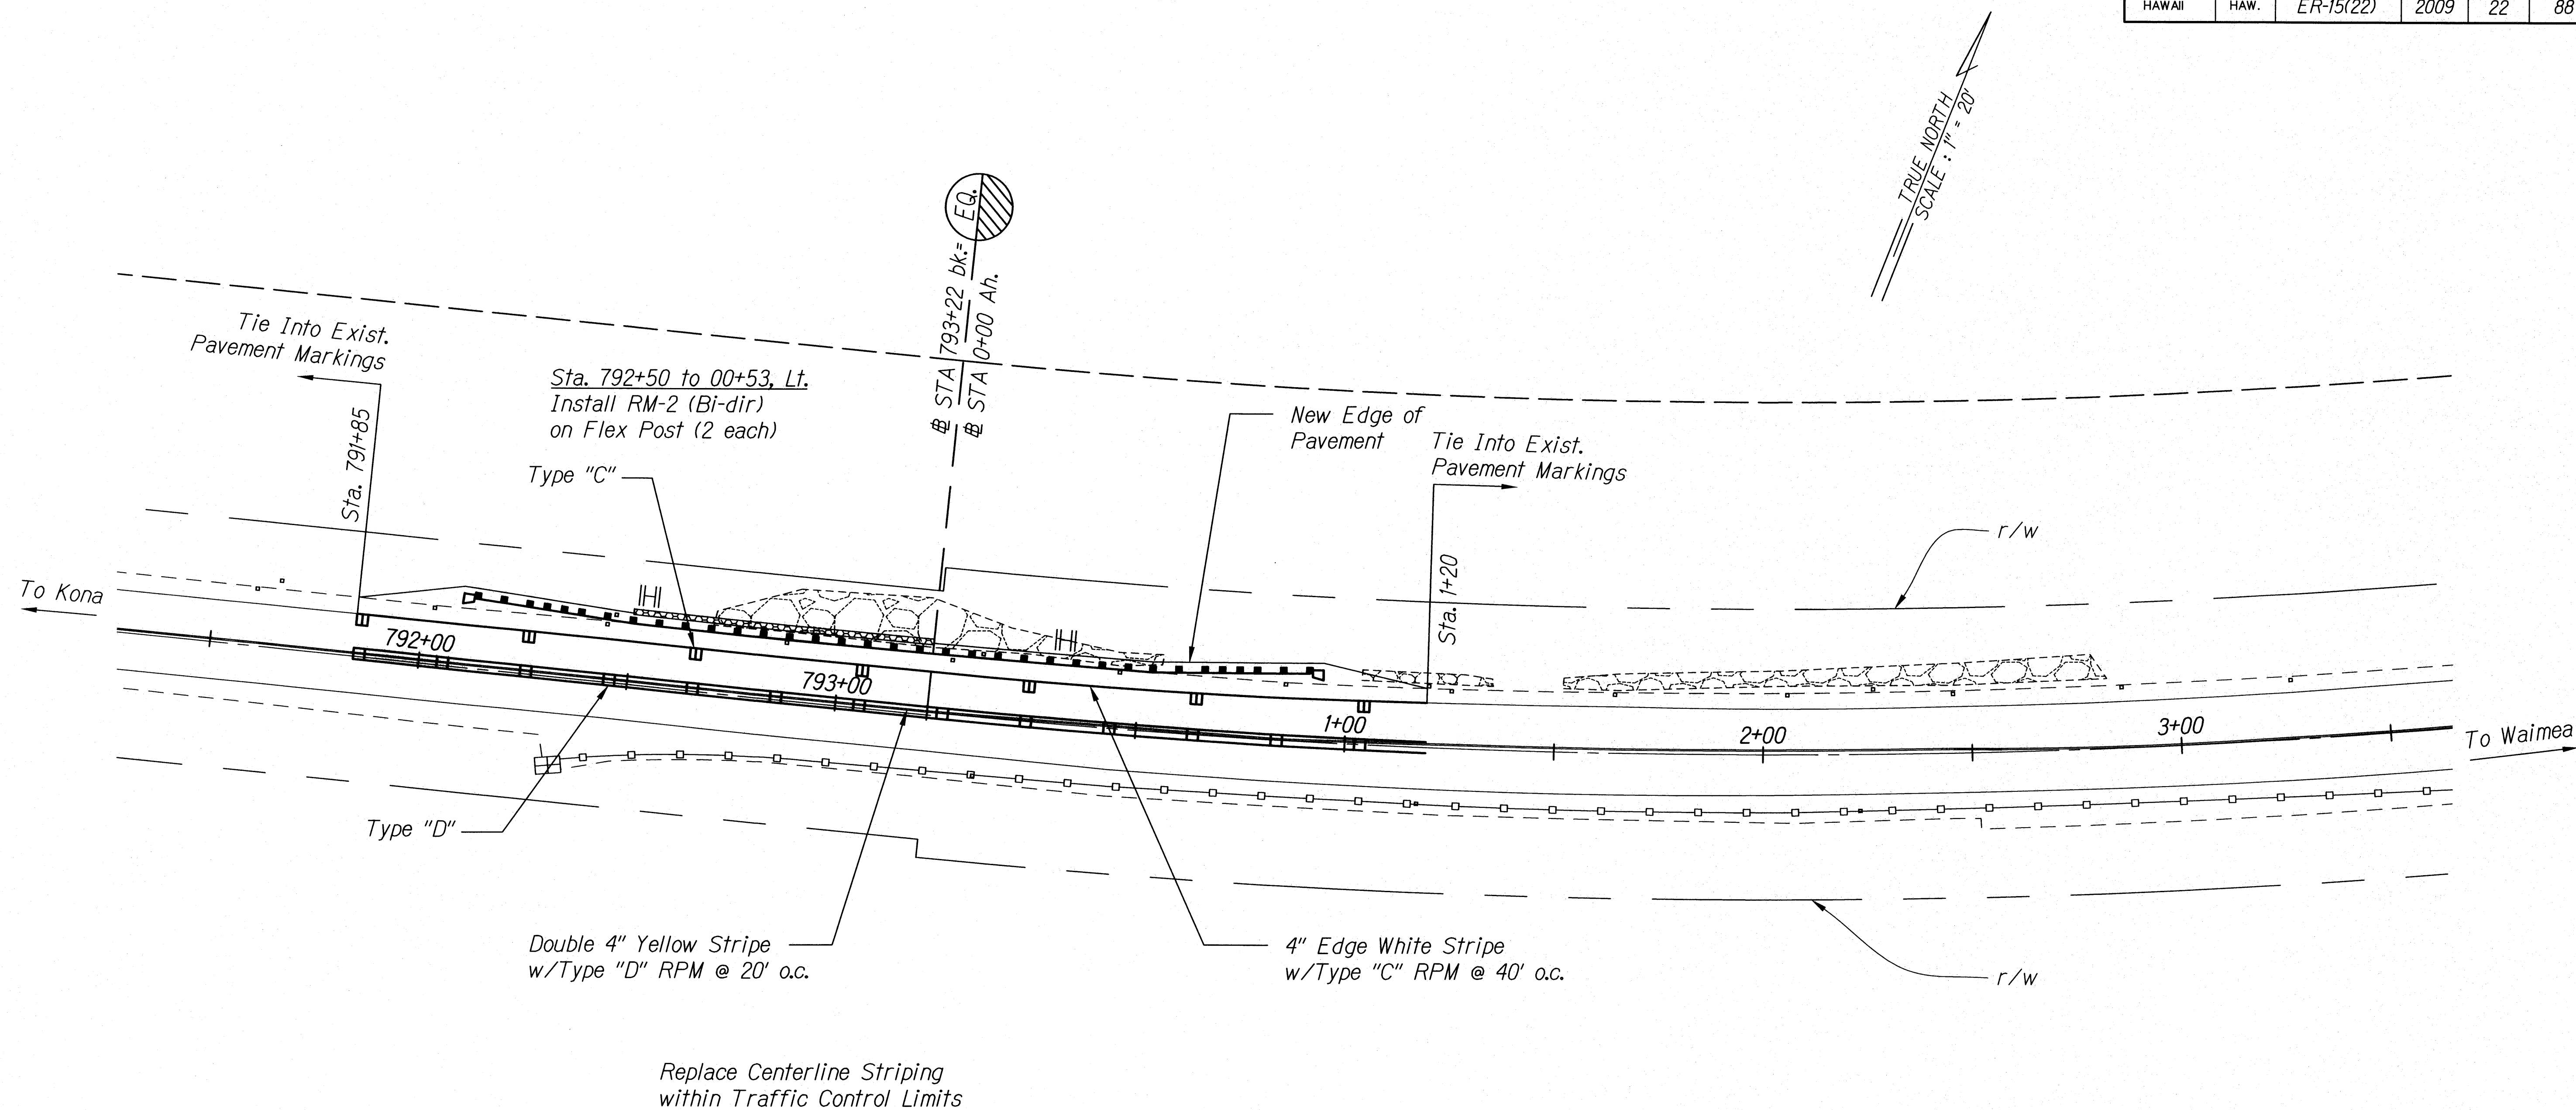

STRIPING PLAN - MP 13.4
Scale: 1"=20'

Scale: 1"=20' 20' 0 20' 40'

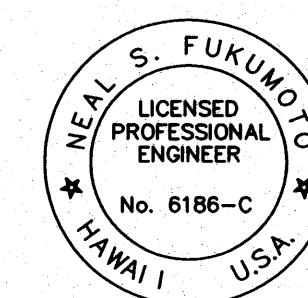

This work was prepared by me or under my supervision.
Exp. 04-30-10
Neal S. Fukunoto
Wesley R. Segawa & Associates, Inc.

STATE OF HAWAII
DEPARTMENT OF TRANSPORTATION
HIGHWAYS DIVISION

STRIPING PLAN
SITE 2 - MP 13.4

EMERGENCY EARTHQUAKE ROCKFALL REPAIRS
VARIOUS LOCATIONS ON HAWAII, UNIT 4
Federal Aid Project No. ER-15(22)

Scale: 1"=20' Date: Dec. 2009
SHEET No. 23 OF 23 SHEETS