



FED. ROAD DIST. NO.	STATE	FED. AID PROJ. NO.	FISCAL YEAR	SHEET NO.	TOTAL SHEETS
HAWAII	HAW.	ER-15(22)	2009	44	88

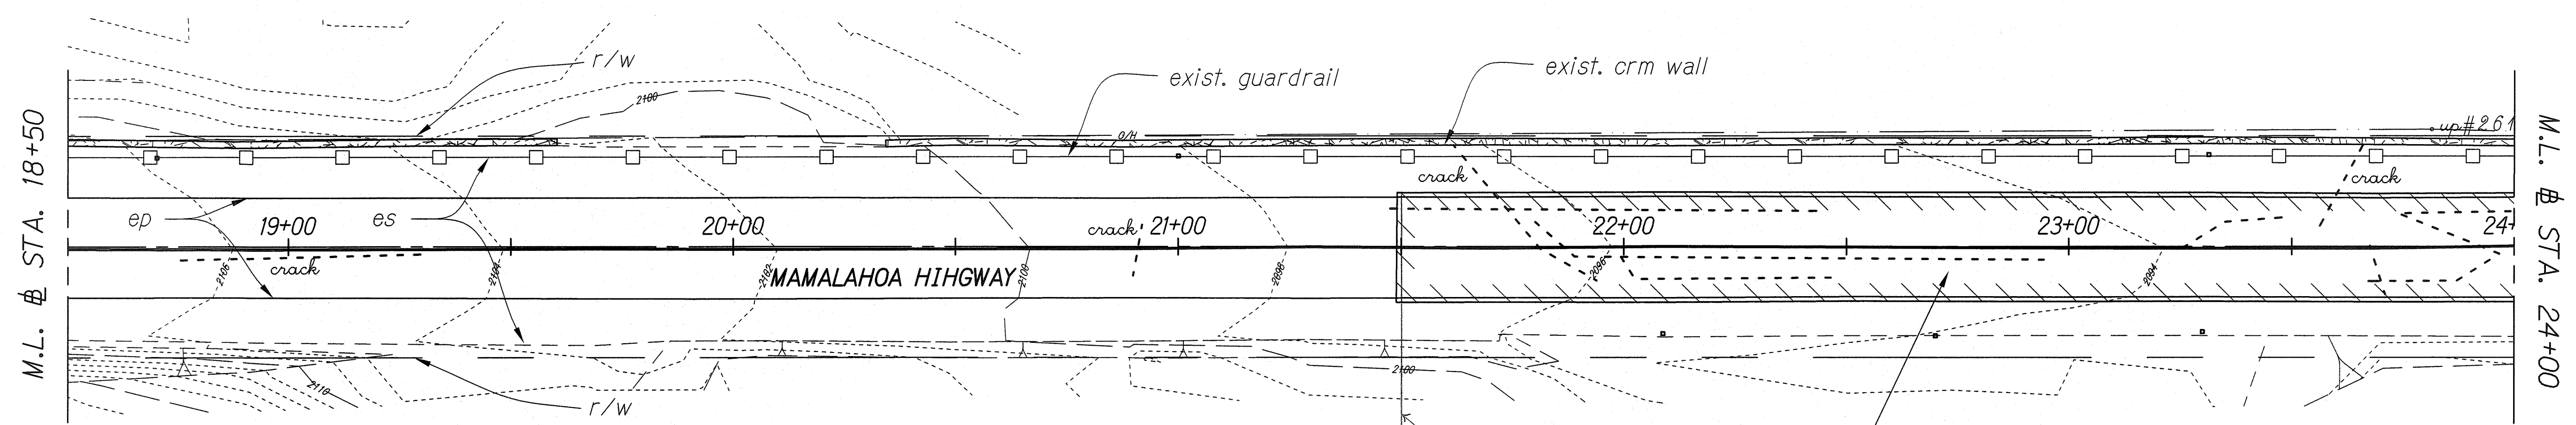


Additional Reconstruction of Weakened Pavement Areas 21+50 to 22+50

Sta. 21+50 to 30+95
Coldplane A.C. Pavement 3" and Resurface.
See Below For Typical Section

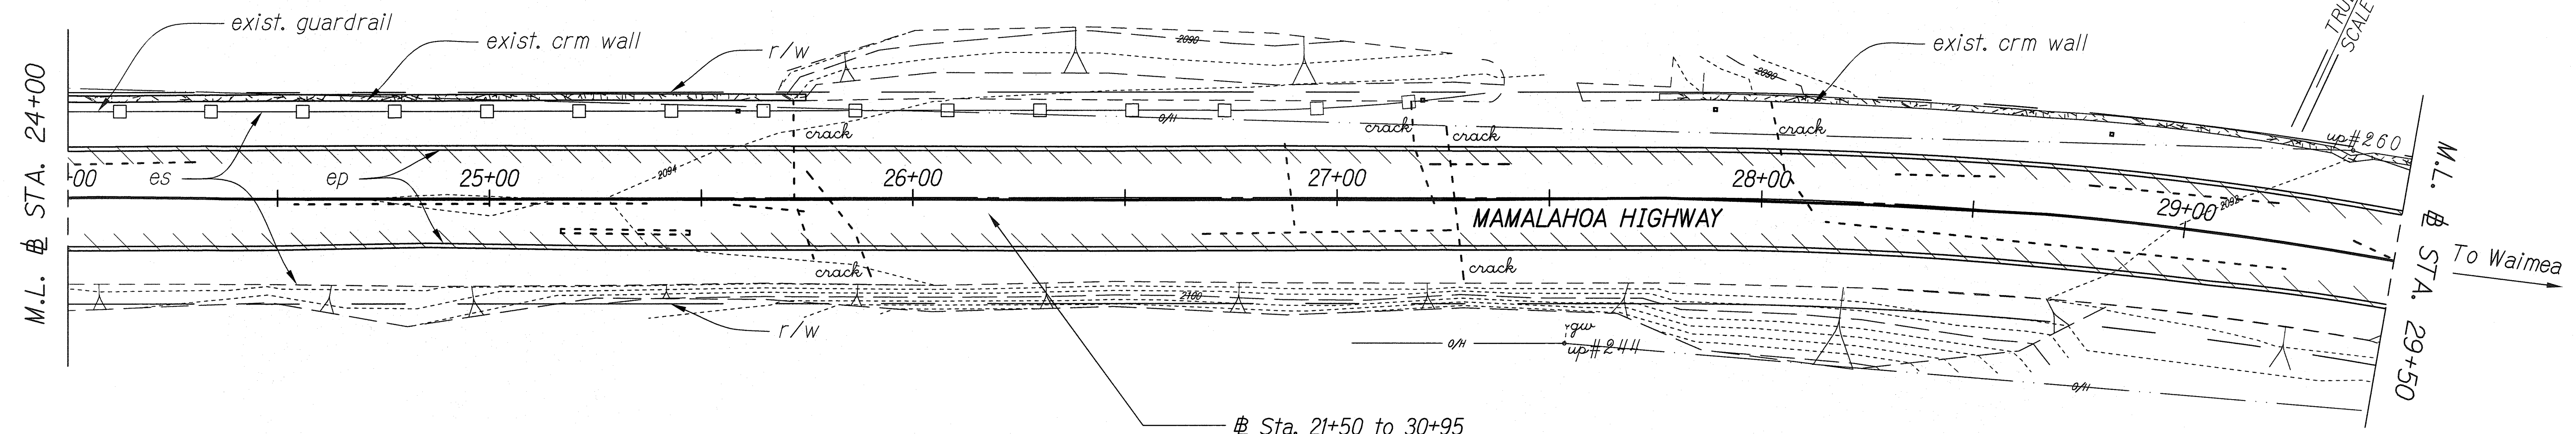


Sta. 21+50 to 30+95
Cold Plane A.C. Pavement 3" and Resurface.
See Below For Typical Section.

PLAN - MP 27.7 TO 28.7
Scale: 1"=20'

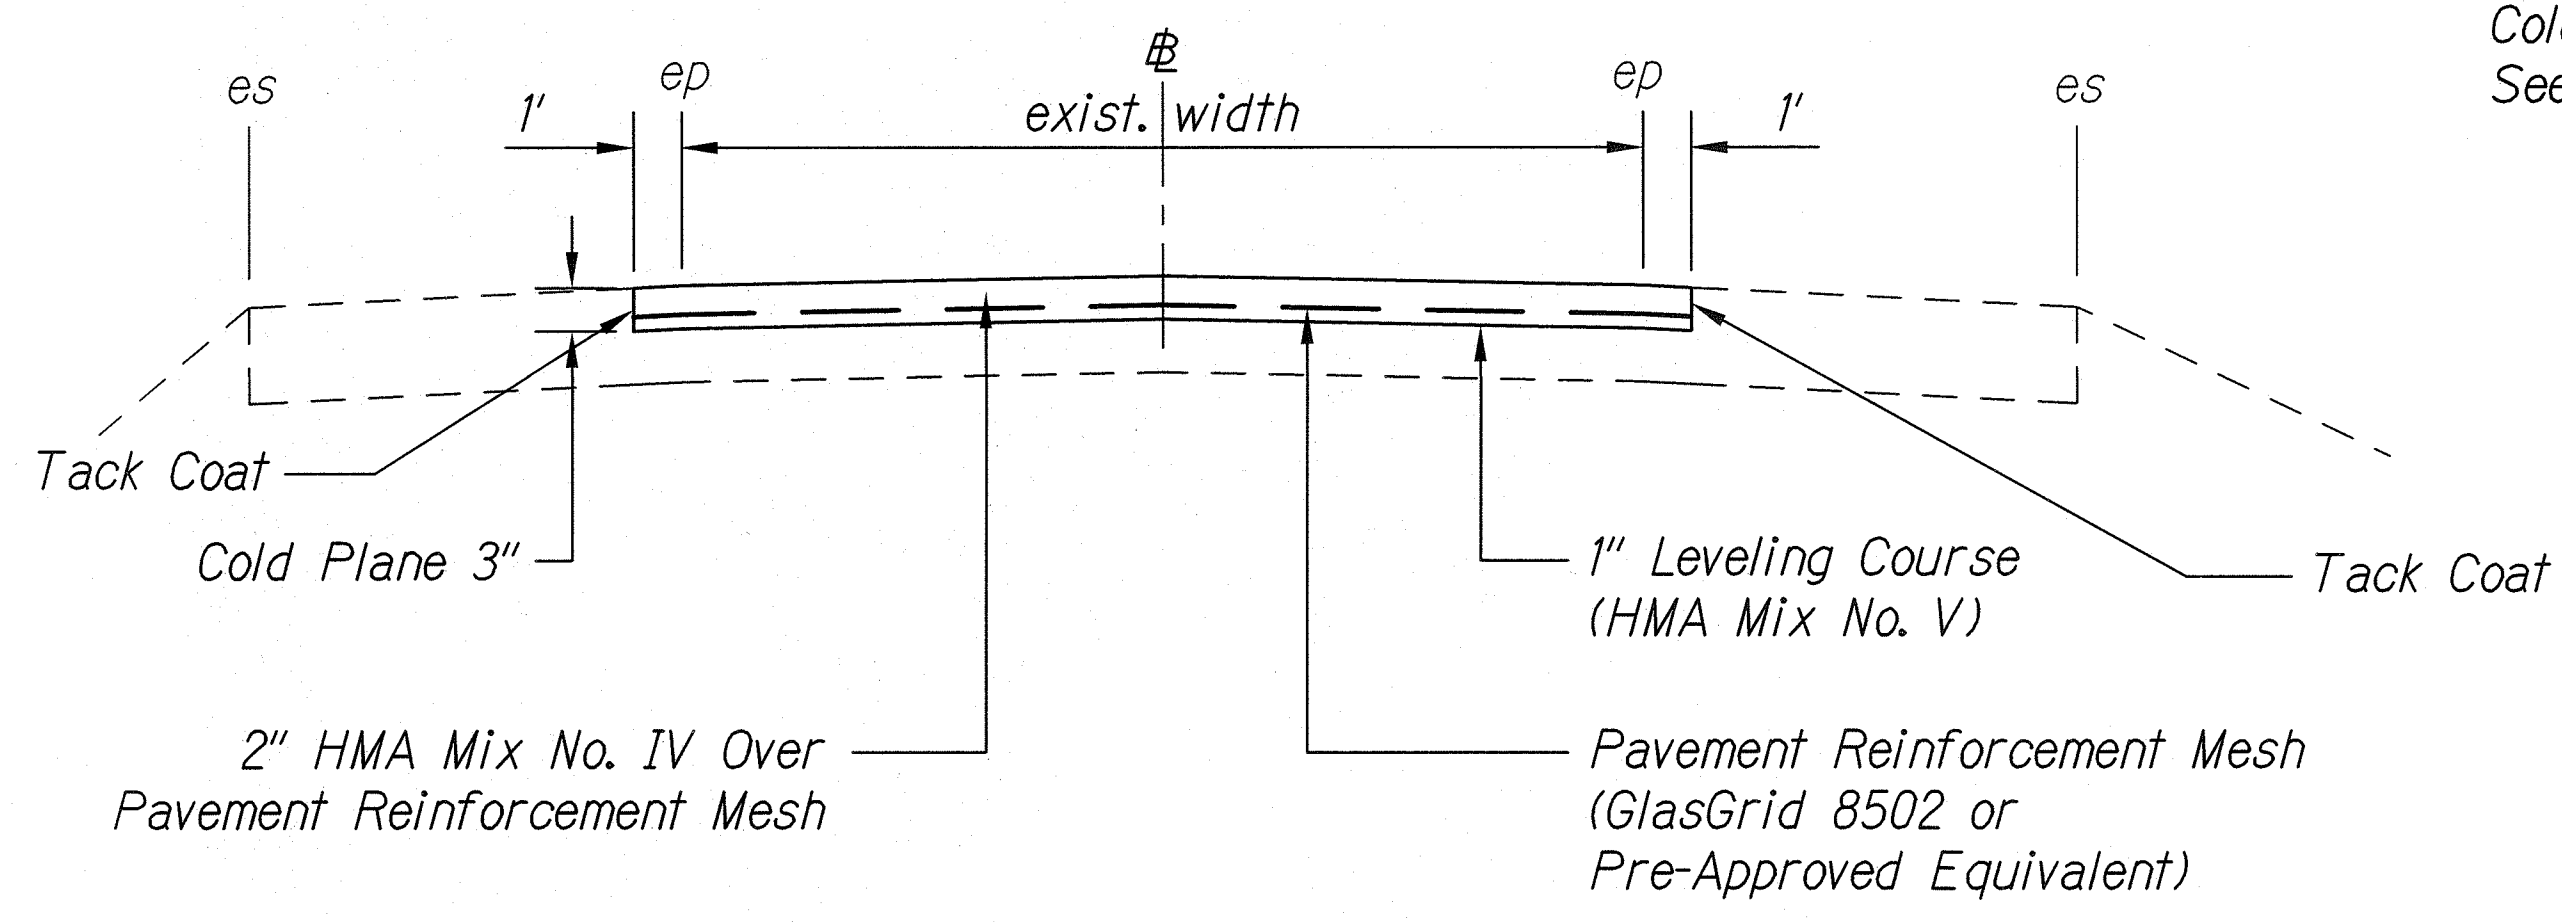

TYPICAL COLD PLANE/RESURFACE SECTION
Scale: Not to Scale


NOTE:
Seal All Existing Cracks in Pavement Labeled "crack", Except Where Pavement is Noted to be Resurfaced.

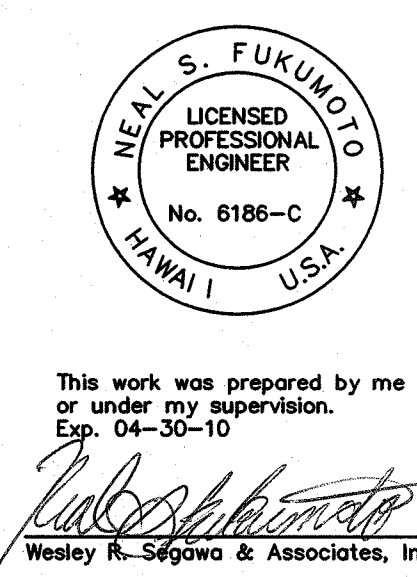

STATE OF HAWAII
DEPARTMENT OF TRANSPORTATION
HIGHWAYS DIVISION
SITE PLAN - 2
SITE 6-MP 27.7 TO MP 28.7
EMERGENCY EARTHQUAKE ROCKFALL REPAIRS
VARIOUS LOCATIONS ON HAWAII, UNIT 4
Federal Aid Project No. ER-15(22)
Scale: As Shown Date: December 2009
SHEET No. 6.2 OF 6.7 SHEETS

"AS-BUILT"

FED. ROAD DIST. NO.	STATE	FED. AID PROJ. NO.	FISCAL YEAR	SHEET NO.	TOTAL SHEETS
HAWAII	HAW.	ER-15(22)	2009	45	88

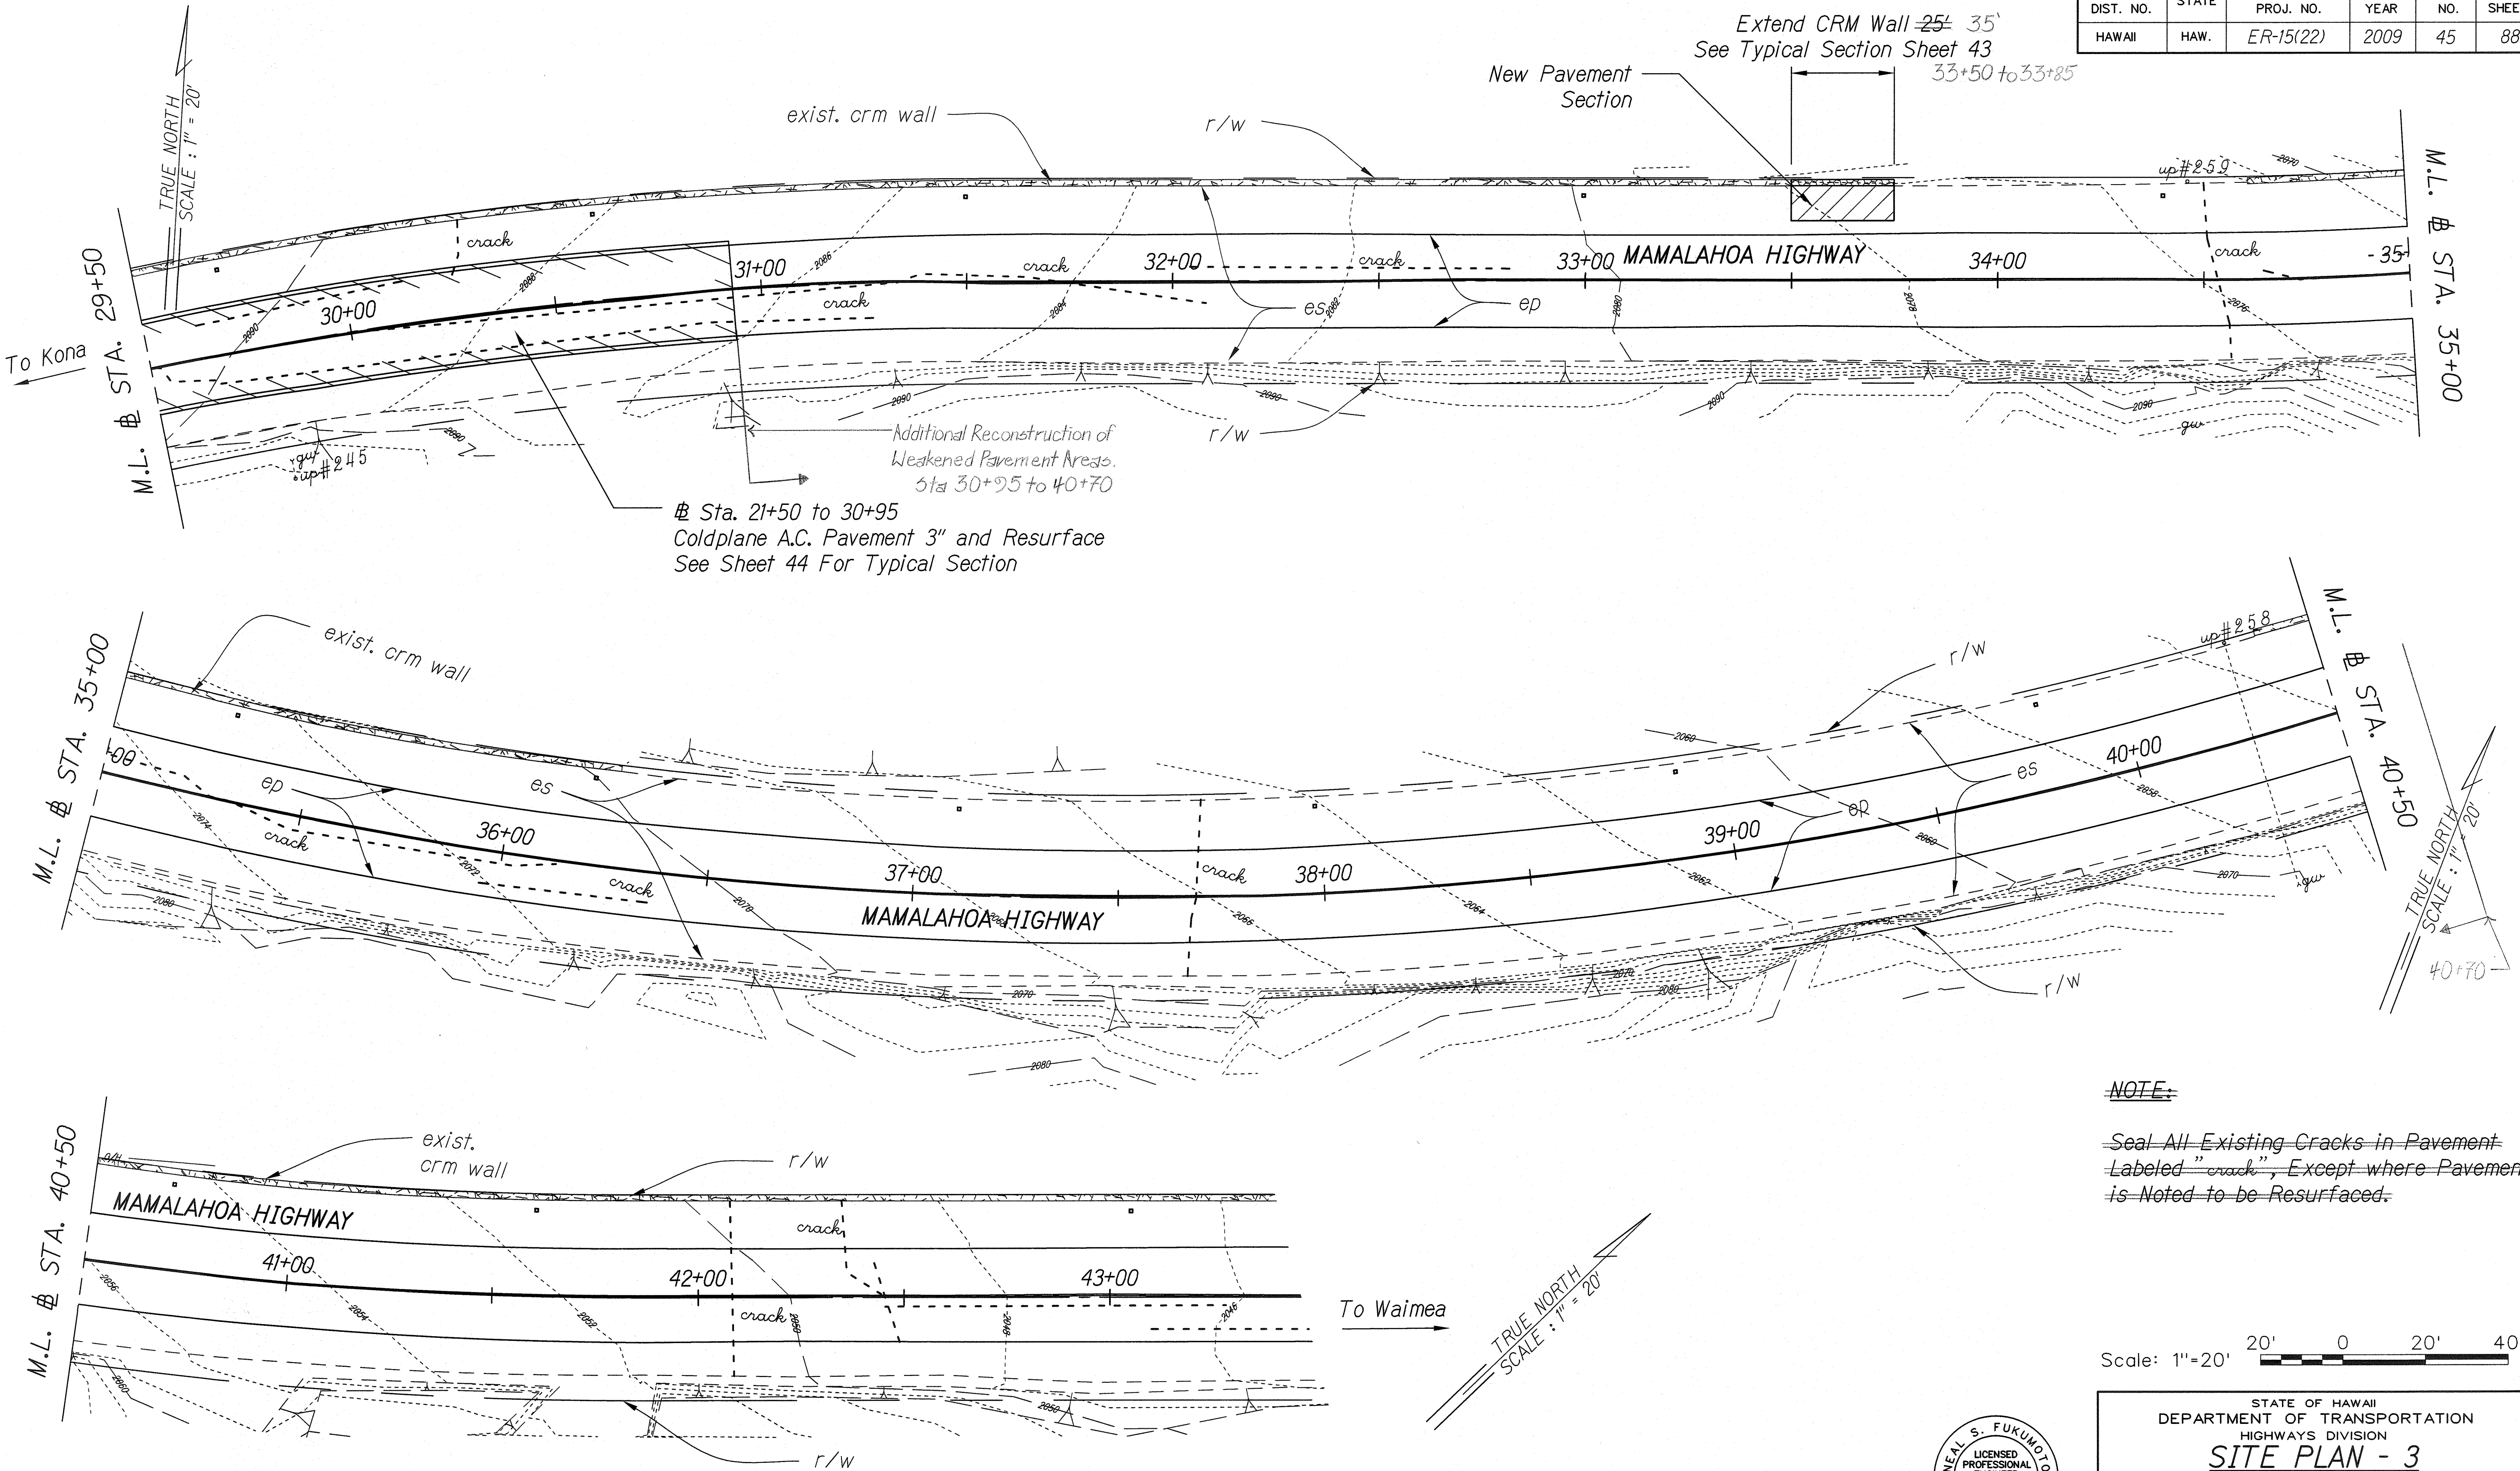

NOTE:

Seal All Existing Cracks in Pavement Labeled "crack", Except where Pavement is Noted to be Resurfaced.

Scale: 1"=20' 20' 0 20' 40'

STATE OF HAWAII
DEPARTMENT OF TRANSPORTATION
HIGHWAYS DIVISION
SITE PLAN - 3
SITE 6-MP 27.7 TO MP 28.7
EMERGENCY EARTHQUAKE ROCKFALL REPAIRS
VARIOUS LOCATIONS ON HAWAII, UNIT 4
Federal Aid Project No. ER-15(22)
Scale: As Shown Date: December 2009
SHEET No. 6.3 OF 6.7 SHEETS


This work was prepared by me or under my supervision.
Exp. 04-30-10

Neal S. Fukunoto
Wesley R. Segawa & Associates, Inc.

PLAN - MP 27.7 TO 28.7
Scale: 1"=20'


"AS-BUILT"

FED. ROAD DIST. NO.	STATE	FED. AID PROJ. NO.	FISCAL YEAR	SHEET NO.	TOTAL SHEETS
HAWAII	HAW.	ER-15(22)	2009	46	88

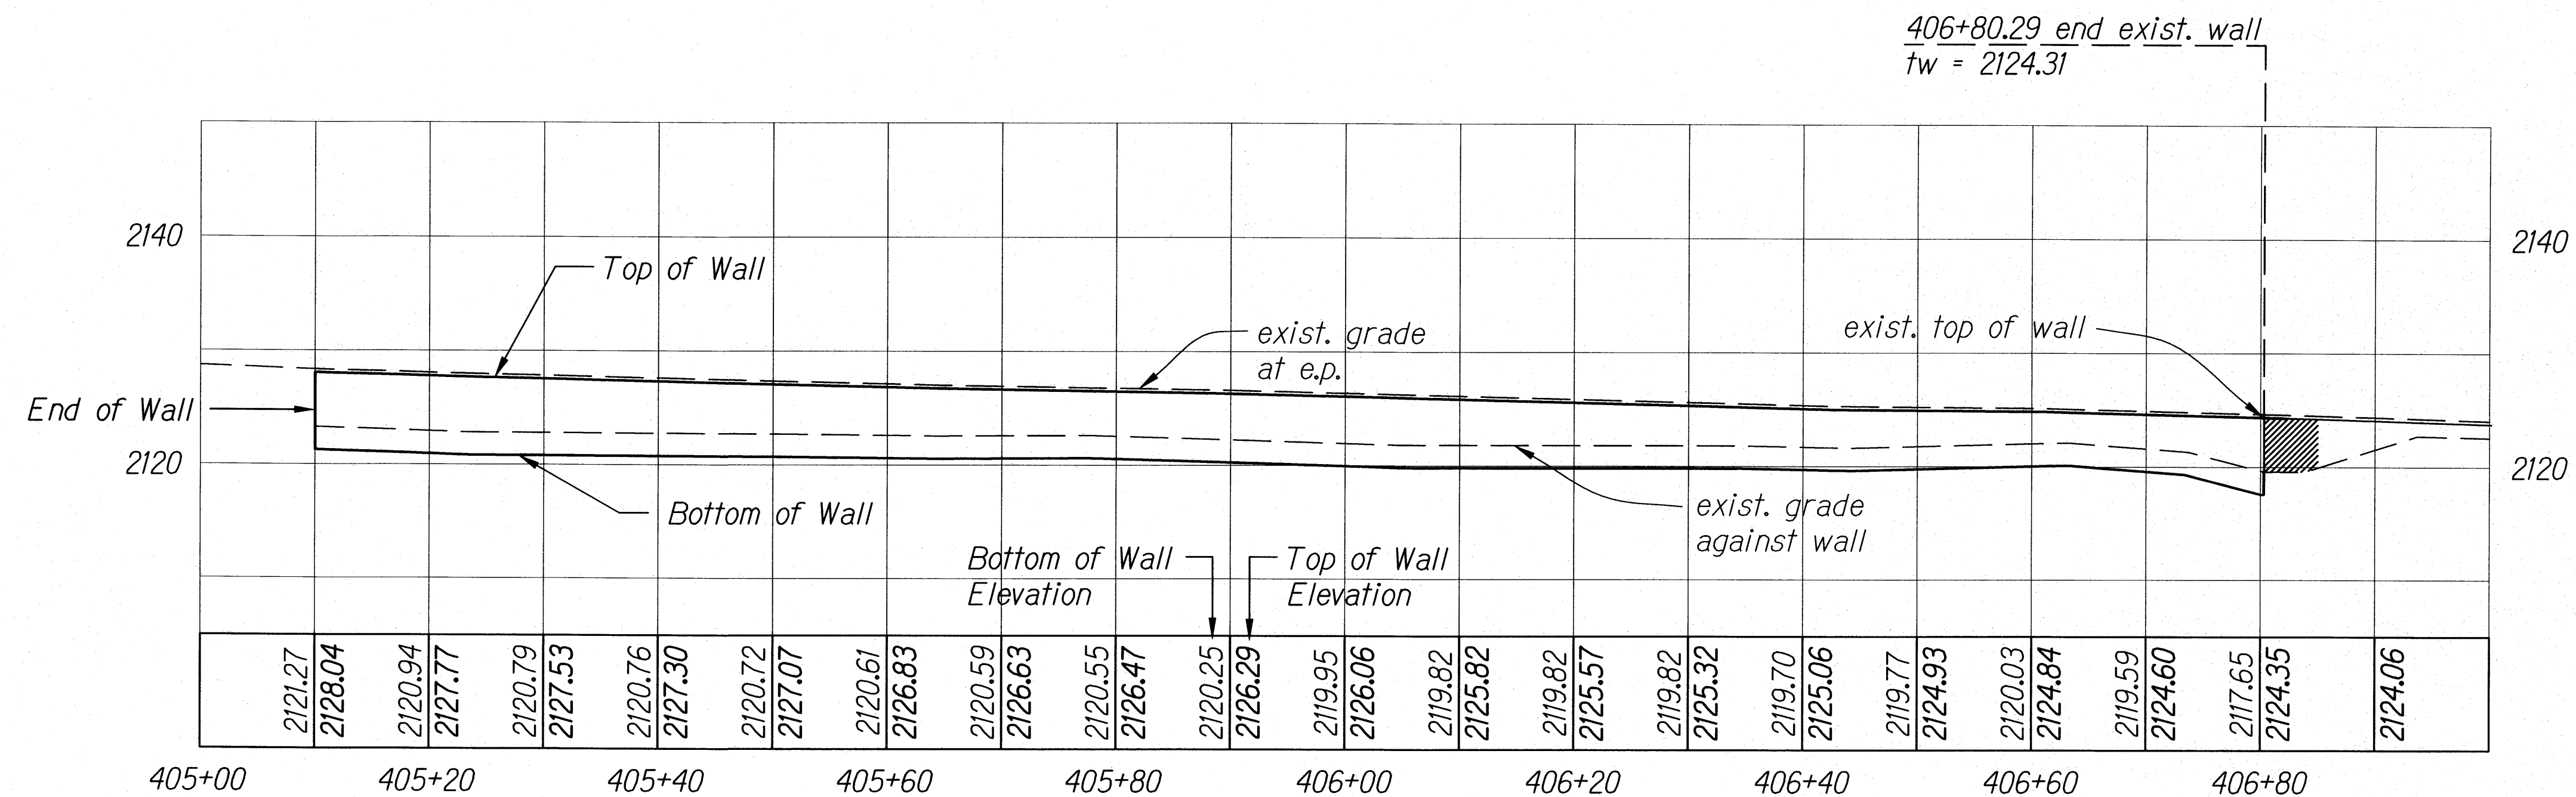


CRM WALL PROFILE - STA. 405+10 TO 406+80

Scale: 1" = 10'

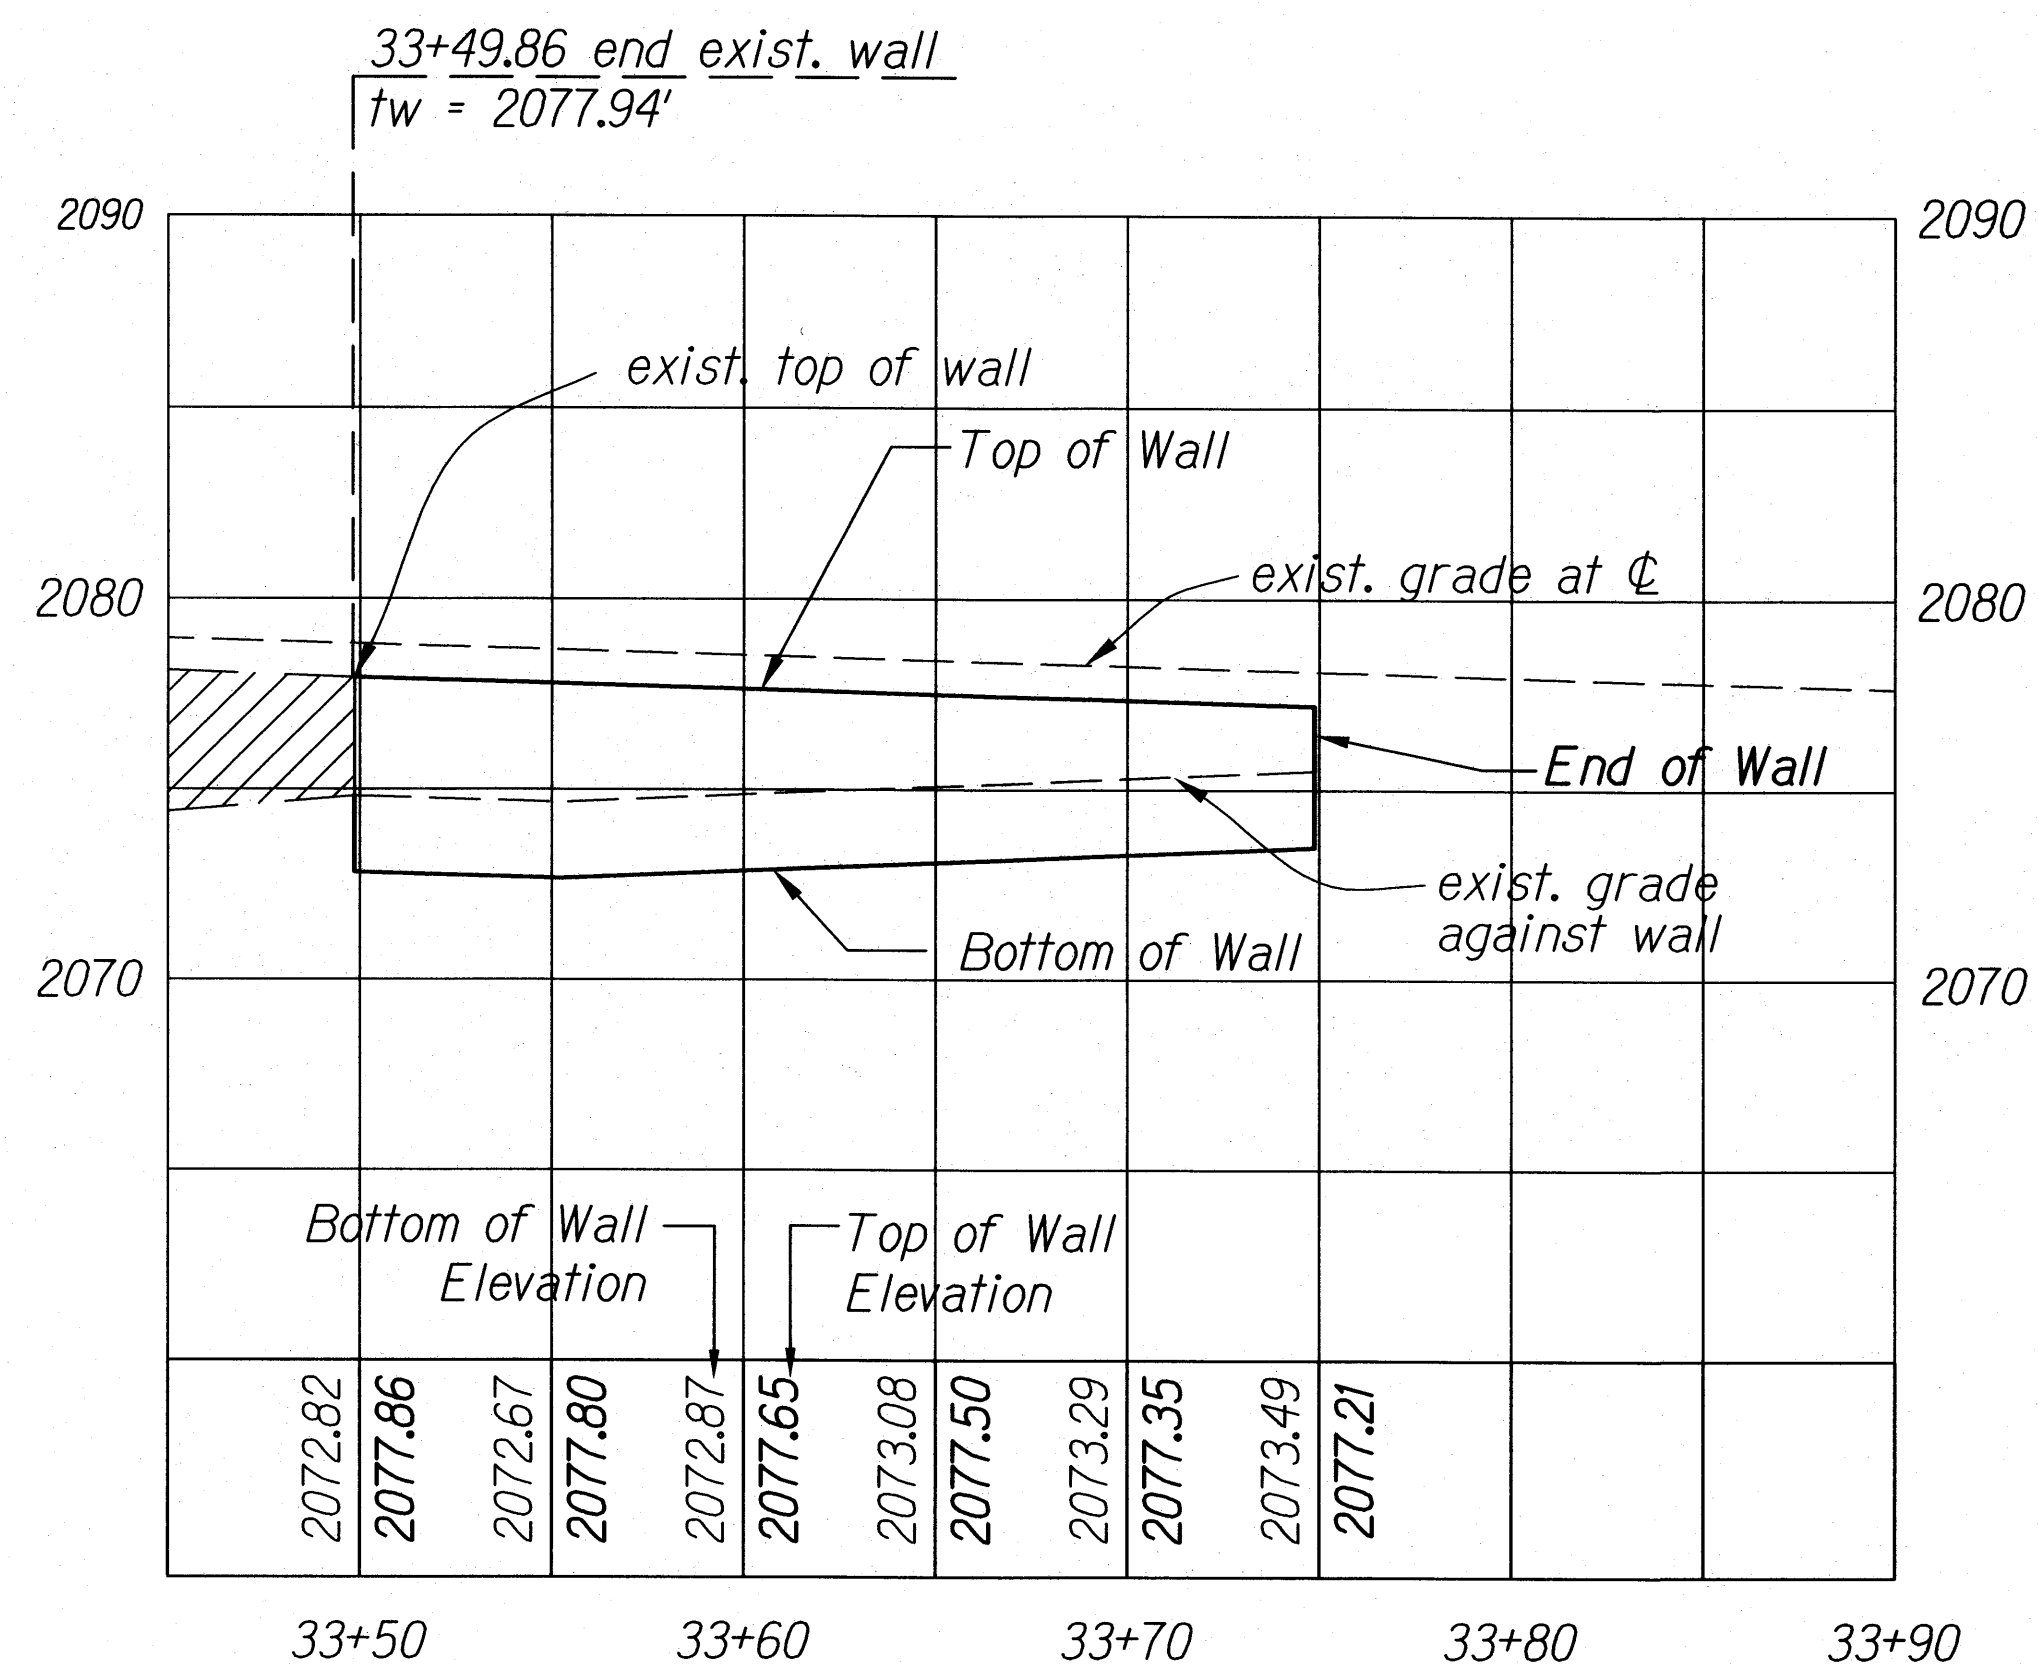


CRM WALL PROFILE - STA. 33+50 TO 33+75

Scale: 1" = 5'

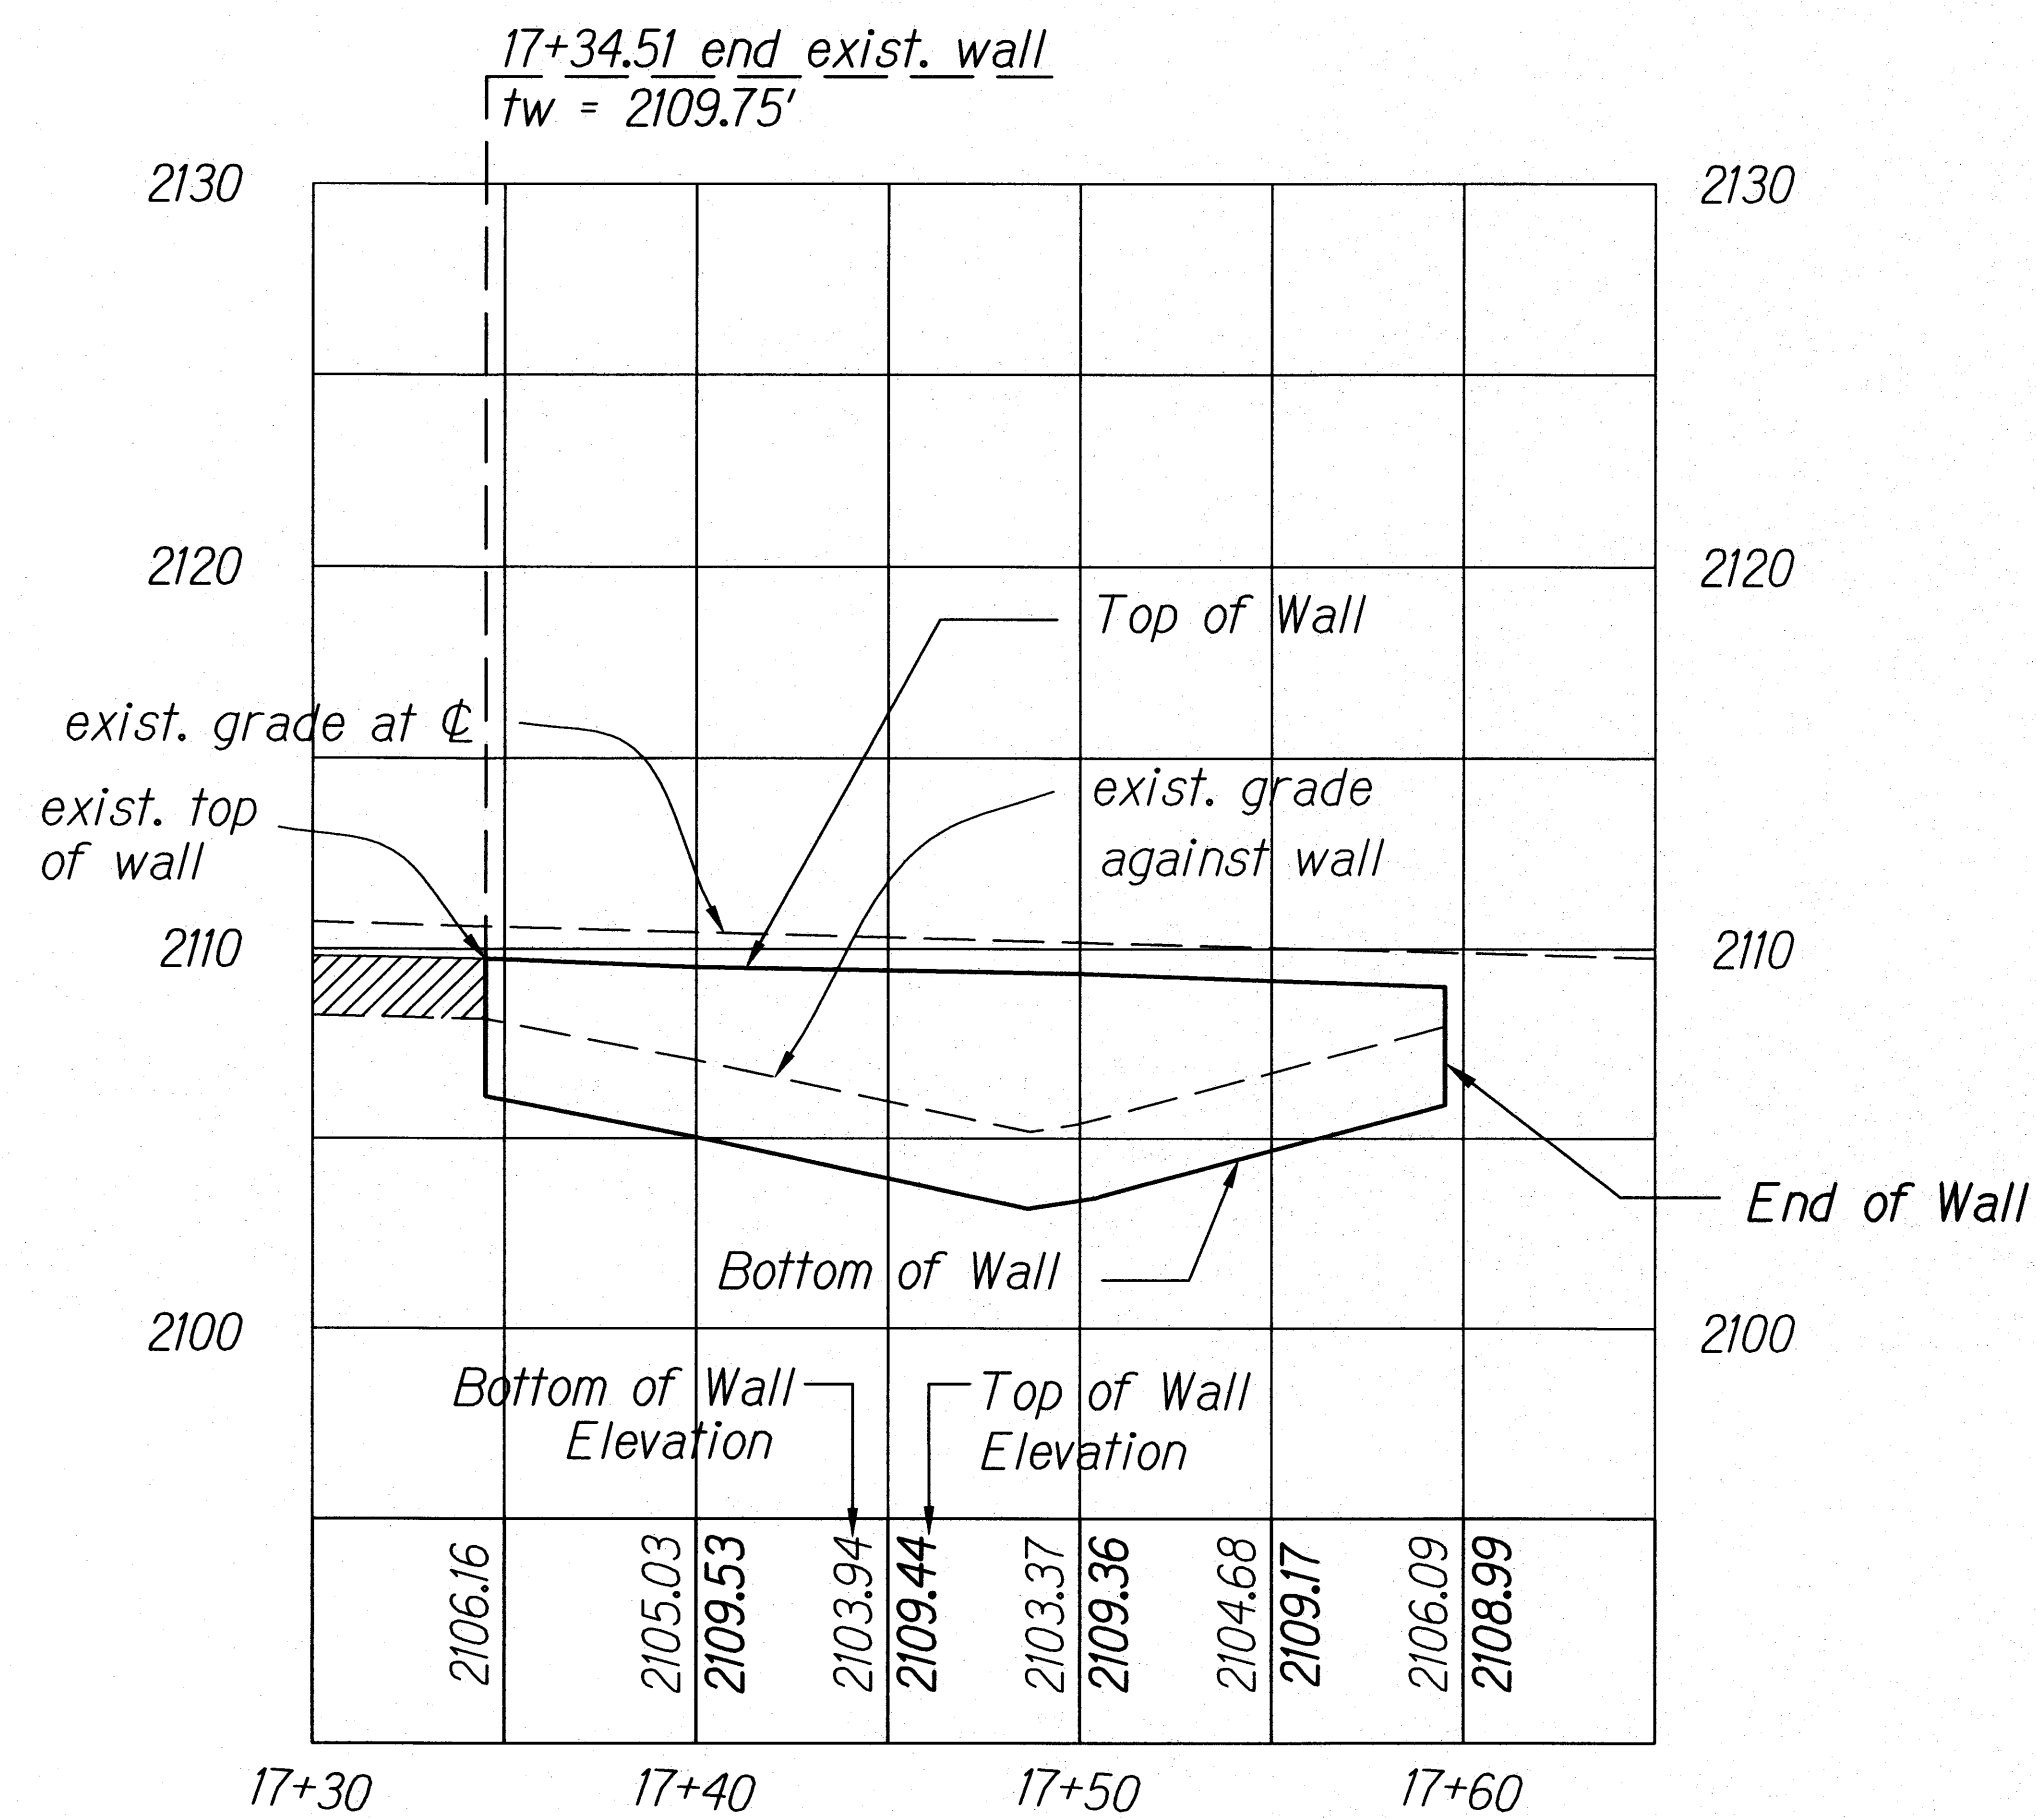

CRM WALL PROFILE - STA. 17+35 TO 17+60

Scale: 1" = 5'

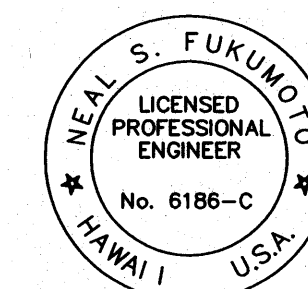


This work was prepared by me or under my supervision.
Exp. 04-30-10
Neal S. Fukunaga
Wesley R. Segawa & Associates, Inc.

STATE OF HAWAII
DEPARTMENT OF TRANSPORTATION
HIGHWAYS DIVISION

CRM WALL PROFILE
SITE 6-MP 27.7 TO MP 28.7
EMERGENCY EARTHQUAKE ROCKFALL REPAIRS
VARIOUS LOCATIONS ON HAWAII, UNIT 4
Federal Aid Project No. ER-15(22)
Scale: As Shown Date: Dec. 2009
SHEET No. 6.4 OF 6.7 SHEETS

FED. ROAD DIST. NO.	STATE	FED. AID PROJ. NO.	FISCAL YEAR	SHEET NO.	TOTAL SHEETS
HAWAII	HAW.	ER-15(22)	2009	47	88

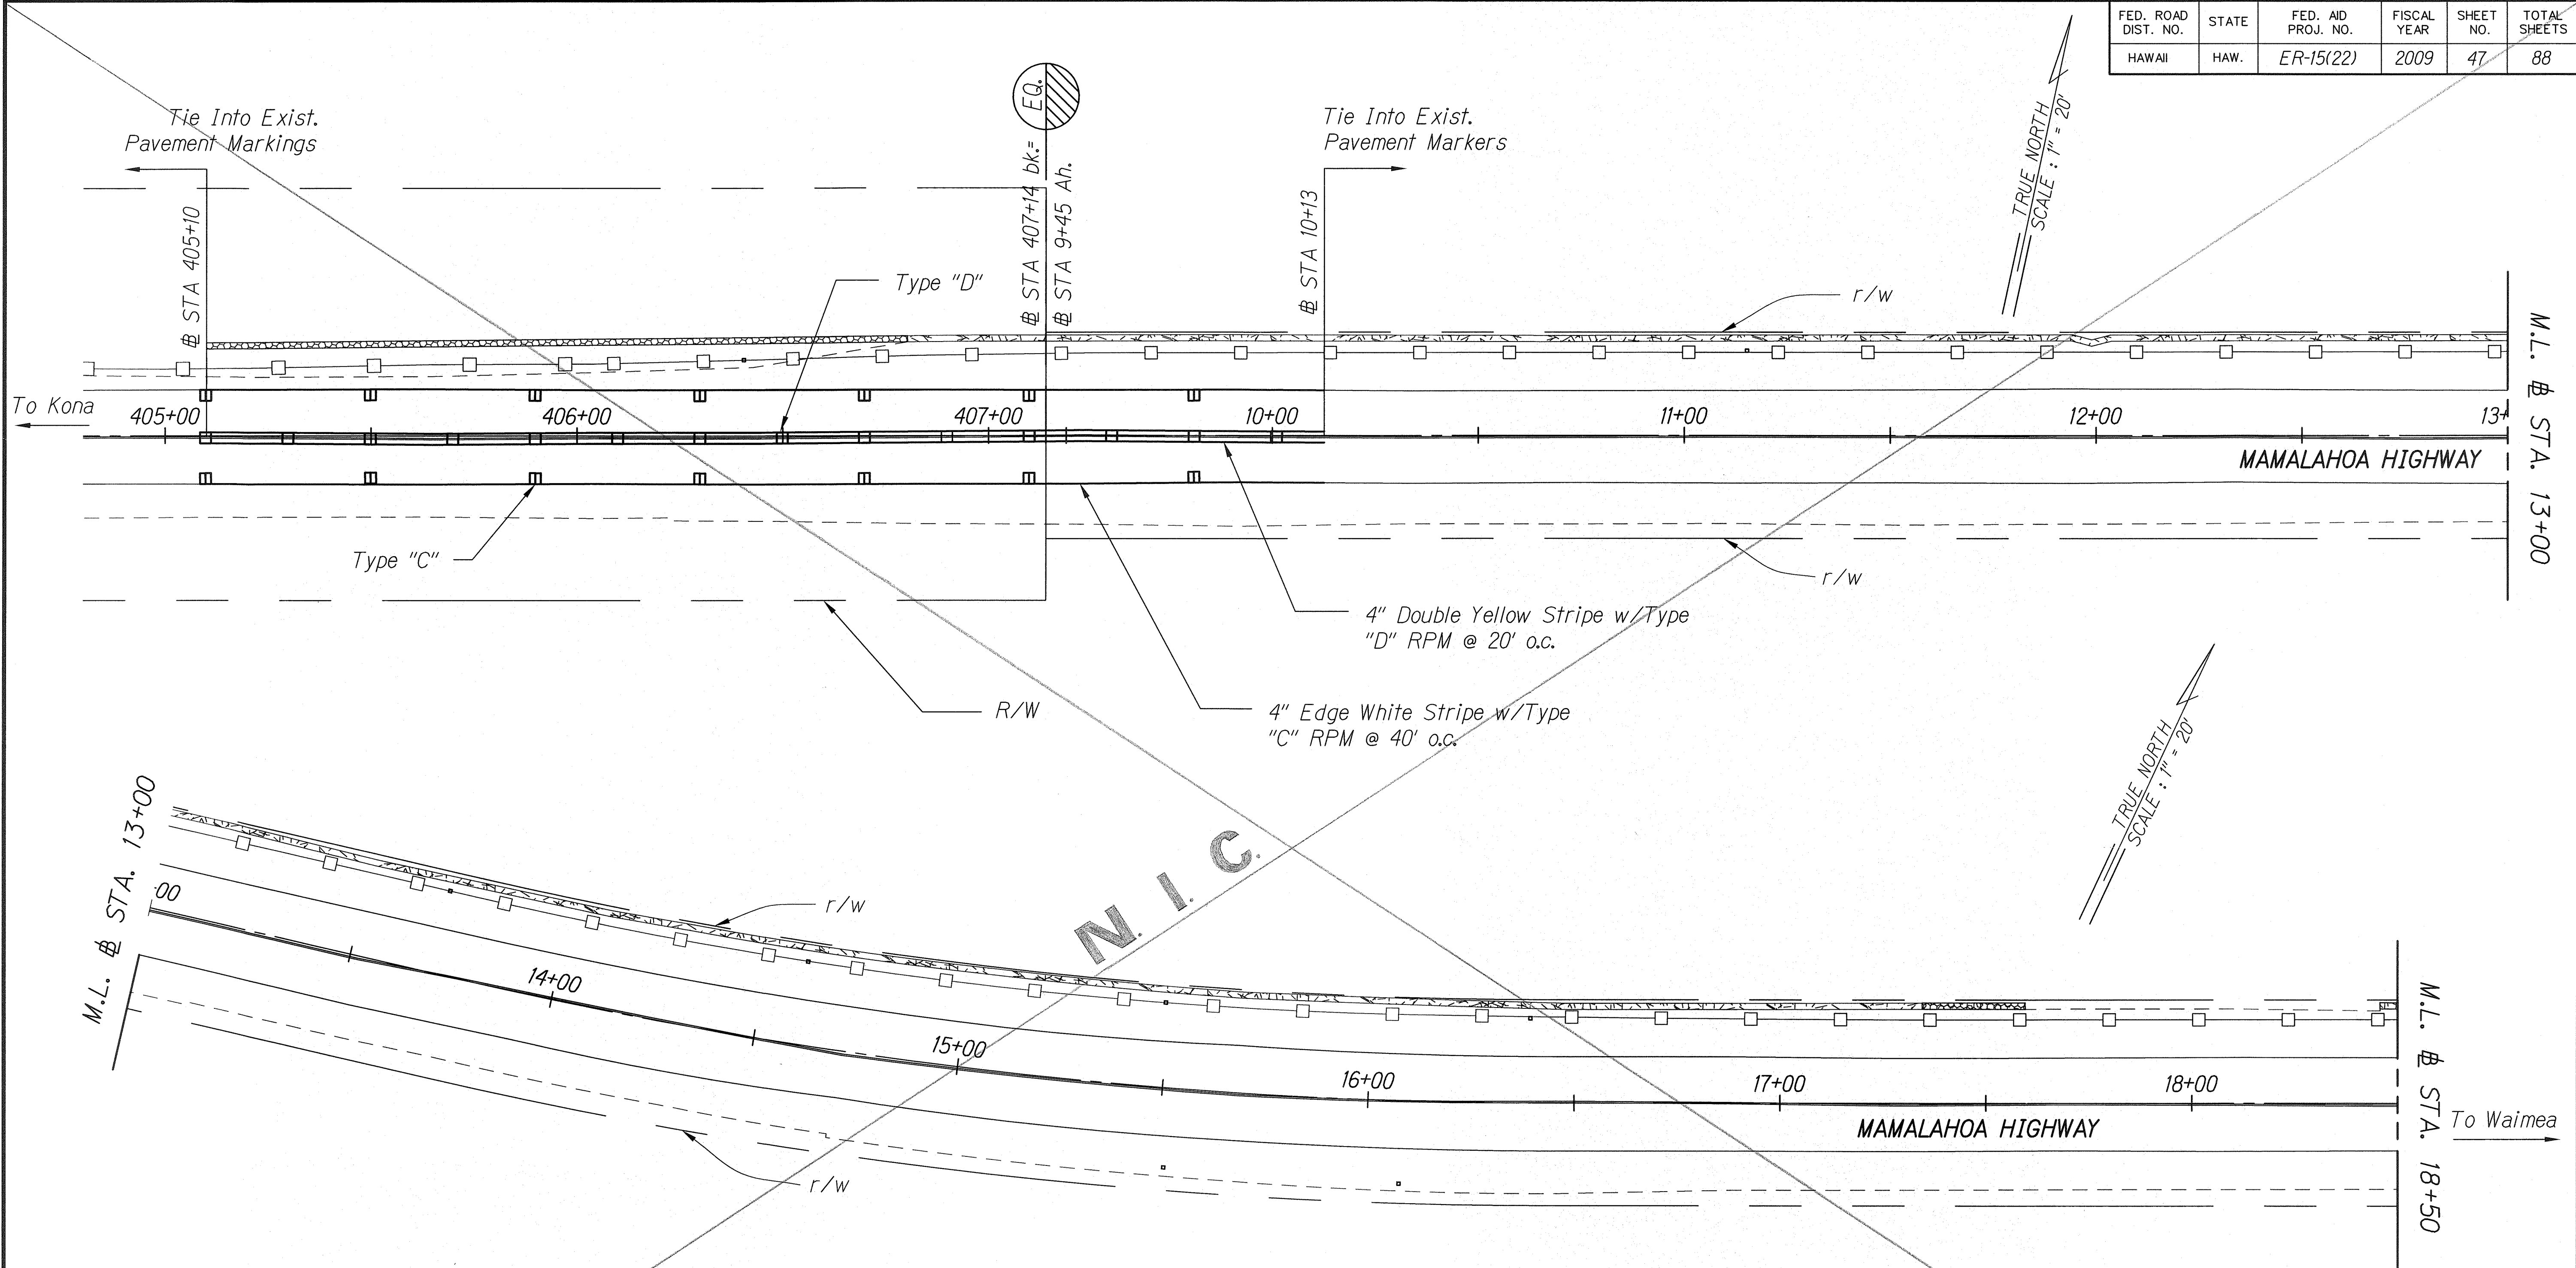

PLAN - MP 27.7 TO 28.7
Scale: 1"=20'



ORIGINAL PLAN	SURVEY PLOTTED BY	DATE
TRACED BY	DRAWN BY	
NOTE BOOK	DESIGNED BY	
	CHECKED BY	

NEAL S. FUKUMOTO
LICENSED PROFESSIONAL ENGINEER
No. 6186-C
HAWAII U.S.A.

STATE OF HAWAII
DEPARTMENT OF TRANSPORTATION
HIGHWAYS DIVISION

STRIPING PLAN

SITE 6-MP 27.7 TO MP 28.7

EMERGENCY EARTHQUAKE ROCKFALL REPAIRS
VARIOUS LOCATIONS ON HAWAII, UNIT 4
Federal Aid Project No. ER-15(22)

Scale: As Shown Date: Dec. 2009


SHEET No. 6.5 OF 6.7 SHEETS

This work was prepared by me or under my supervision.
Exp. 04-30-10


Wesley R. Segawa & Associates, Inc.

"AS-BUILT"

FED. ROAD DIST. NO.	STATE	FED. AID PROJ. NO.	FISCAL YEAR	SHEET NO.	TOTAL SHEETS
HAWAII	HAW.	ER-15(22)	2009	48	88

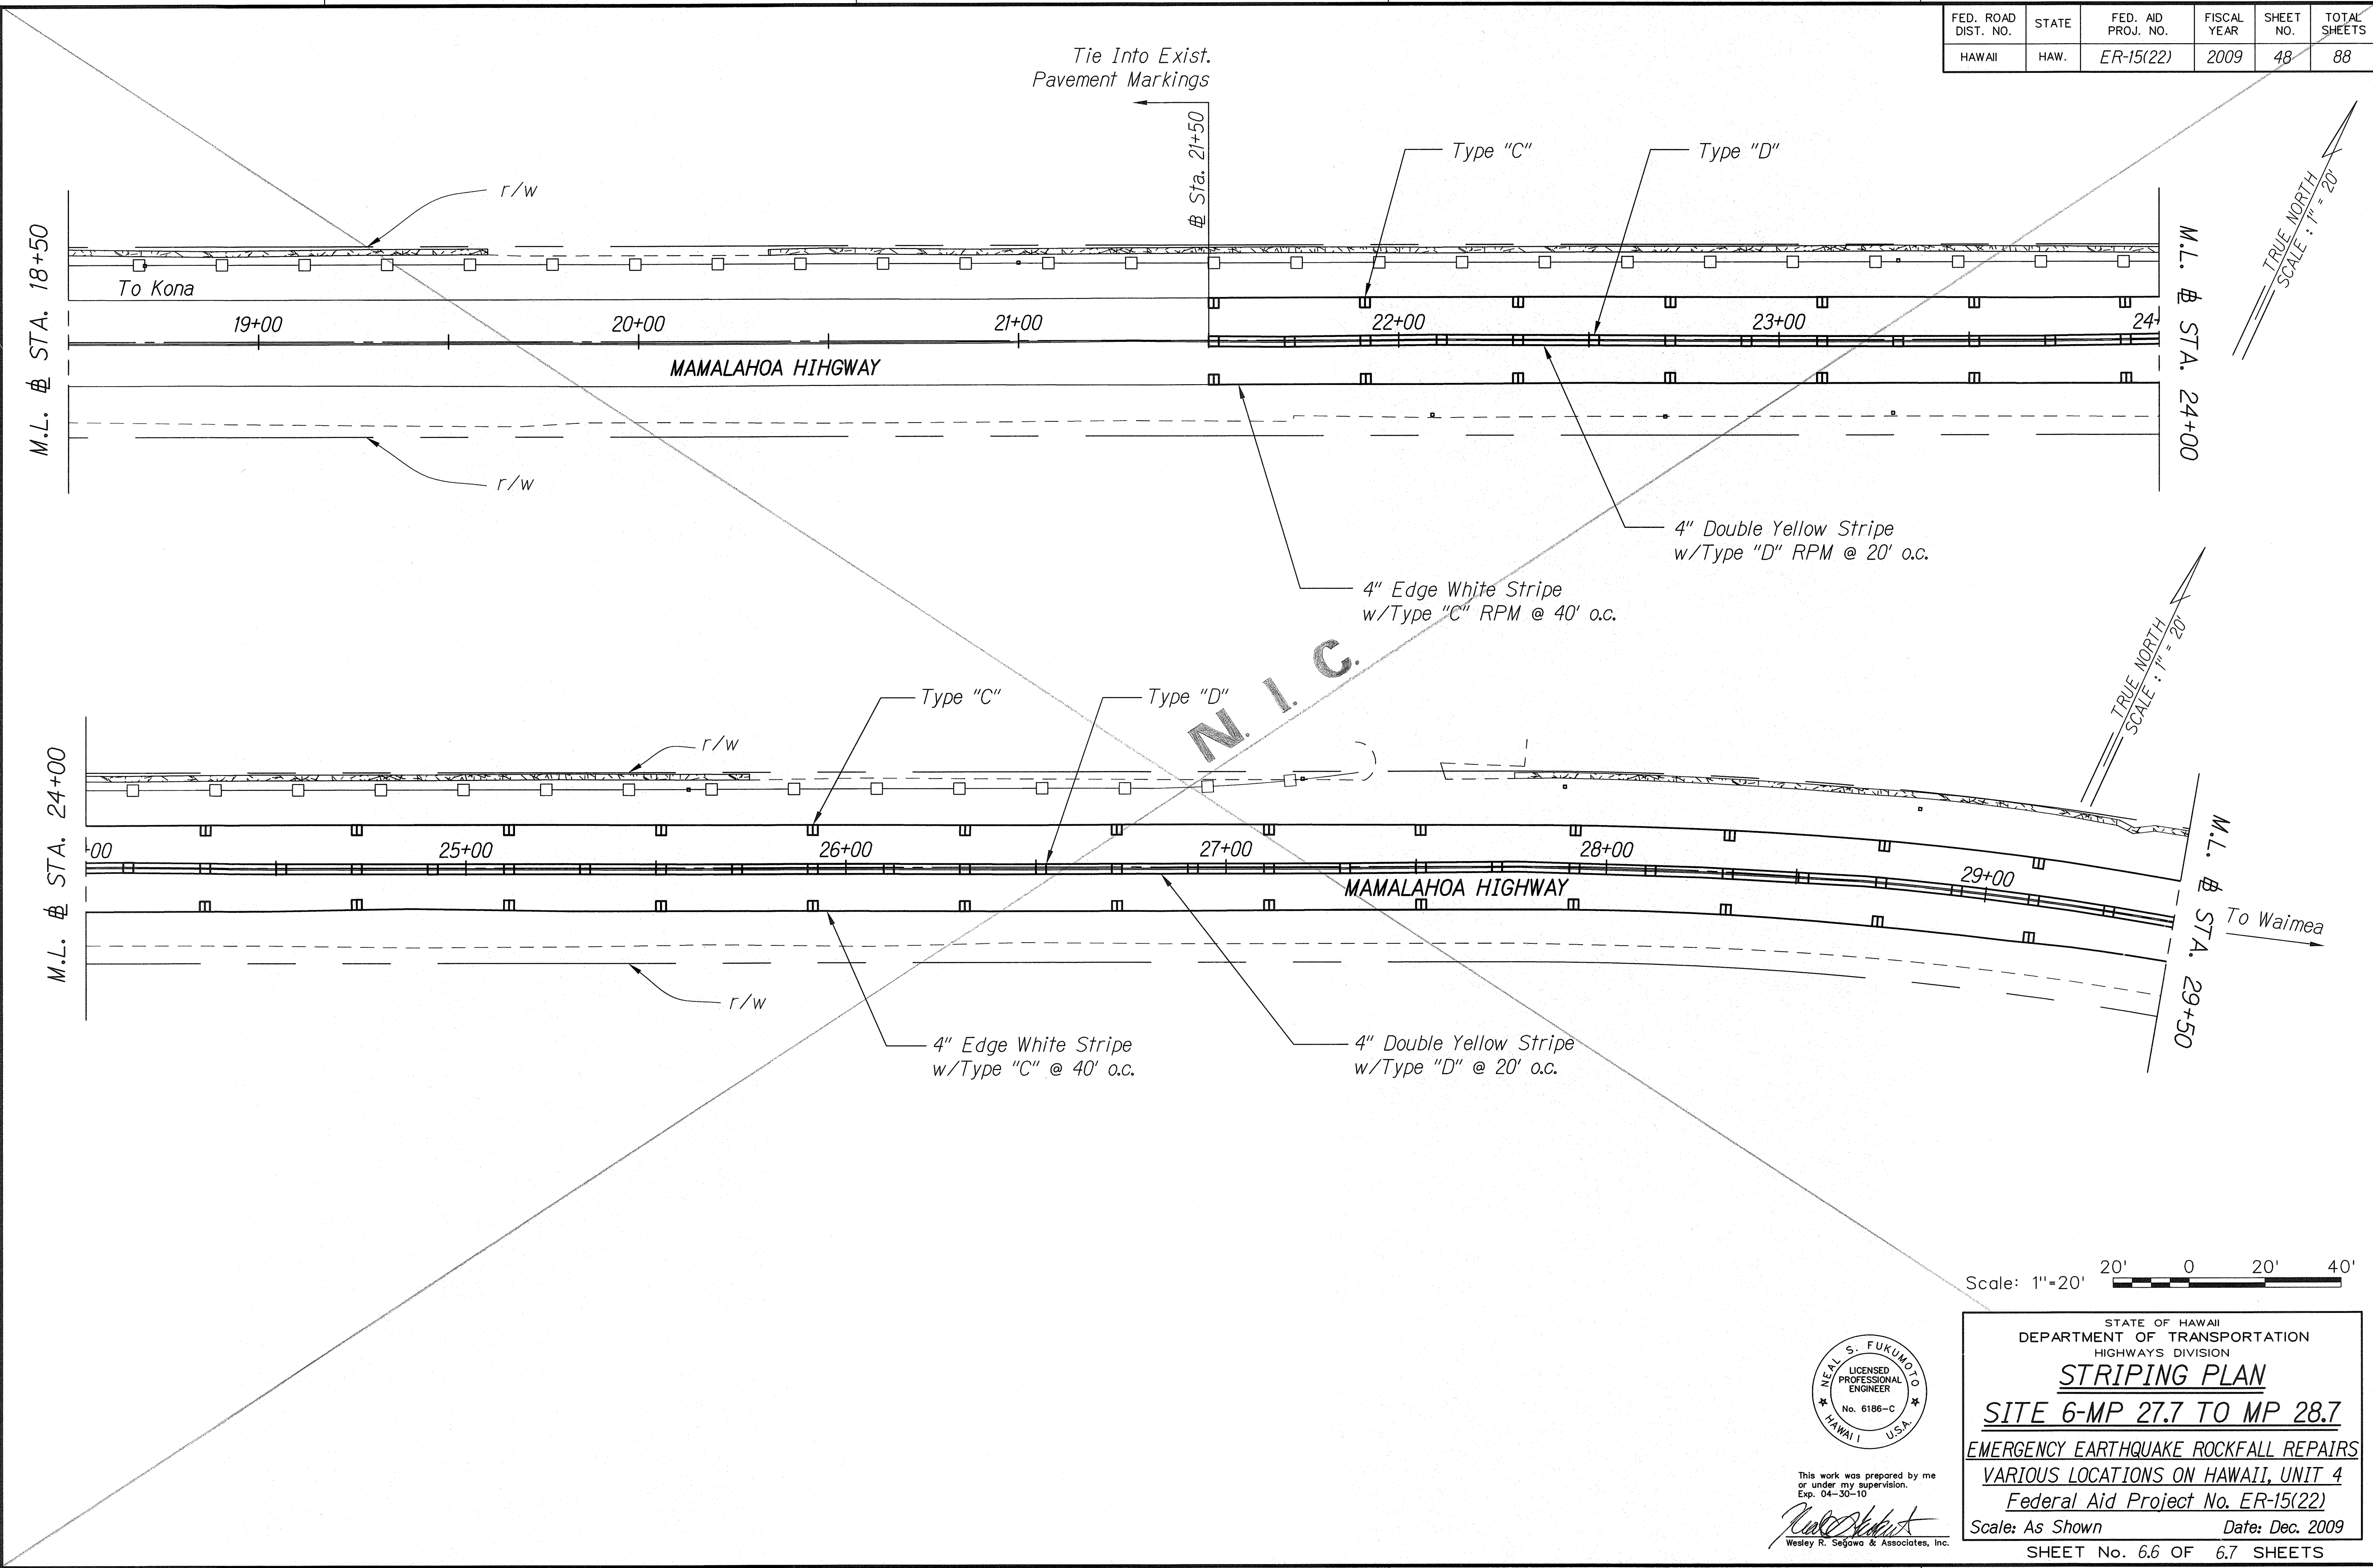


SURVEY PLOTTED BY	DATE
DRAWN BY	
TRACED BY	
NOTED BY	
CHECKED BY	
DATE	

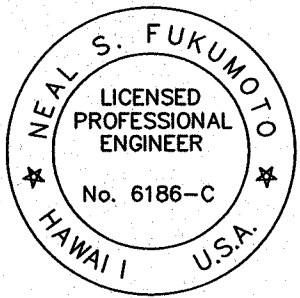

This work was prepared by me or under my supervision.
Exp. 04-30-10
Wesley R. Segawa
Wesley R. Segawa & Associates, Inc.


STATE OF HAWAII
DEPARTMENT OF TRANSPORTATION
HIGHWAYS DIVISION
STRIPING PLAN
SITE 6-MP 27.7 TO MP 28.7
EMERGENCY EARTHQUAKE ROCKFALL REPAIRS
VARIOUS LOCATIONS ON HAWAII, UNIT 4
Federal Aid Project No. ER-15(22)
Scale: As Shown Date: Dec. 2009
SHEET No. 6.6 OF 6.7 SHEETS

FED. ROAD DIST. NO.	STATE	FED. AID PROJ. NO.	FISCAL YEAR	SHEET NO.	TOTAL SHEETS
HAWAII	HAW.	ER-15(22)	2009	49	88

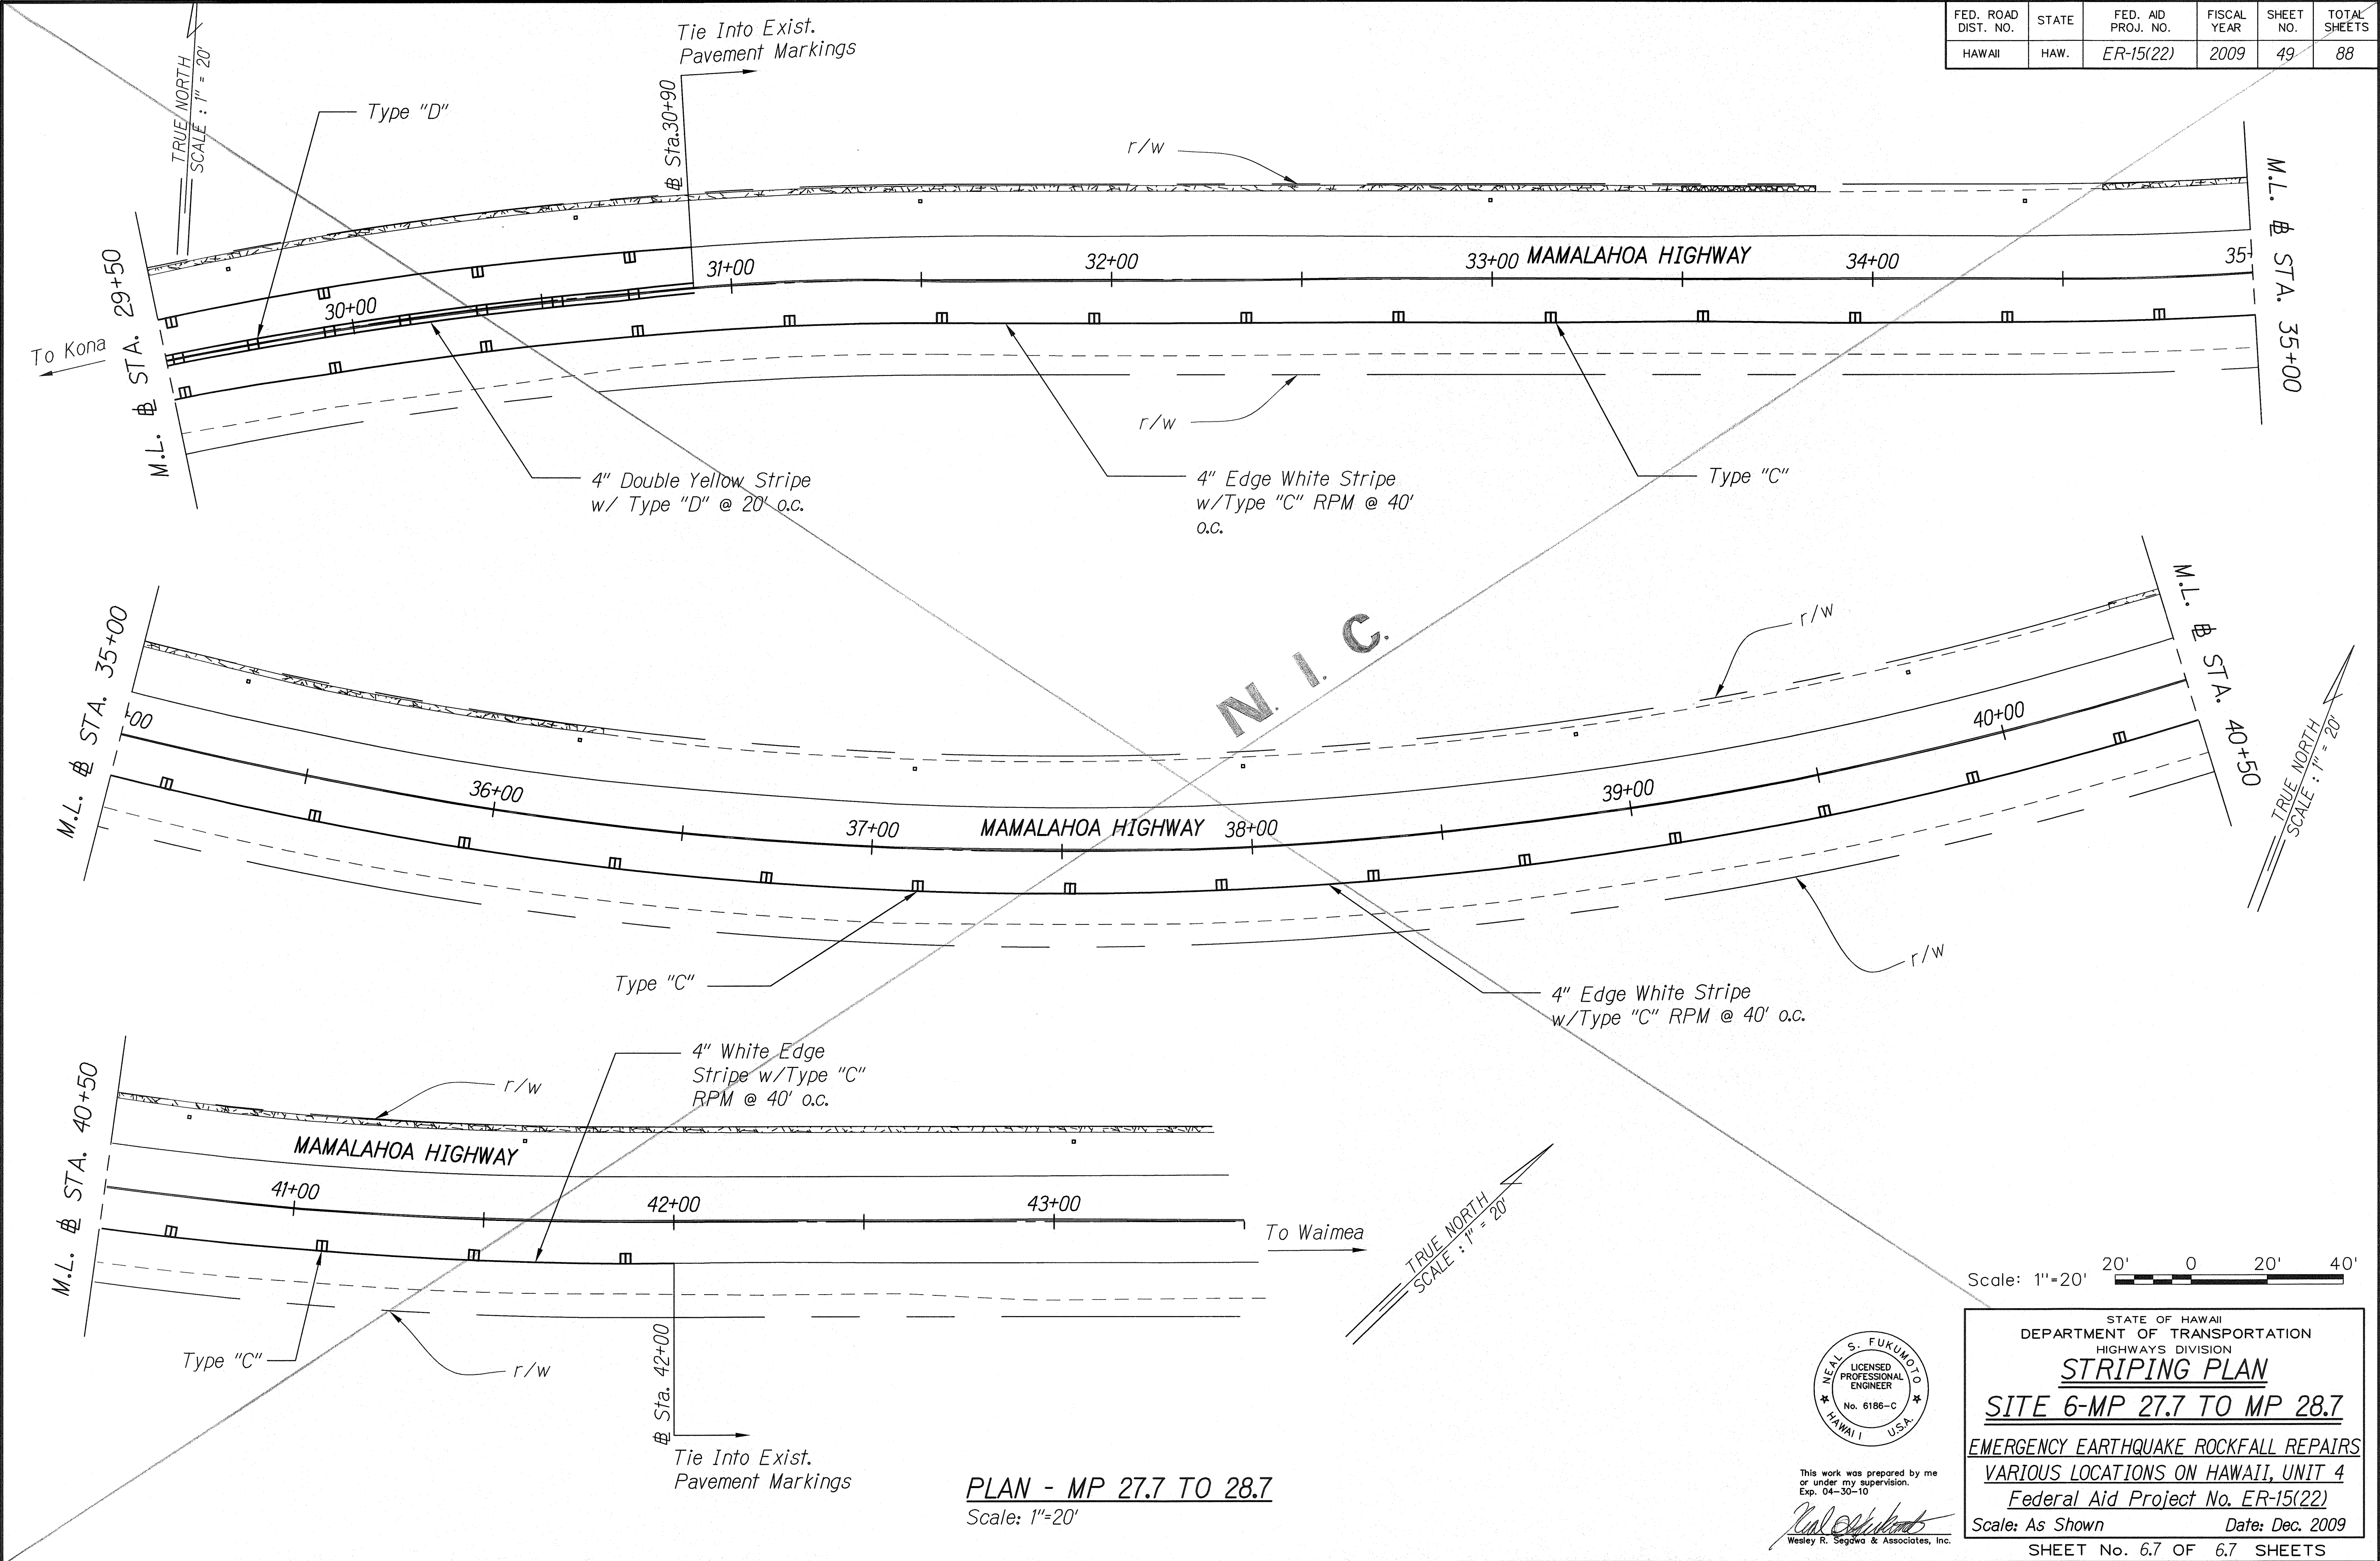

SURVEY PLOTTED BY	DATE
DRAWN BY	
TRACED BY	
NOTE BOOK	
QUANTITIES BY	
CHECKED BY	
N _o	

PLAN - MP 27.7 TO 28.7
Scale: 1"=20'

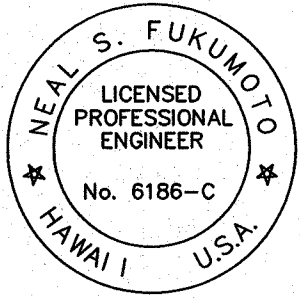

This work was prepared by me or under my supervision.
Exp. 04-30-10
Neal S. Fukumoto
Wesley R. Segawa & Associates, Inc.



STATE OF HAWAII
DEPARTMENT OF TRANSPORTATION
HIGHWAYS DIVISION
STRIPING PLAN
SITE 6-MP 27.7 TO MP 28.7
EMERGENCY EARTHQUAKE ROCKFALL REPAIRS
VARIOUS LOCATIONS ON HAWAII, UNIT 4
Federal Aid Project No. ER-15(22)
Scale: As Shown Date: Dec. 2009
SHEET No. 6.7 OF 6.7 SHEETS

"AS-BUILT"