



FED. ROAD DIST. NO.	STATE	FED. AID PROJ. NO.	FISCAL YEAR	SHEET NO.	TOTAL SHEETS
HAWAII	HAW.	ER-15(22)	2009	50	88

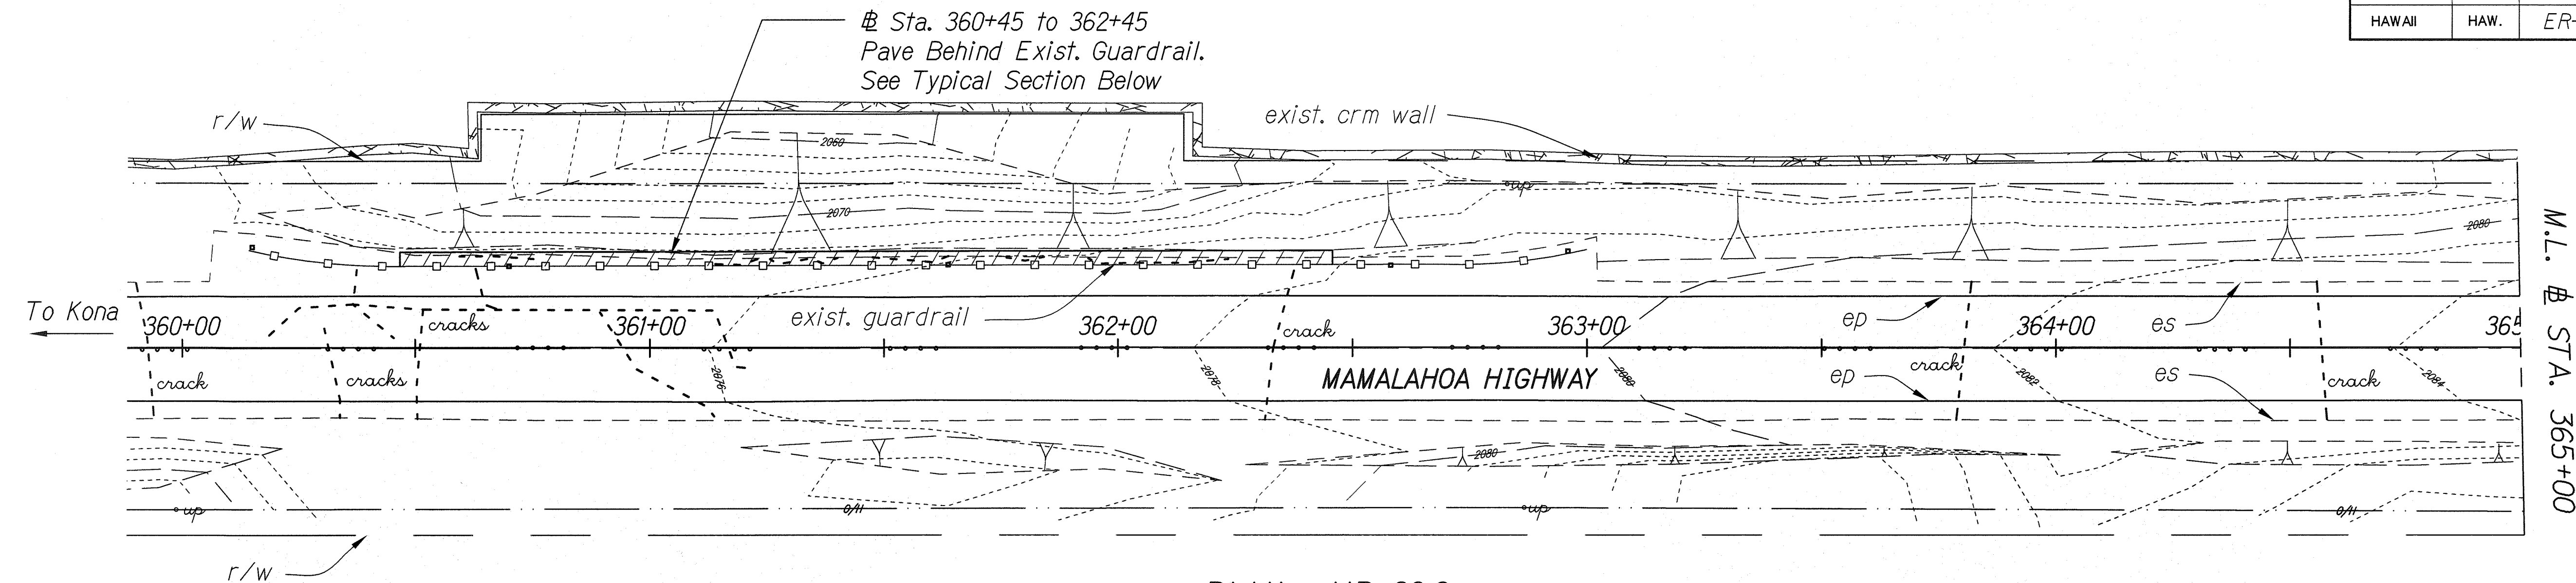


PLAN - MP 29.3
Scale: 1"=20'

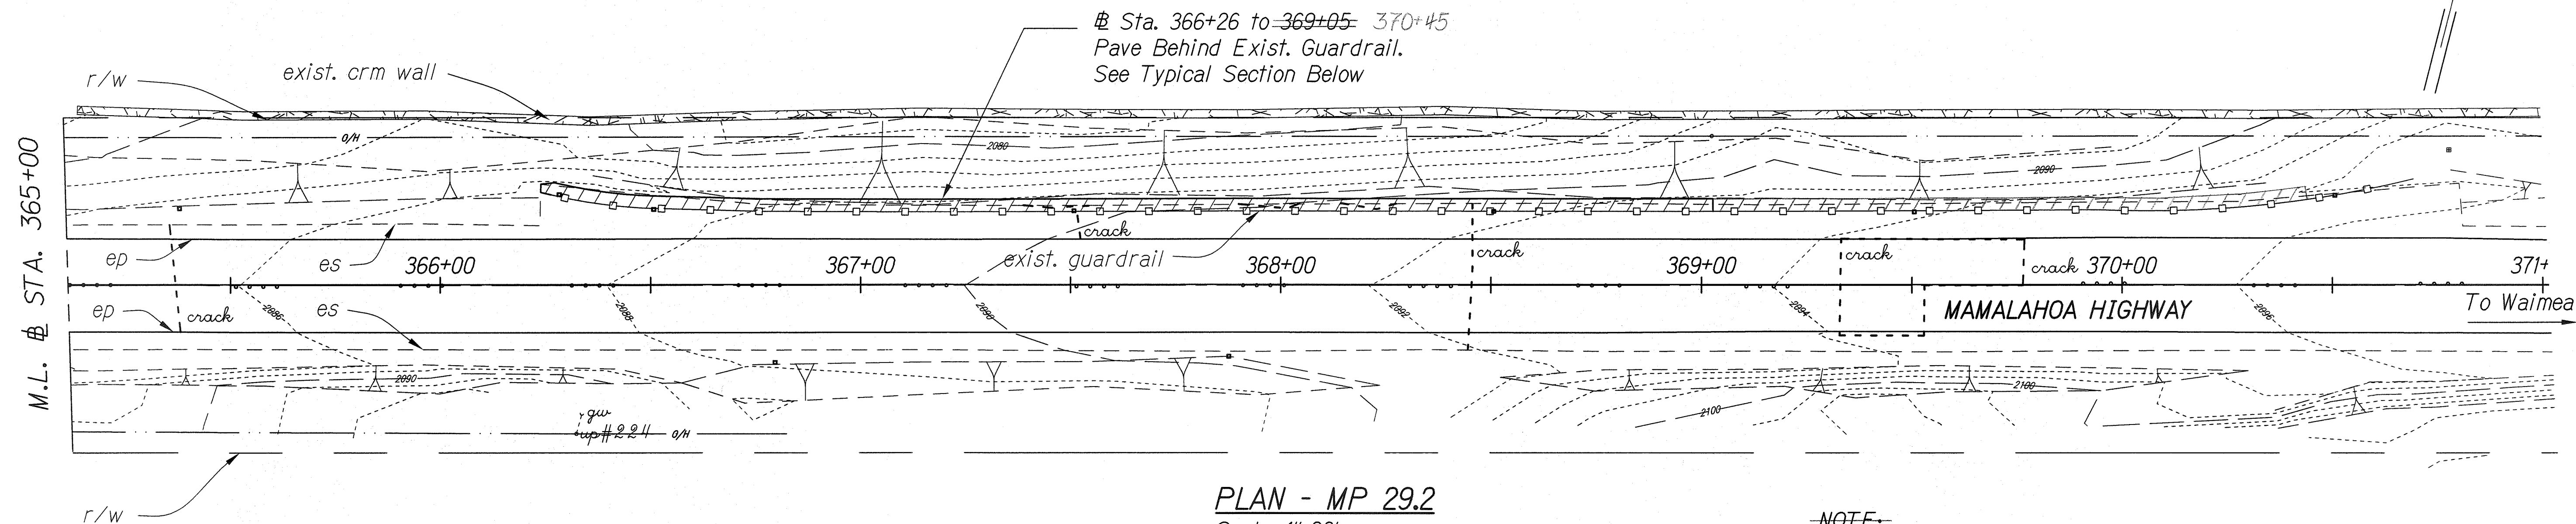

PLAN - MP 29.2
Scale: 1"=20'


NOTE:

Seal All Existing Cracks in Pavement Labeled "crack", Except Where Pavement is Noted to be Reconstructed.

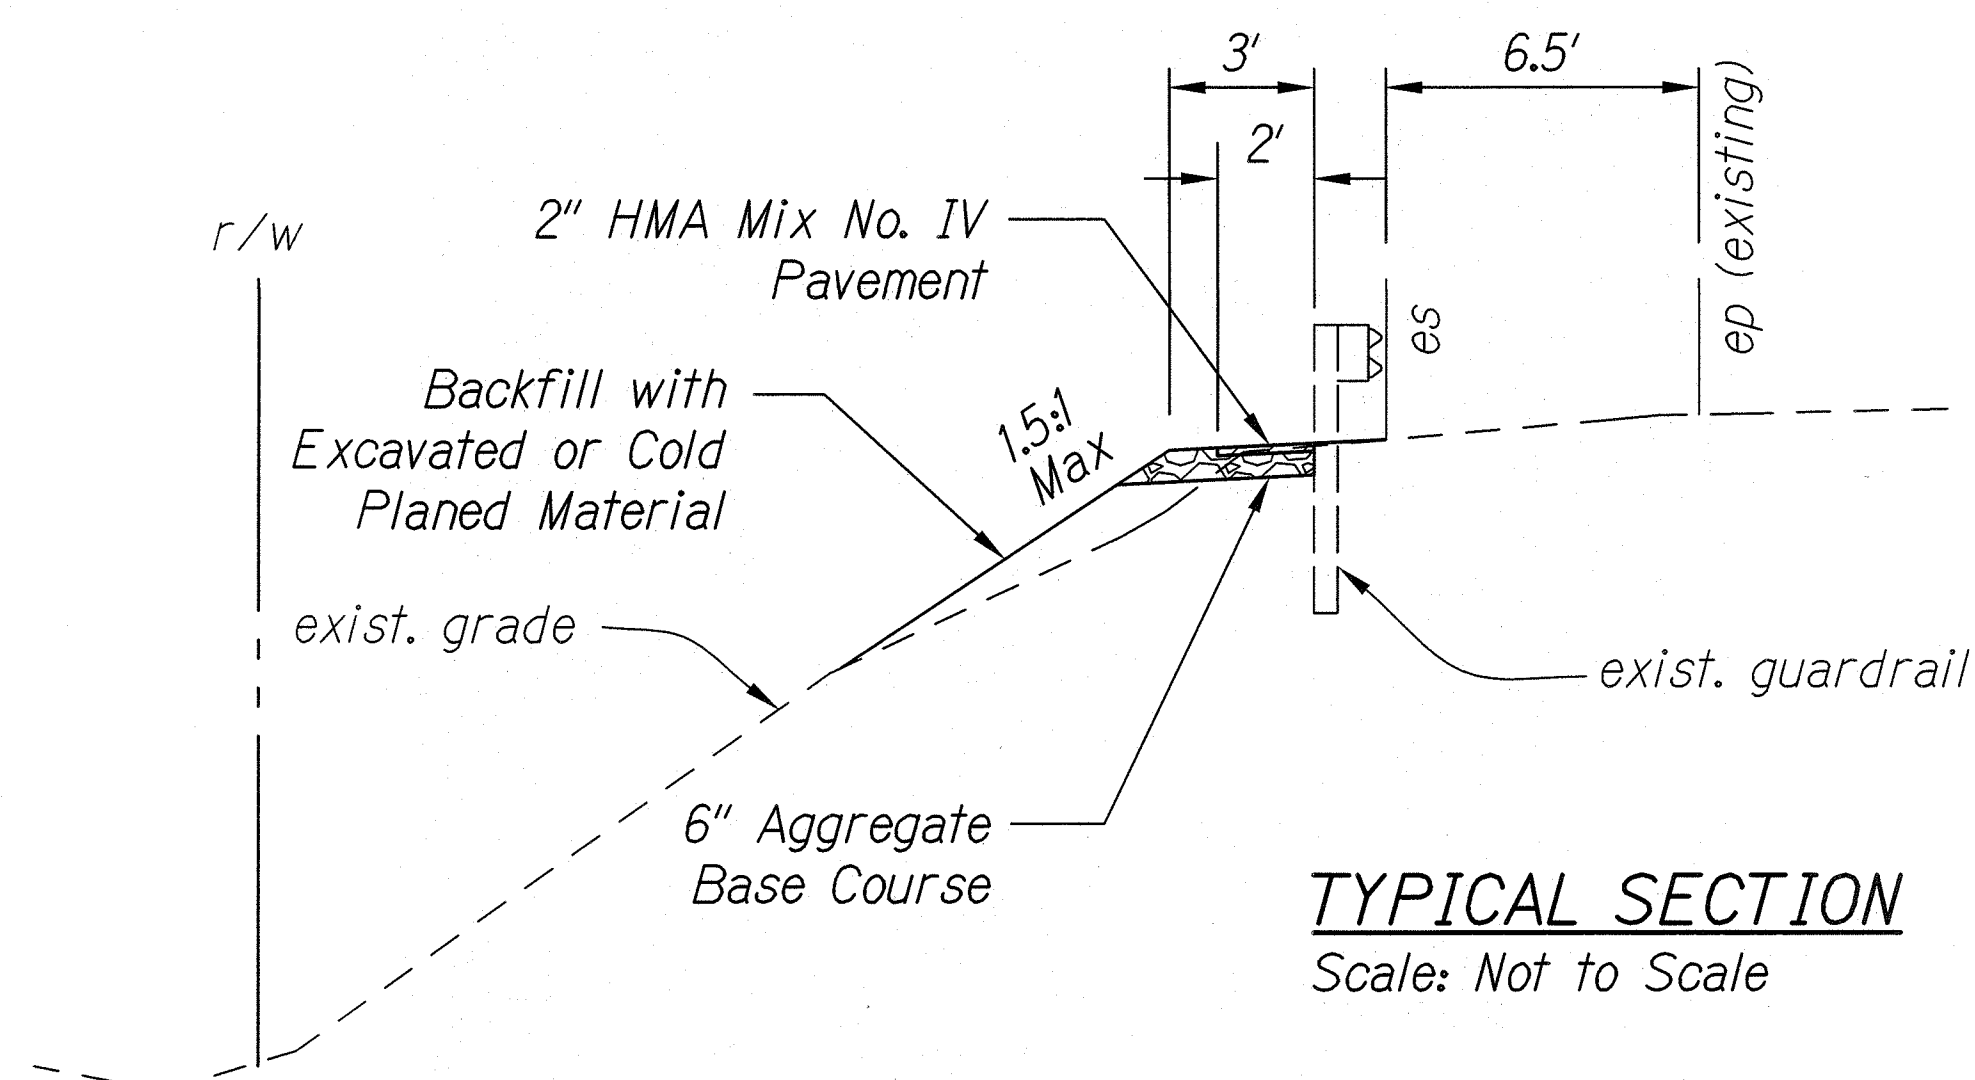

TYPICAL SECTION
Scale: Not to Scale

SURVEY PLOTTED BY	DATE
DRAWN BY	
DESIGNED BY	
CHECKED BY	
NOTED BY	
DATE	

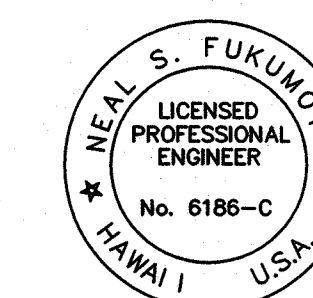

This work was prepared by me or under my supervision.
Exp. 04-30-10
Wesley R. Segawa & Associates, Inc.

STATE OF HAWAII
DEPARTMENT OF TRANSPORTATION
HIGHWAYS DIVISION
SITE PLAN
SITE 7 - MP 29.2
EMERGENCY EARTHQUAKE ROCKFALL REPAIRS
VARIOUS LOCATIONS ON HAWAII, UNIT 4
Federal Aid Project No. ER-15(22)
Scale: As Shown Date: December 2009
SHEET No. 71 OF 71 SHEETS

"AS-BUILT"