

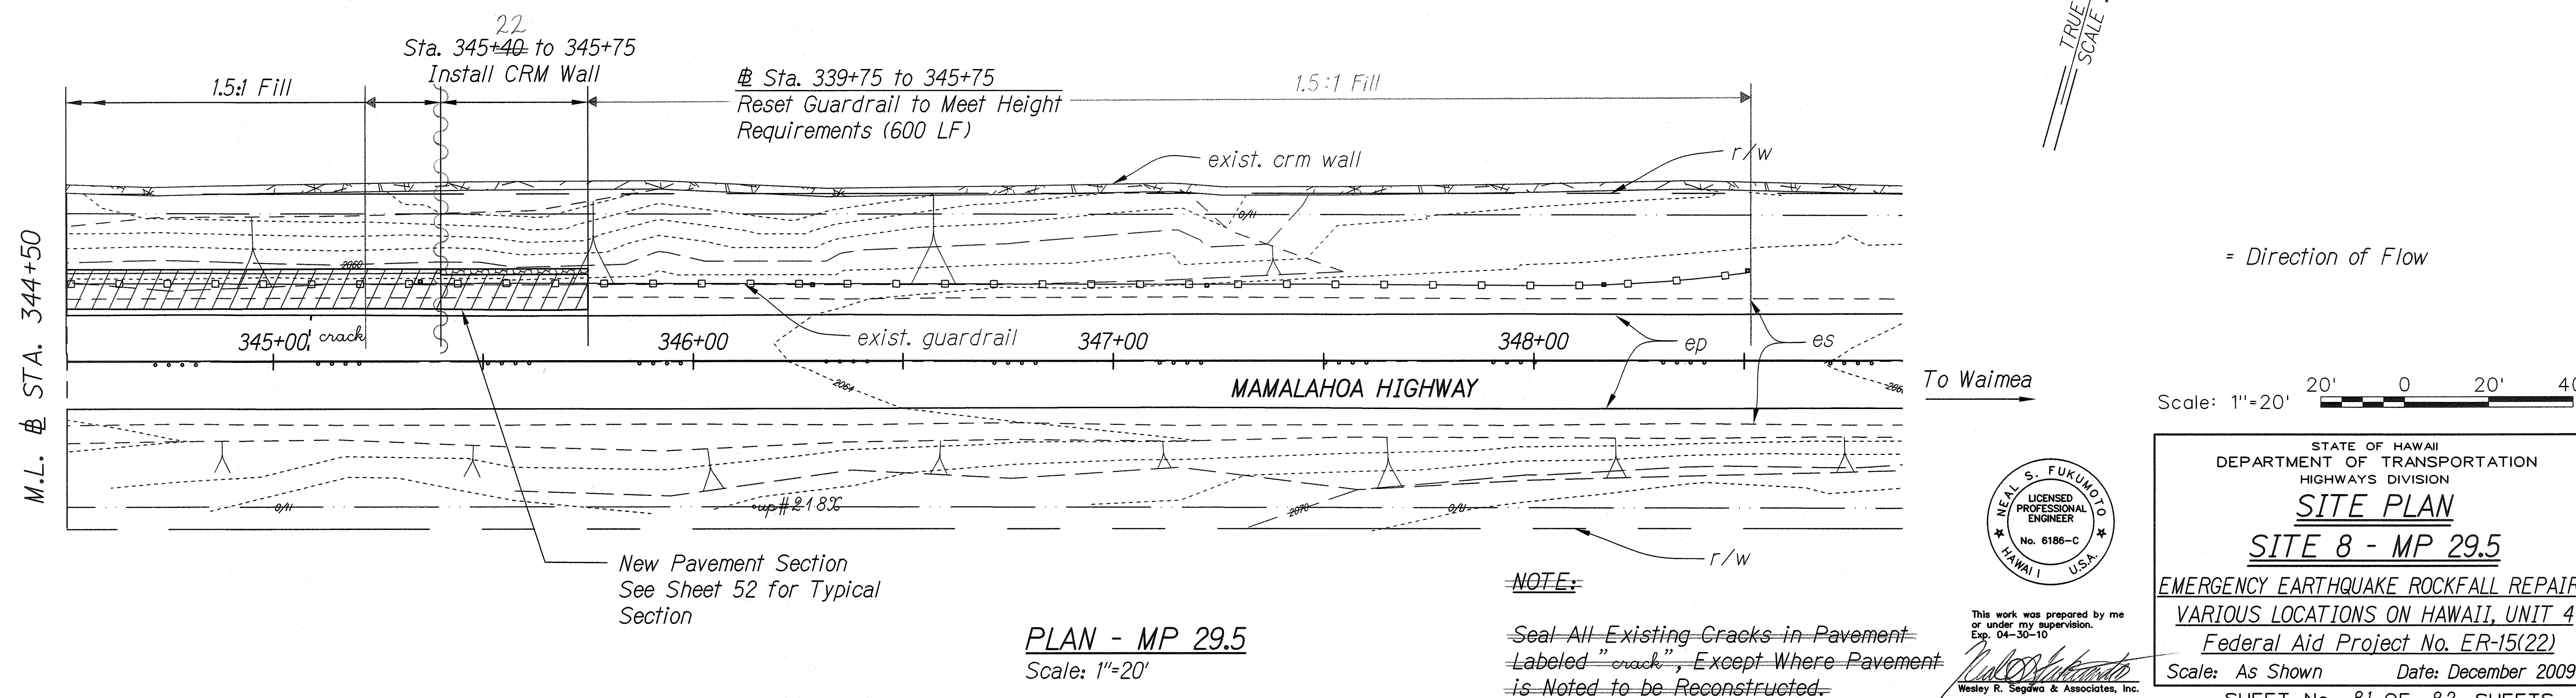


FED. ROAD DIST. NO.	STATE	FED. AID PROJ. NO.	FISCAL YEAR	SHEET NO.	TOTAL SHEETS
HAWAII	HAW.	ER-15(22)	2009	51	88

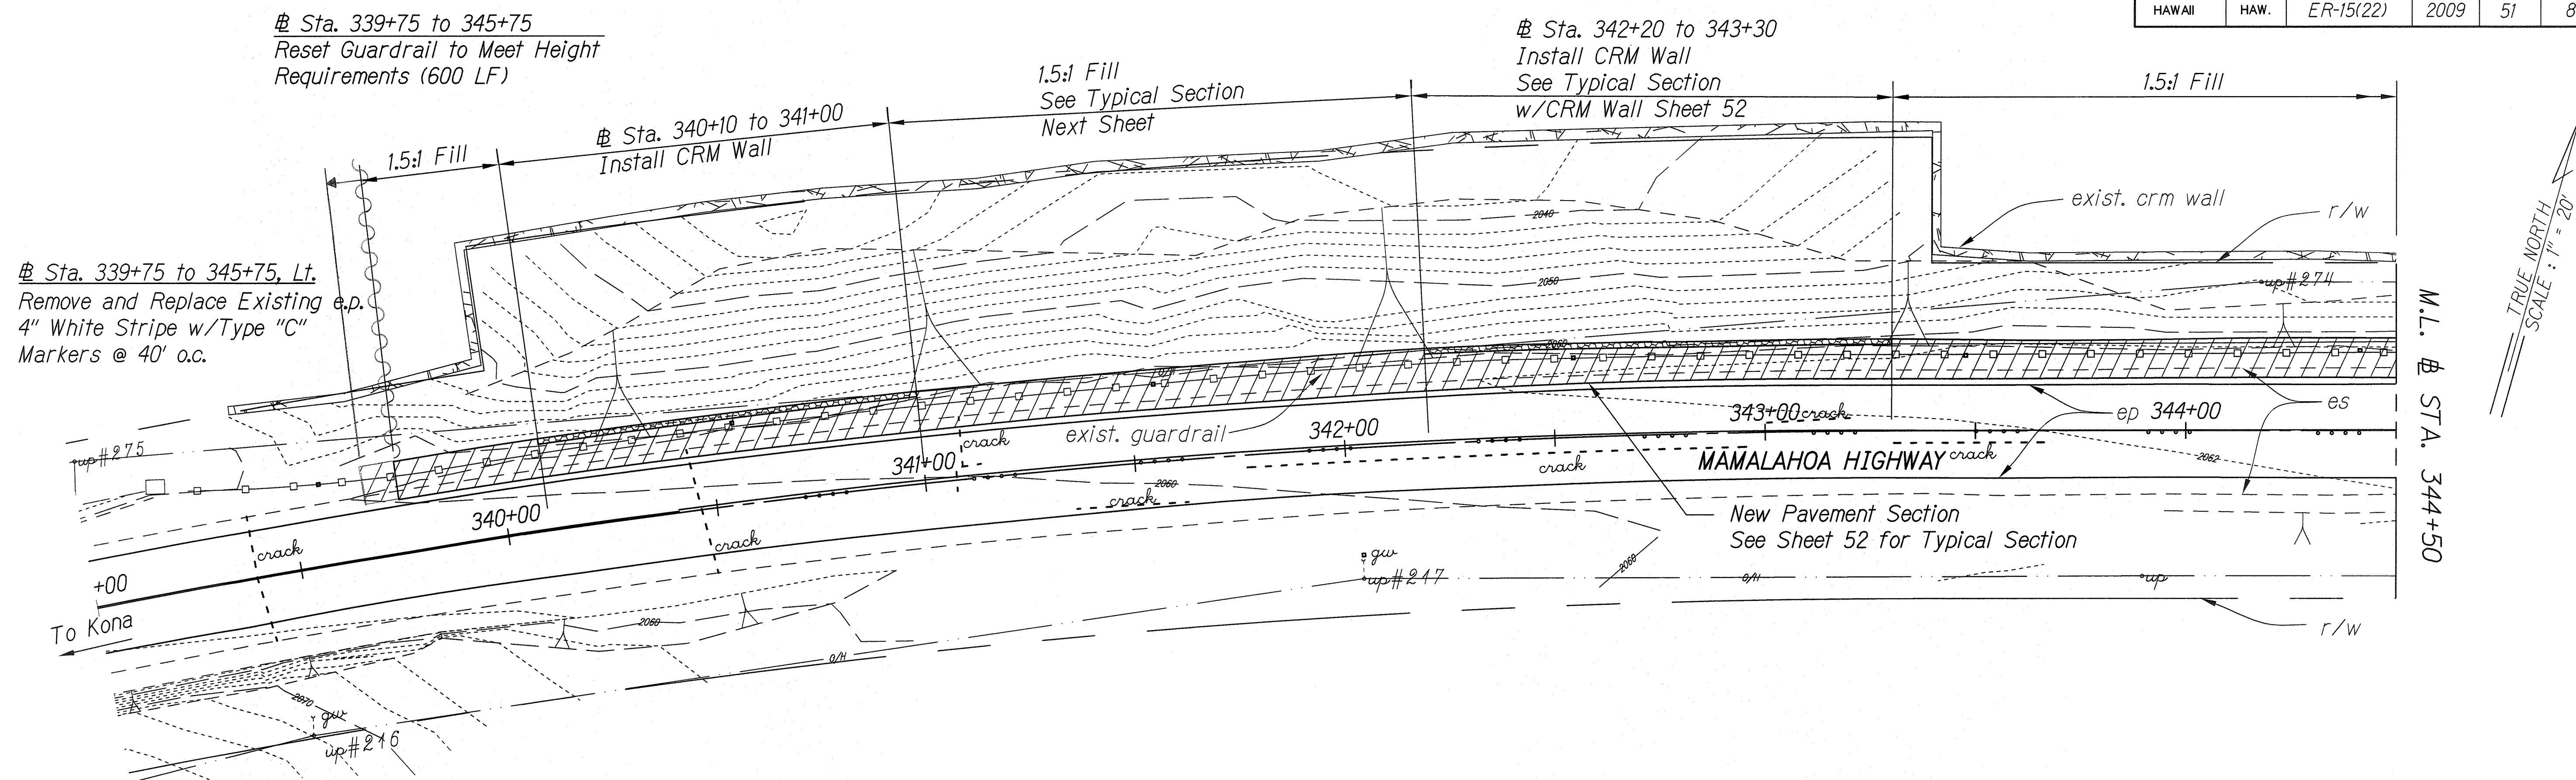


"AS-BUILT"


FED. ROAD DIST. NO.	STATE	FED. AID PROJ. NO.	FISCAL YEAR	SHEET NO.	TOTAL SHEETS
HAWAII	HAW.	ER-15(22)	2009	52	88

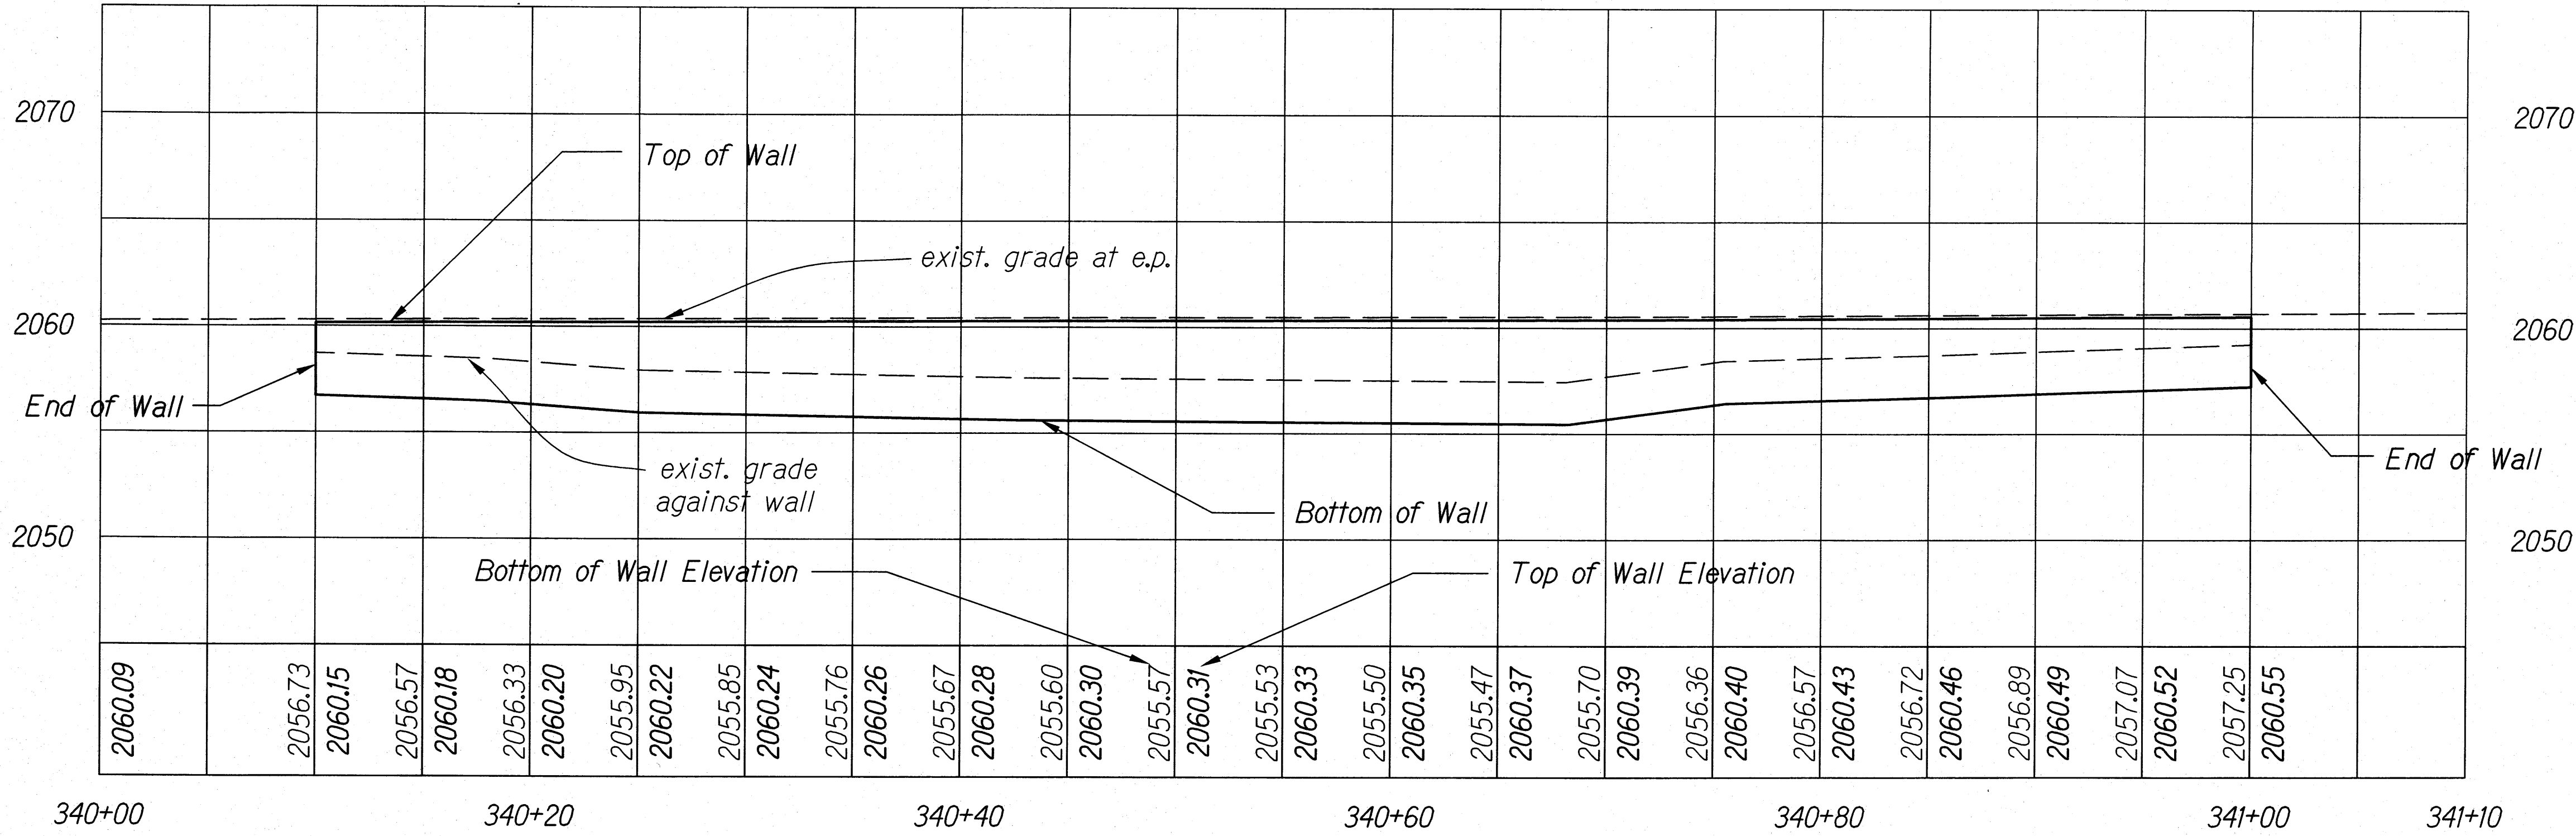

CRM WALL PROFILE - MP 29.5, STA. 340+10 TO 341+00
Scale: 1" = 5'

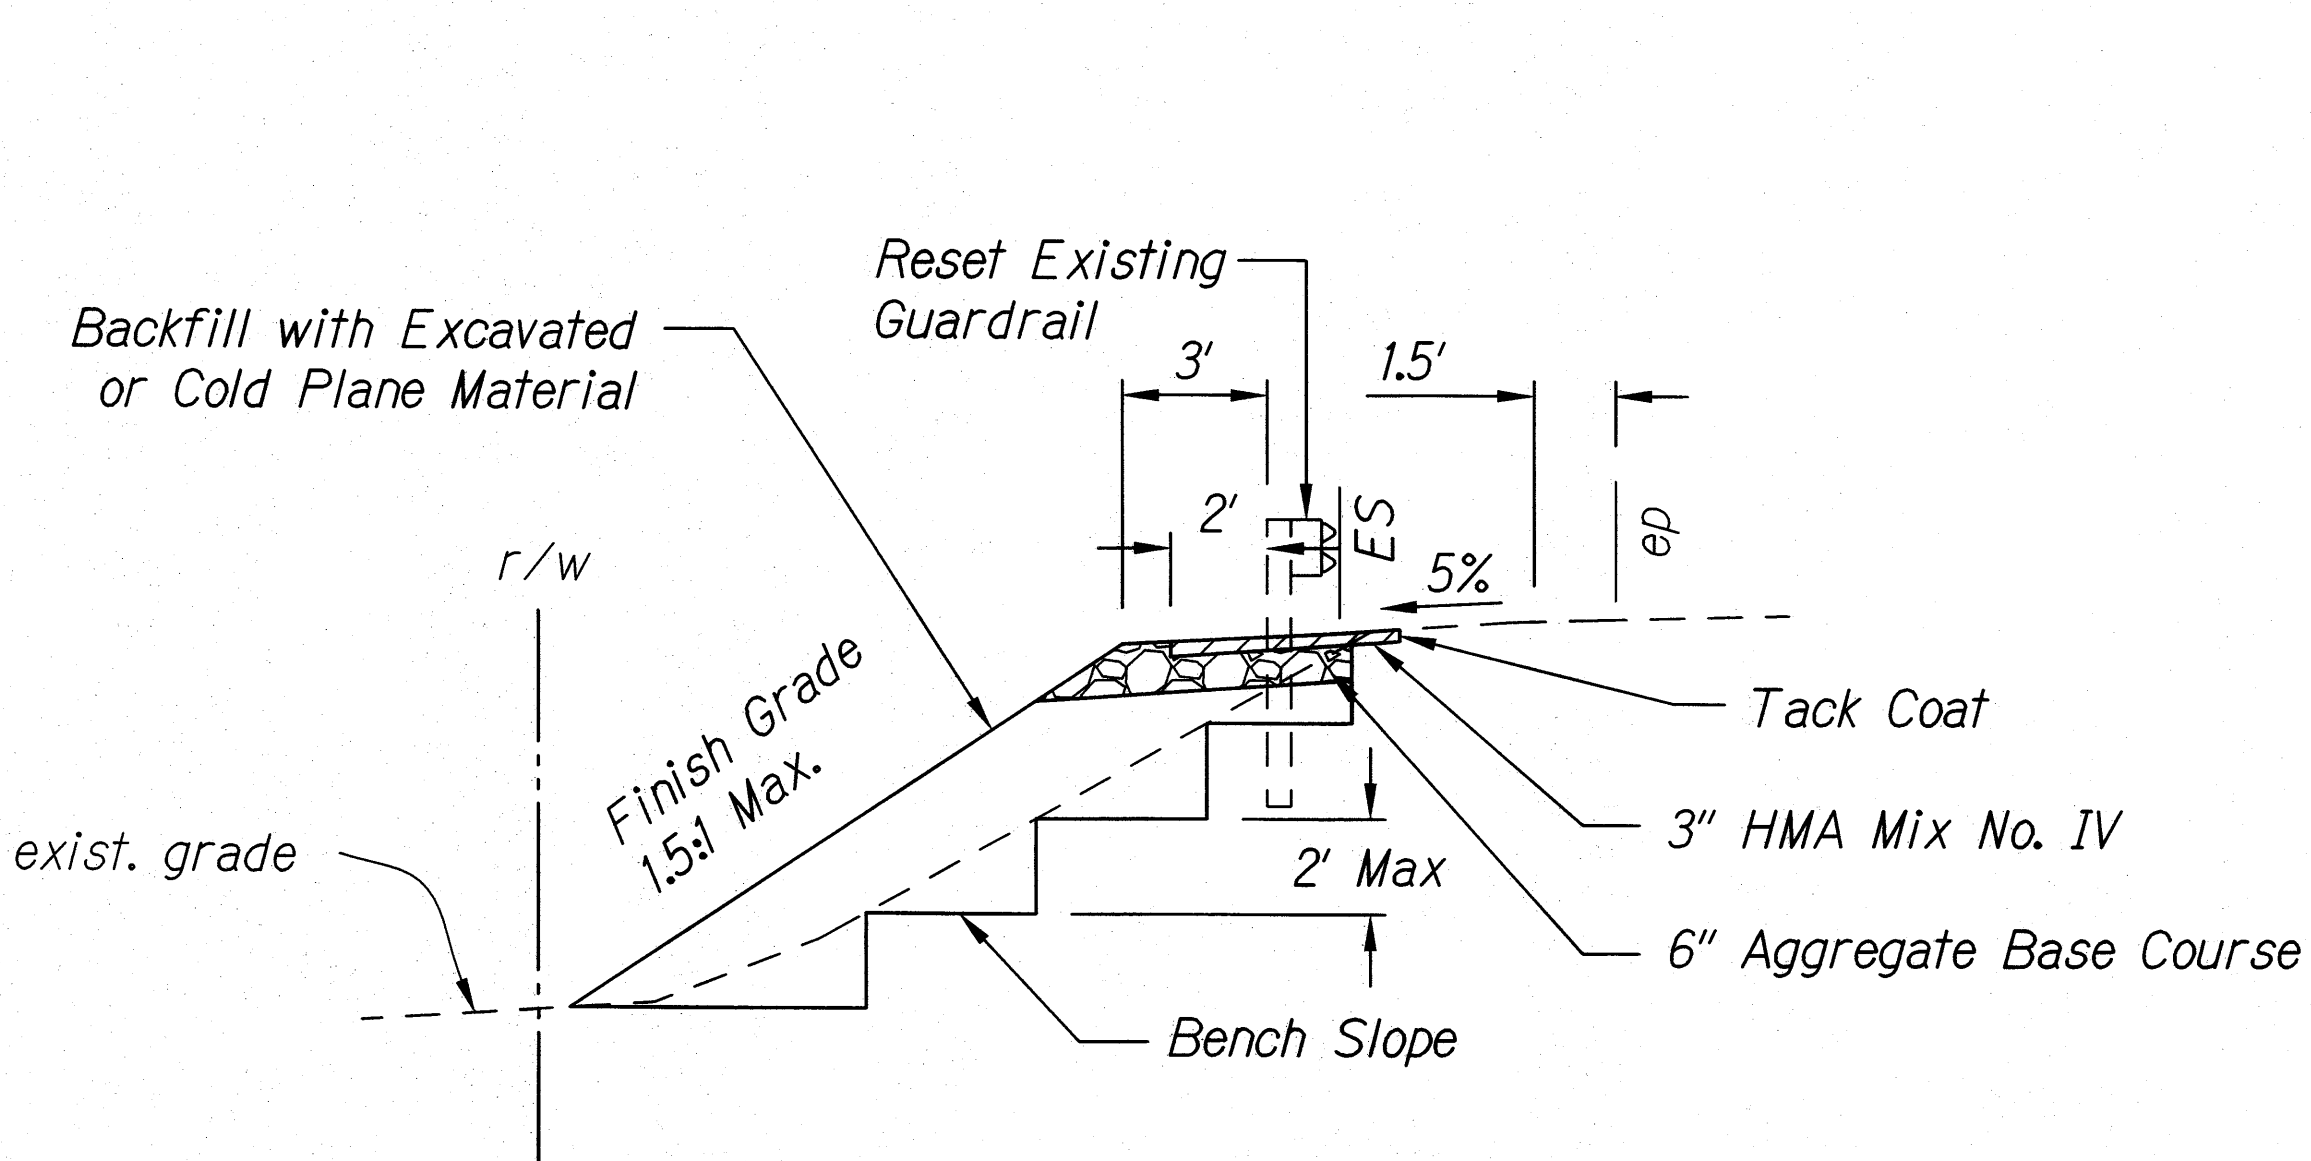


TYPICAL FILL SECTION
Scale: Not to Scale

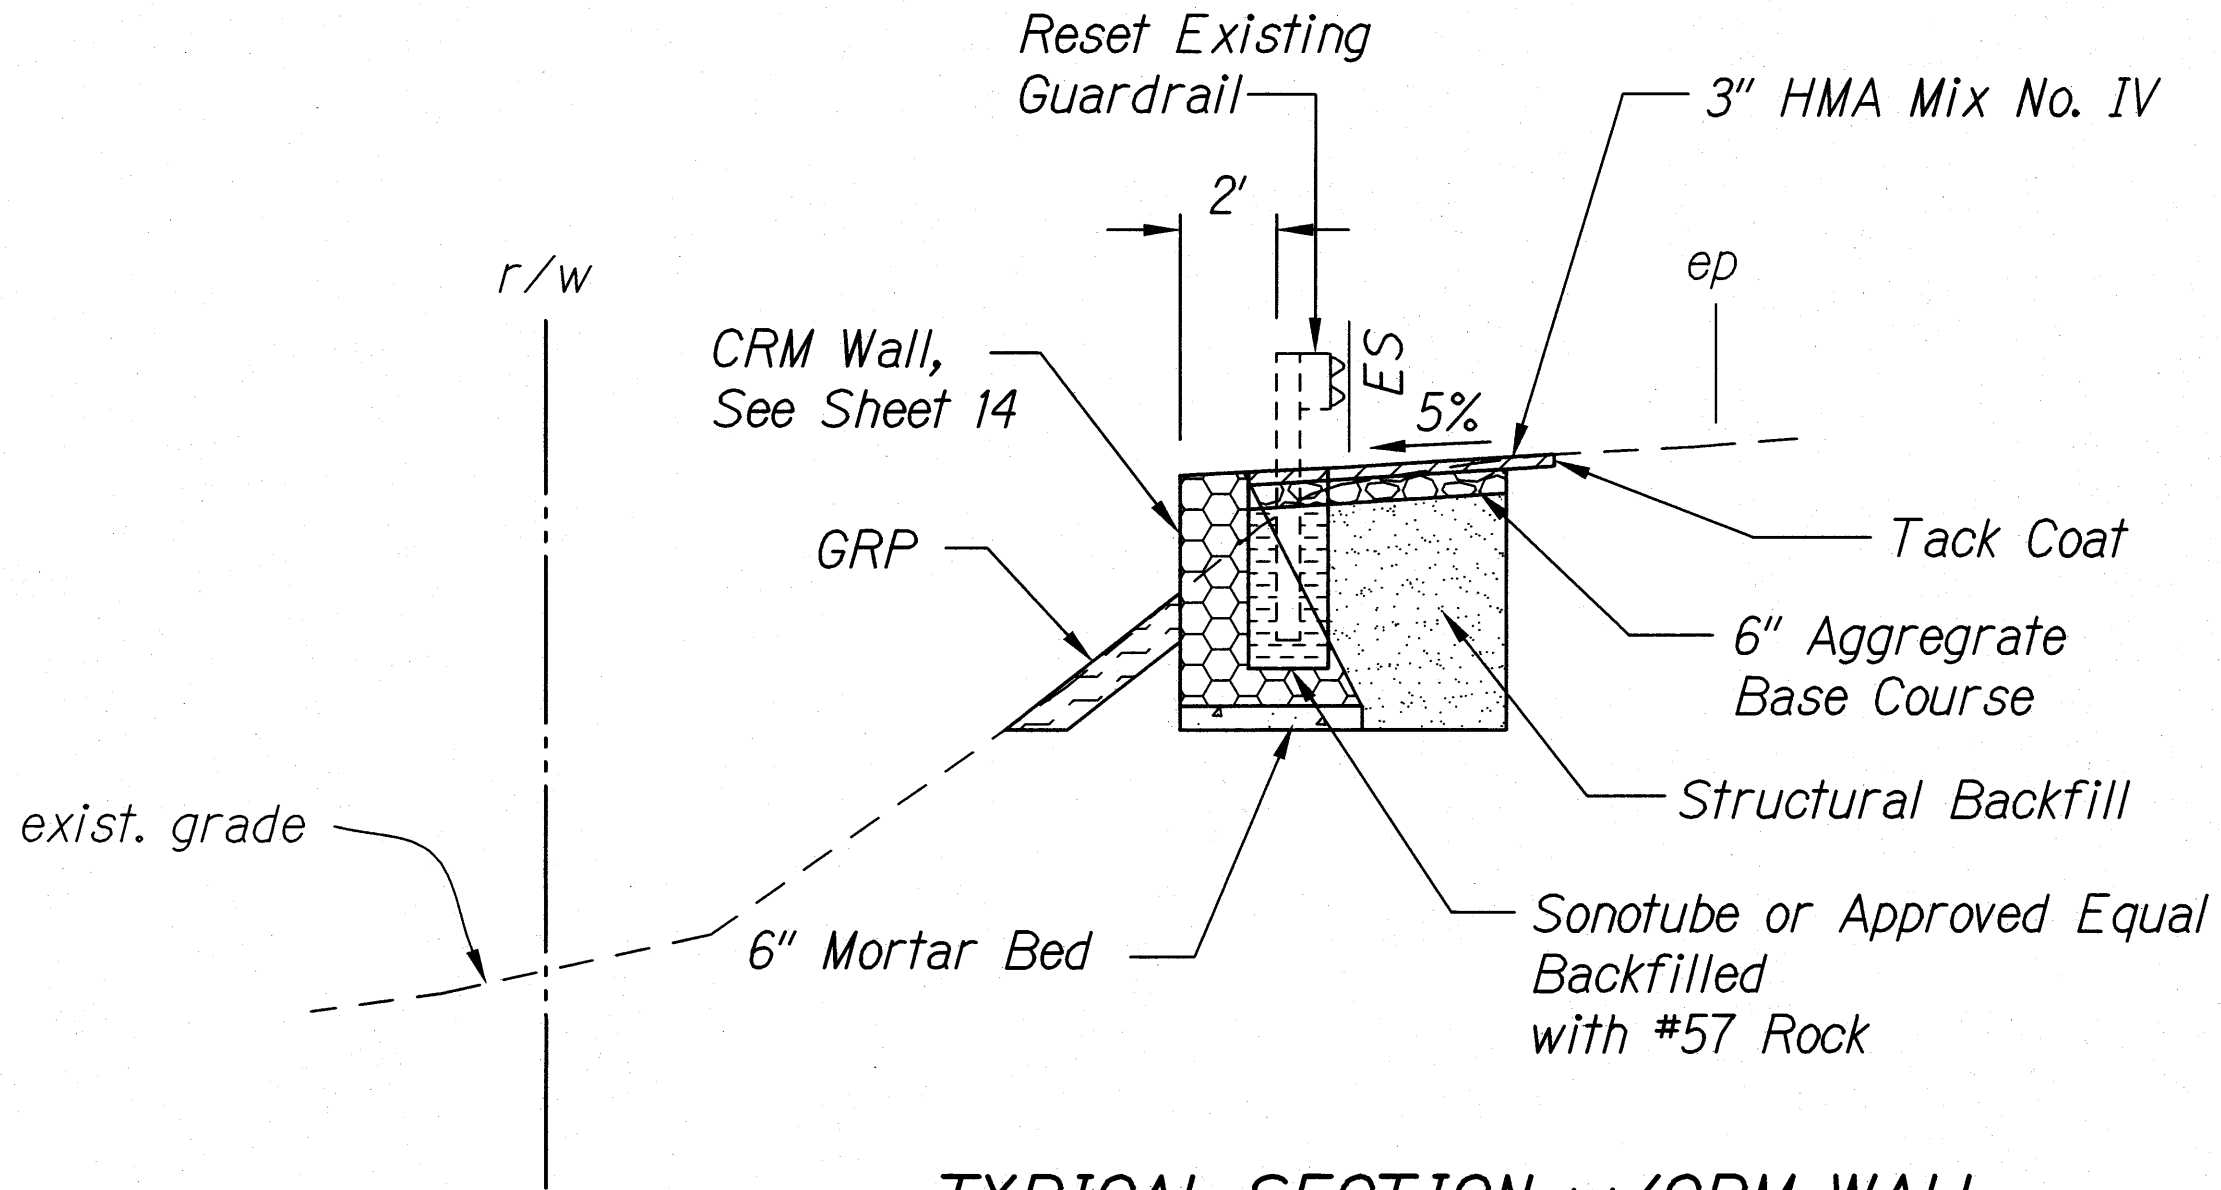

TYPICAL SECTION w/CRM WALL
Scale: Not to Scale


DATE	_____
SURVEY PLOTTED BY	_____
DRAWN BY	_____
TRACED BY	_____
DESIGNED BY	_____
QUANTITIES BY	_____
CHECKED BY	_____
ORIGINAL PLAN	_____
NOTE BOOK	_____
N.	_____

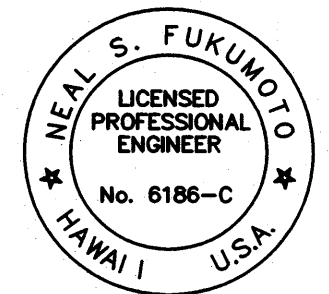

This work was prepared by me or under my supervision.
Exp. 04-30-10
Wesley R. Segawa & Associates, Inc.


STATE OF HAWAII
DEPARTMENT OF TRANSPORTATION
HIGHWAYS DIVISION
CRM WALL PROFILE
SITE 8 - MP 29.5
EMERGENCY EARTHQUAKE ROCKFALL REPAIRS
VARIOUS LOCATIONS ON HAWAII, UNIT 4
Federal Aid Project No. ER-15(22)
Scale: As Shown Date: December 2009
SHEET No. 8.2 OF 8.3 SHEETS

FED. ROAD DIST. NO.	STATE	FED. AID PROJ. NO.	FISCAL YEAR	SHEET NO.	TOTAL SHEETS
HAWAII	HAW.	ER-15(22)	2009	53	88

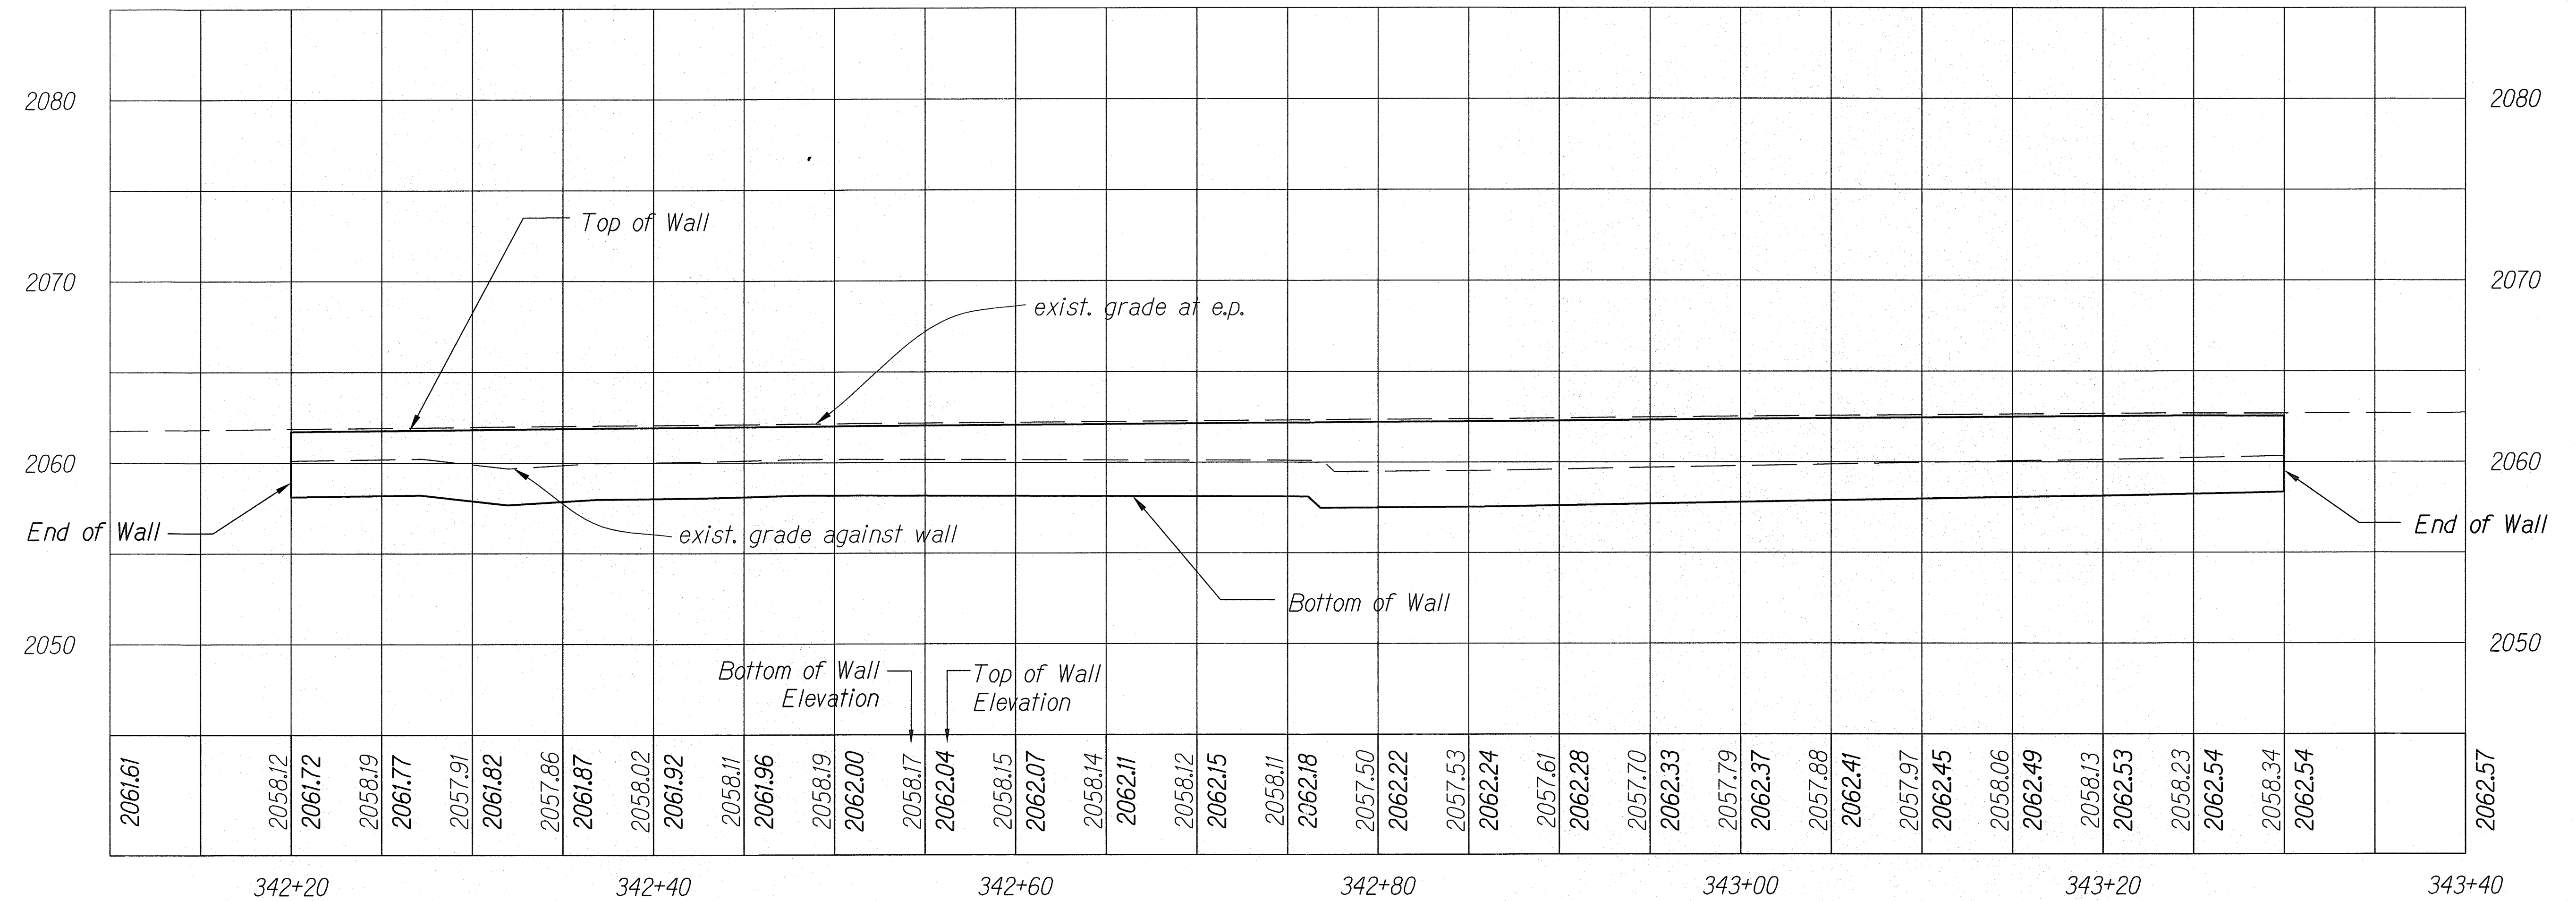

CRM WALL PROFILE - MP 29.5, STA. 342+20 TO 343+30


Scale: 1" = 5'

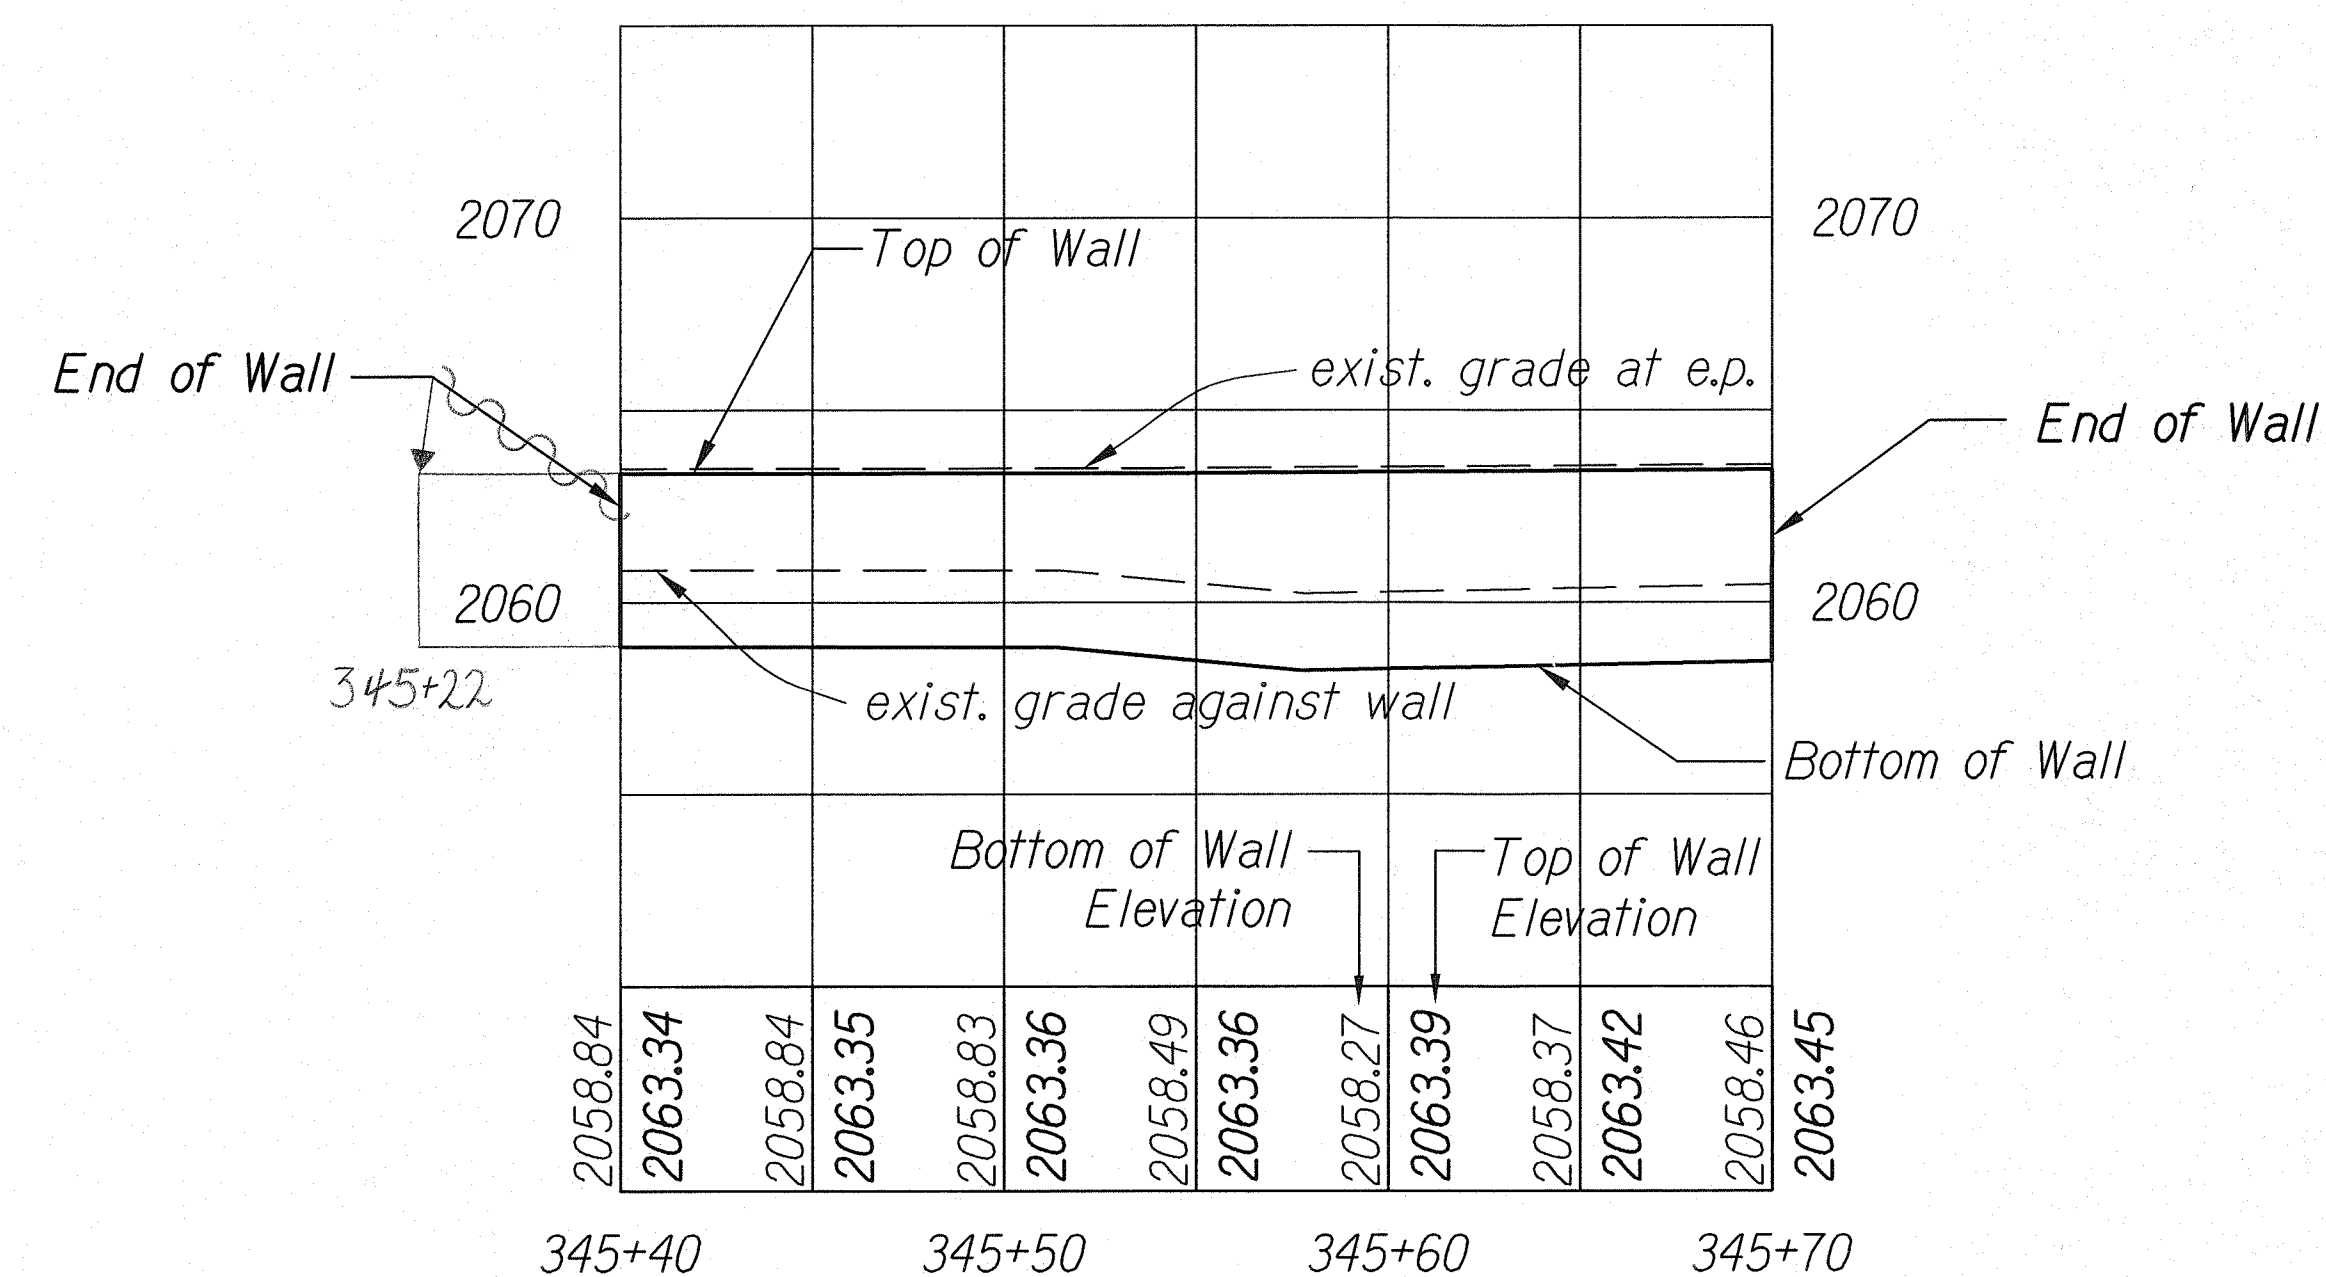

CRM WALL PROFILE - MP 29.5, STA. 345+40 TO 345+70

Scale: 1" = 5'

ORIGINAL PLAN	SURVEY PLOTTED BY	DATE
NOTE BOOK	DRAWN BY	
	DESIGNED BY	
	CHECKED BY	

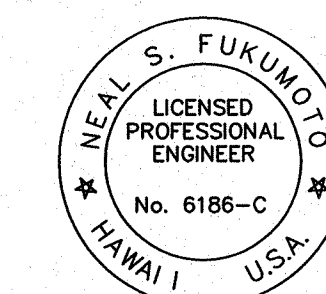

This work was prepared by me
or under my supervision.
Exp. 04-30-10
Neal S. Fukumoto
Wesley R. Segawa & Associates, Inc.

STATE OF HAWAII
DEPARTMENT OF TRANSPORTATION
HIGHWAYS DIVISION
CRM WALL PROFILE
SITE 8 - MP 29.5
EMERGENCY EARTHQUAKE ROCKFALL REPAIRS
VARIOUS LOCATIONS ON HAWAII, UNIT 4
Federal Aid Project No. ER-15(22)
Scale: 1"=5' Date: Dec. 2009
SHEET No. 8.3 OF 8.3 SHEETS

"AS-BUILT"