
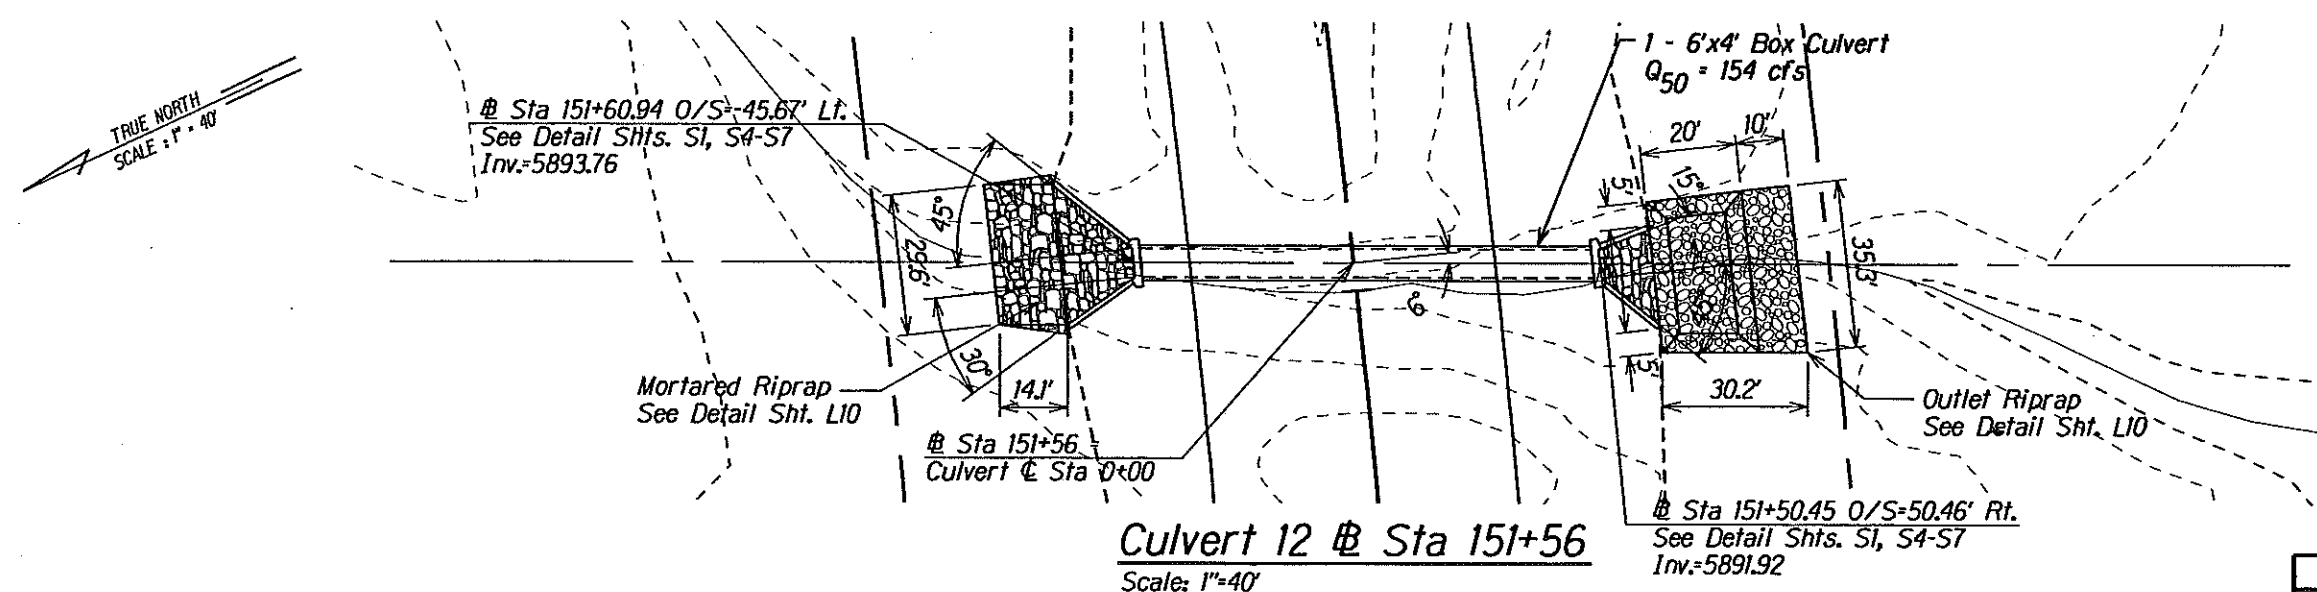
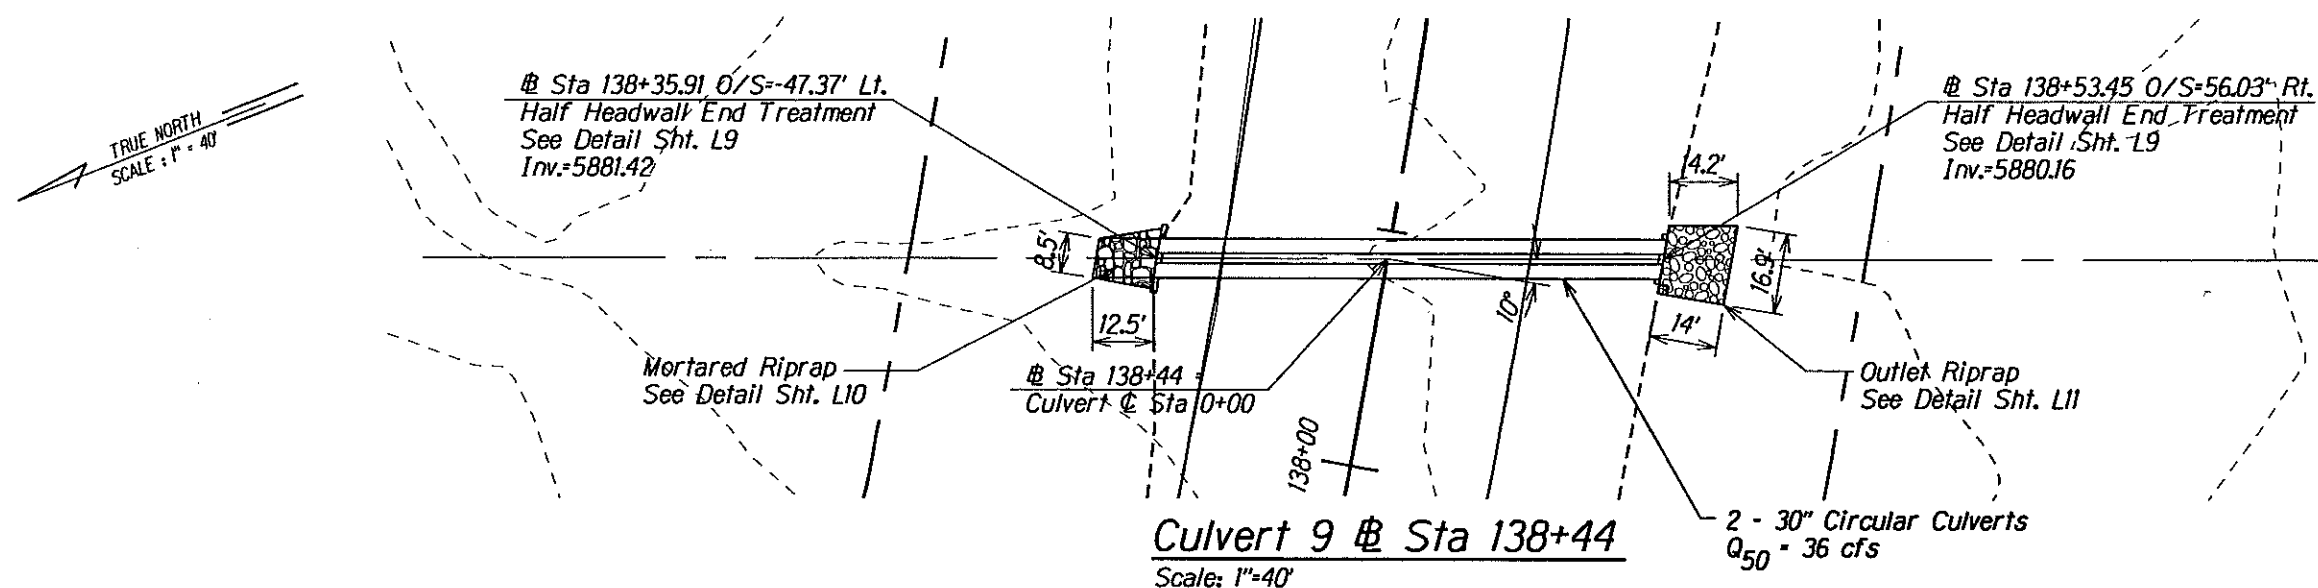


REG	STATE	PROJECT	SHEET NO.	TOTAL SHEETS
9	HI	HI-A-AD-6(2) Saddle Road	L12	L19

REVISED
03/01/2005

Wing Wall Lengths
Inlet = 14.8'
Outlet = 20.7'



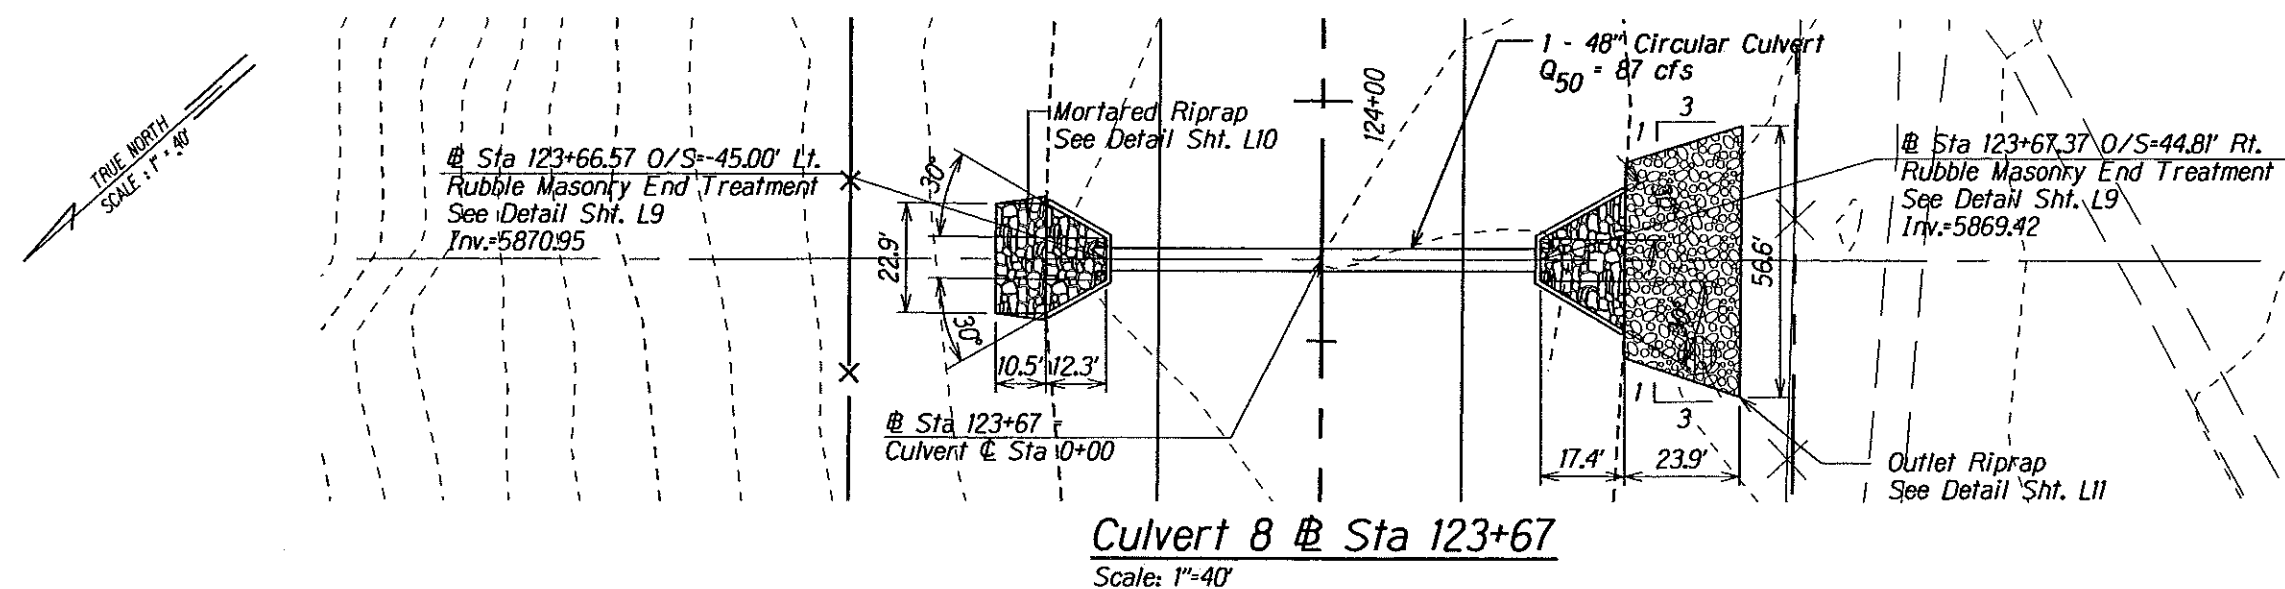


CULVERT PLAN DETAILS

SHEET No. 1 OF 2

L12

REG	STATE	PROJECT	SHEET NO.	TOTAL SHEETS
9	HI	HI-A-AD-6(2) Saddle Road	L13	L19

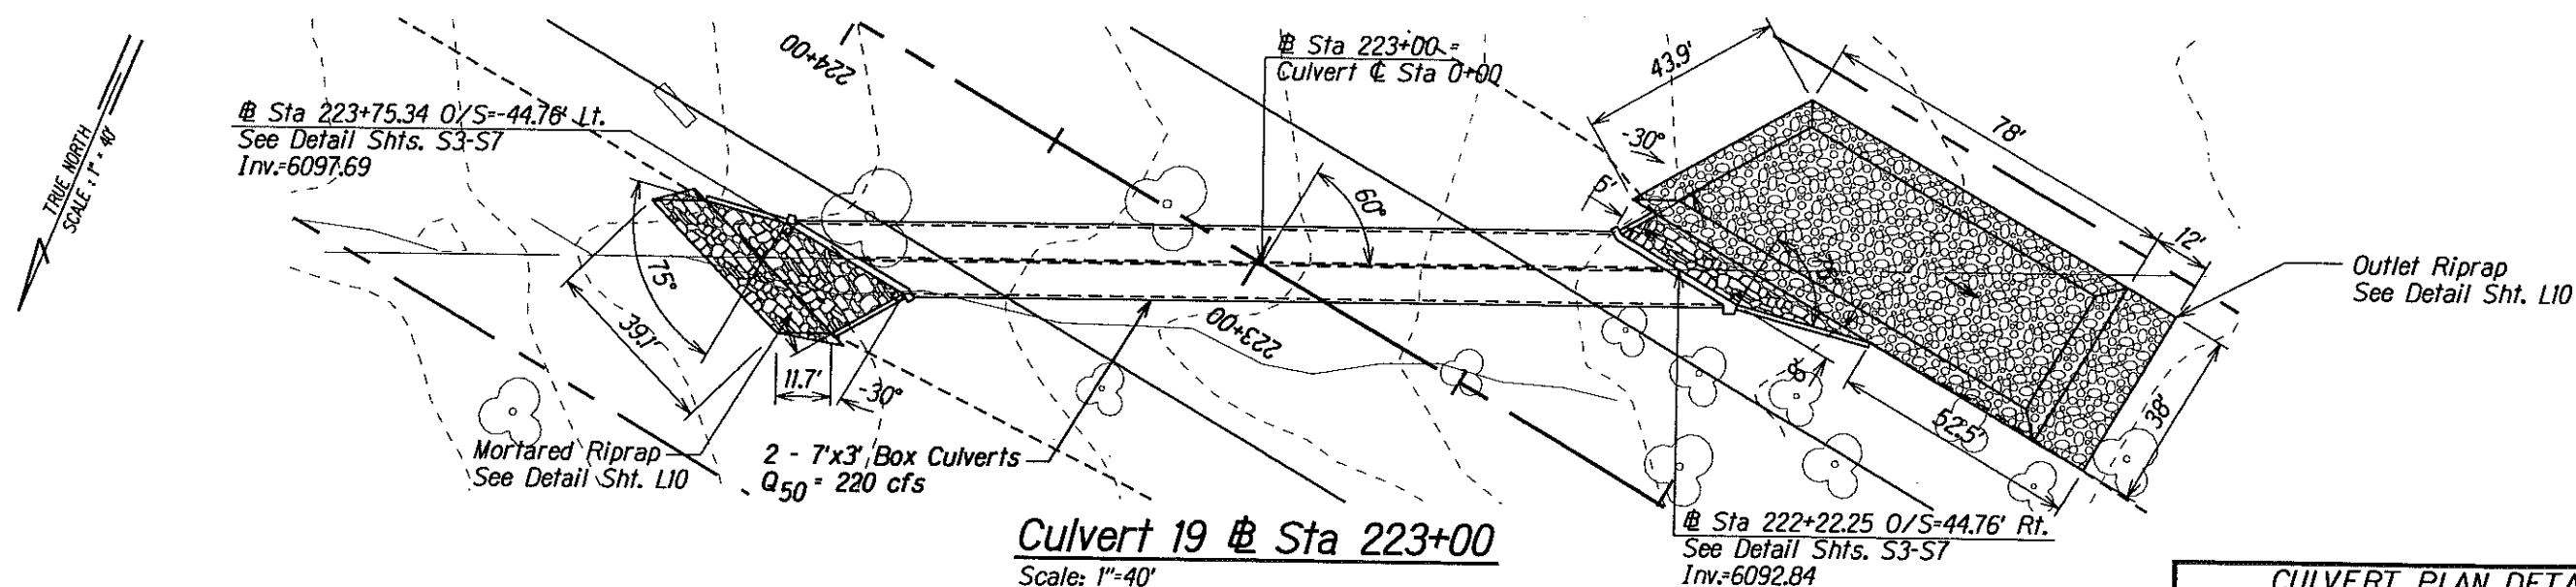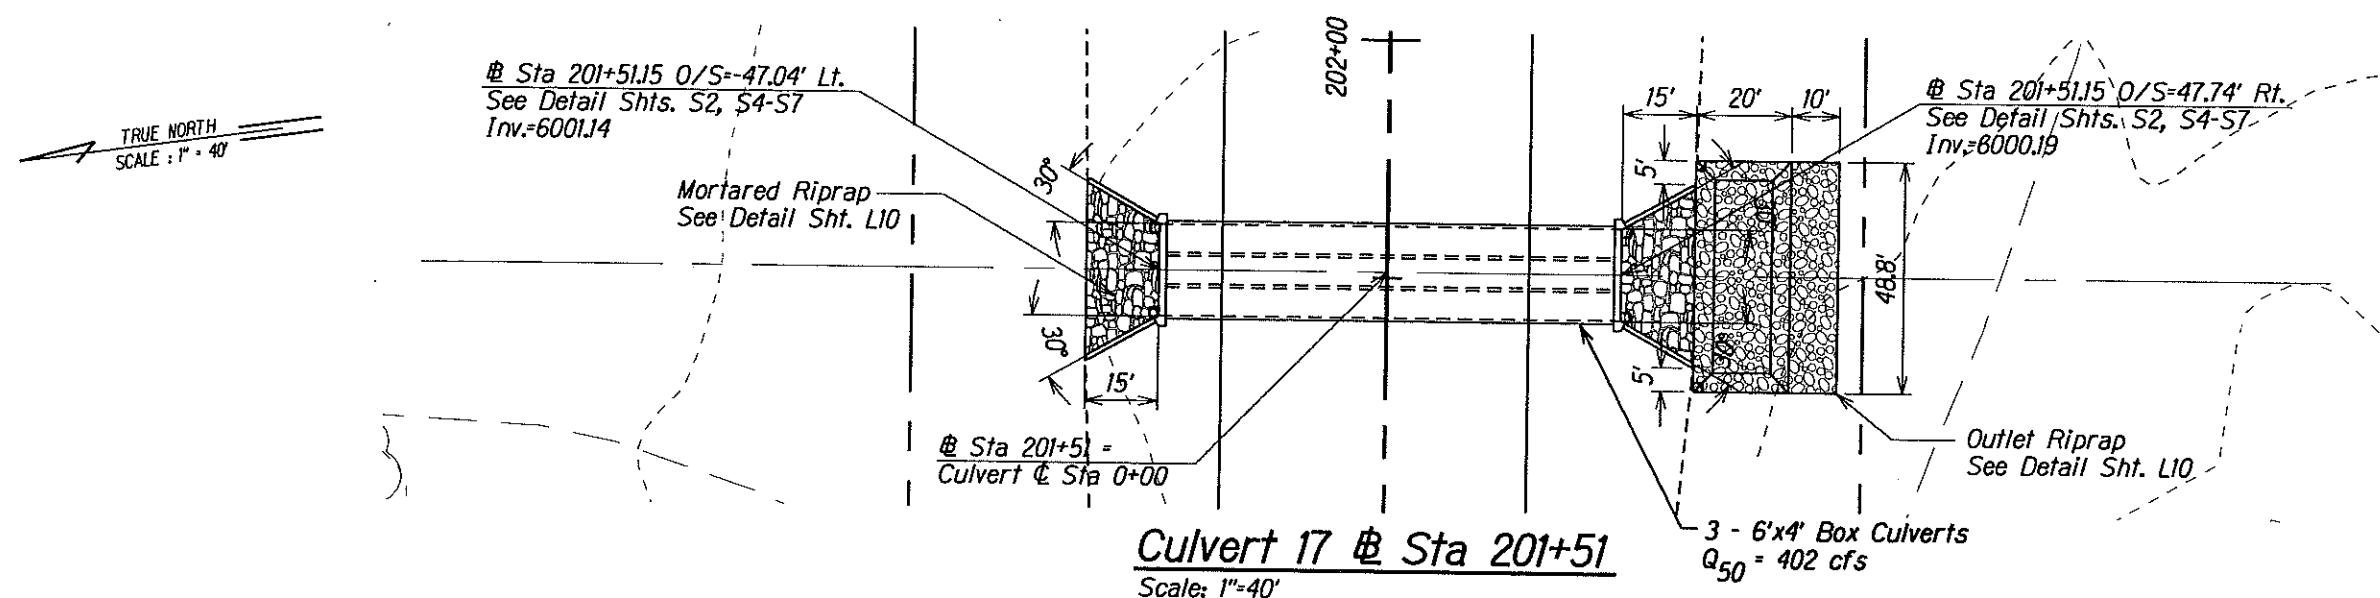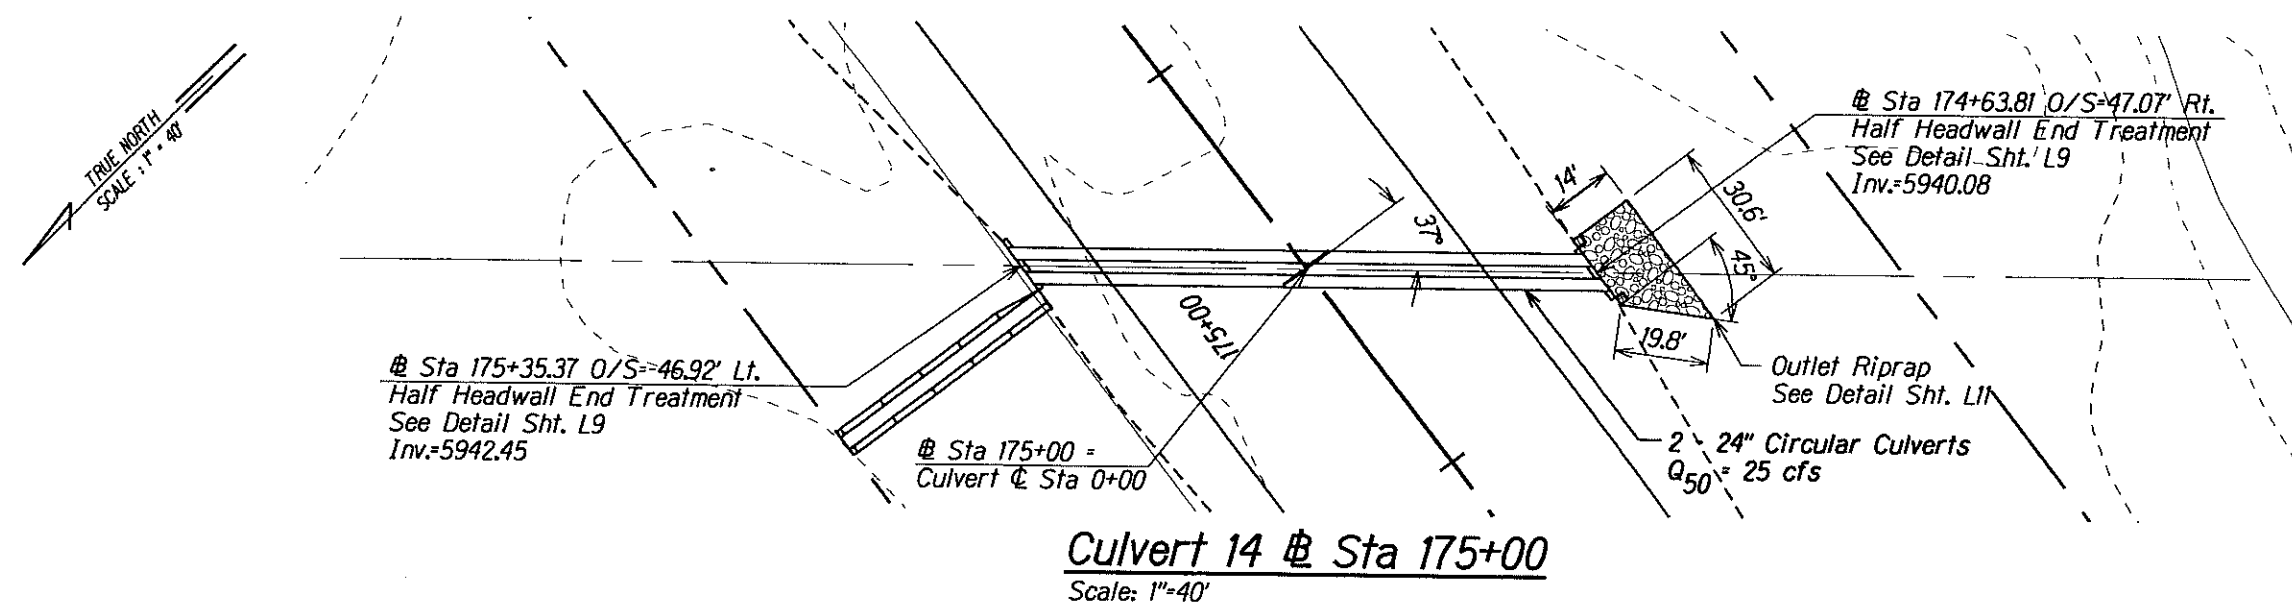

CULVERT PLAN DETAILS

SHEET No. 2 OF 2