


SEGMENT	DESCRIPTION
Entire Perimeter	Install 72-inch fence, see shts. M1-M3

REG	STATE	PROJECT	SHEET NO.	TOTAL SHEETS
9	HI	EMP 6(1A) Saddle Road	B3	B7

BOUNDARY SURVEY NOTES:

1. Azimuths and coordinates refer to government survey triangulation station "Ahumoa" and "Pu'u Kihe" for the Kalohe and Pu'u Mali mitigation sites respectively.
2. Azimuths and distances shown describe the mitigation site boundary lines and not the proposed fence layout. Layout and stake the proposed fence and related work in accordance with SCR section 152.

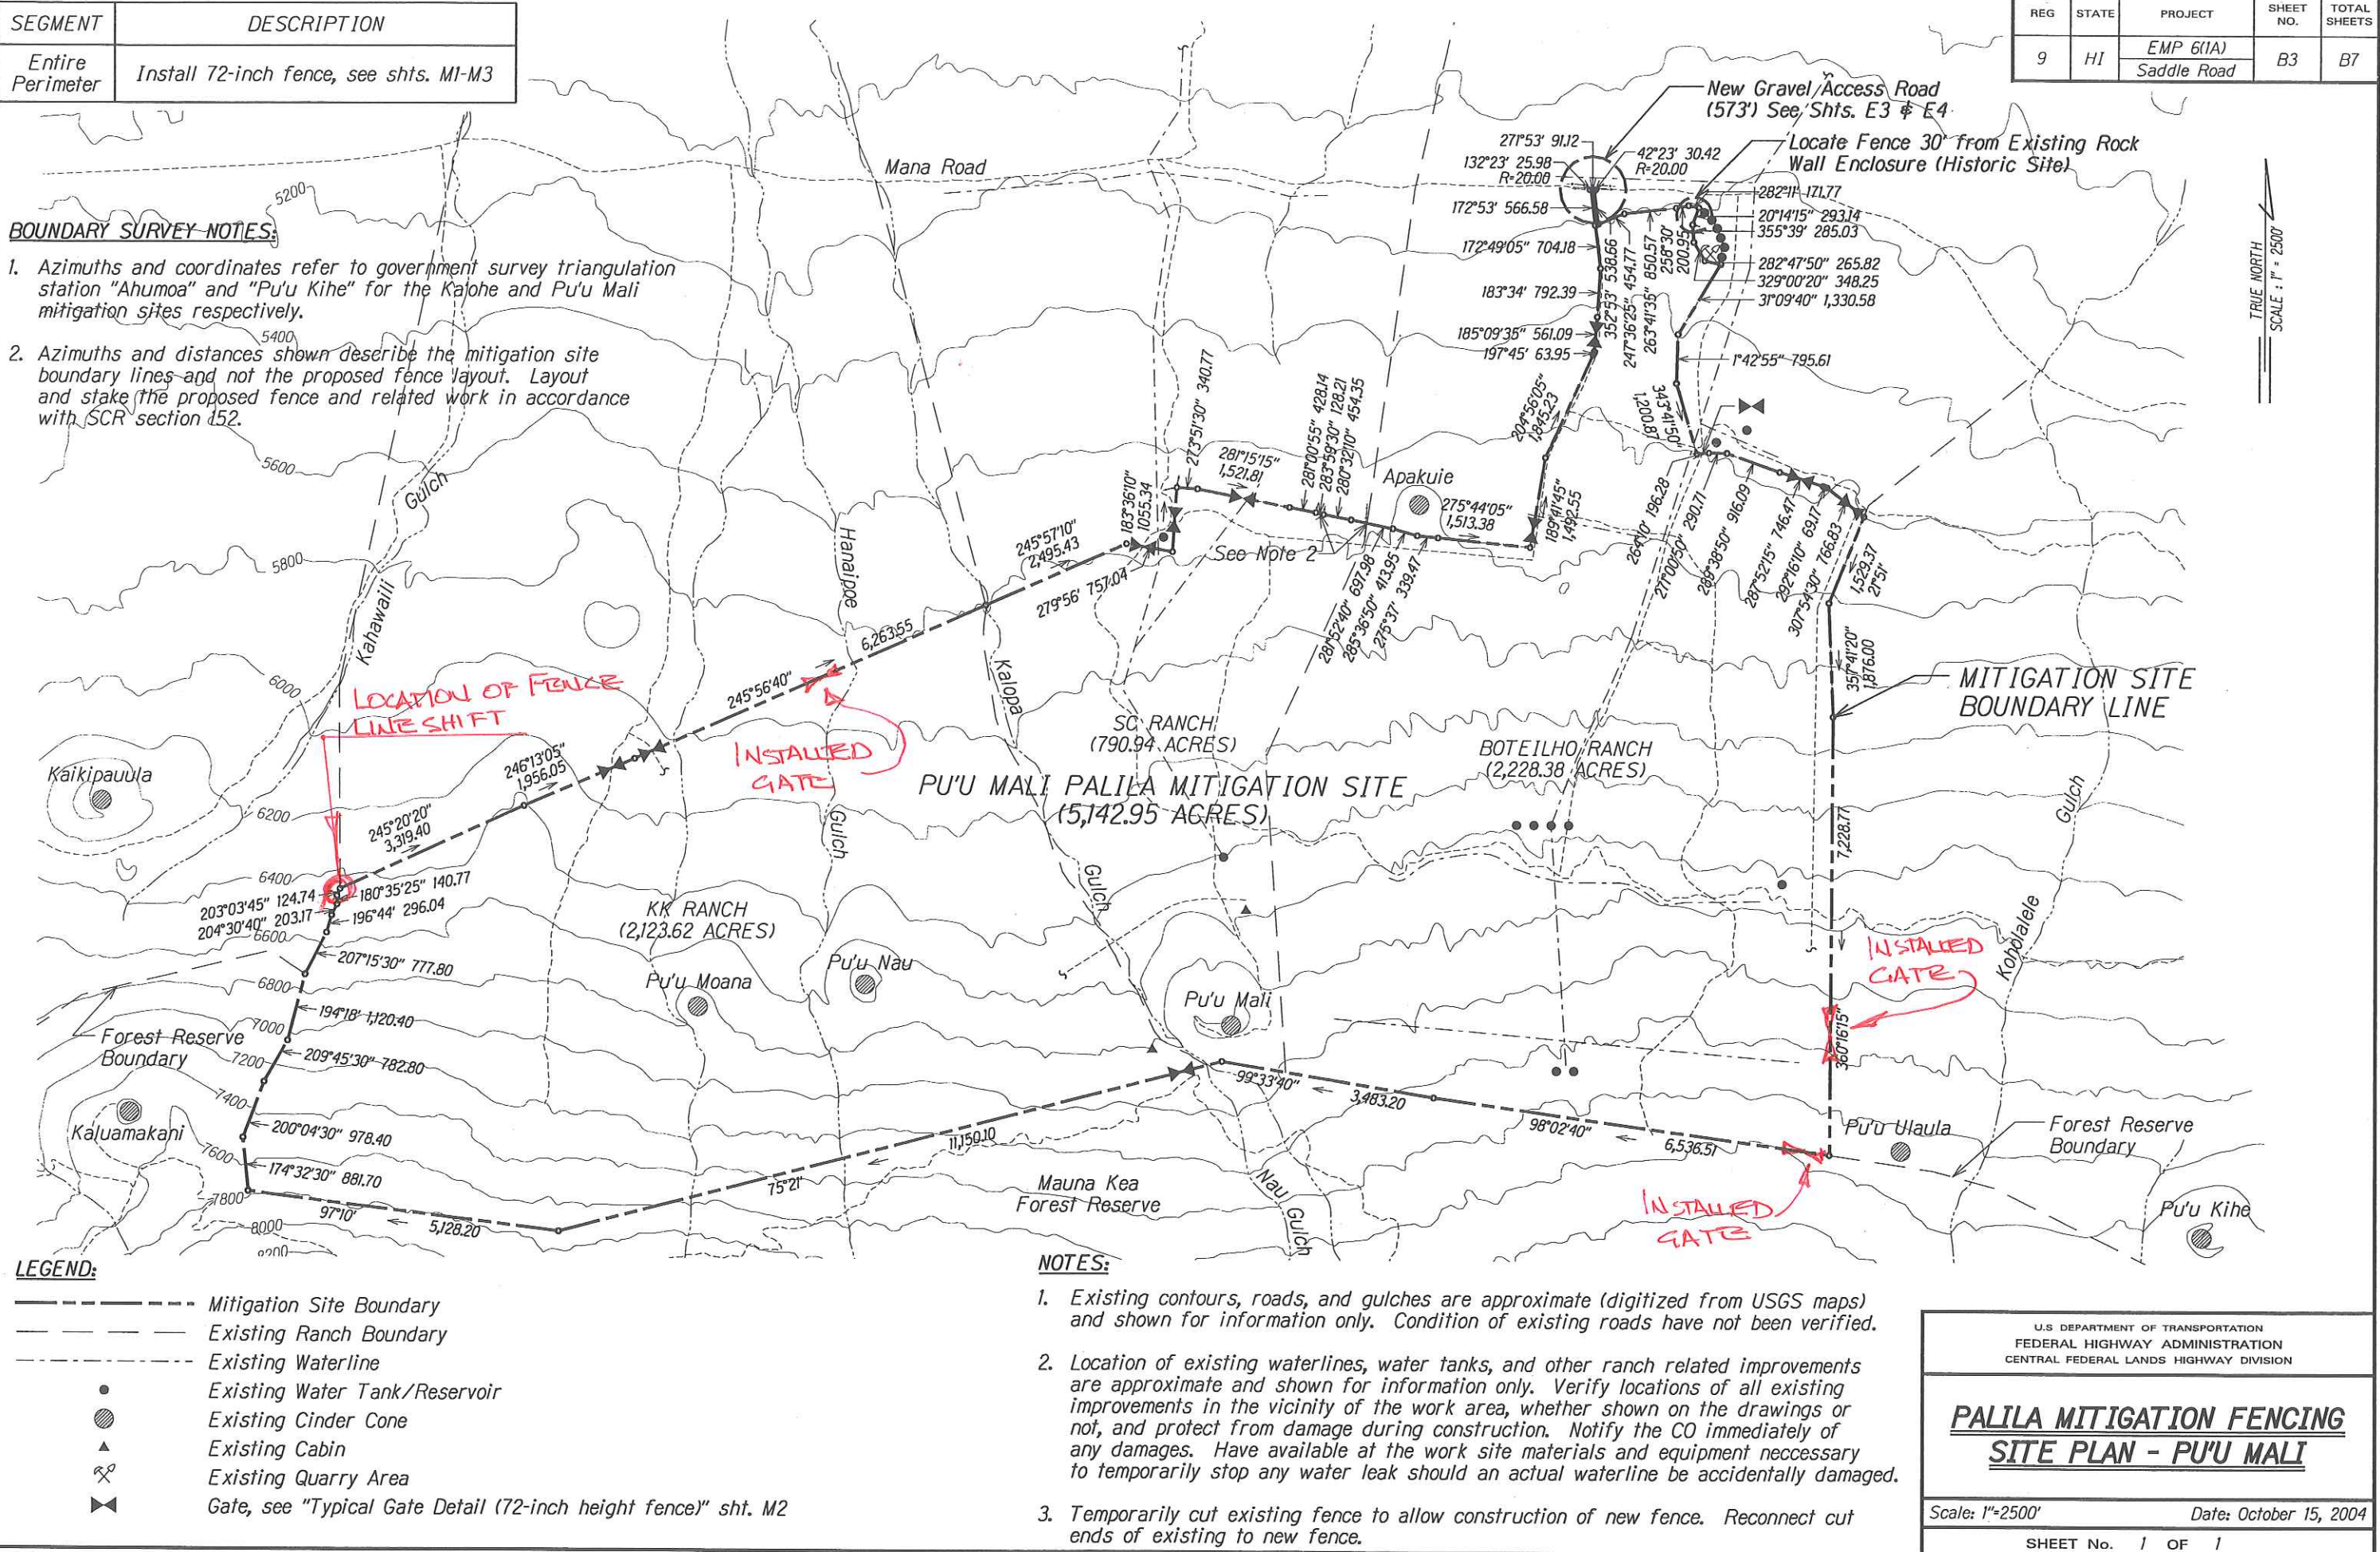

TRUE NORTH
SCALE: 1" = 2500'

U.S. DEPARTMENT OF TRANSPORTATION
FEDERAL HIGHWAY ADMINISTRATION
CENTRAL FEDERAL LANDS HIGHWAY DIVISION

**PALILA MITIGATION FENCING
SITE PLAN - PU'U MALI**

Scale: 1"=2500' Date: October 15, 2004

SHEET No. 1 OF 1