
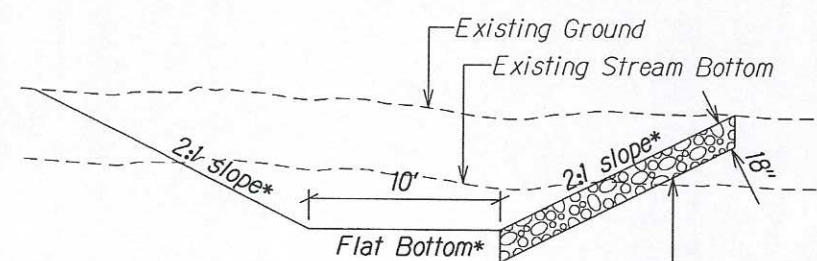




STATE	SADDLE ROAD PROJECT	SHEET NO.	TOTAL SHEETS
HI	HI A-AD 6(4)	G5	G5

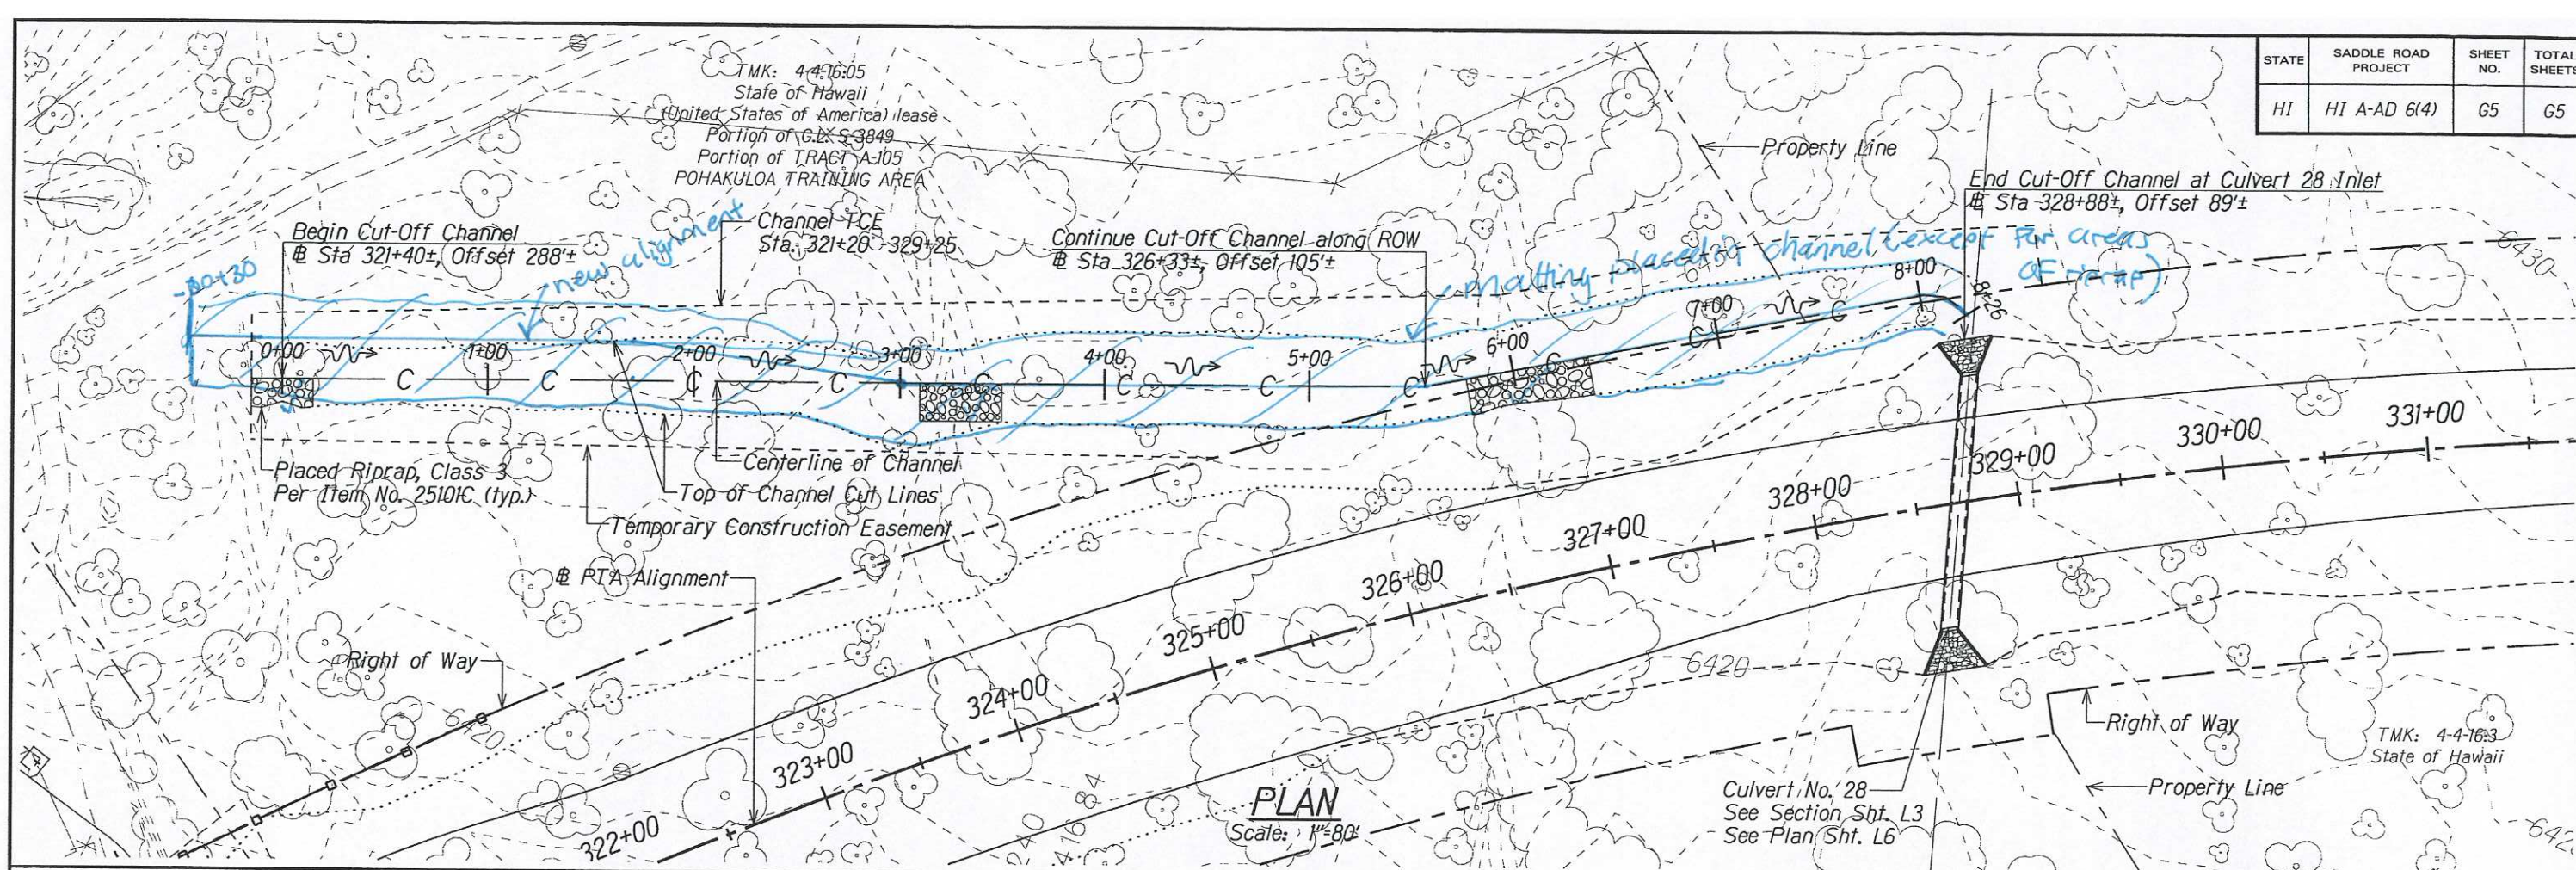

Reinforce slope with Placed Riprap, Class 3
(Item No. 2510IC) lined with Earthwork Geotextile, Type IV-E
at all stream crossings (Sta 0+00±, 3+20±, 6+00±)
Field adjust if necessary

Channel Typical Section
Scale: 1"=10'

*Install Erosion Control Mat Type 3 (Pay Item
No. 6290IC) on entire channel surface, except
on riprap surface.

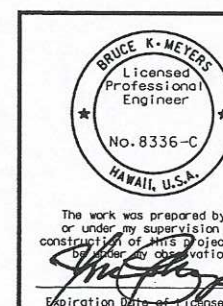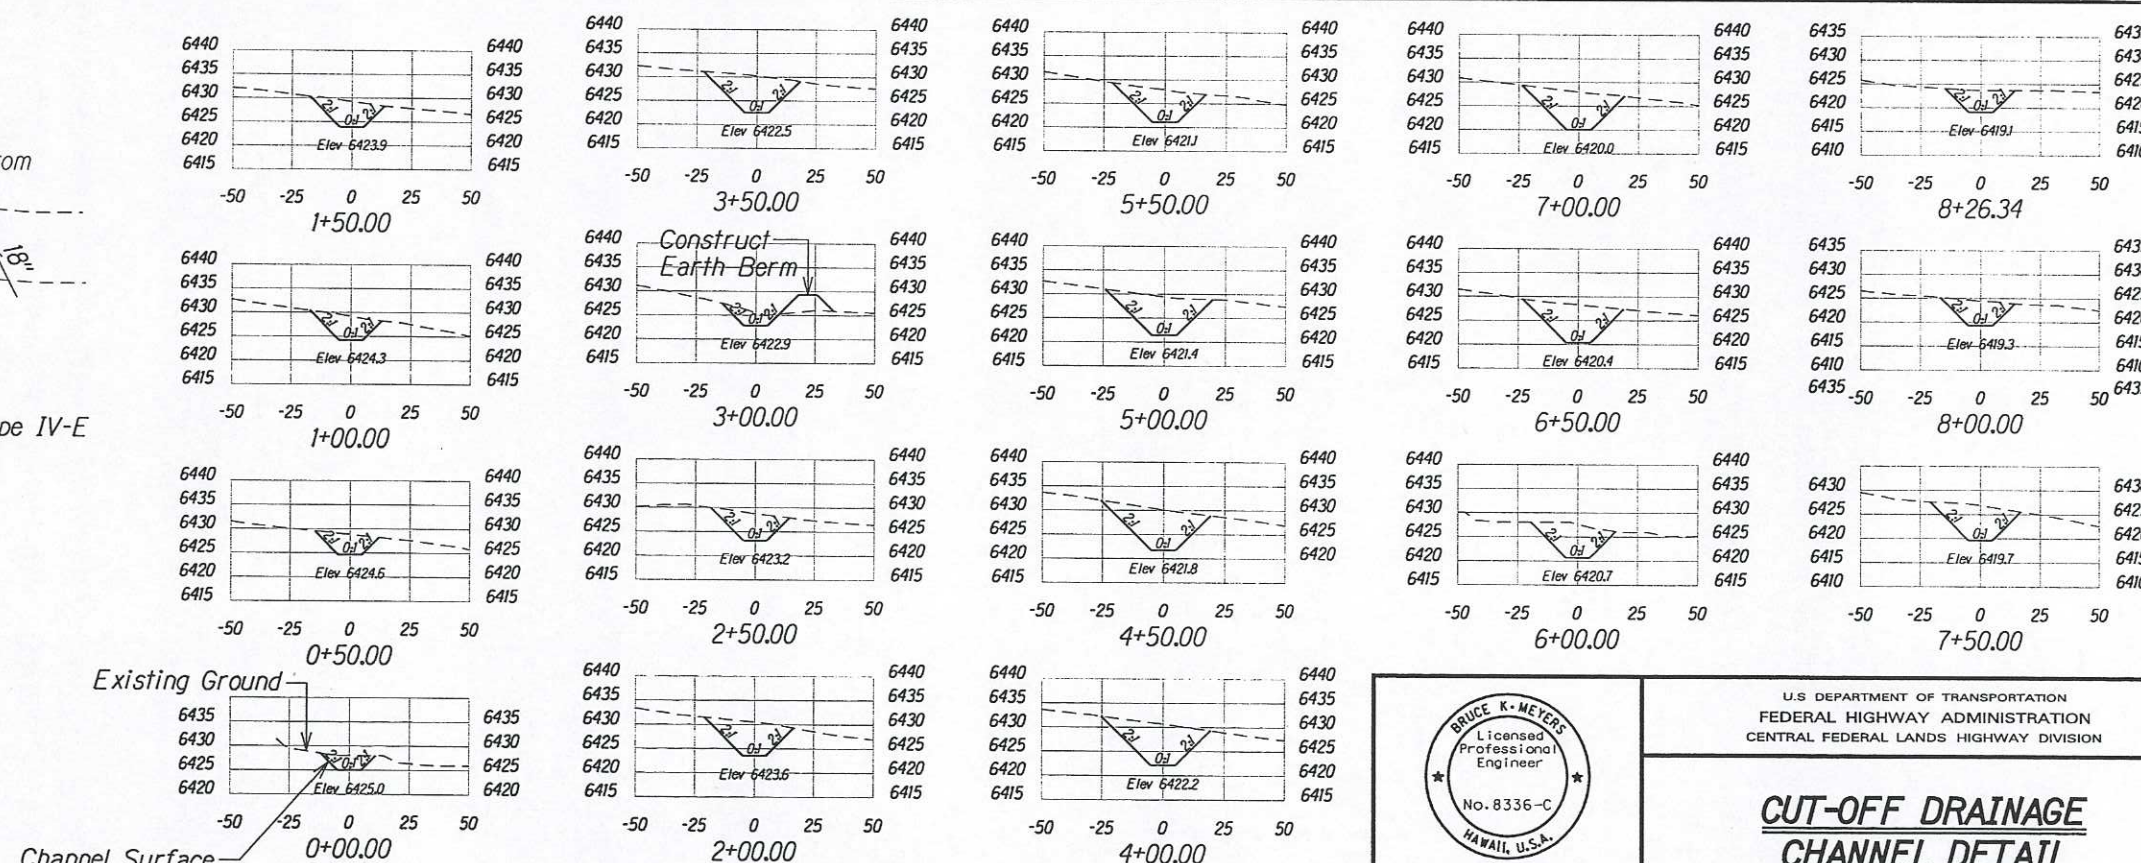

U.S. DEPARTMENT OF TRANSPORTATION
FEDERAL HIGHWAY ADMINISTRATION
CENTRAL FEDERAL LANDS HIGHWAY DIVISION

**CUT-OFF DRAINAGE
CHANNEL DETAIL**

Scale: As Noted Date: June 29, 2007
SHEET No. 1 OF 1