
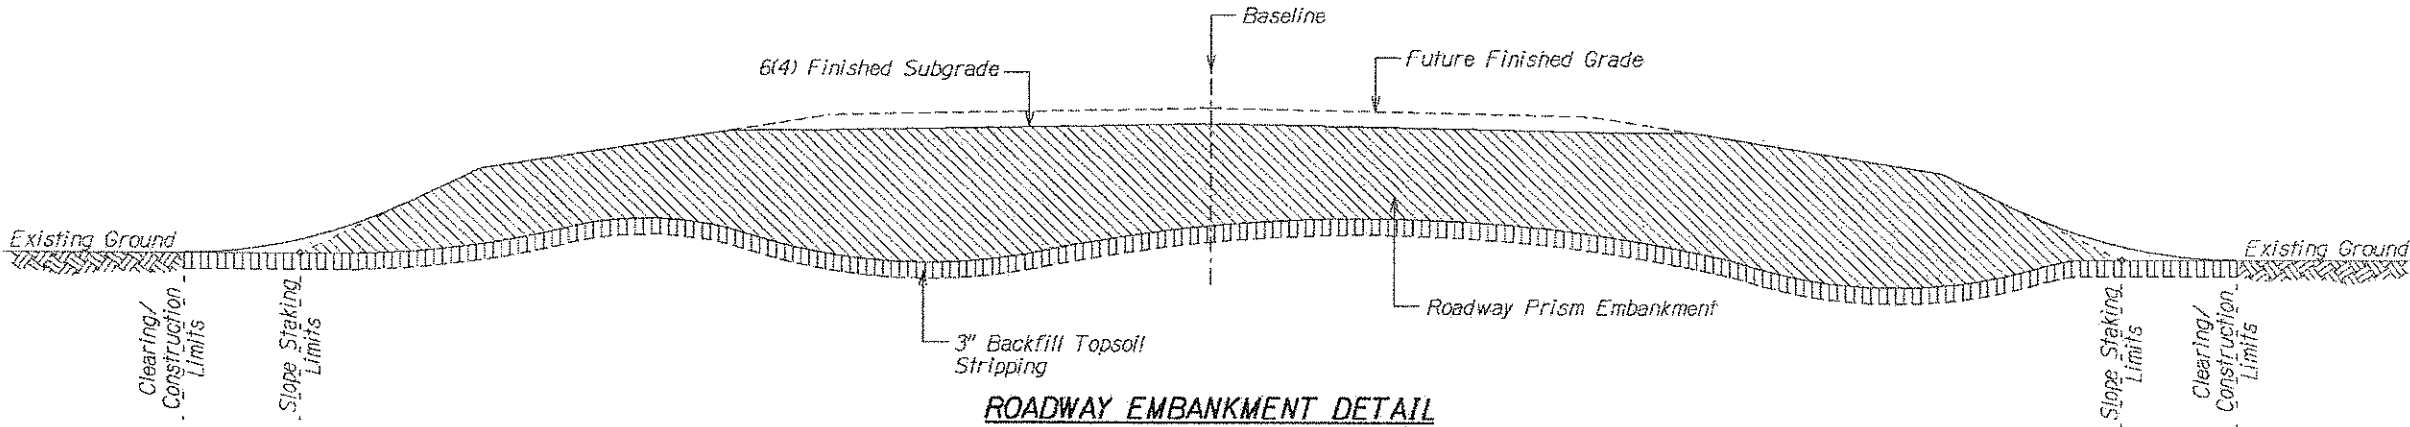


GRADING SUMMARY DETAIL

STATE	SADDLE ROAD PROJECT	SHEET NO.	TOTAL SHEETS
HI	HI A-AD 6(4)	C5	C9

Pay Item	Roadway Excavation			Adjustments To Excavation				Roadway Embankment		Adjustments to Embankment			Mass Haul			
			20401		20402											20412
Station to Station	Roadway Prism	Approach Roads*	Roadway Excavation	(-) Topsoil Stripping In Cuts	(+) Sub-excavation	Average Shrink/Swell Factor	Total Excavation Available for Fills	Roadway Prism	Approach Roads	(+) Topsoil Replacement Under Fill	(+) Sub-excavation	Total Embankment	Excavation - Embankment	Mass Ordinate	Conserved Topsoil	Waste

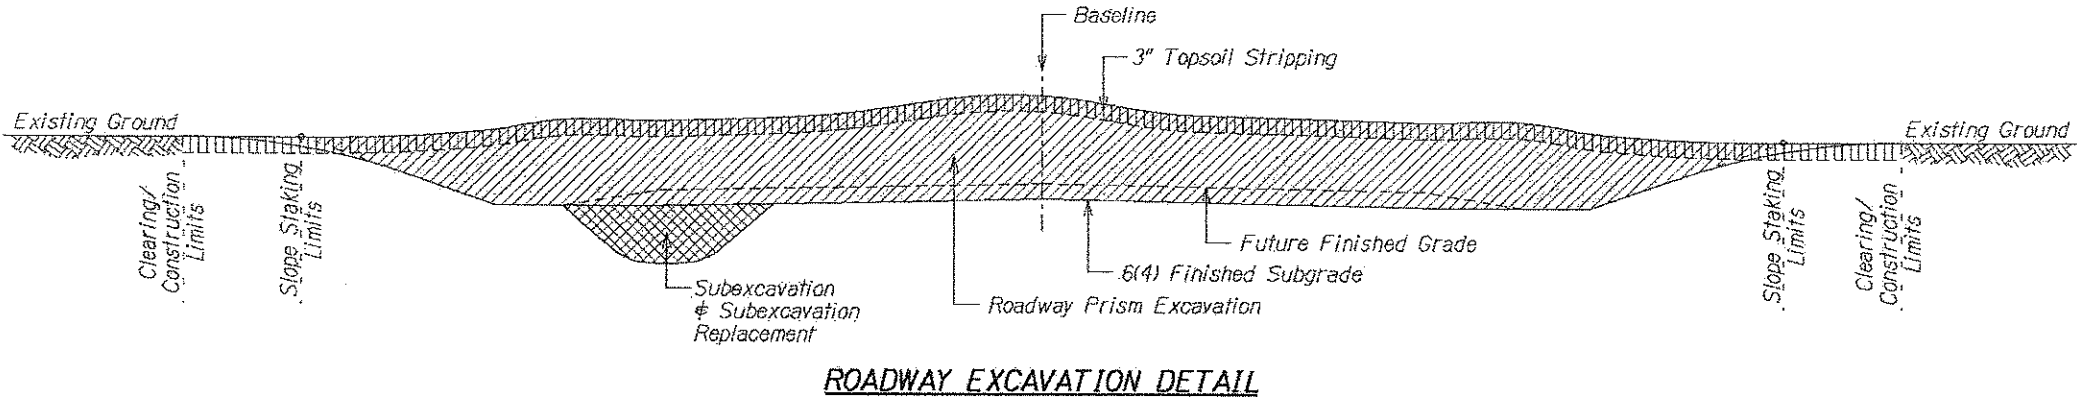

- Legend:
- Roadway Prism Excavation
 - Roadway Prism Embankment
 - Subexcavation & Subexcavation Replacement
 - 3" Topsoil Stripping or Backfill

