



STATE	SADDLE ROAD PROJECT	SHEET NO.	TOTAL SHEETS
HI	HI A-AD 6(4)	L1	L15

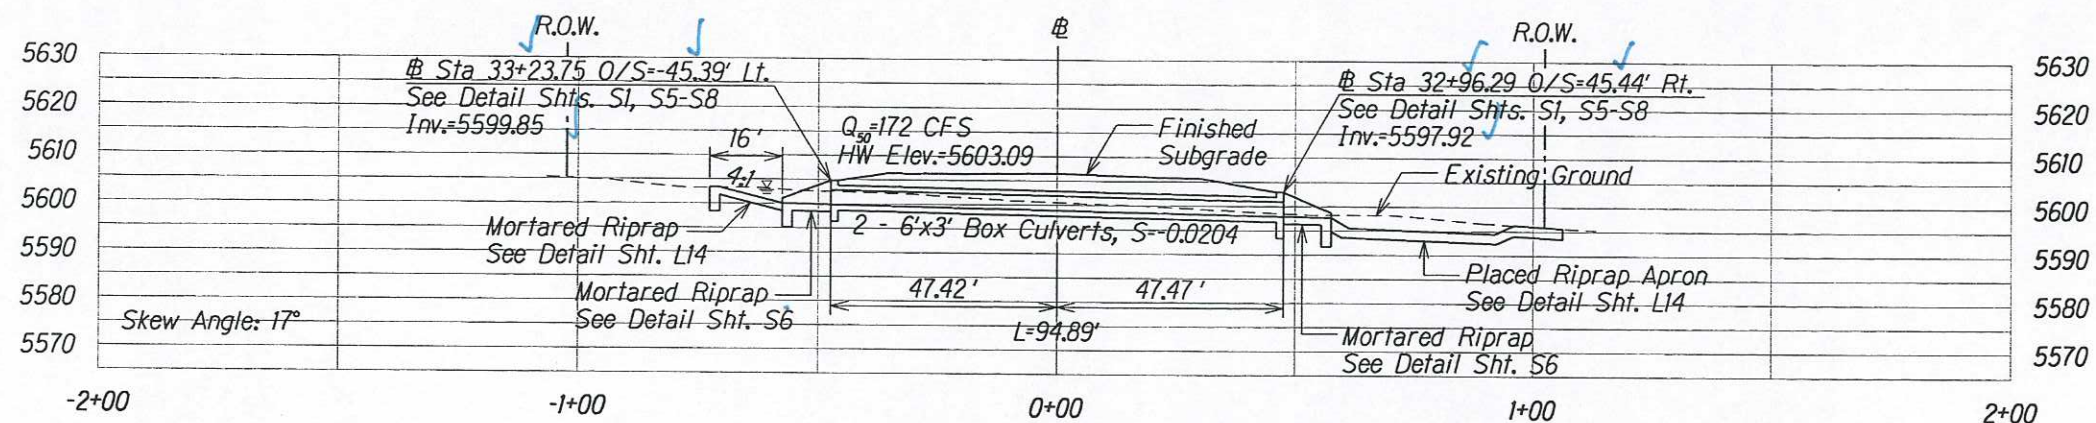


CULVERT 2 @ STA 33+10

see attached plan & profile (field design)

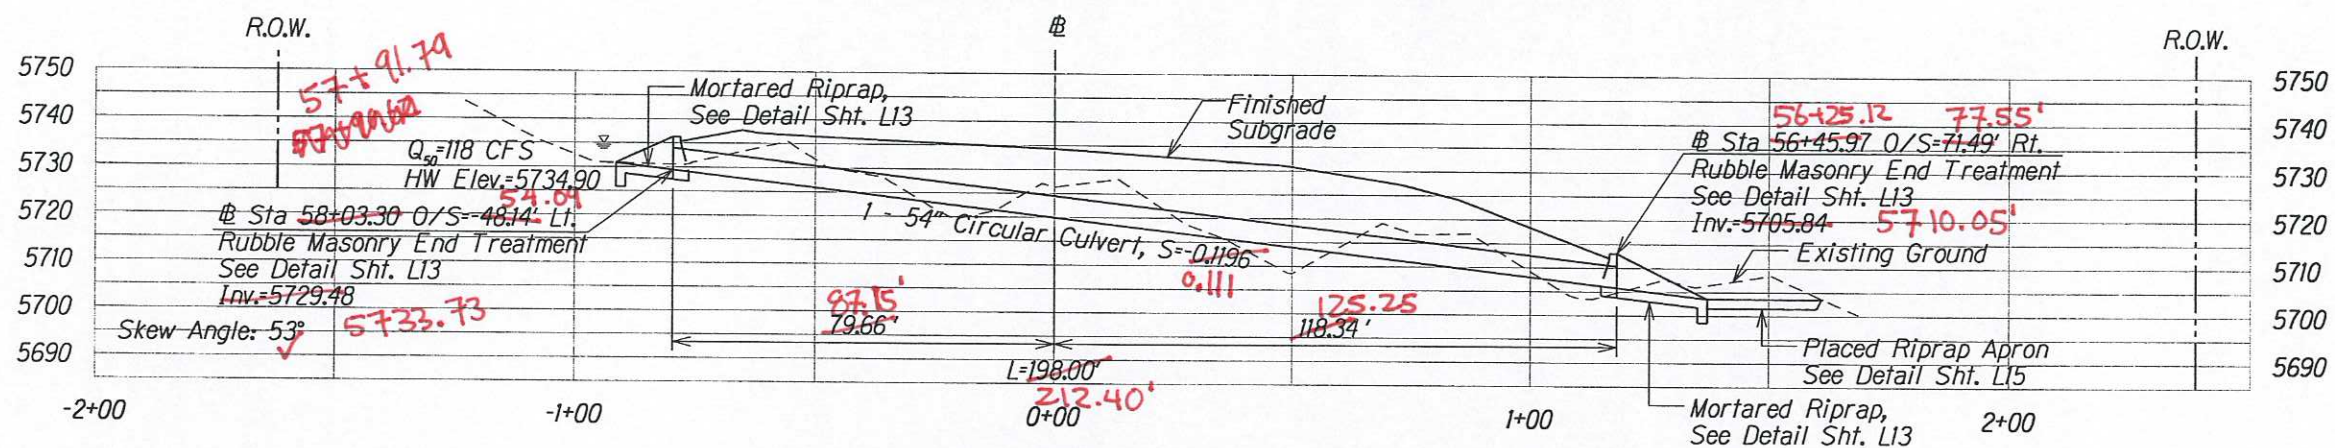

CULVERT 3 @ STA 57+40

see attached plan & profile (field design)

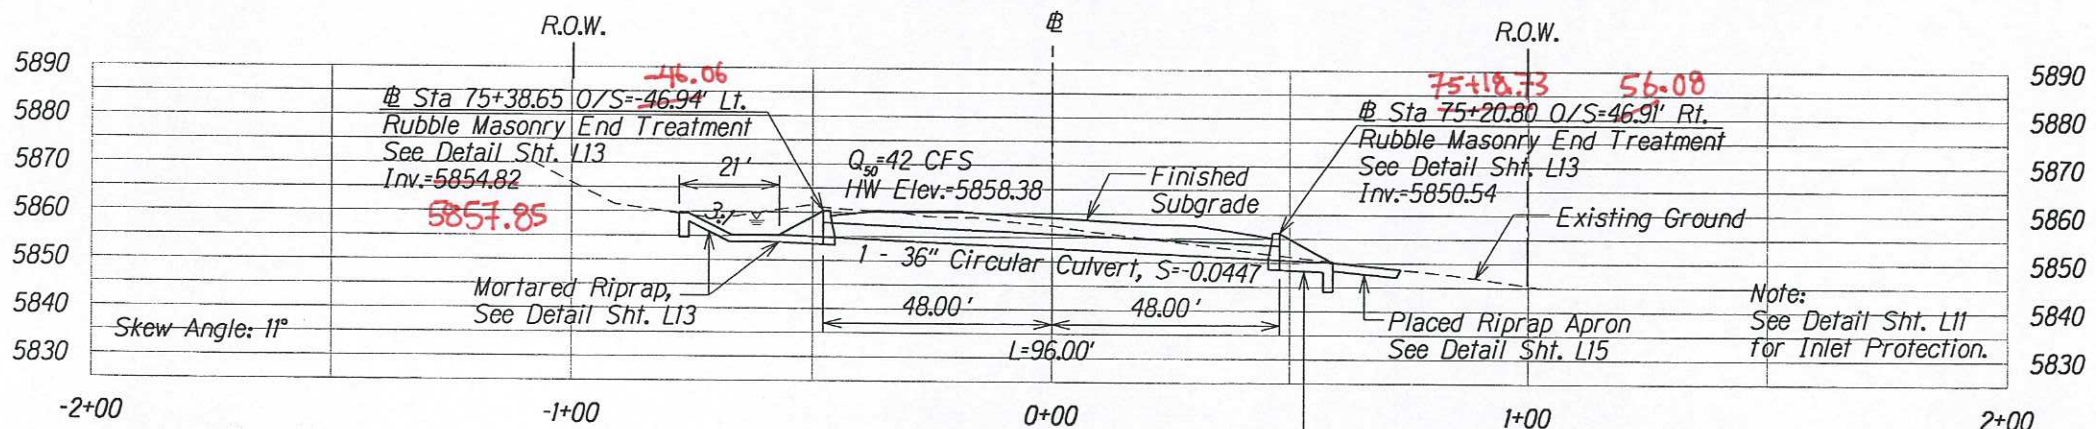

CULVERT 4 @ STA 75+30

see attached plan & profile (field design)

BRUCE K. MEYERS
Licensed Professional Engineer
No. 8336-C
HAWAII, U.S.A.

The work was prepared by me or under my supervision and construction of this project will be under my observation.
Expiration Date of License 4/08




U.S. DEPARTMENT OF TRANSPORTATION
FEDERAL HIGHWAY ADMINISTRATION
CENTRAL FEDERAL LANDS HIGHWAY DIVISION

**LONGITUDINAL
CULVERT SECTIONS**

Scale: 1"=40' Date: June 29, 2007

SHEET No. 1 OF 4

STATE	SADDLE ROAD PROJECT	SHEET NO.	TOTAL SHEETS
HI	HI A-AD 6(4)	L2	L15

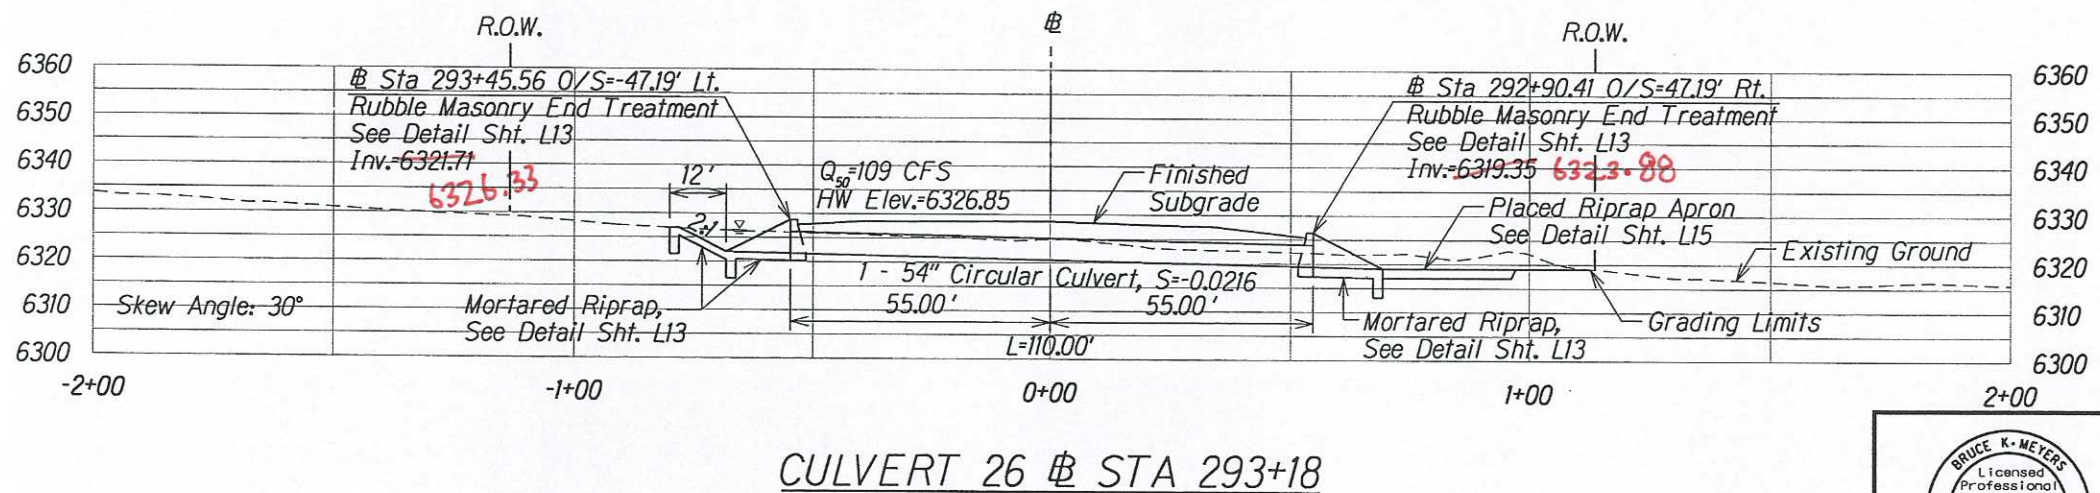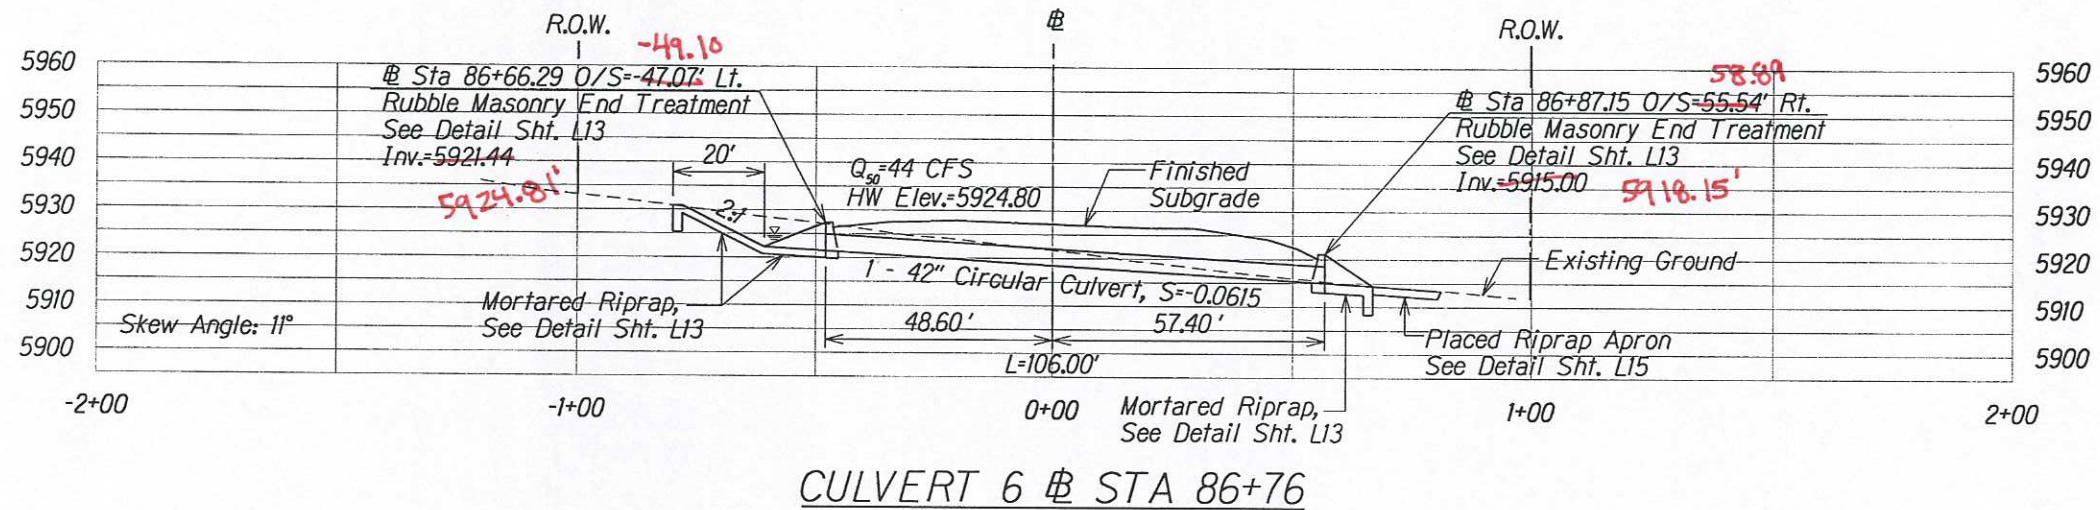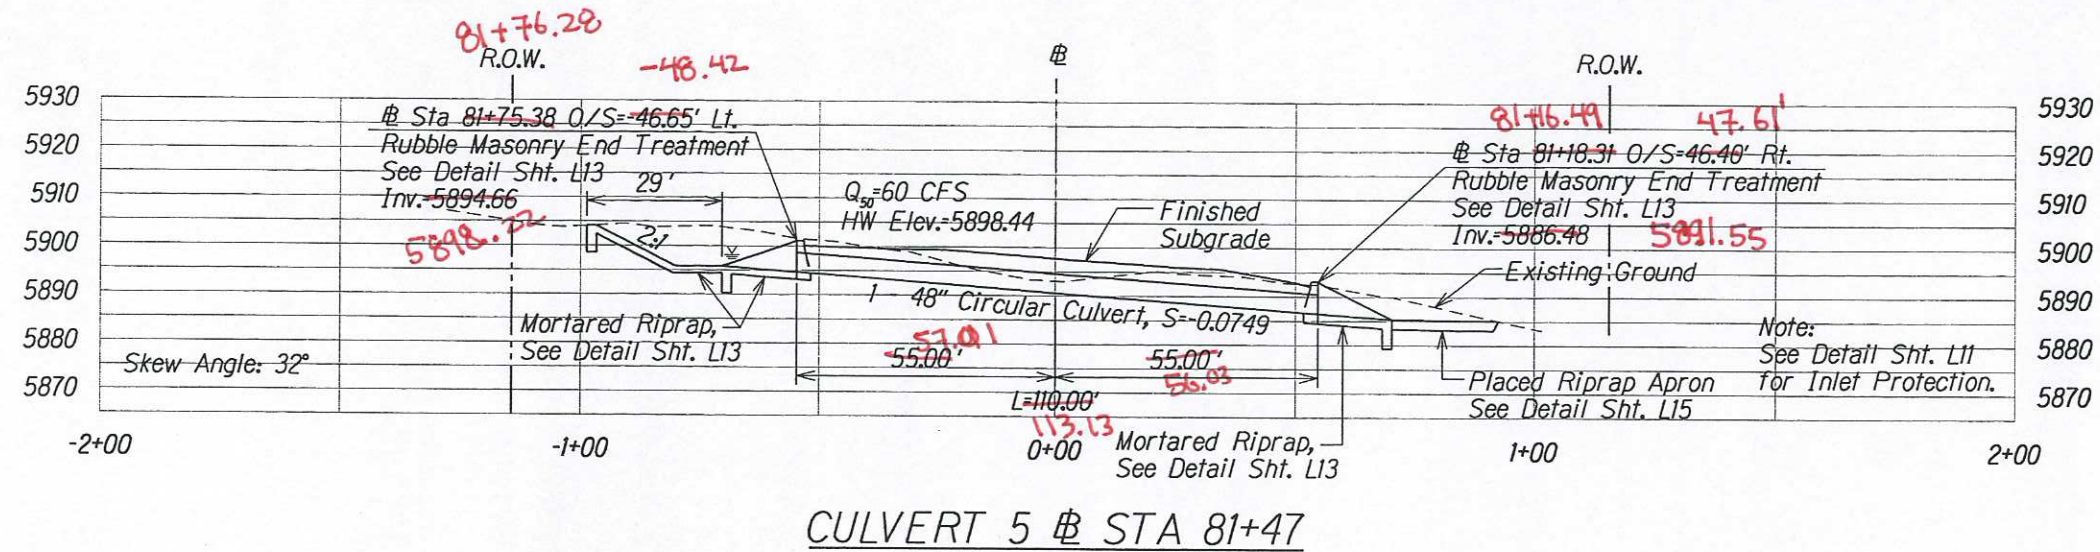

BRUCE K. MEYERS
Licensed Professional Engineer
No. 8336-C
HAWAII, U.S.A.

The work was prepared by me or under my supervision and construction of this project will be under my observation.
Expiration Date of License 4/08


U.S. DEPARTMENT OF TRANSPORTATION
FEDERAL HIGHWAY ADMINISTRATION
CENTRAL FEDERAL LANDS HIGHWAY DIVISION

**LONGITUDINAL
CULVERT SECTIONS**


Scale: 1"=40' Date: June 29, 2007

SHEET No. 2 OF 4


STATE	SADDLE ROAD PROJECT	SHEET NO.	TOTAL SHEETS
HI	HI A-AD 6(4)	L3	L15

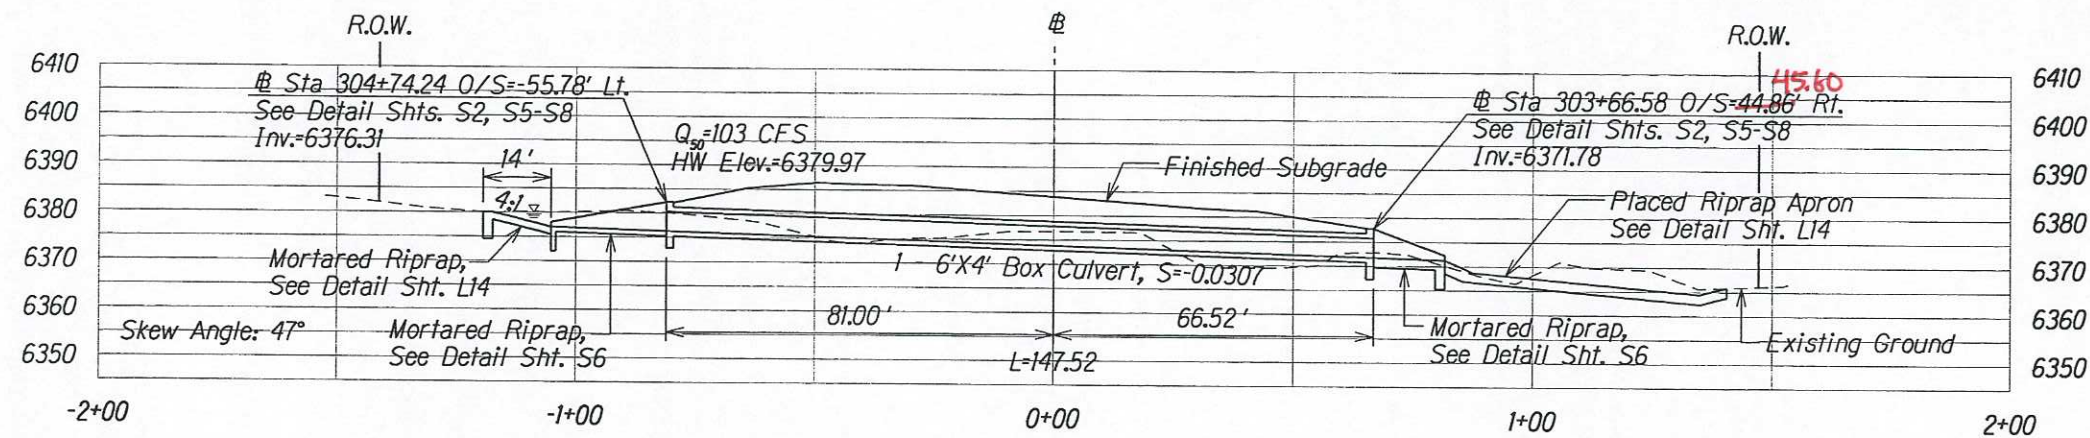

CULVERT 27 @ STA 304+16

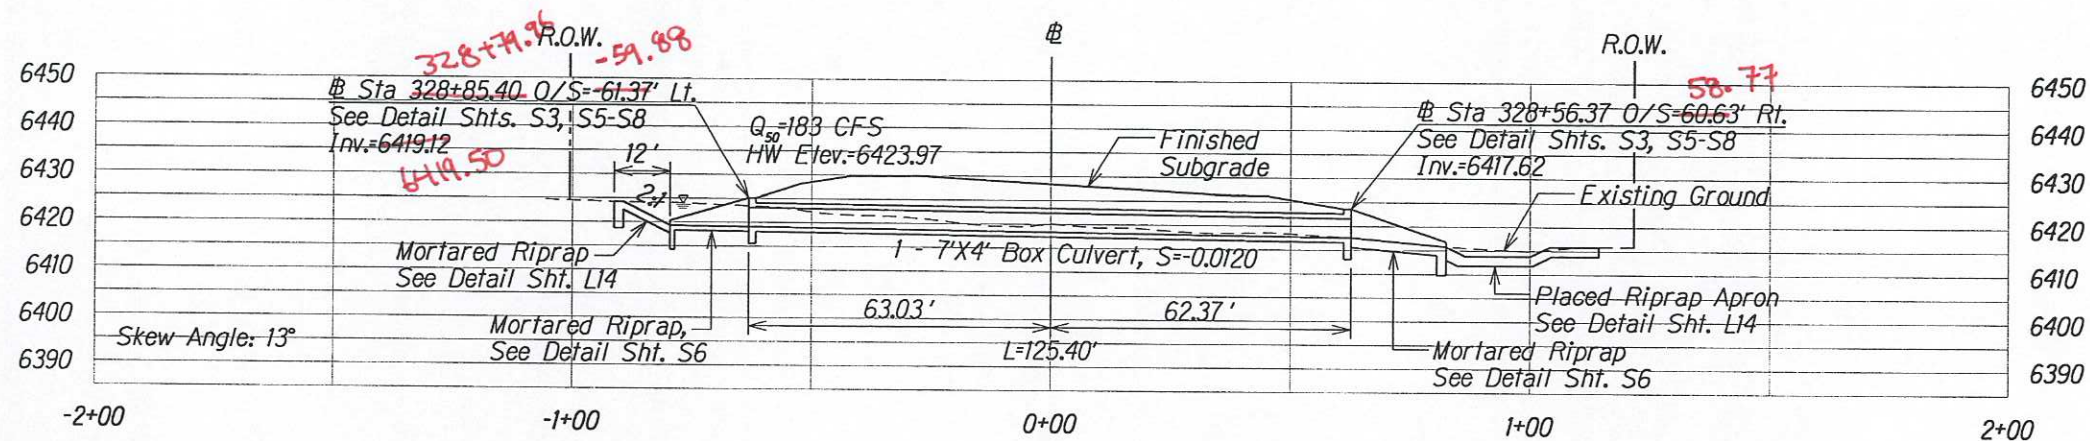

CULVERT 28 @ STA 328+71

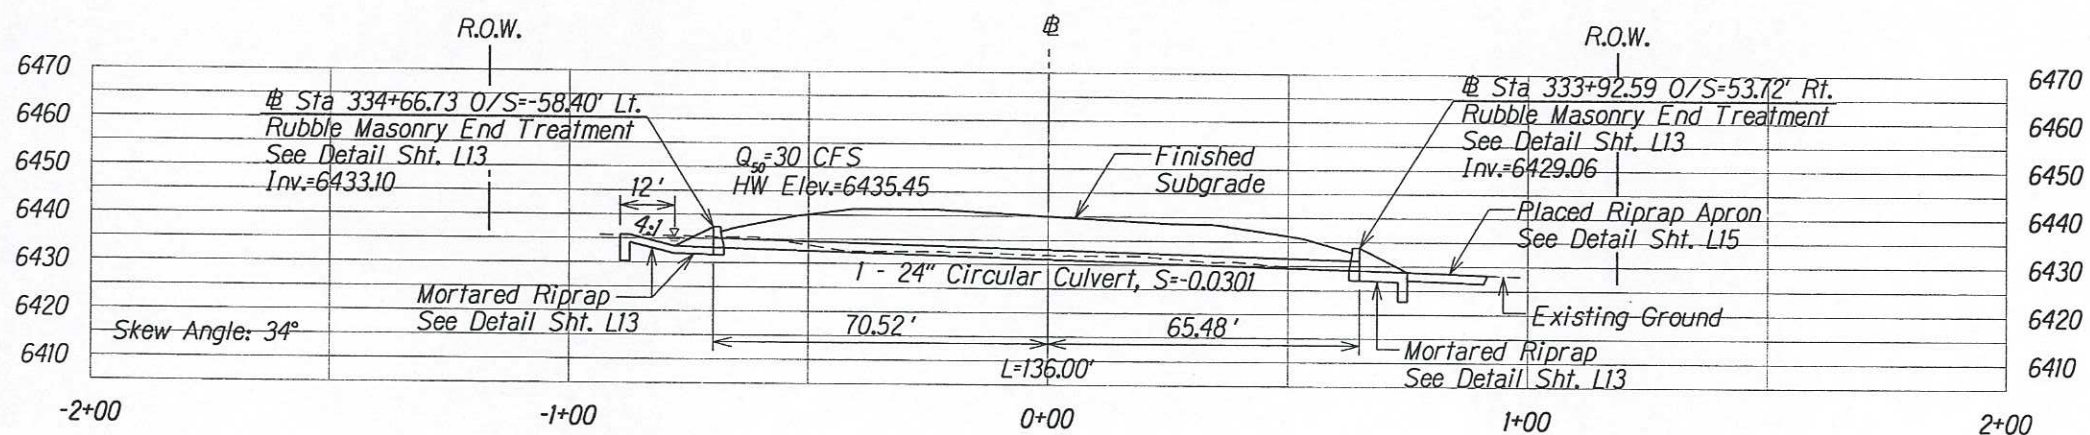

CULVERT 29 @ STA 334+29

BRUCE K. MEYERS
Licensed Professional Engineer
No. 8336-C
HAWAII, U.S.A.

The work was prepared by me or under my supervision and construction of this project will be under my observation.
Expiration Date of License 12/08

U.S. DEPARTMENT OF TRANSPORTATION
FEDERAL HIGHWAY ADMINISTRATION
CENTRAL FEDERAL LANDS HIGHWAY DIVISION



**LONGITUDINAL
CULVERT SECTIONS**

Scale: 1"=40' Date: June 29, 2007


SHEET No. 3 OF 4

M:\Mproj\Lenntle\204028\100%\sheets\sh1003.dgn

STATE	SADDLE ROAD PROJECT	SHEET NO.	TOTAL SHEETS
HI	HI A-AD 6(4)	L4	L15

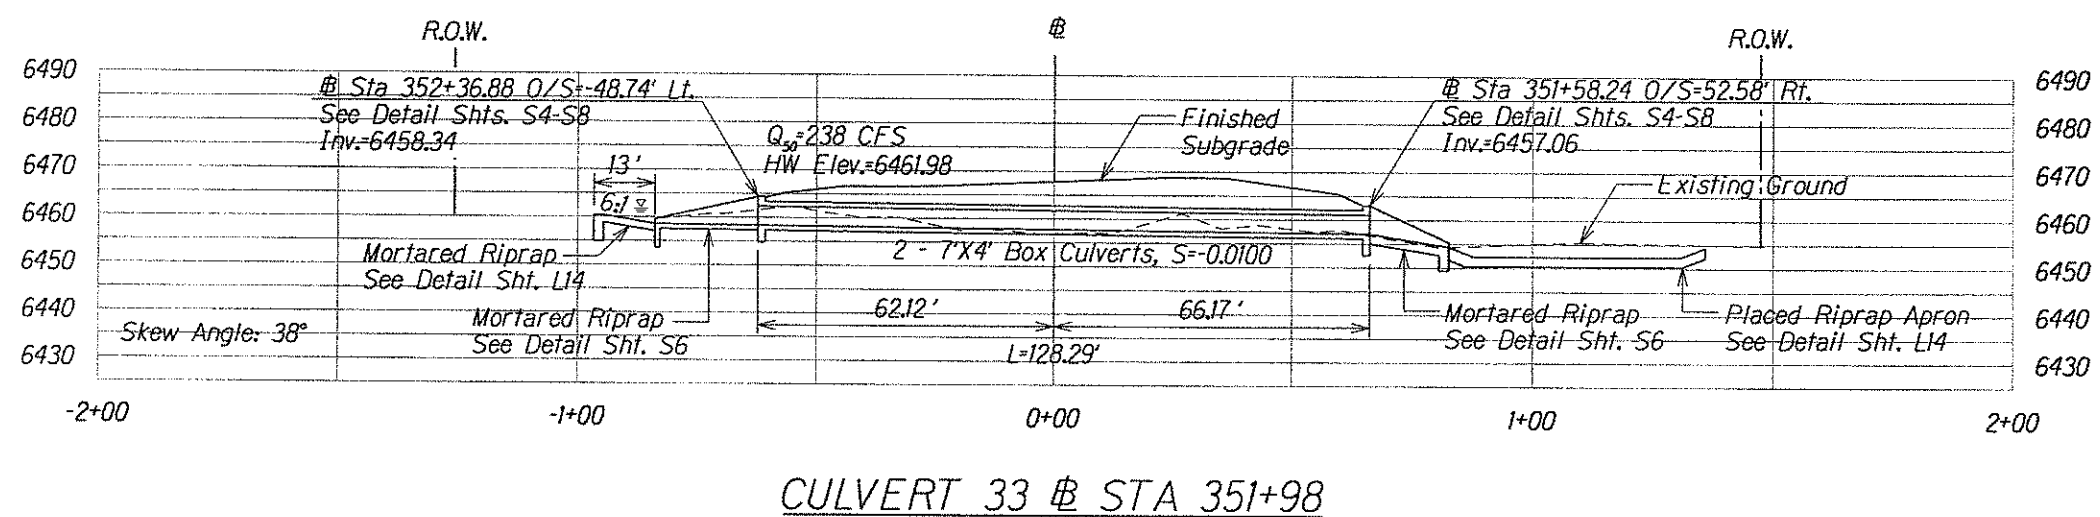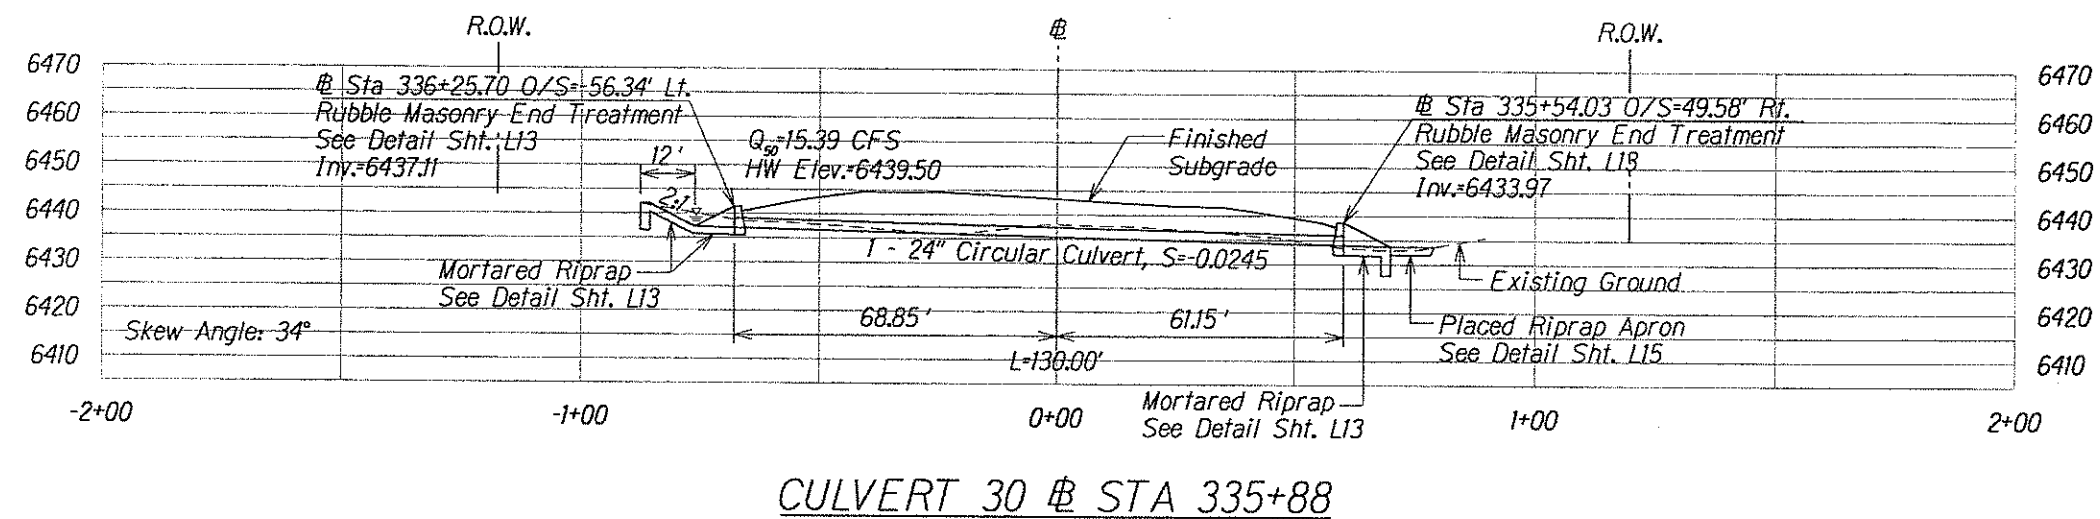

M:\Mpro1\Lenmie\204028\100%\sheets\sh1004.dgn

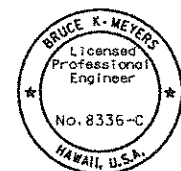

The work was prepared by me or under my supervision and construction of this project will be my responsibility.

Expiration Date of License 4/08.

U.S. DEPARTMENT OF TRANSPORTATION
FEDERAL HIGHWAY ADMINISTRATION
CENTRAL FEDERAL LANDS HIGHWAY DIVISION

**LONGITUDINAL
CULVERT SECTIONS**

Scale: 1"=40' Date: June 29, 2007

SHEET No. 4 OF 4