



STATE	SADDLE ROAD PROJECT	SHEET NO.	TOTAL SHEETS
HI	HI A-AD 6(4)	C4	C9

MASSHAIL DIAGRAM

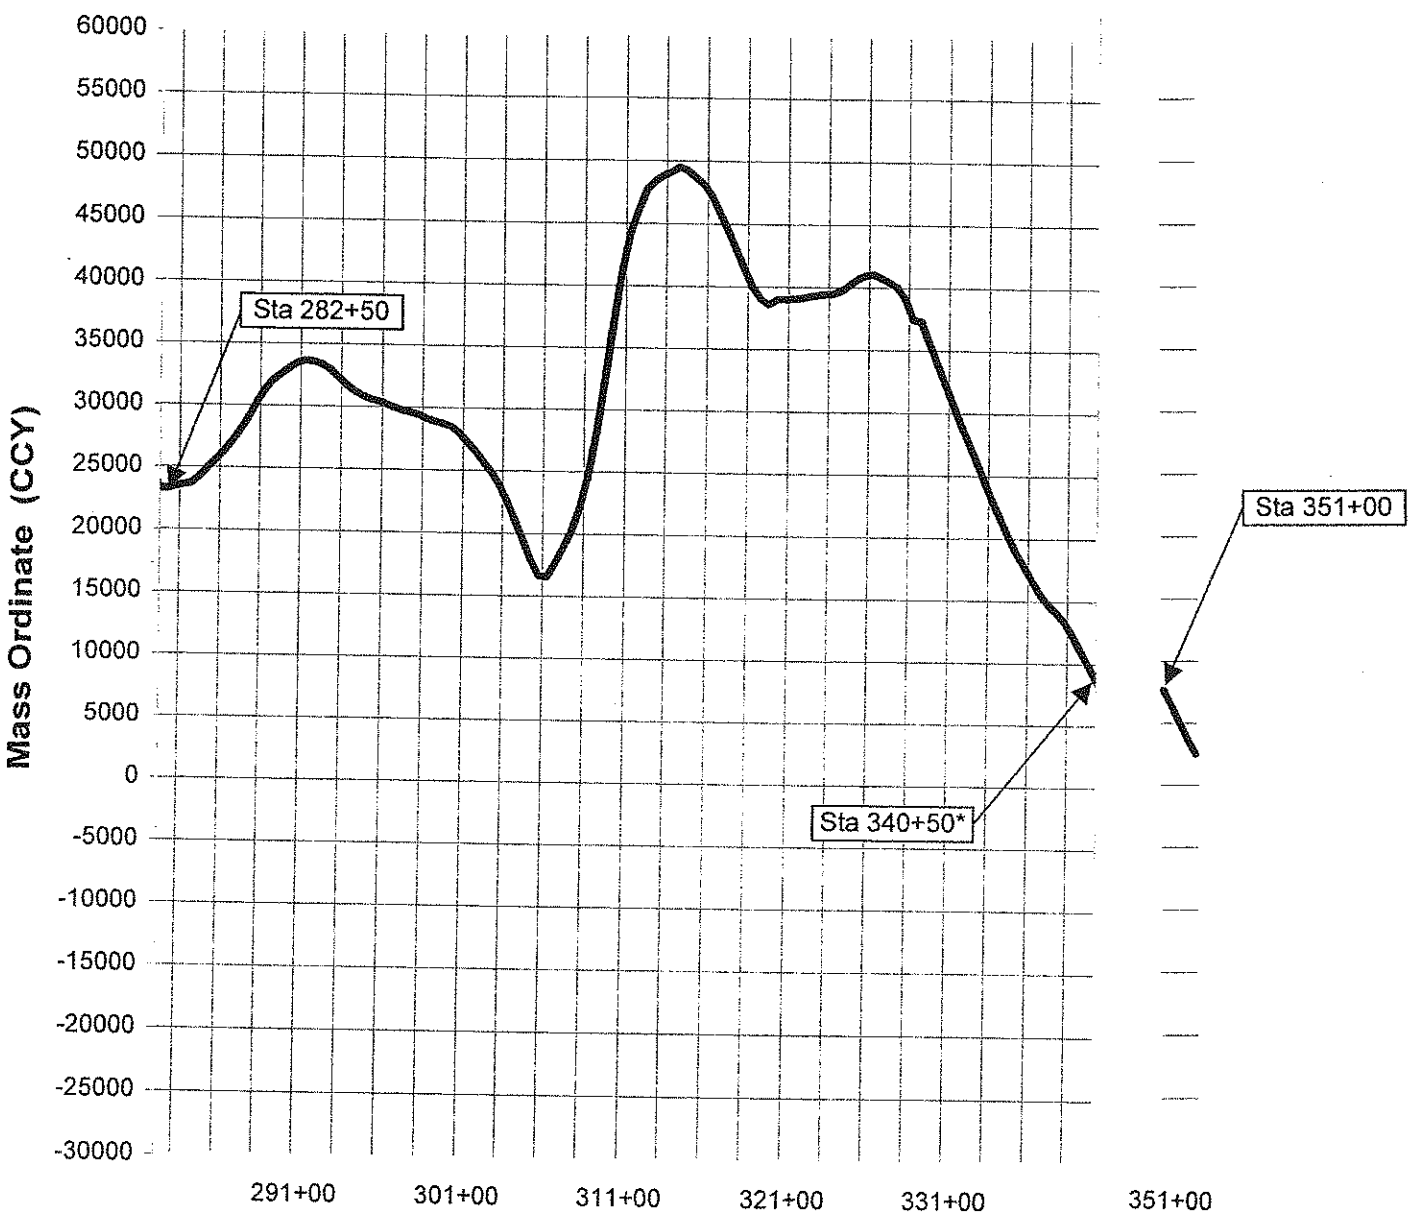

*The sections between stations 88+75 and 282+50 and 340+50 and 351+00 are previously constructed sections.

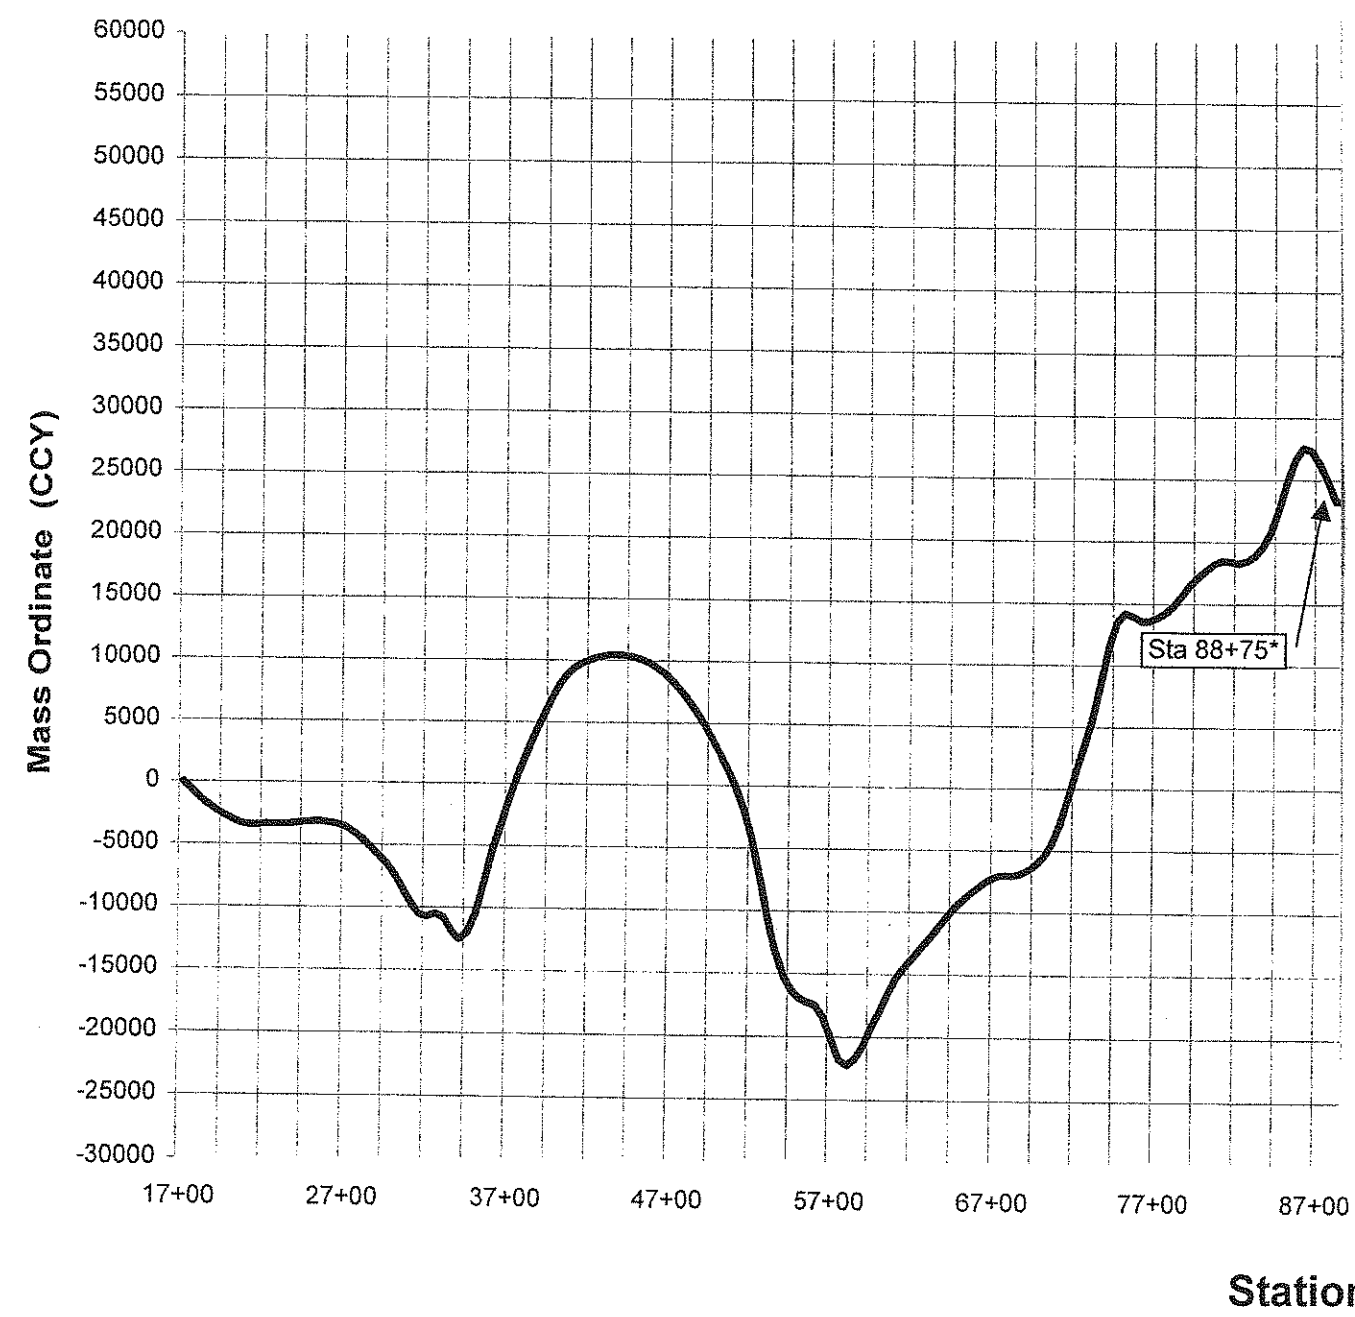