
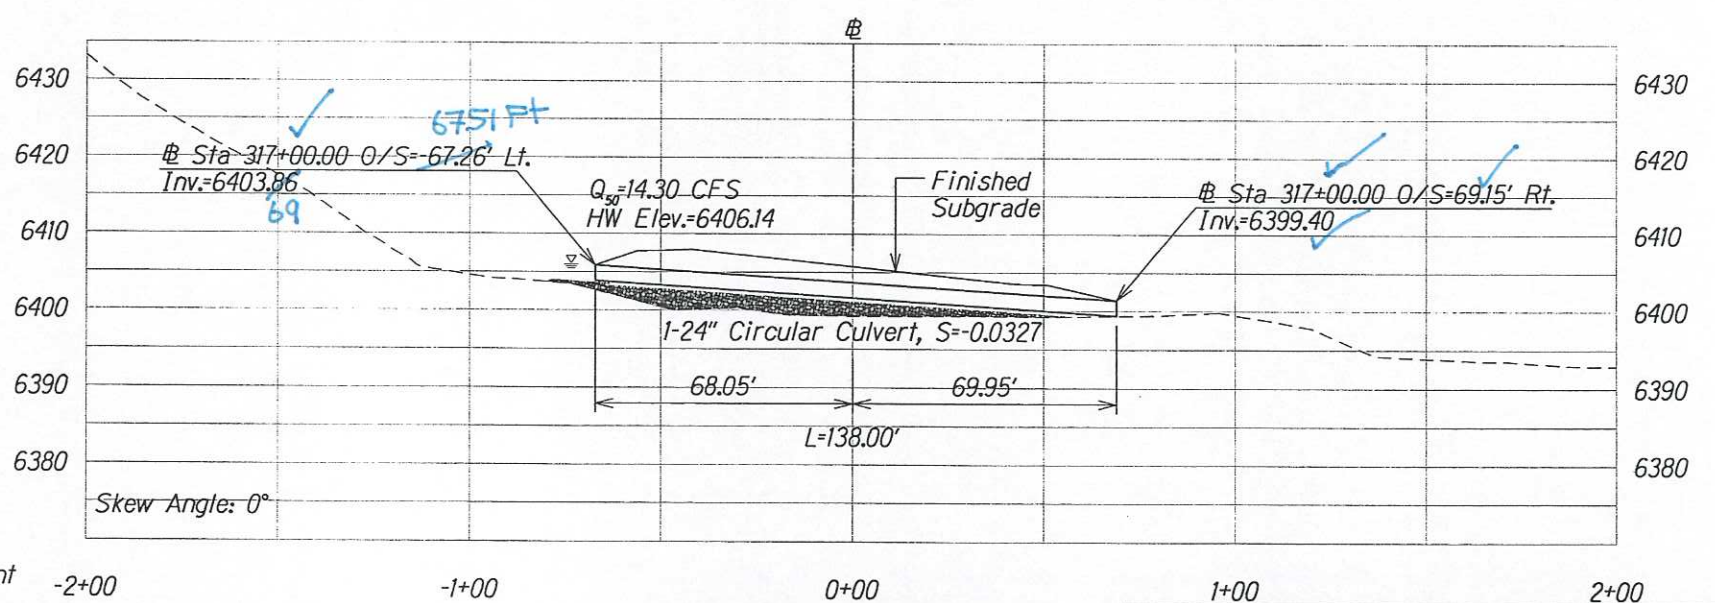
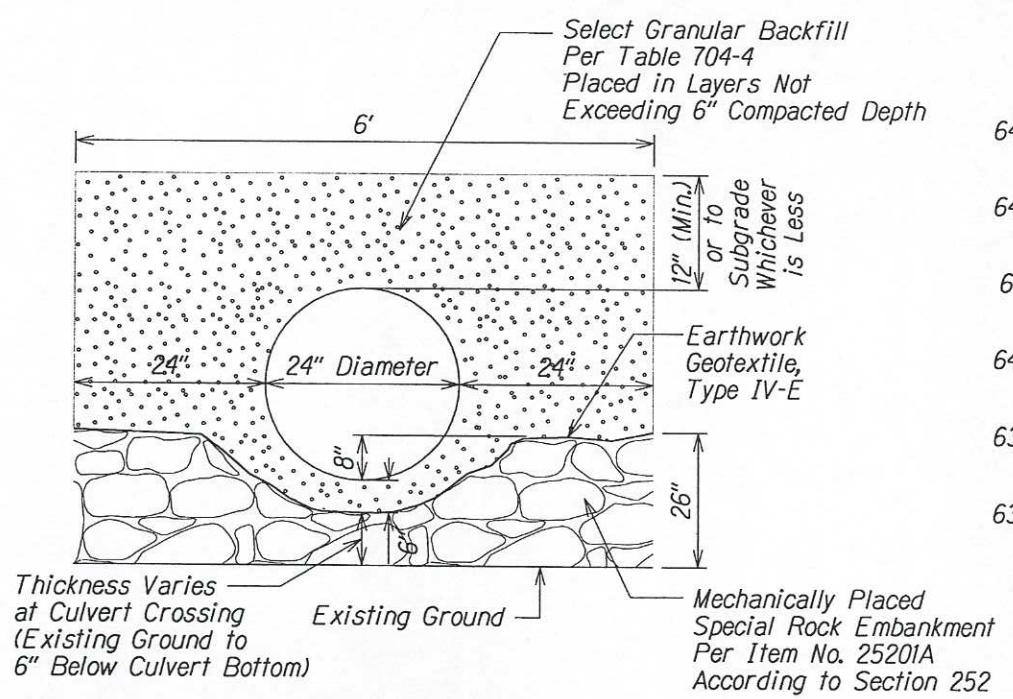


STATE	SADDLE ROAD PROJECT	SHEET NO.	TOTAL SHEETS
HI	HI A-AD 6(4)	G3	G5

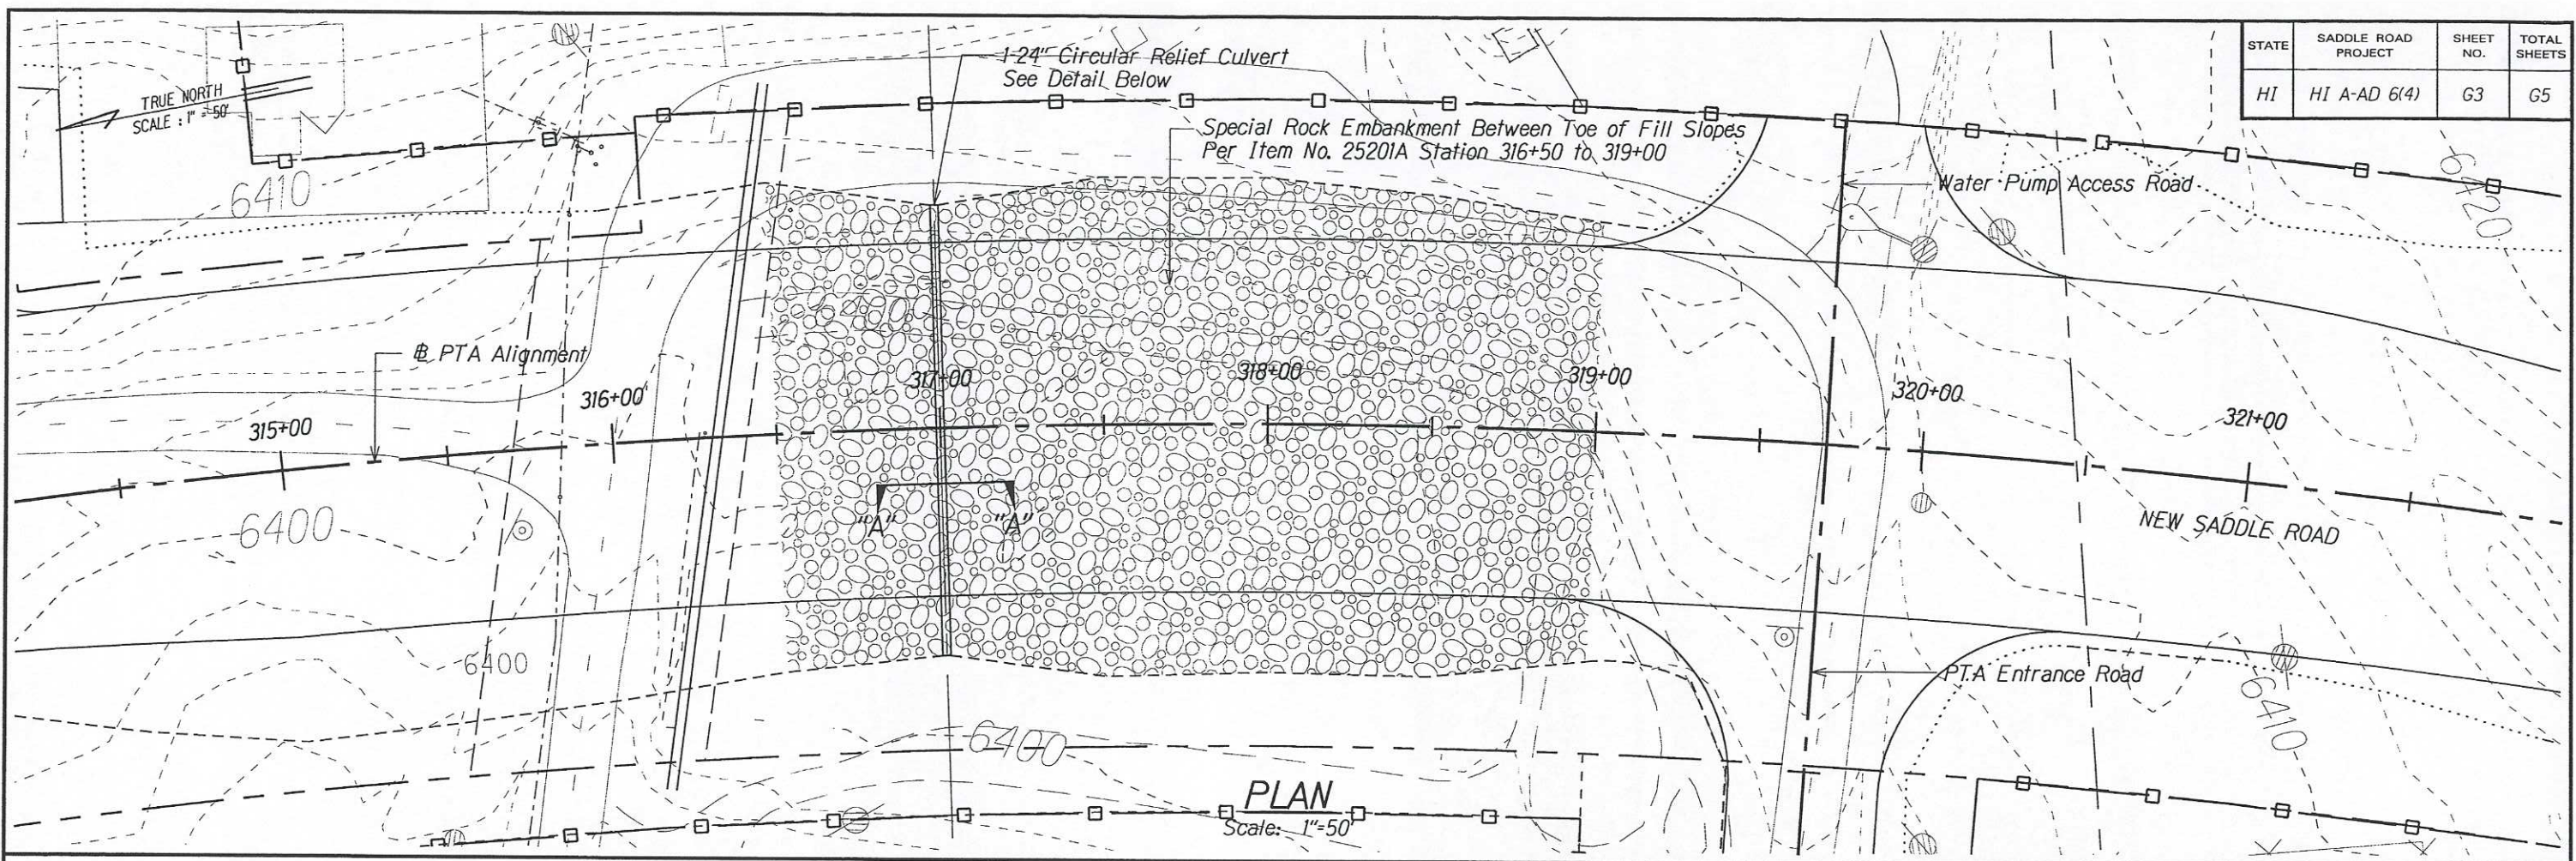

**SECTION A-A
ROCK EMBANKMENT
CULVERT INSTALLATION**
Not to Scale

**STATION 317+00
24" RELIEF CULVERT
LONGITUDINAL SECTION**
Scale: Horiz. 1"=50'
Vert. 1"=25'

BRUCE K. MEYERS
Licensed Professional Engineer
No. 8336-C
HAWAII, U.S.A.

The work was prepared by me or under my supervision and construction of this project will be under my observation.

Expiration Date of License 4/08

U.S. DEPARTMENT OF TRANSPORTATION
FEDERAL HIGHWAY ADMINISTRATION
CENTRAL FEDERAL LANDS HIGHWAY DIVISION

**SPECIAL ROCK EMBANKMENT
STA 316+50 TO 319+00**

Scale: As Noted Date: June 29, 2007

SHEET No. 1 OF 1

M:\Mproj\Lenzie\204028\100%\sheets\shg003.dgn