



STATE	SADDLE ROAD PROJECT	SHEET NO.	TOTAL SHEETS
HI	HI A-AD/STP 6(3) # 200(1)	L1	L16

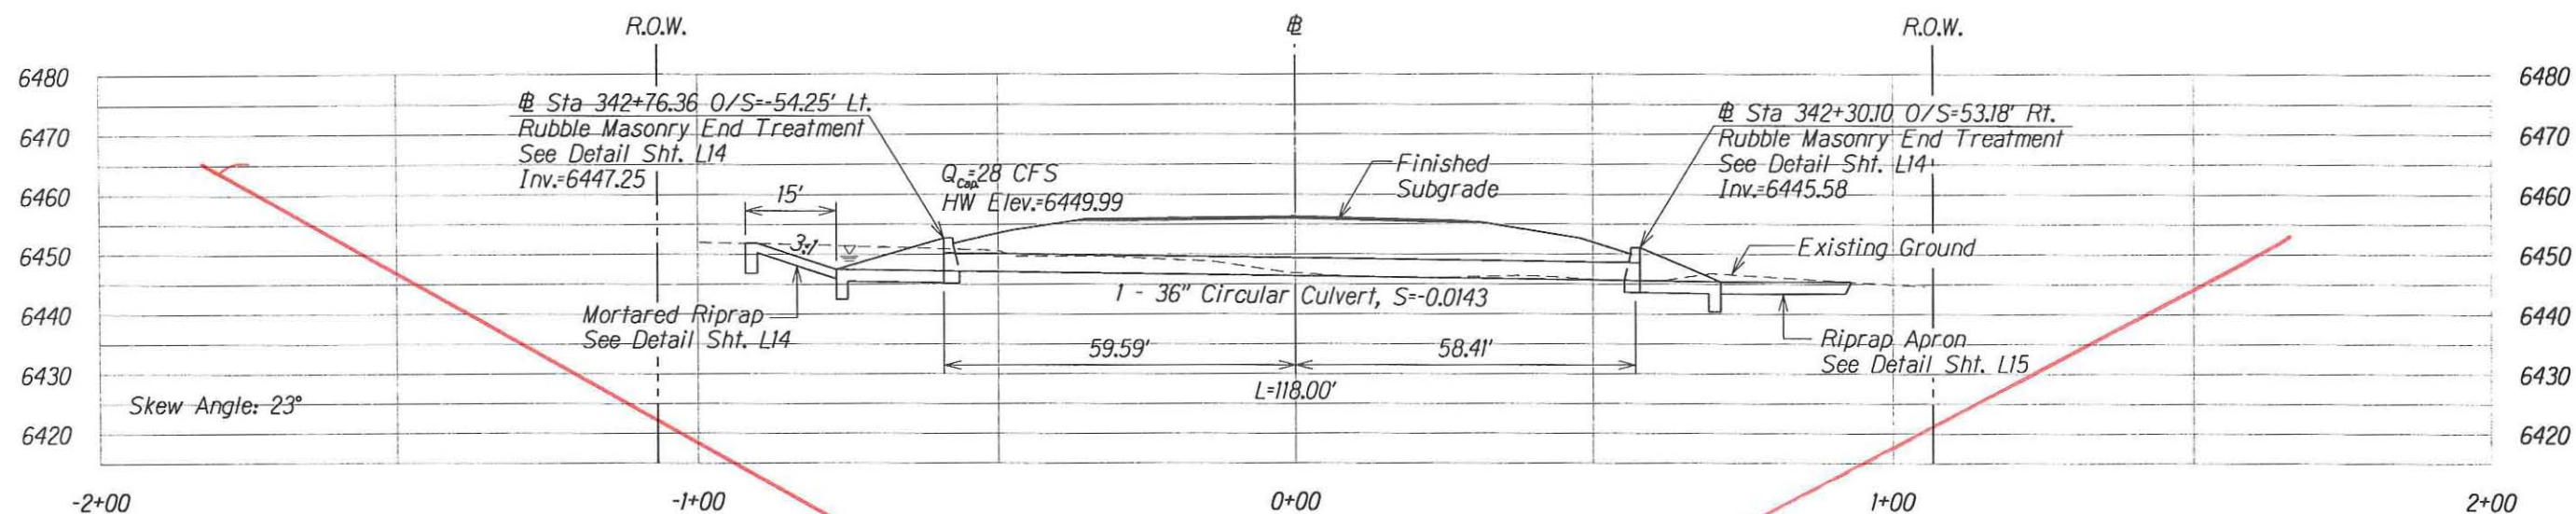




CULVERT 31 @ STA 342+53

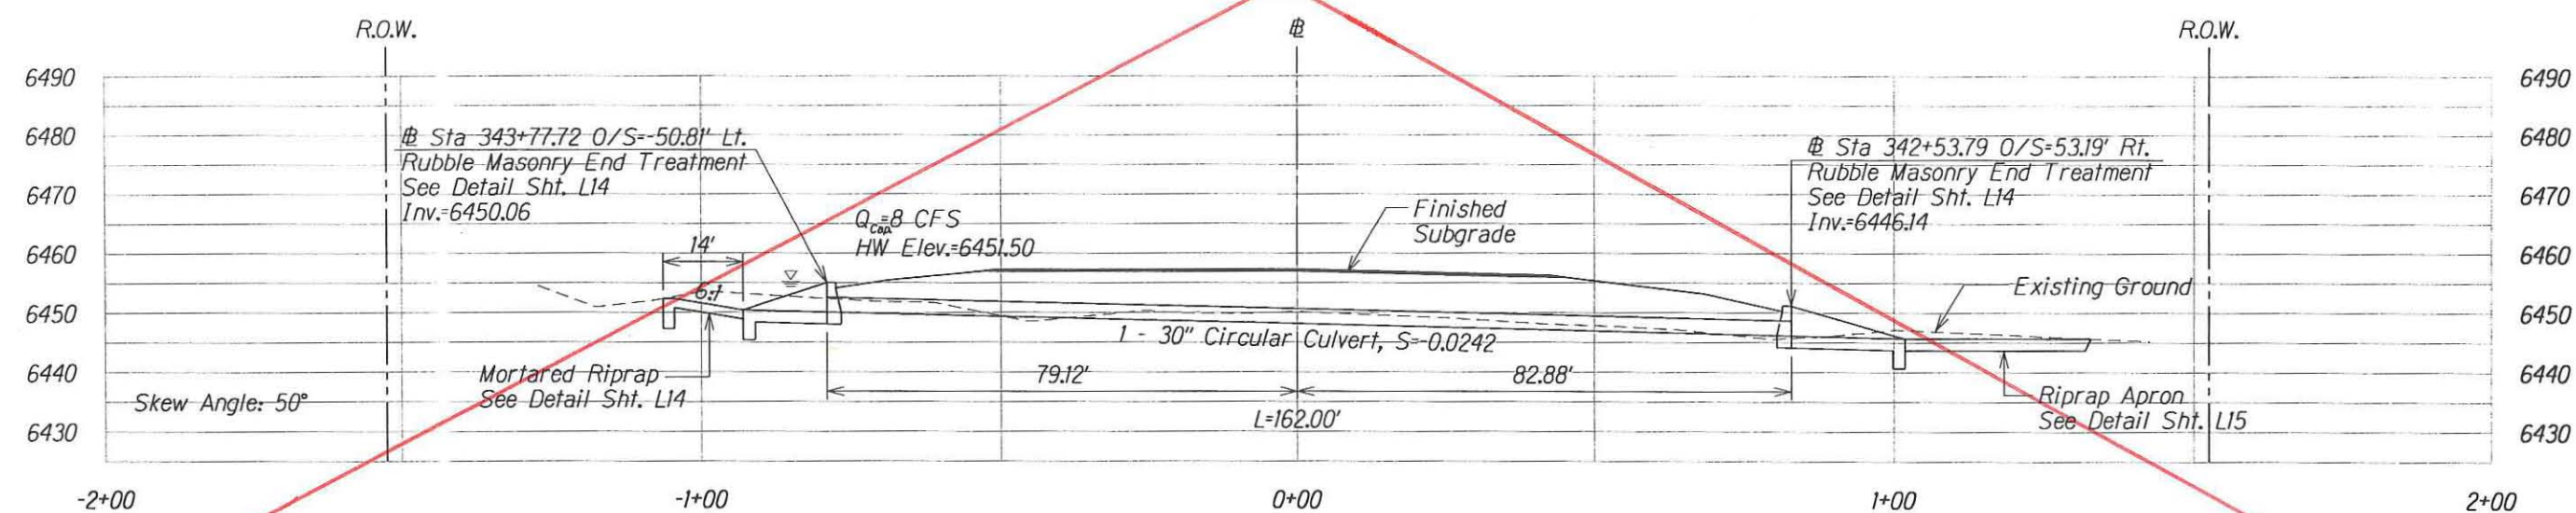

CULVERT 32 @ STA 343+17

 The work was prepared by me or under my supervision and construction of this project will be under my direction. Expiration Date of License: 1/06	U.S. DEPARTMENT OF TRANSPORTATION FEDERAL HIGHWAY ADMINISTRATION CENTRAL FEDERAL LANDS HIGHWAY DIVISION
	LONGITUDINAL CULVERT SECTIONS
Scale: 1"=30'	Date: December 5, 2005
SHEET No. 1 OF 4	

STATE	SADDLE ROAD PROJECT	SHEET NO.	TOTAL SHEETS
HI	HI A-AD/STP 6(3) # 200(1)	L2	L16

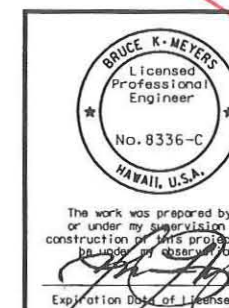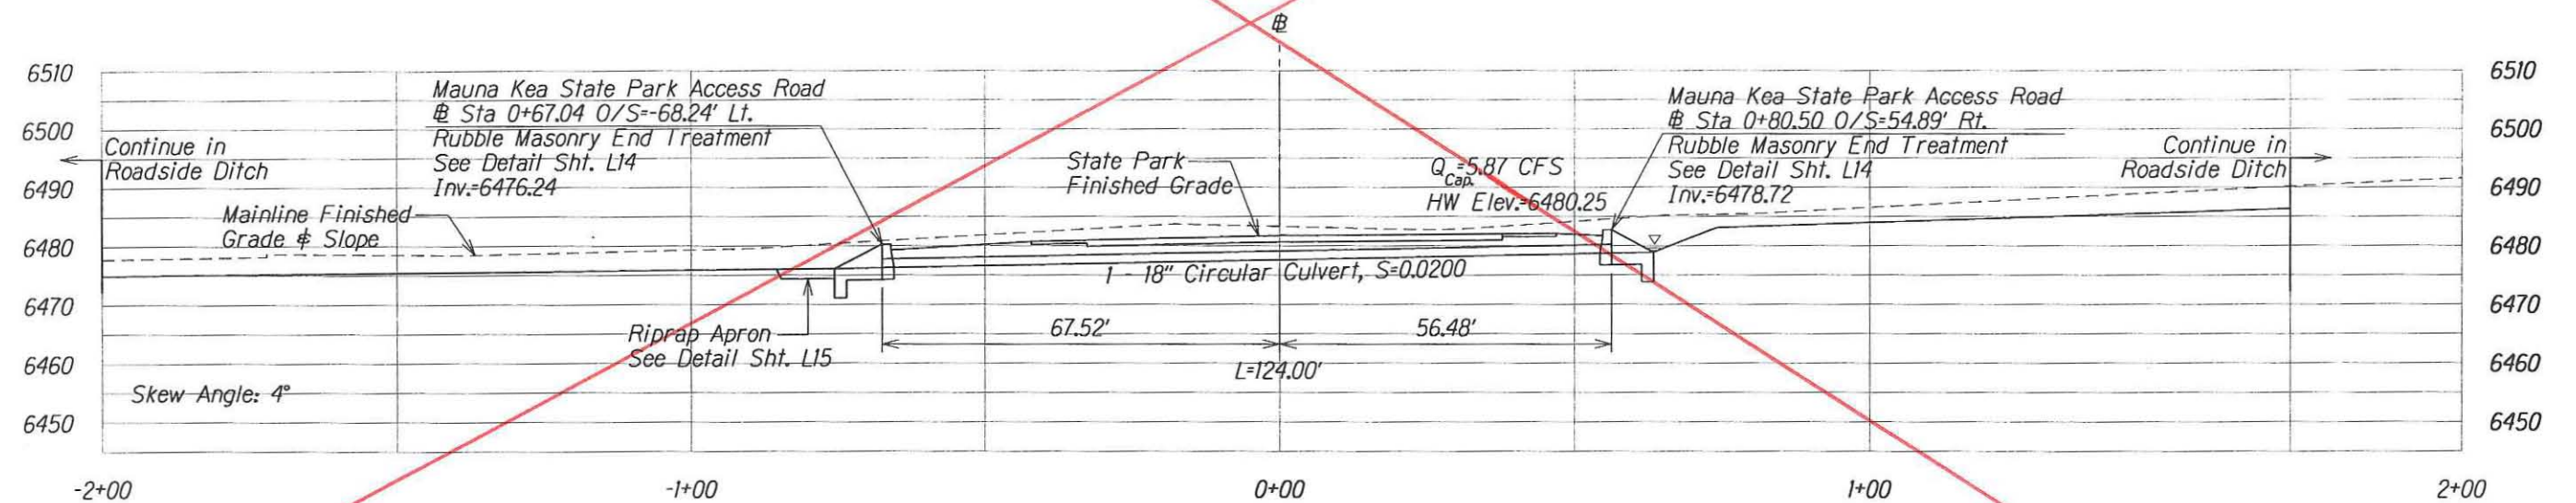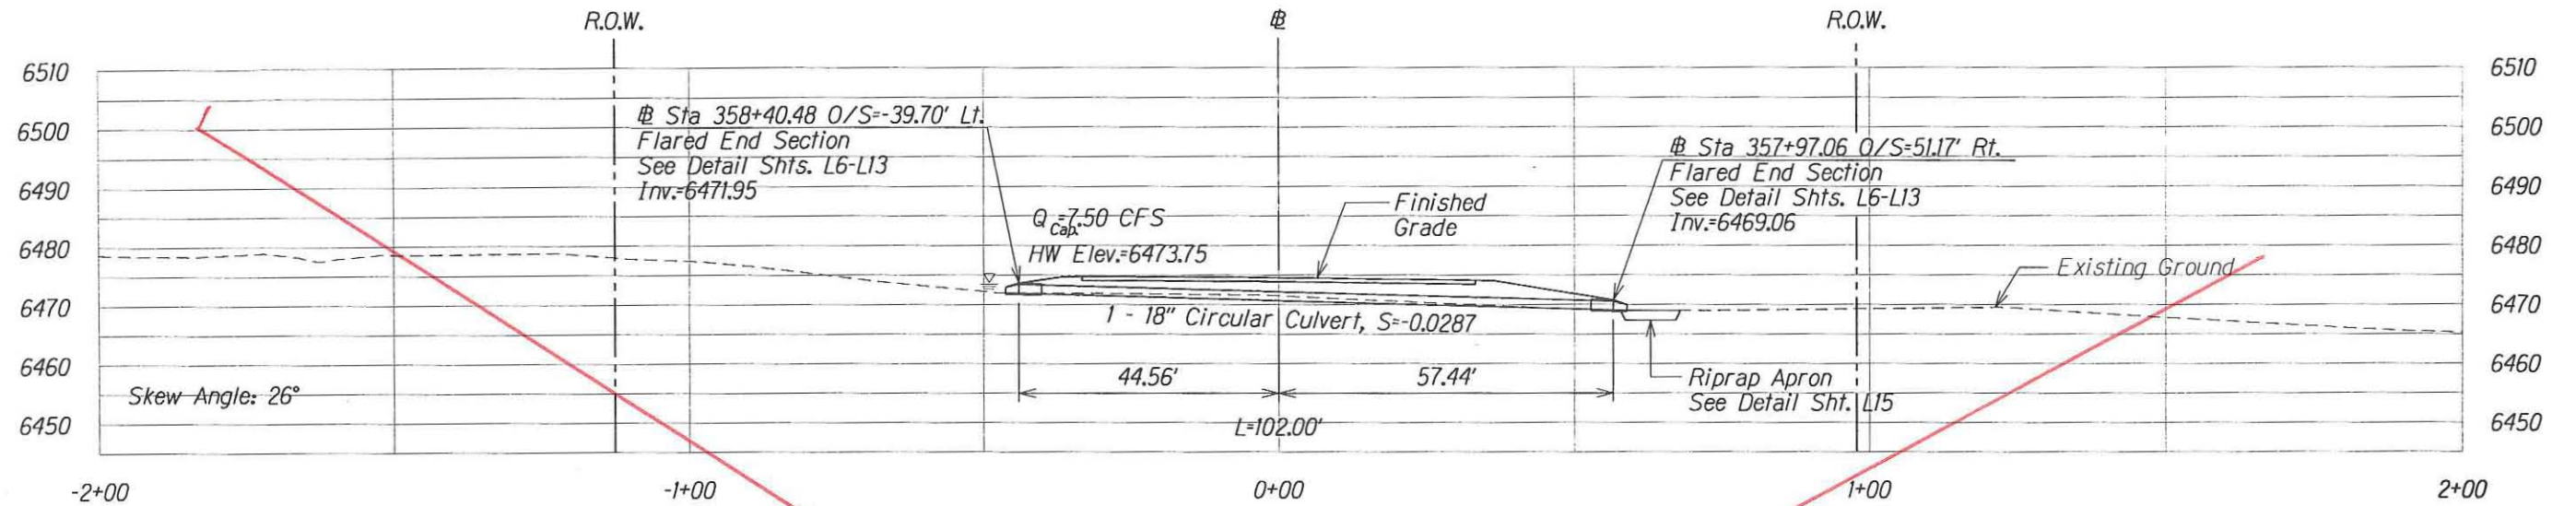

U.S. DEPARTMENT OF TRANSPORTATION
FEDERAL HIGHWAY ADMINISTRATION
CENTRAL FEDERAL LANDS HIGHWAY DIVISION



LONGITUDINAL CULVERT SECTIONS

Scale: 1"=30'

Date: December 5, 2005


SHEET No. 2 OF 4

STATE	SADDLE ROAD PROJECT	SHEET NO.	TOTAL SHEETS
HI	HI A-AD/STP 6(3) # 200(1)	L4	L16

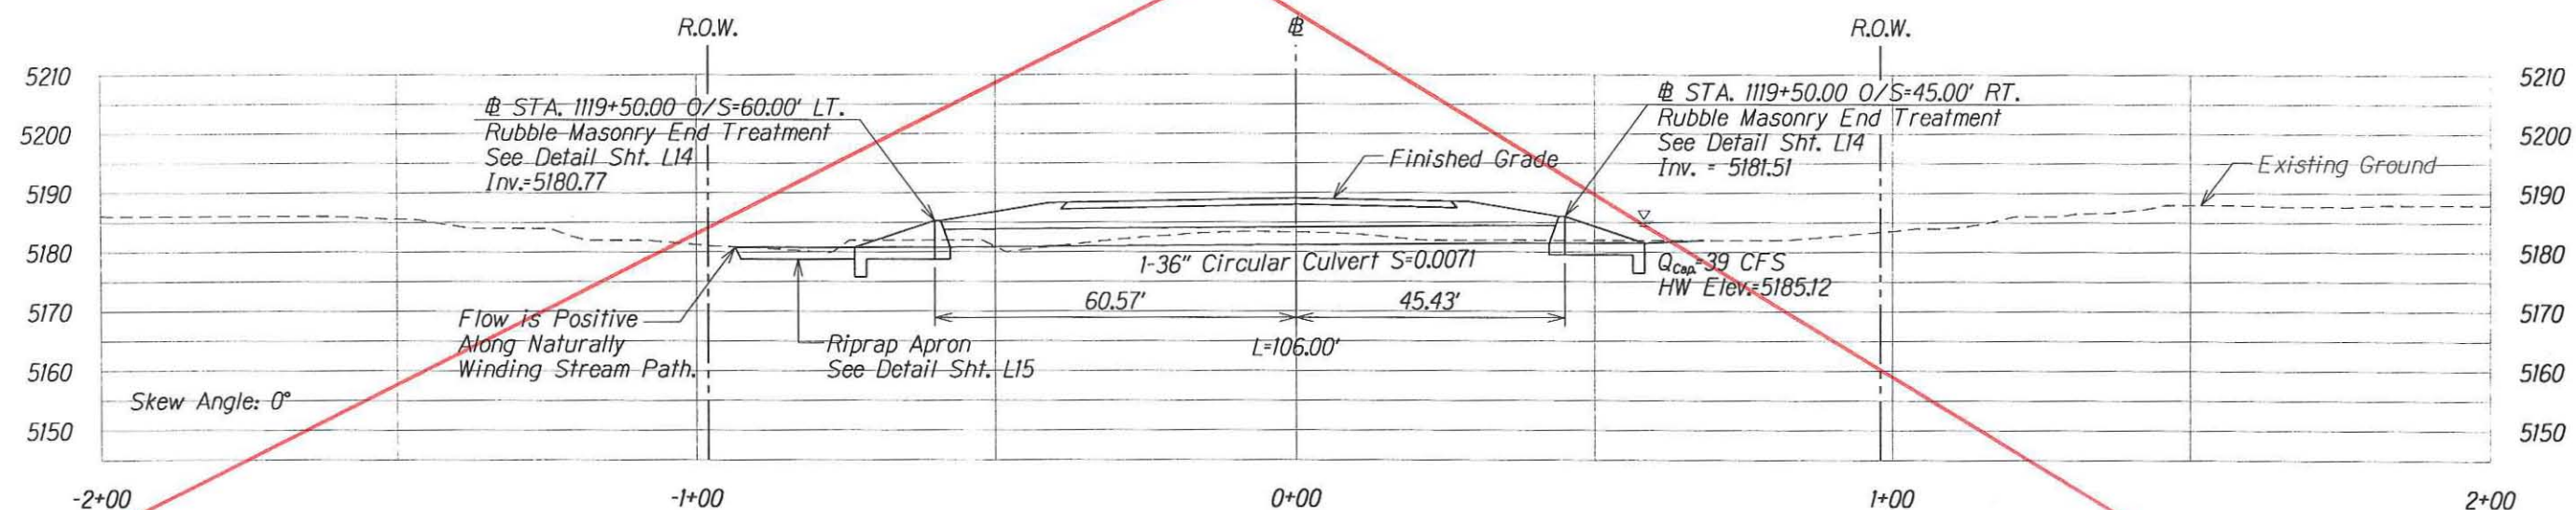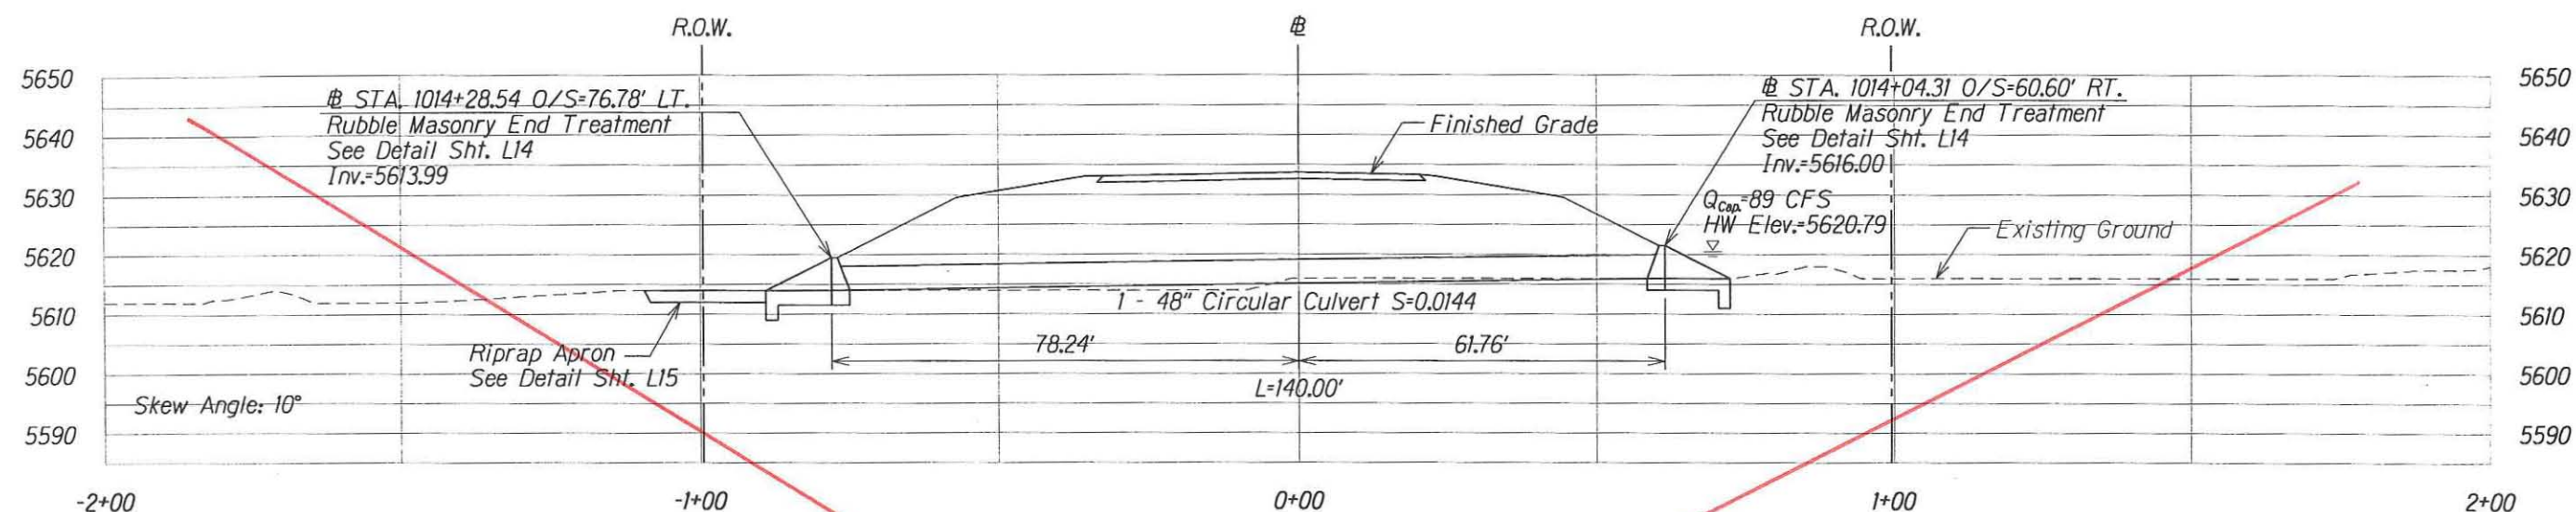

CULVERT 58 @ STA 1014+15

CULVERT 59 @ STA 1119+50

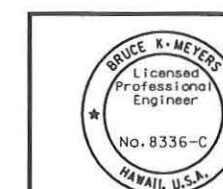

The work was prepared by me or under my supervision and construction of this project will be under my observation.
Expiration Date of License 4/06

U.S. DEPARTMENT OF TRANSPORTATION
FEDERAL HIGHWAY ADMINISTRATION
CENTRAL FEDERAL LANDS HIGHWAY DIVISION


LONGITUDINAL
CULVERT SECTIONS

Scale: 1"=30'


Date: December 5, 2005

SHEET No. 4 OF 4

STATE	SADDLE ROAD PROJECT	SHEET NO.	TOTAL SHEETS
HI	HI A-AD/STP 6(3) # 200(1)	L5	L16

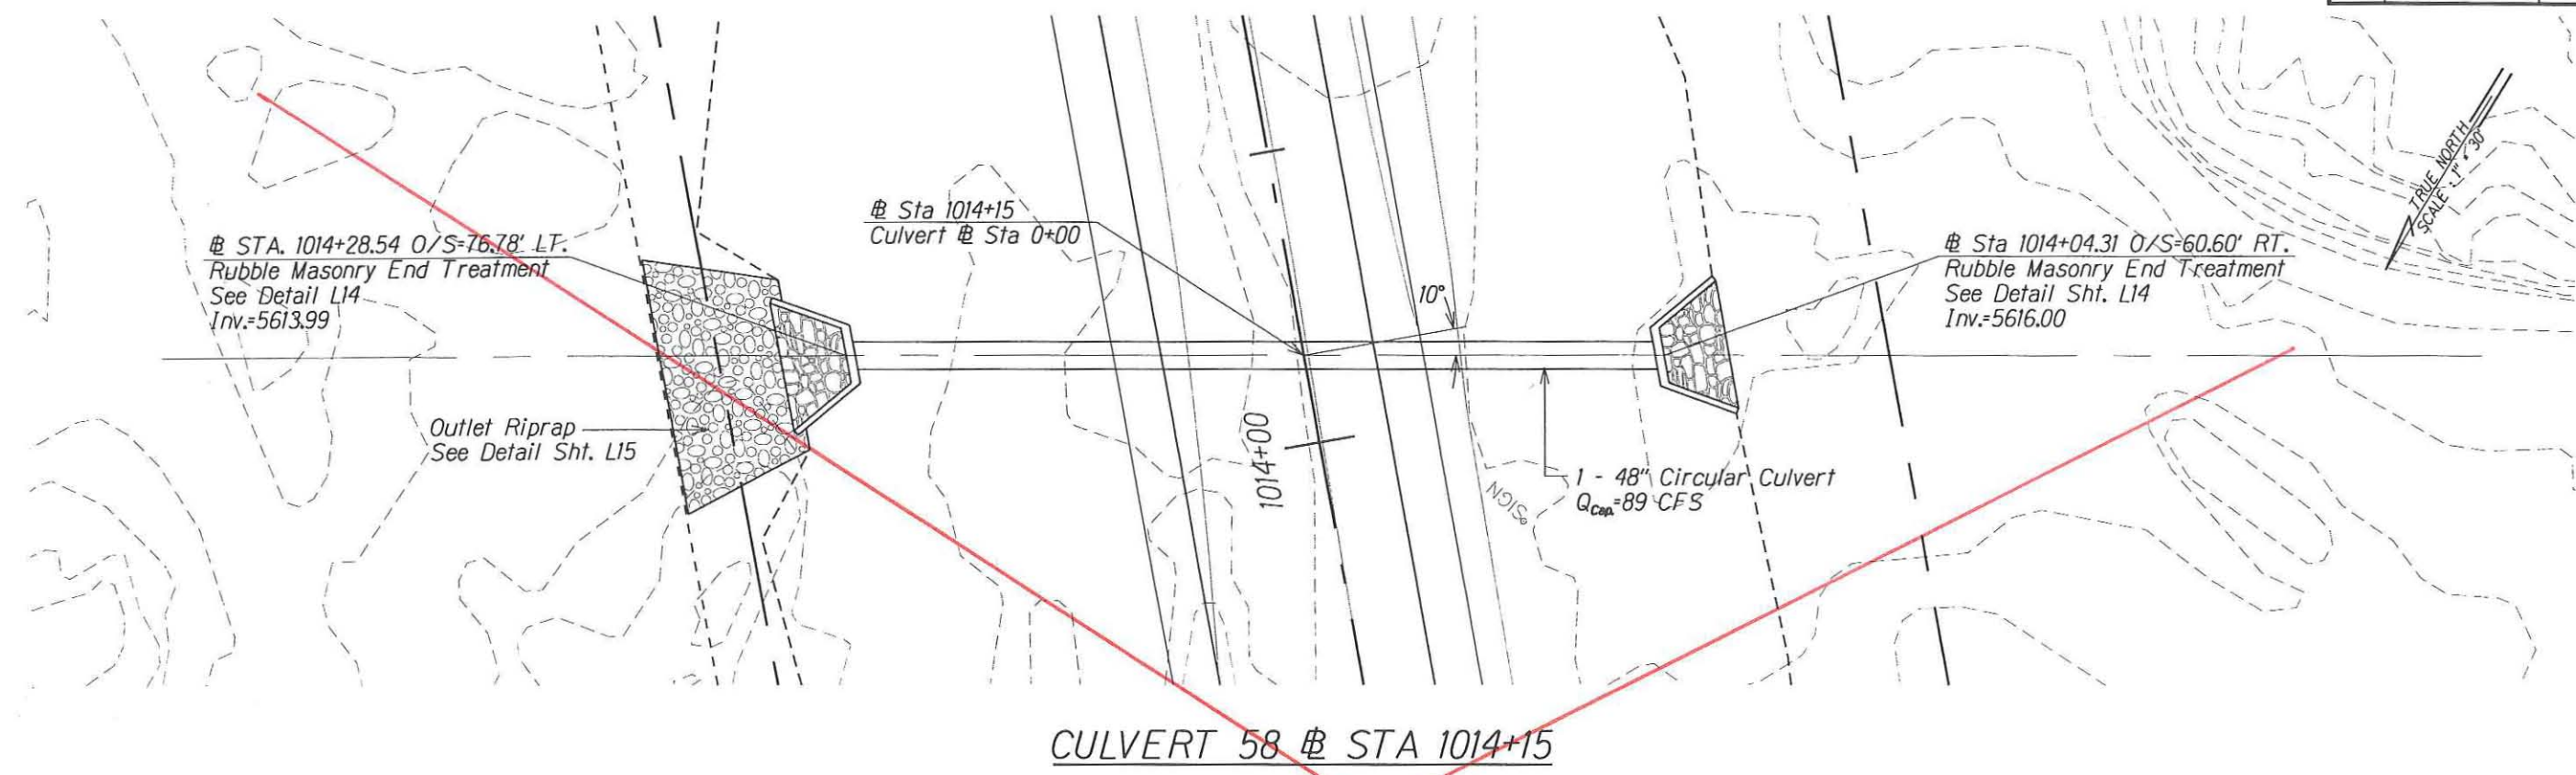

CULVERT 58 @ STA 1014+15

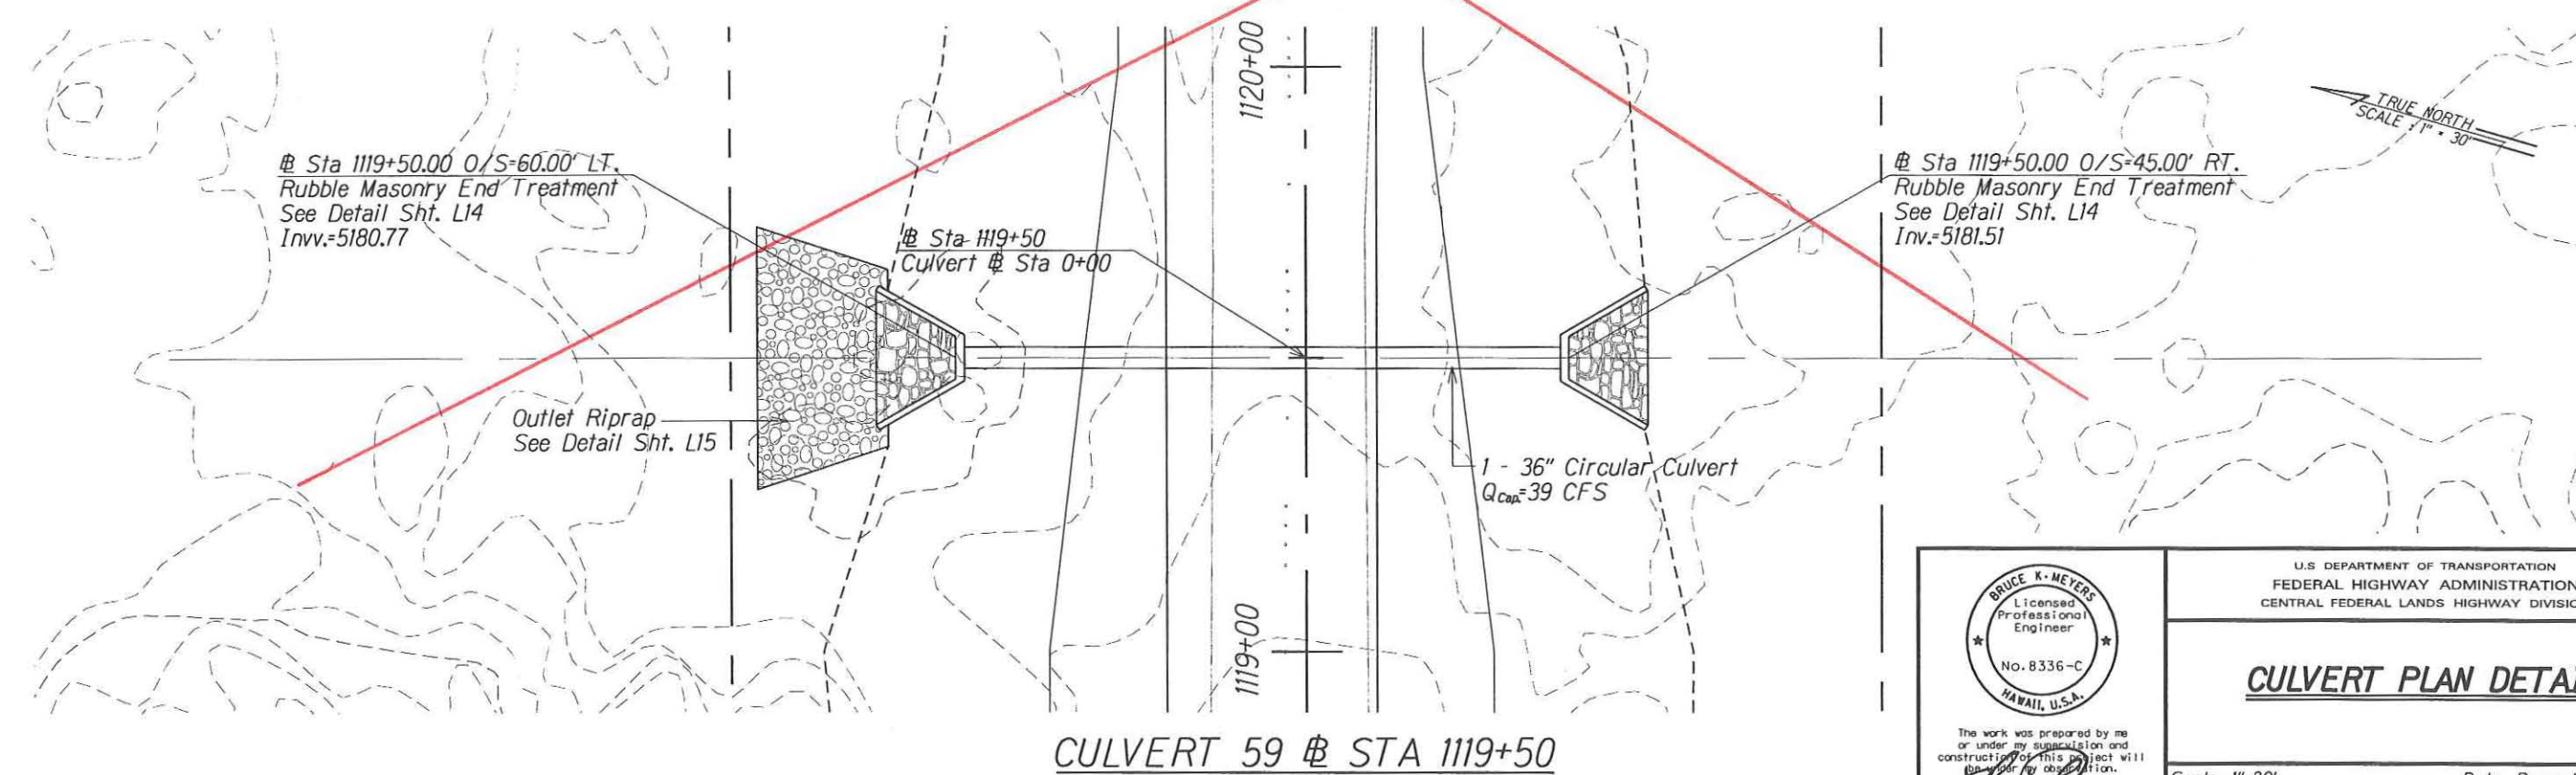

CULVERT 59 @ STA 1119+50

BRUCE K. MEYERS
Licensed Professional Engineer
No. 8336-C
HAWAII, U.S.A.

The work was prepared by me or under my supervision and construction of this project will be under my observation.

Expiration Date of License: 12/06

U.S. DEPARTMENT OF TRANSPORTATION
FEDERAL HIGHWAY ADMINISTRATION
CENTRAL FEDERAL LANDS HIGHWAY DIVISION

CULVERT PLAN DETAIL

Scale: 1"=30' Date: December 5, 2005

SHEET No. 1 OF 1

M:\Mproj\Lennie\205009\sheets\sh11005.dgn