

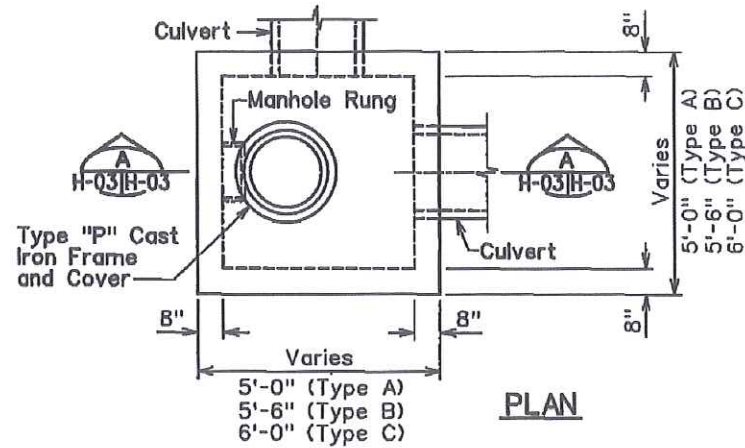


PLAN VIEW OF WALL SECTION

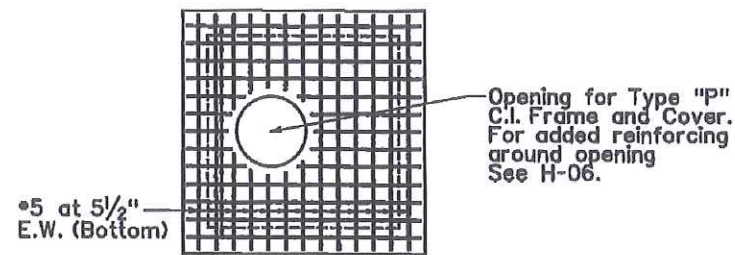

PLAN VIEW OF TOP SLAB REINFORCING

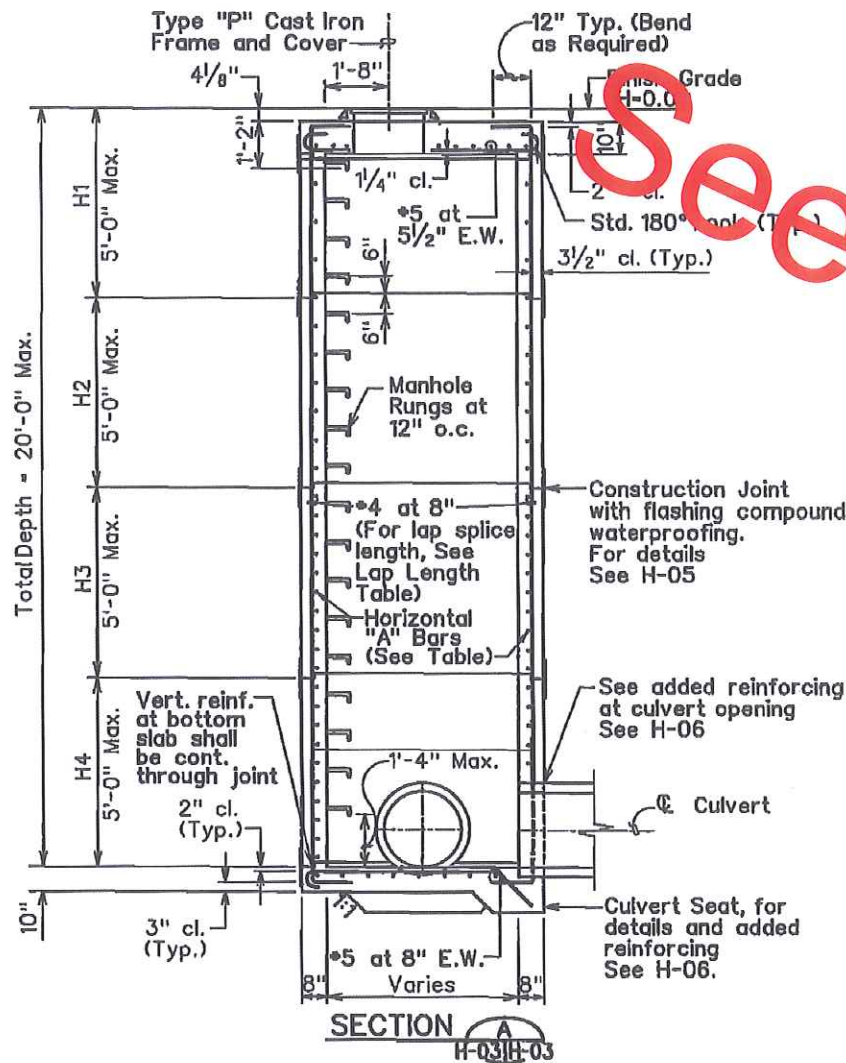

HORIZONTAL "A" BARS FOR STORM DRAIN MANHOLE	
SDMH DEPTH	HORIZONTAL "A" BARS
H1 0'-0" to 5'-0"	#5 at 10"
H2 5'-1" to 10'-0"	#5 at 8"
H3 10'-1" to 15'-0"	#5 at 6"
H4 15'-1" to 20'-0"	#5 at 6"

VERT. BAR LAP SPLICE	
BAR	VERT. LAP LENGTH
#4	1'-8"
#5	2'-2"

- General Notes:
- General Criteria:
 - At-rest Horizontal Pressure = 80 pcf (2 to 1 sloping backfill, above groundwater)
 - At-rest Vertical Pressure = 40 pcf (2 to 1 sloping backfill, above groundwater)
 - Allowable Bearing Capacity = 1,700 psf + 8 x (overburden pressure); where overburden pressure equals 100 pcf x H
 - Live Load Surcharge (Equivalent Height of Soil)
For H = 0' to 5'; head = 4'-0"
For H = 5' to 20'; head = 10'-0"
 - Exposure Factor (For Crack Control) = 1.0 for Class 1 exposure

DATE	REVISION	APP'D.
X	X	

STATE OF HAWAII
DEPARTMENT OF TRANSPORTATION
HIGHWAYS DIVISION

STANDARD PLAN H-03

TYPE A, B, AND C

STORM DRAIN MANHOLE



THIS WORK WAS PREPARED BY ME OR UNDER MY SUPERVISION.

Wendy G. McLain 4/30/2012

SIGNATURE EXPIRATION DATE OF THE LICENSE



STANDARD PLAN H-03 05/31/07

U.S. DEPARTMENT OF TRANSPORTATION
FEDERAL HIGHWAY ADMINISTRATION
FEDERAL LANDS HIGHWAY

U.S. CUSTOMARY SPECIAL
(HDOT STD H-03)
TYPE A, B AND C
STORM DRAIN MANHOLE

NO SCALE

SPECIAL
604-A

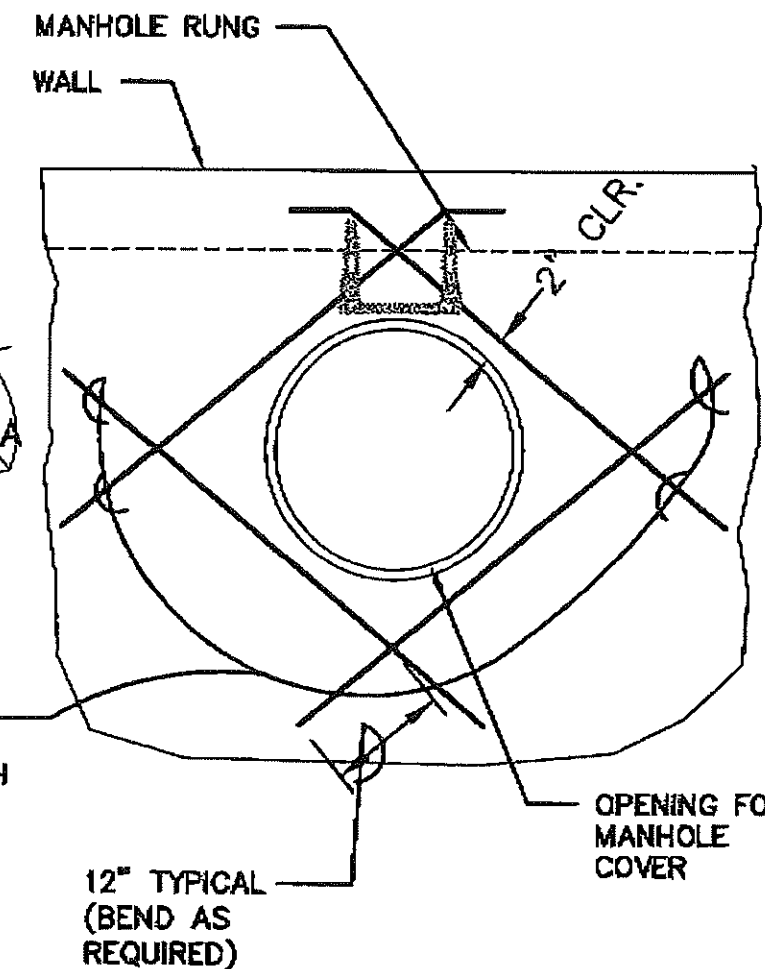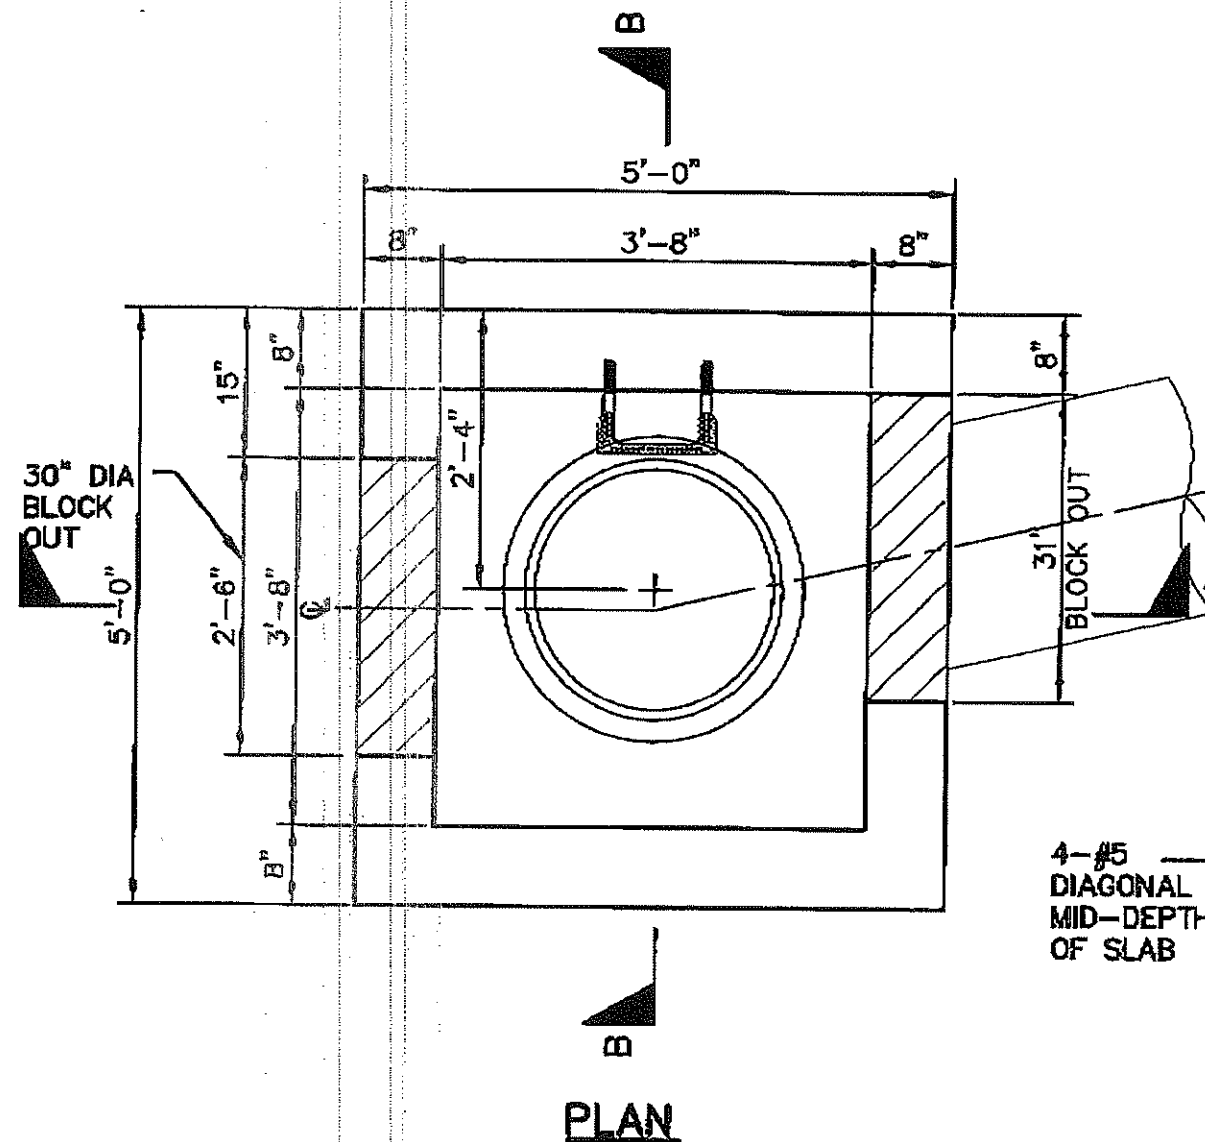


NOTES:

- 1 CONCRETE SHALL HAVE A COMPRESSIVE STRENGTH OF 5,000 P.S.I. AT 28 DAYS.
- 2 ALL REINFORCING STEEL SHALL BE NEW STOCK DEFORMED BARS CONFORMING TO ASTM A706W GRADE 60 UNLESS OTHERWISE NOTED. PLACEMENT OF REBARS SHALL BE IN ACCORDANCE WITH ACI-315 & ACI-318. ALL BARS SHALL BE CLEAN OF RUST, GREASE OR OTHER MATERIALS LIKELY TO IMPAIR BOND. ALL BENDS SHALL BE MADE COLD.
- 3 ALL REINFORCING BARS SHALL BE ACCURATELY & SECURELY PLACED. ALL REINFORCING SHALL BE LAPPED 40 BAR DIAMETERS OR EIGHTEEN (18) INCHES, WHICHEVER IS GREATER AT SPLICES. ALL SPLICES SHALL BE MADE AWAY FROM POINT OF MAXIMUM STRESS. 4. CONCRETE COVER TO REINFORCING STEEL SHALL BE 1-1/2" MINIMUM.
- 5 NON-TRAFFIC APPLICATION ONLY
- 6 BLOCKOUTS DIAMETER SHALL BE PIPE SPECIFIED PIPE DIAMETER PLUS 3 INCHES

WEIGHT

CONCRETE C.Y. (FOOTING)
C.Y. (WALL)
REBAR LBS

ADDED REINFORCING FOR MANHOLE OPENING

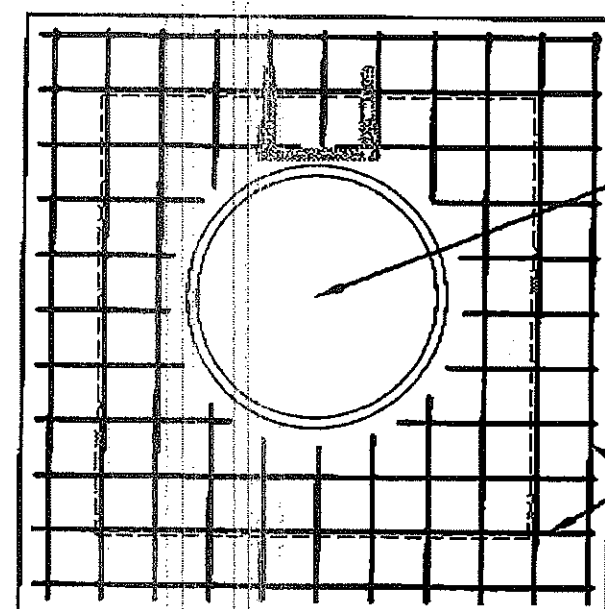

OPENING FOR TYPE "P"
C.I. FRAME AND
COVER. FOR ADDED
REINFORCING AROUND
OPENING SEE H-06

#5 AT 5 1/2"
O.C. E.W.
(BOTTOM)

HAWAII PRECAST, INC.

P.O. BOX 160 KAILUA-KONA, HI 96745

Ph: (808) 328-7730 Fax: (808) 328-8028

CONTRACTOR: KIRKLAND CONSTRUCTION

JOB: SADDLE ROAD - WEST SIDE

TYPE A STORM DRAIN MANHOLE AT STATION 783+85


SCALE: 1/2"=1'-0"

DATE: April 1, 2012


DRAWN BY: RT

SHEET: 1 OF 3

CHECKED BY: TT

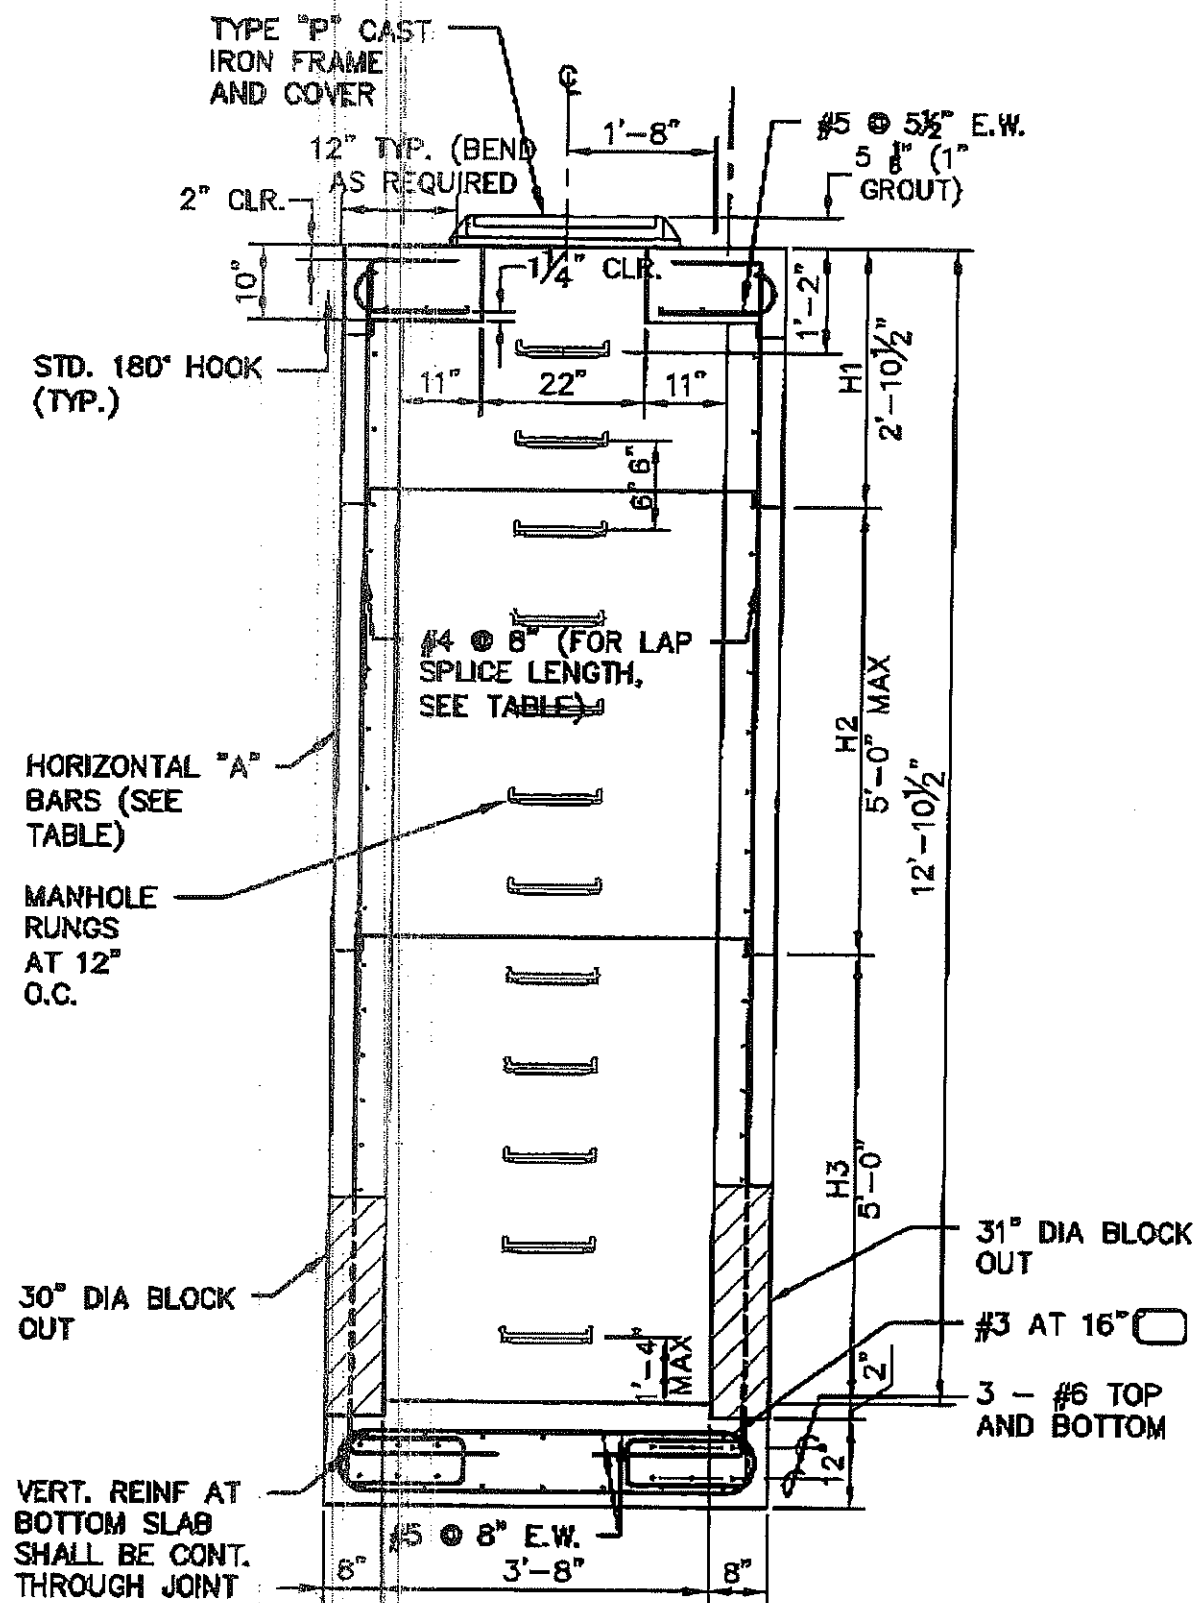

SECTION A-A

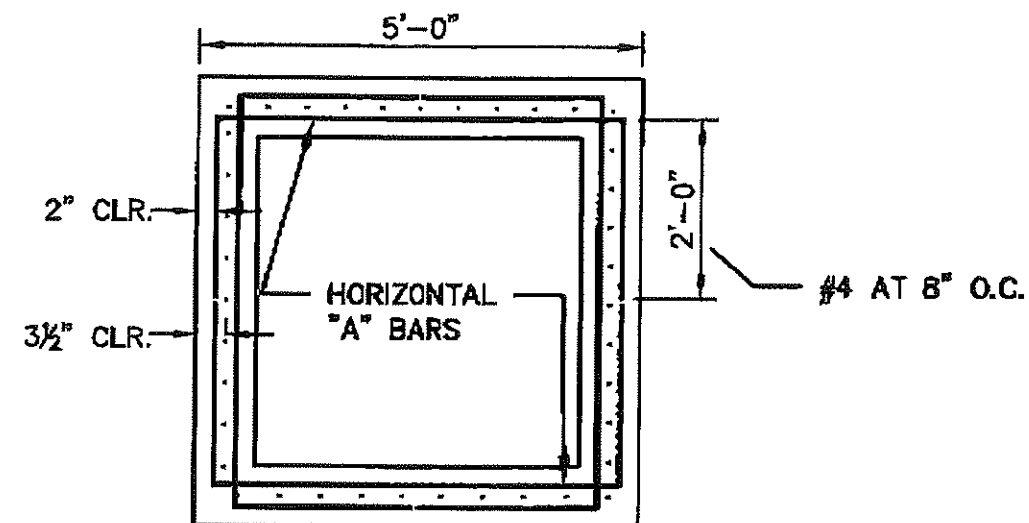

PLAN VIEW OF WALL SECTION

HORIZONTAL "A" BARS FOR STORM DRAIN MANHOLE	
SDMH DEPTH	HORIZONTAL "A" BARS
H1 0'-0" TO 5'-0"	#5 AT 10"
H2 5'-1" TO 10'-0"	#5 AT 8"
H3 10'-1" TO 15'-0"	#5 AT 6"
H4 15'-1" TO 20'-0"	#5 AT 6"

VERT. BAR LAP SPLICE	
BAR	VERT. LAP LENGTH
#4	1'-8"
#5	2'-2"

HAWAII PRECAST, INC.

P.O. BOX 160 KAILUA-KONA, HI 96745

Ph: (808) 328-7730 Fax: (808) 328-9028

CONTRACTOR: KIRKLAND CONSTRUCTION

JOB: SADDLE ROAD - WEST SIDE

TYPE A STORM DRAIN MANHOLE AT STATION 783+85

SCALE: 3/8"=1'-0"


DATE: April 1, 2012

DRAWN BY: RT


SHEET: 2 OF

CHECKED BY: TT

3

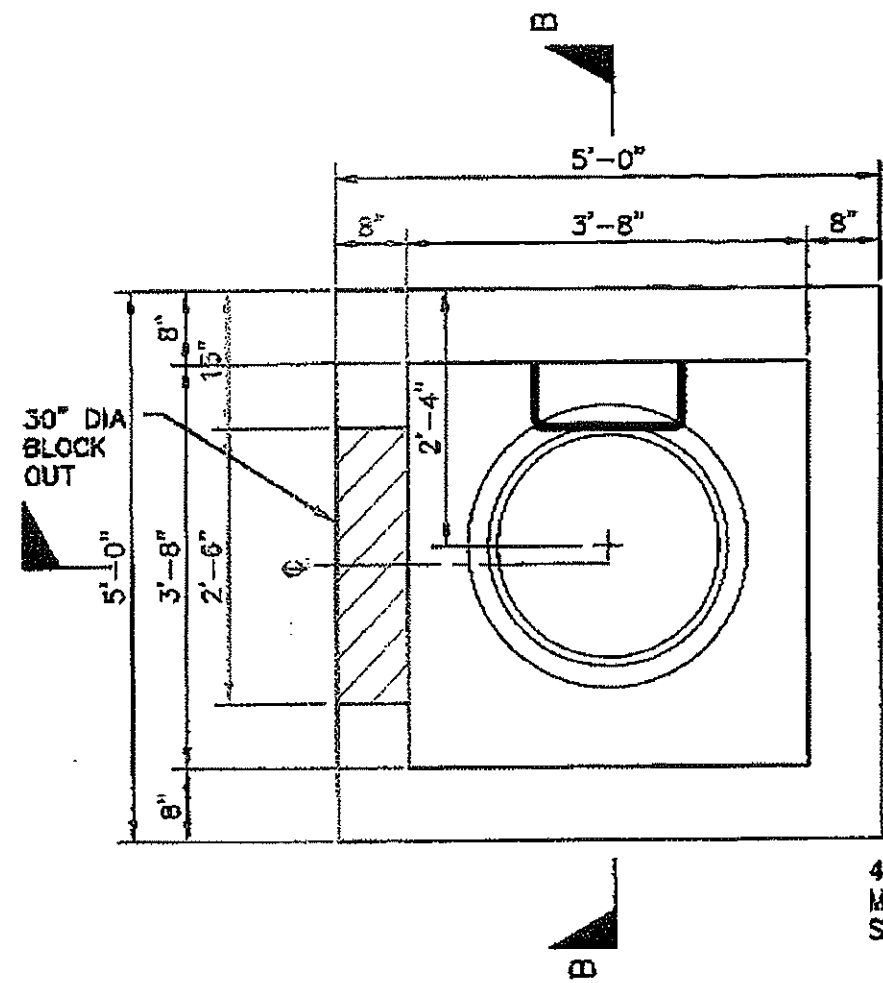


PLAN

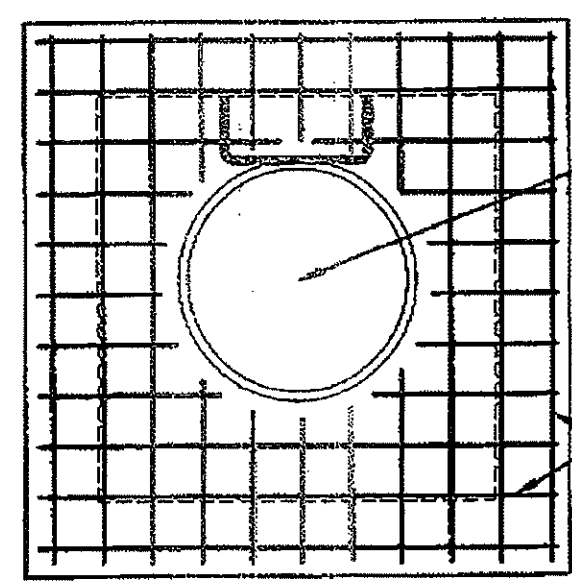

OPENING FOR TYPE "P"
C.I. FRAME AND
COVER. FOR ADDED
REINFORCING AROUND
OPENING SEE H-06

#5 AT 5 1/2"
O.C. E.W.
(BOTTOM)

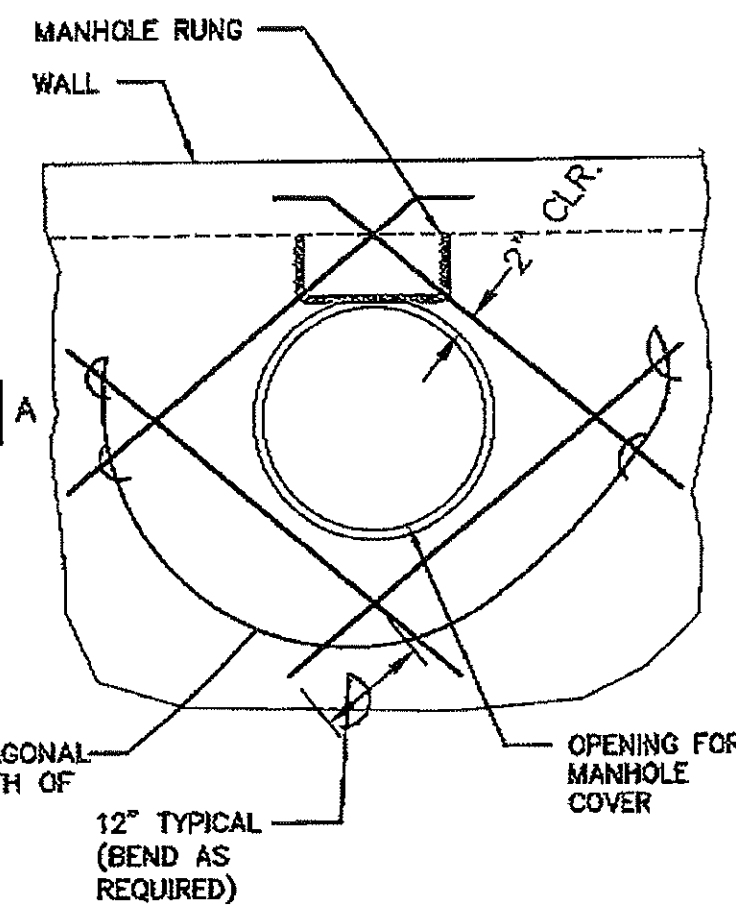

ADDED REINFORCING
FOR MANHOLE OPENING


NOTES:


- 1 CONCRETE SHALL HAVE A COMPRESSIVE STRENGTH OF 5,000 P.S.I. AT 28 DAYS.
- 2 ALL REINFORCING STEEL SHALL BE NEW STOCK DEFORMED BARS CONFORMING TO ASTM A706W GRADE 60 UNLESS OTHERWISE NOTED. PLACEMENT OF REBARS SHALL BE IN ACCORDANCE WITH ACI-315 & ACI-318. ALL BARS SHALL BE CLEAN OF RUST, GREASE OR OTHER MATERIALS LIKELY TO IMPAIR BOND. ALL BENDS SHALL BE MADE COLD.
- 3 ALL REINFORCING BARS SHALL BE ACCURATELY & SECURELY PLACED. ALL REINFORCING SHALL BE LAPPED 40 BAR DIAMETERS OR EIGHTEEN (18) INCHES, WHICHEVER IS GREATER AT SPLICES. ALL SPLICES SHALL BE MADE AWAY FROM POINT OF MAXIMUM STRESS. 4. CONCRETE COVER TO REINFORCING STEEL SHALL BE 1-1/2" MINIMUM.

- 5 NON-TRAFFIC APPLICATION ONLY
- 6 BLOCKOUTS DIAMETER SHALL BE PIPE SPECIFIED PIPE DIAMETER PLUS 3 INCHES


WEIGHT	
CONCRETE C.Y. (FOOTING)	
C.Y. (WALL)	
REBAR LBS	

HAWAII PRECAST, INC. P.O. BOX 160 KAILUA-KONA, HI 96745 Ph: (808) 328-7730 Fax: (808) 328-9028		
CONTRACTOR: _____ JOB: <u>SADDLE ROAD - WEST SIDE</u>		
TYPE A STORM DRAIN MANHOLE AT STATION 778+61		
SCALE: 1/2"=1'-0" DATE: <u>April 1, 2012</u>	DRAWN BY: RT SHEET: <u>1</u> OF <u>3</u>	CHECKED BY: TT

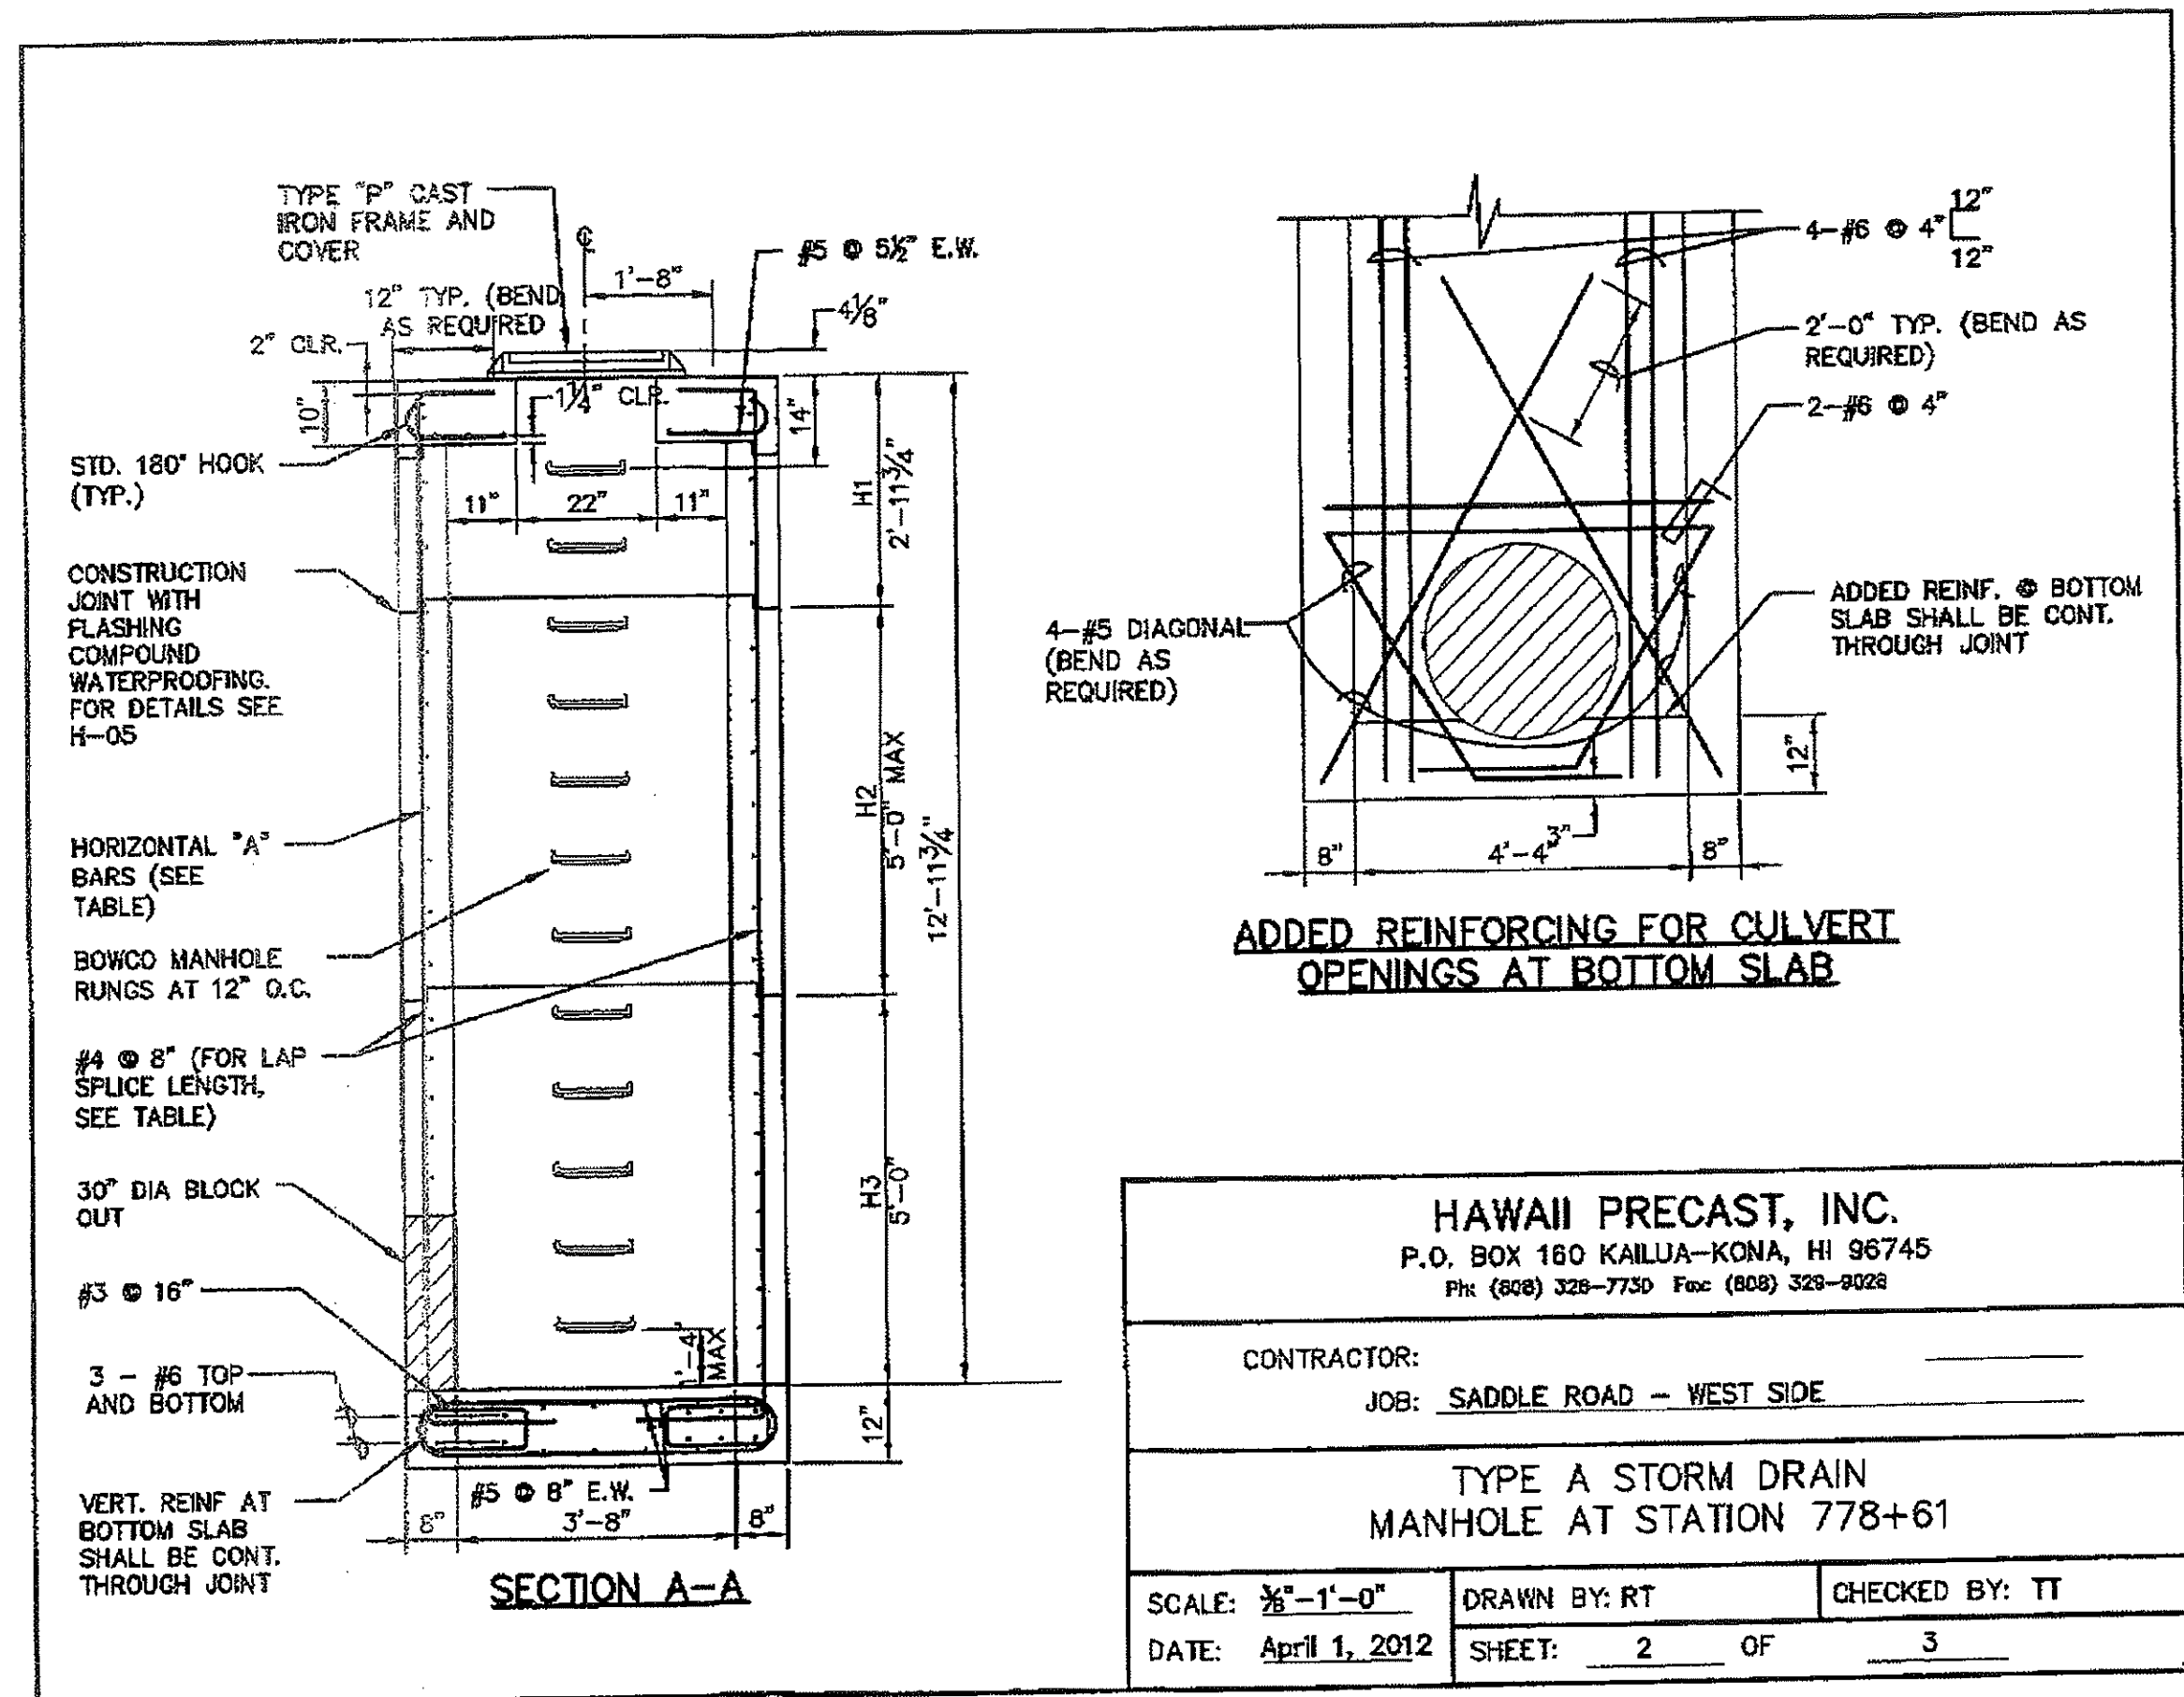

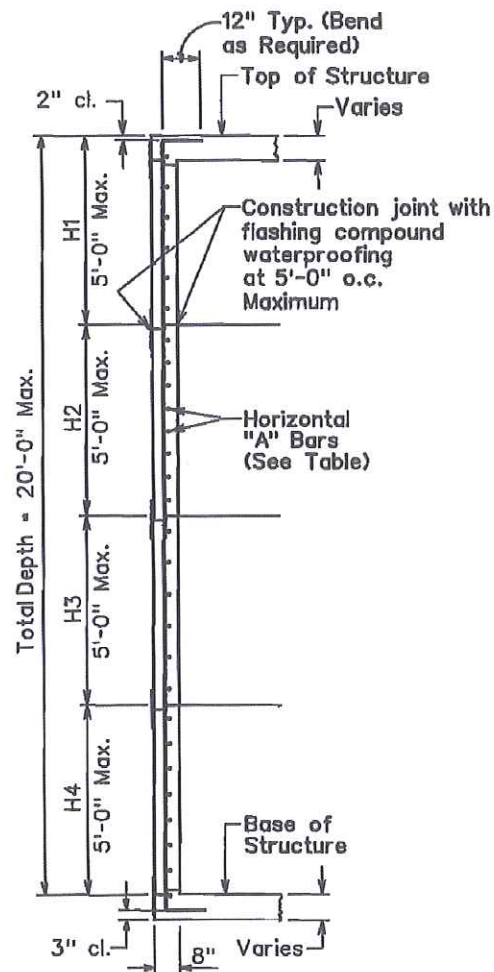


ELEVATION VIEW
OF WALL SECTION

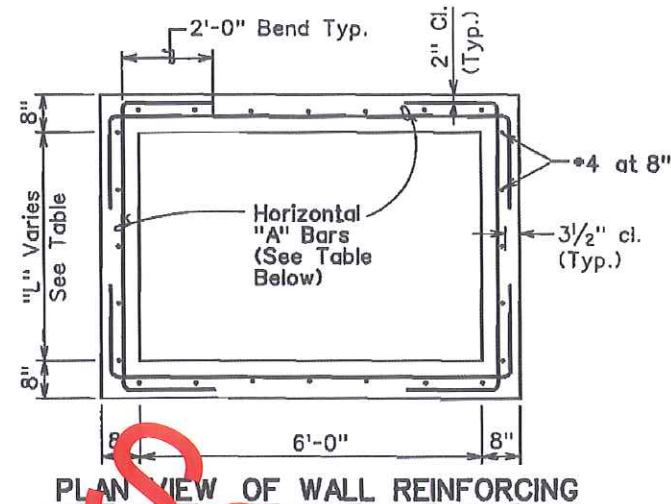


PLAN VIEW OF WALL REINFORCING

General Notes:

- General Criteria
 - At-rest Horizontal Pressure = 80 pcf (2 to 1 sloping backfill, above groundwater)
 - At-rest Vertical Pressure = 40 pcf (2 to 1 sloping backfill, above groundwater)
 - Allowable Bearing Capacity = 1,700 psf + 8 x (overburden pressure); where overburden pressure equals 100 pcf x H
 - Live Load Surcharge (Equivalent Height of Soil)
For H = 0' to 5'; heq = 4'-0"
For H = 5' to 20'; heq = 3'-0"
- Exposure Factor (For Crack Control) = 1.0 for Class 1 exposure

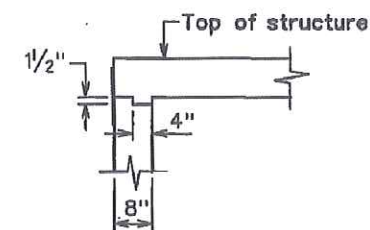


JOINT AT TOP

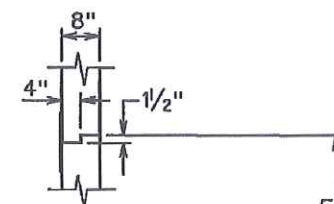

INTERMEDIATE JOINT

2nd layer -
Apply fabric.
See Std. Specs.

3rd layer - Finish
with 2nd coat of
flashing compound

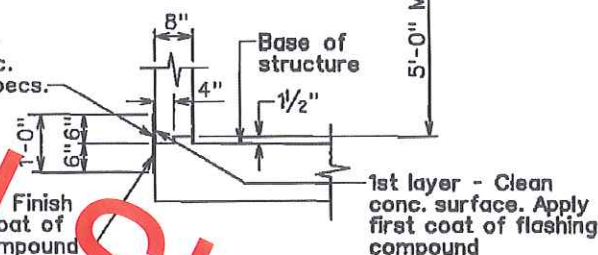

JOINT AT BASE

Note:
Waterproof all construction joints.

CONSTRUCTION JOINT AND
WATERPROOFING DETAILS


HORIZONTAL "A" BARS FOR CATCH BASINS					
DEPTH	"L" MAX.				
	4'-0"	6'-0"	7'-4"	8'-4"	9'-4"
H1 0" to 5'-0"	*5 at 10"	*5 at 10"	*5 at 8"	*5 at 6"	*5 at 5"
H2 5'-1" to 10'-0"	*5 at 8"	*5 at 8"	*5 at 6"	N.A.	N.A.
H3 10'-1" to 15'-0"	*5 at 6"	*5 at 6"	N.A.	N.A.	N.A.
H4 15'-1" to 20'-0"	*5 at 6"	N.A.	N.A.	N.A.	N.A.

Note: N.A. = Not Applicable



X	X	
DATE	REVISION	APP'D.

STANDARD PLAN H-05 05/31/07


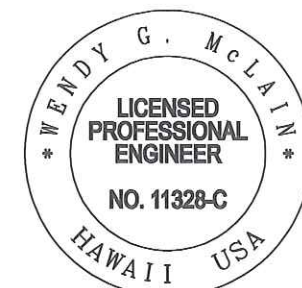


THIS WORK WAS PREPARED BY ME OR UNDER MY SUPERVISION.
4/30/2012
EXPIRATION DATE OF THE LICENSE

U.S. DEPARTMENT OF TRANSPORTATION
FEDERAL HIGHWAY ADMINISTRATION
FEDERAL LANDS HIGHWAY
U.S. CUSTOMARY SPECIAL
(HDOT STD H-05)
TYP. REINFORCING DETAILS
FOR DRAINAGE STRUCTURES

NO SCALE

SPECIAL
604-I

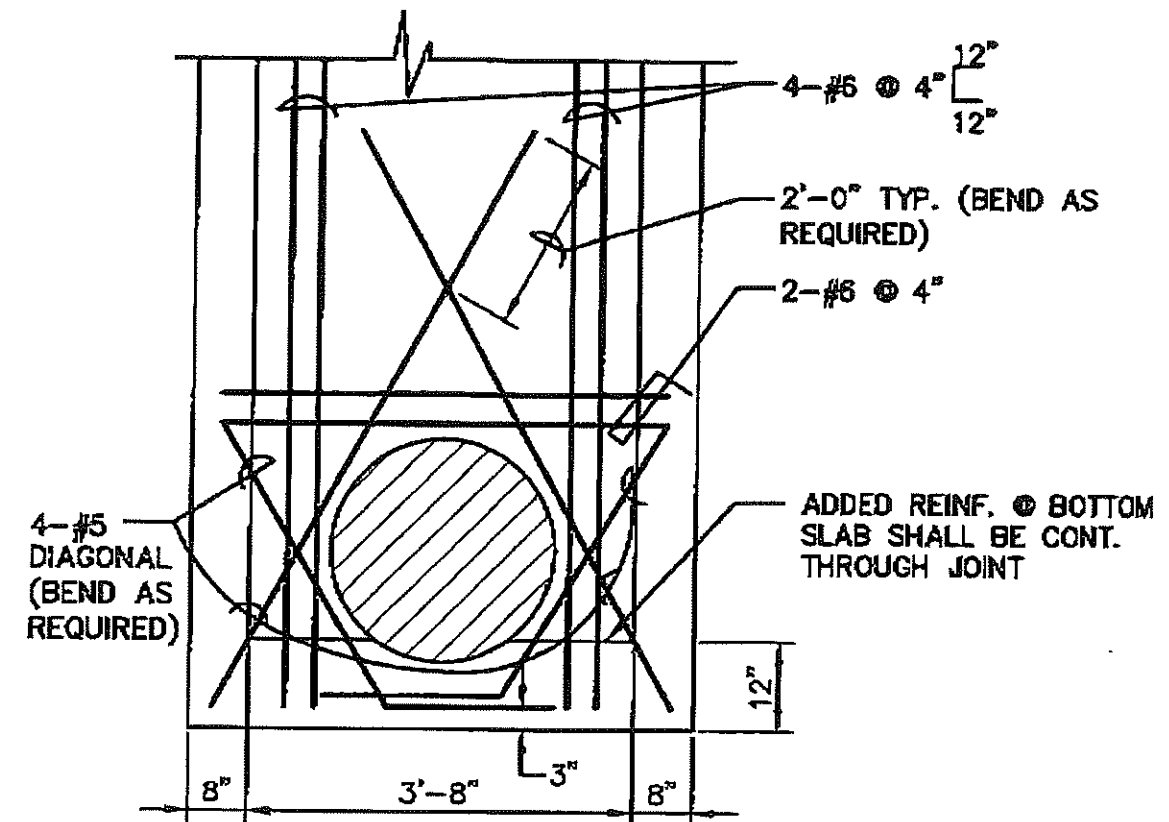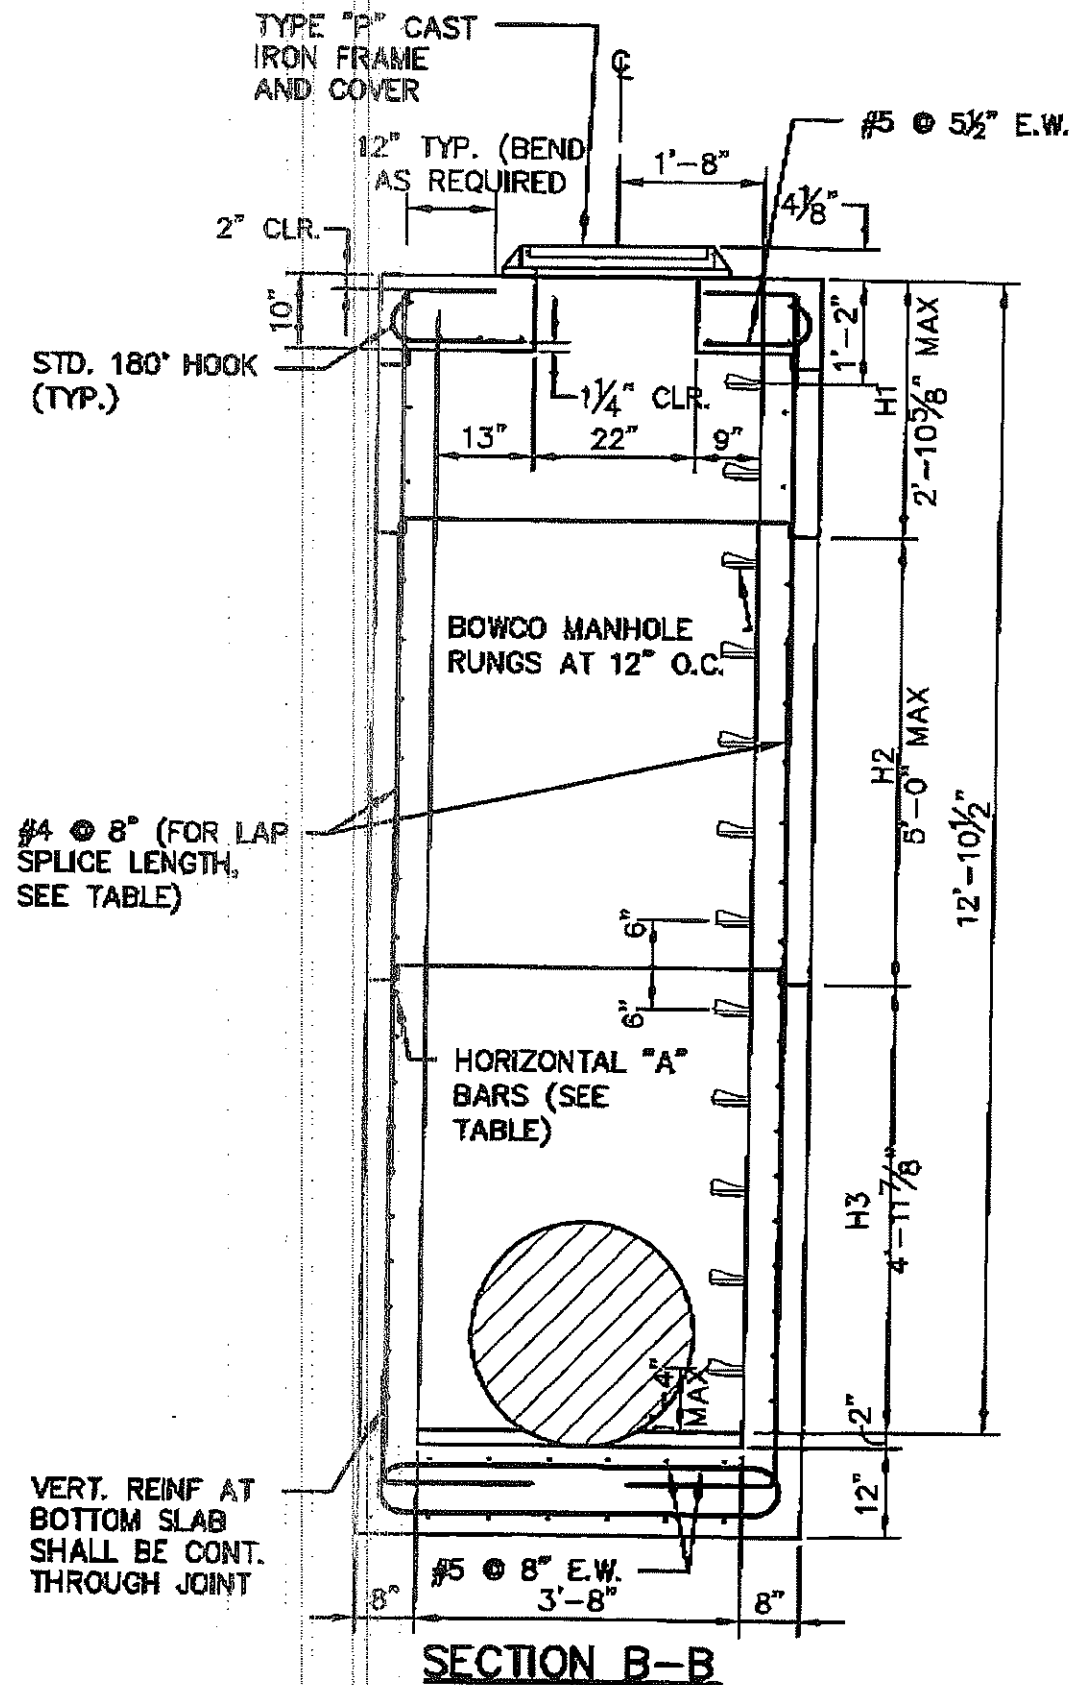

**ADDED REINFORCING FOR CULVERT
OPENINGS AT BOTTOM SLAB**

HAWAII PRECAST, INC.

P.O. BOX 160 KAILUA-KONA, HI 96745

Ph: (808) 328-7730 Fax: (808) 328-8028

CONTRACTOR: KIRKLAND CONSTRUCTION

JOB: SADDLE ROAD - WEST SIDE

**TYPE A STORM DRAIN
MANHOLE AT STATION 783+85**


SCALE: 3/8"=1'-0"

DATE: April 1, 2012

DRAWN BY: RT

SHEET: 3 OF 3

CHECKED BY: TT

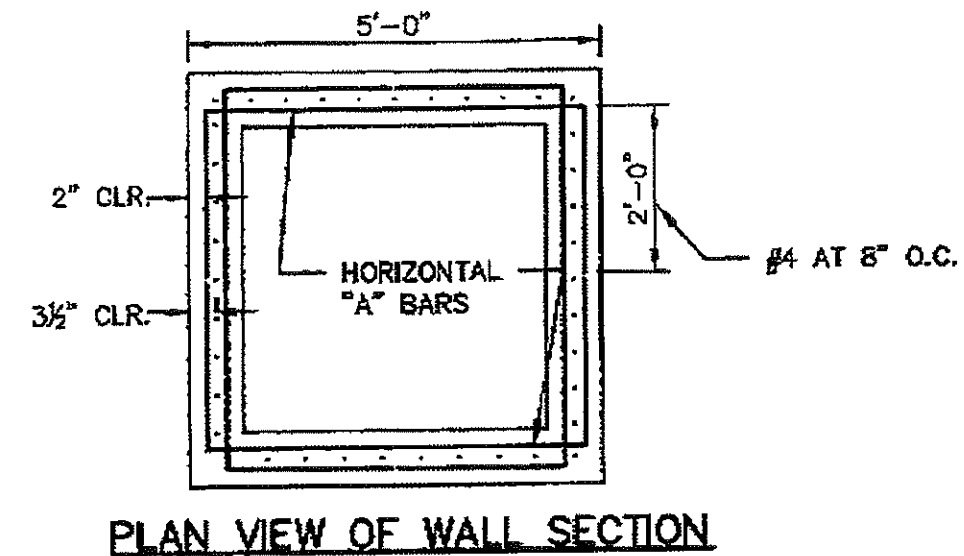

HORIZONTAL "A" BARS FOR STORM DRAIN MANHOLE	
SDMH DEPTH	HORIZONTAL "A" BARS
H1 0'-0" TO 5'-0"	#5 AT 10"
H2 5'-1" TO 10'-0"	#5 AT 8"
H3 10'-1" TO 15'-0"	#5 AT 6"
H4 15'-1" TO 20'-0"	#5 AT 6"

VERT. BAR LAP SPLICE	
BAR	VERT. LAP LENGTH
#4	1'-8"
#5	2'-2"

HAWAII PRECAST, INC.
P.O. BOX 160 KAILUA-KONA, HI 96745
Ph: (808) 326-7730 Fax: (808) 329-9028


CONTRACTOR: _____
JOB: SADDLE ROAD - WEST SIDE

TYPE A STORM DRAIN
MANHOLE AT STATION 778+61


SCALE: $\frac{3}{8}"=1'-0"$
DATE: April 1, 201

DRAWN BY: RT	CHECKED BY: TT
SHEET: 3	OF 3


STATE	PROJECT	SHEET NO.	TOTAL SHEETS
HI	HI A-AD 6(6)	G24	G28

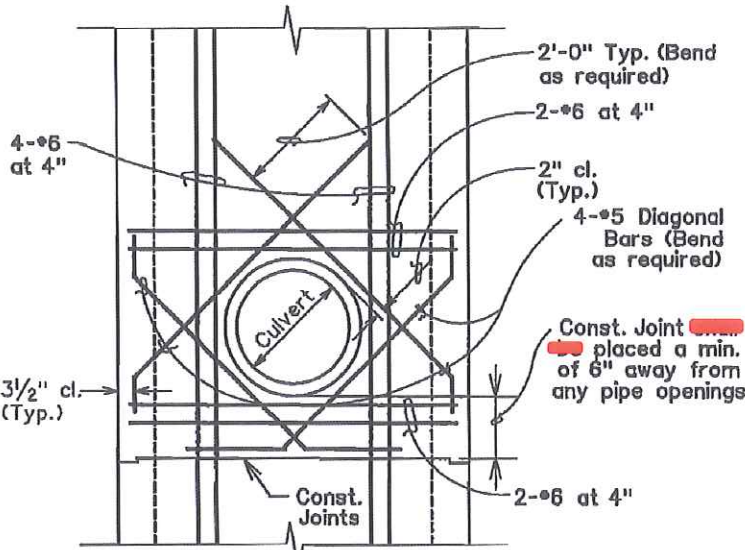


ADDED REINFORCING
FOR CULVERT OPENINGS
(ABOVE BOTTOM SLAB)

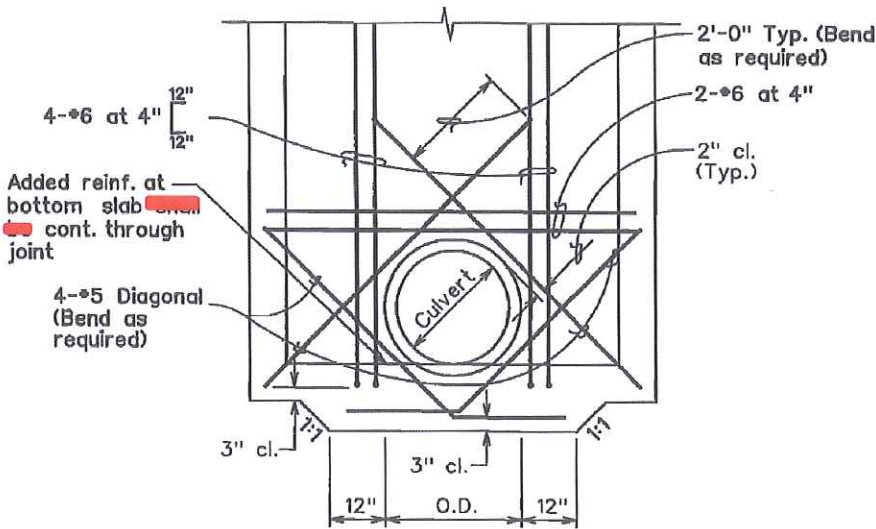

ADDED REINFORCING FOR CULVERT
OPENINGS AT BOTTOM SLAB

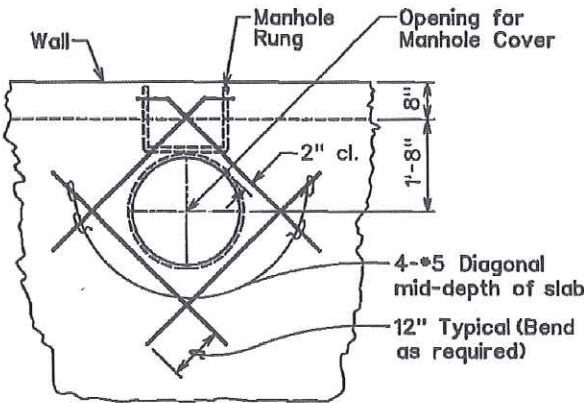

ADDED REINFORCING
FOR MANHOLE OPENING

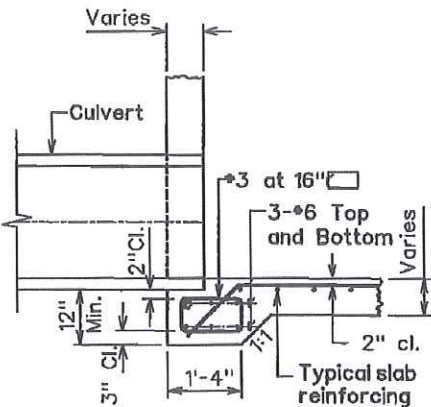


DETAIL OF CULVERT SEAT

DATE	REVISION	APP'D.
X	X	

STANDARD PLAN H-06 05/31/07

STATE OF HAWAII
DEPARTMENT OF TRANSPORTATION
HIGHWAYS DIVISION

STANDARD PLAN H-06
TYPICAL REINFORCING DETAILS
FOR DRAINAGE STRUCTURES

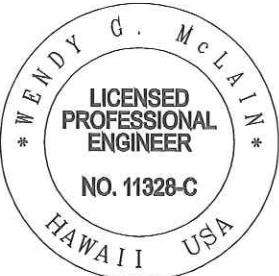

THIS WORK WAS PREPARED BY ME OR
UNDER MY SUPERVISION.
4/30/2012
SIGNATURE EXPIRATION DATE
OF THE LICENSE

U.S. DEPARTMENT OF TRANSPORTATION
FEDERAL HIGHWAY ADMINISTRATION
FEDERAL LANDS HIGHWAY

U.S. CUSTOMARY SPECIAL

(HDOT STD H-06)
TYP. REINFORCING DETAILS
FOR DRAINAGE STRUCTURES

NO SCALE

SPECIAL
604-J