
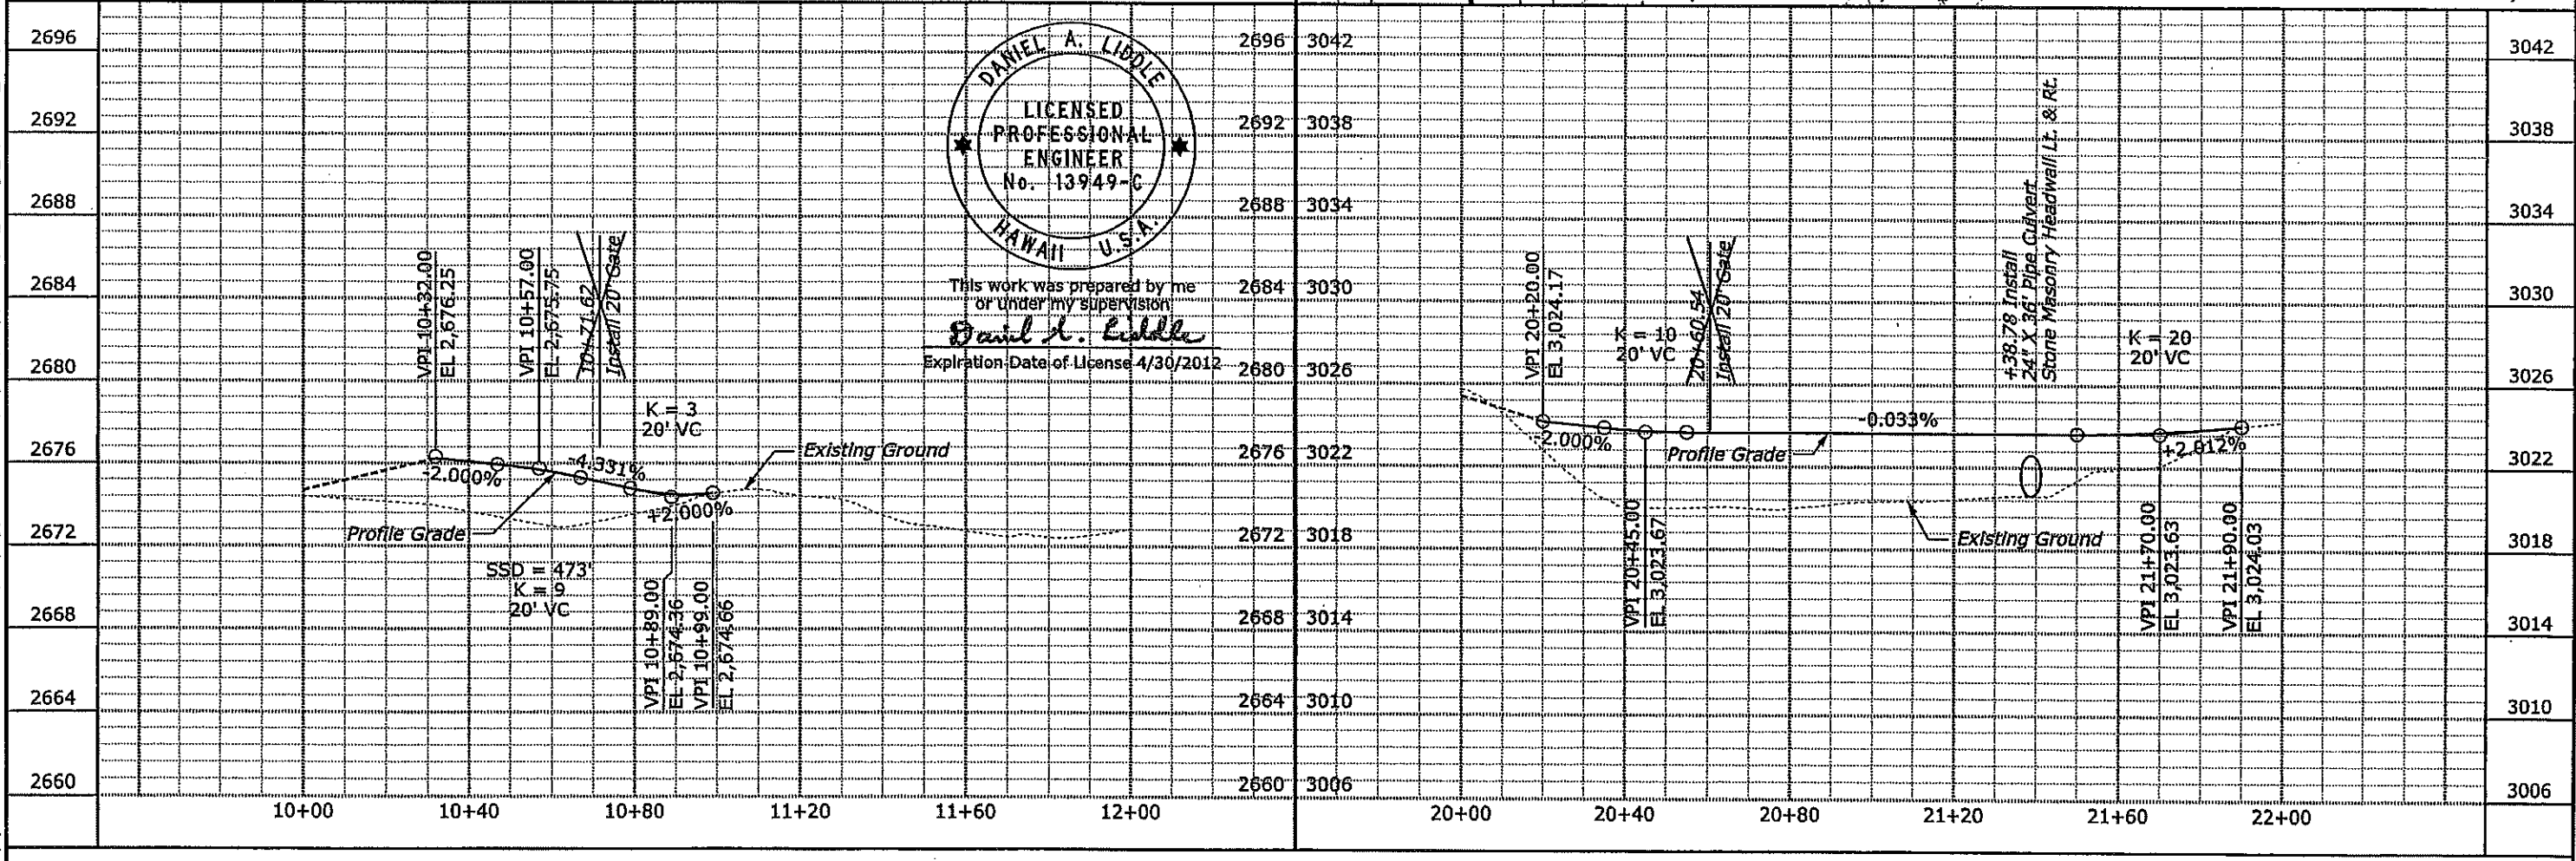
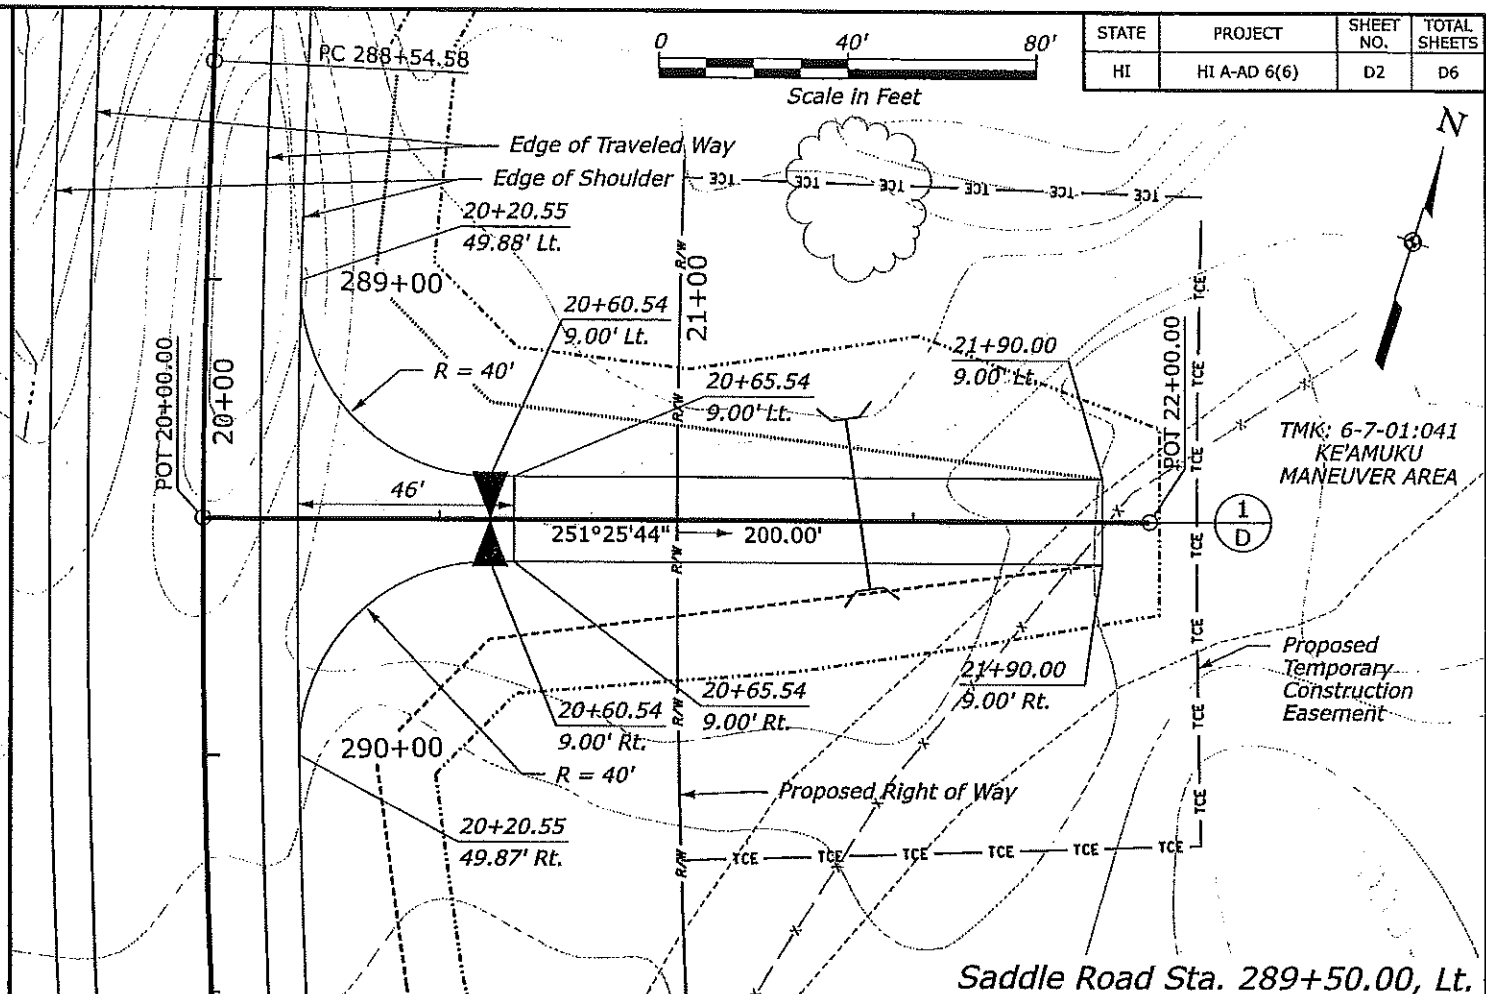




5/3/2011 12:01:31 PM S:\Transport\100013746-SR\HwyDes\Drawings\Sheets_Bld_Package_1\D-Minor_P&P\HI SR 200(00).pdx\01.dgn

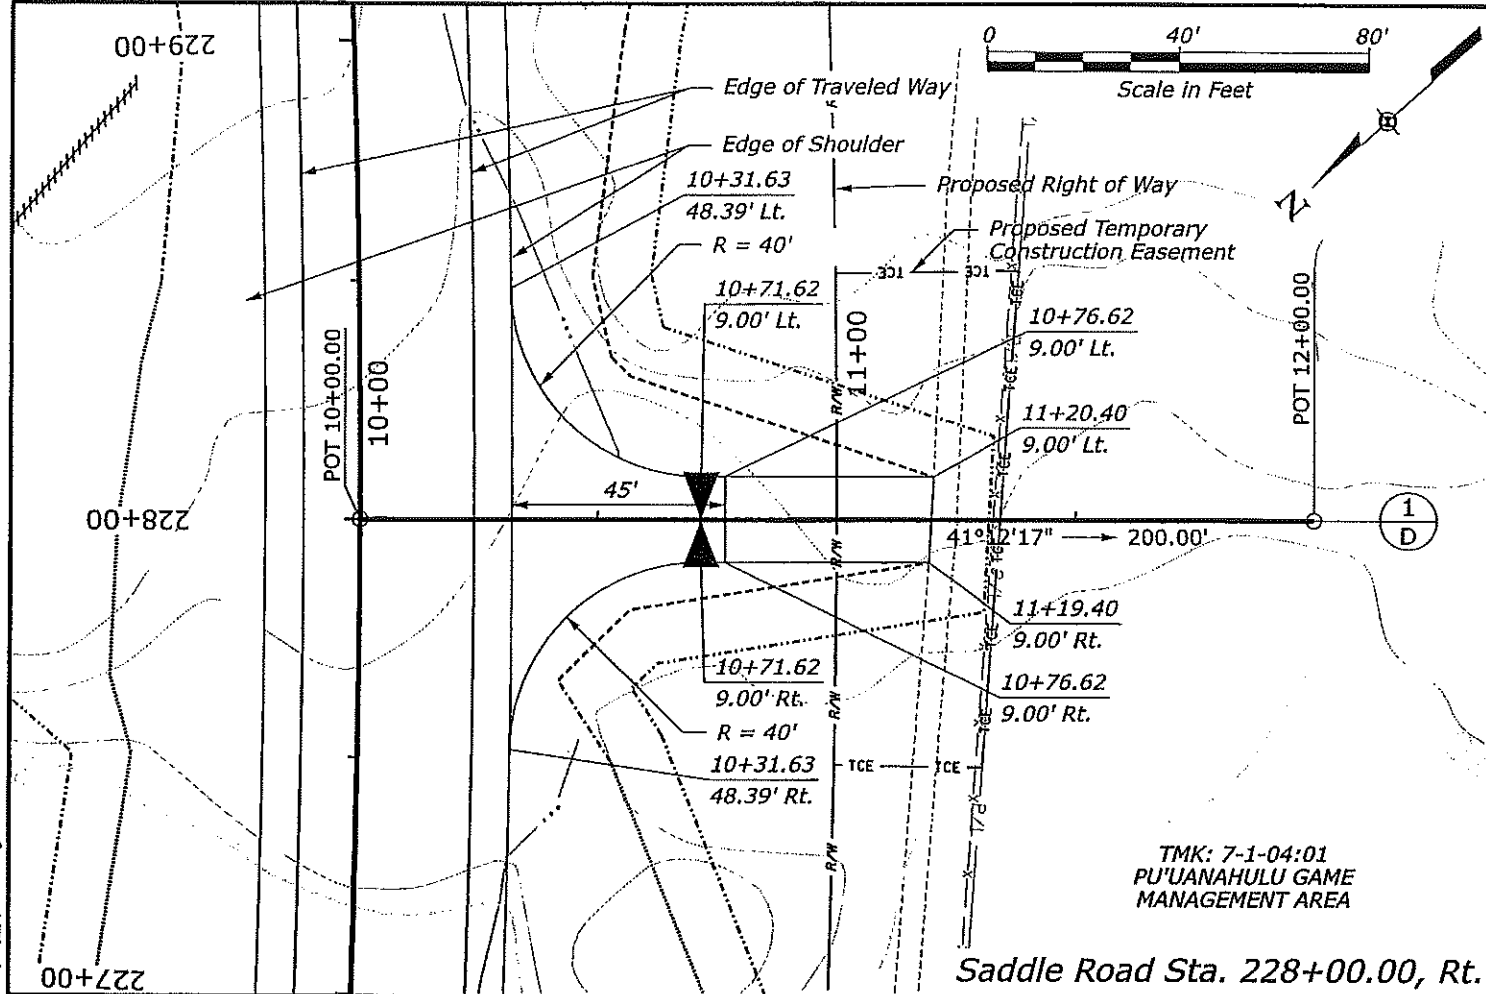


DANIEL A. LIDDE
LICENSED PROFESSIONAL ENGINEER
No. 13949-G
HAWAII U.S.A.

This work was prepared by me
or under my supervision
Daniel A. Liddle
Expiration Date of License 4/30/2012

STATE	PROJECT	SHEET NO.	TOTAL SHEETS
HI	HI A-AD 6(6)	D5	D6

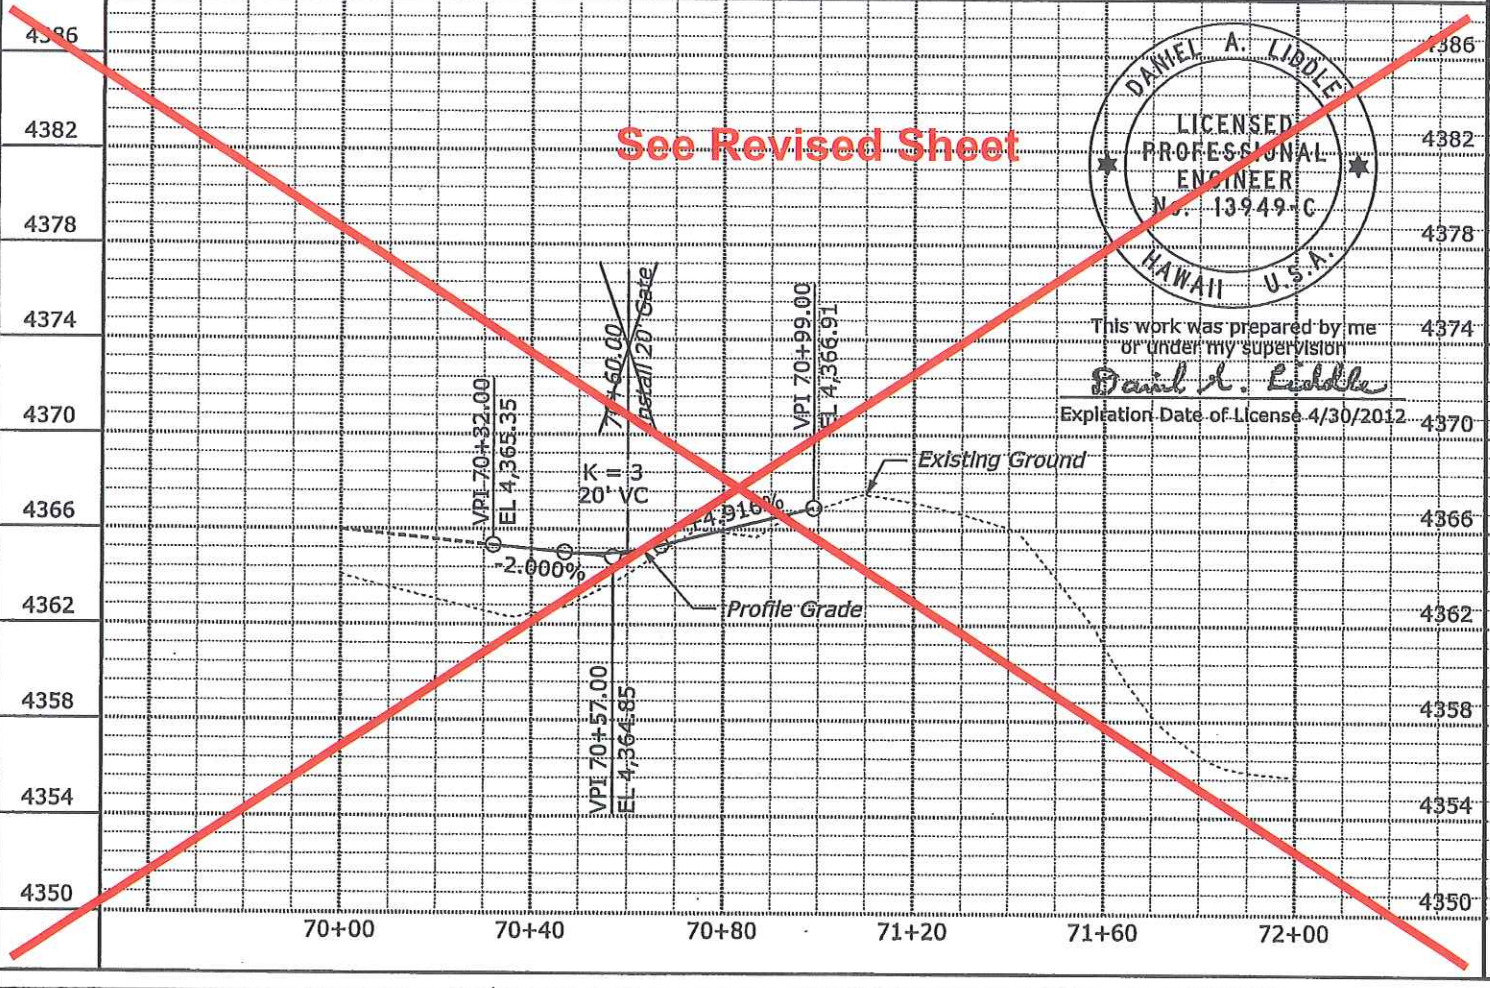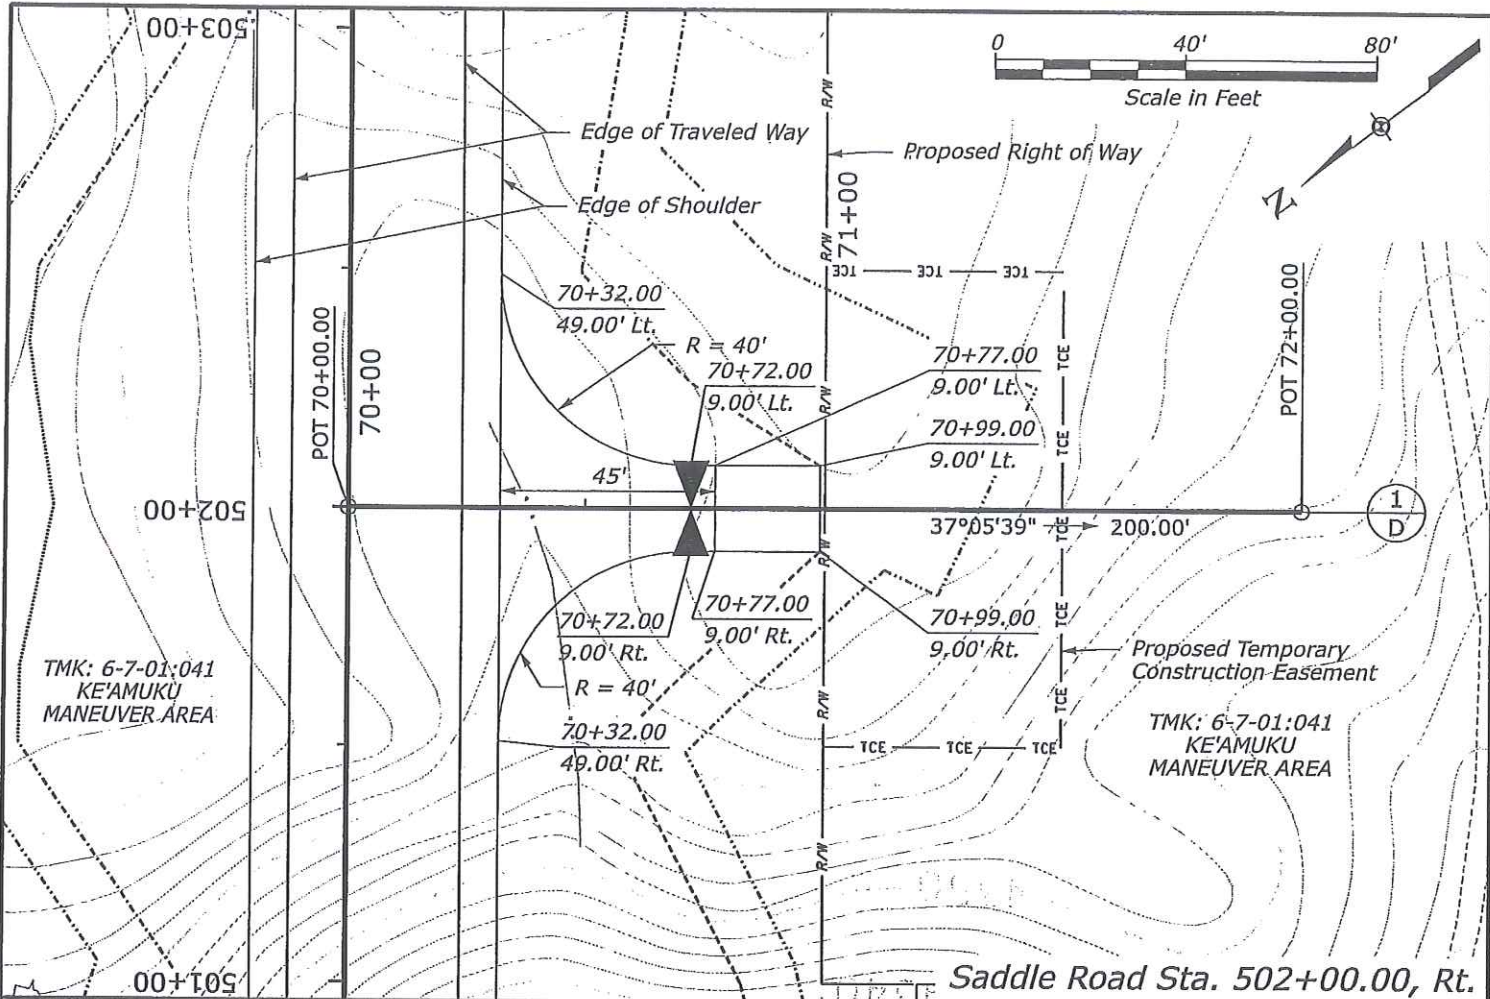


See Revised Sheet

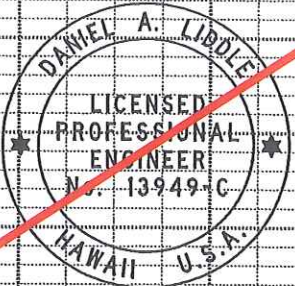


This work was prepared by me or under my supervision
Daniel A. Liddle
Expiration Date of License 4/30/2012

5/3/2011 12:03:14 PM S:\Transport\100013746-SR\HwyDes\Drawings\Package_1\Drawings\SR 200(00)_ppdw04.dgn

S:\Transport\100013746-SR\HwyDes\Drawings\Sheets_Bld_Package_11D-Minor_P8P\HI SR 200(00)_ppdw05.dgn
7:09:52 AM
5/5/2011

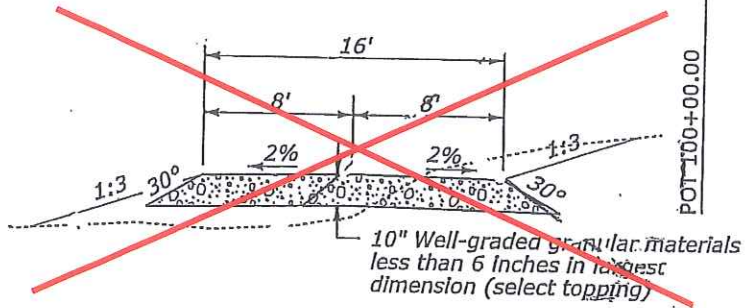


**TYPICAL SECTION
KE'EKE'E ROAD
Station 103+00.00 to 106+55.00**


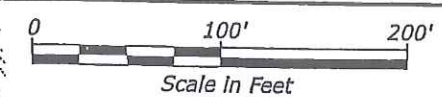


STATE	PROJECT	SHEET NO.	TOTAL SHEETS
HI	HI A-AD 6(6)	D6	D6

Note: KE'EKE'E Road
Maintain and Keep Open for Temporary Military.
Coordinate Closure During Construction With the Military.
KE'EKE'E Road Shall be Maintained at a Min. Width of 16'.

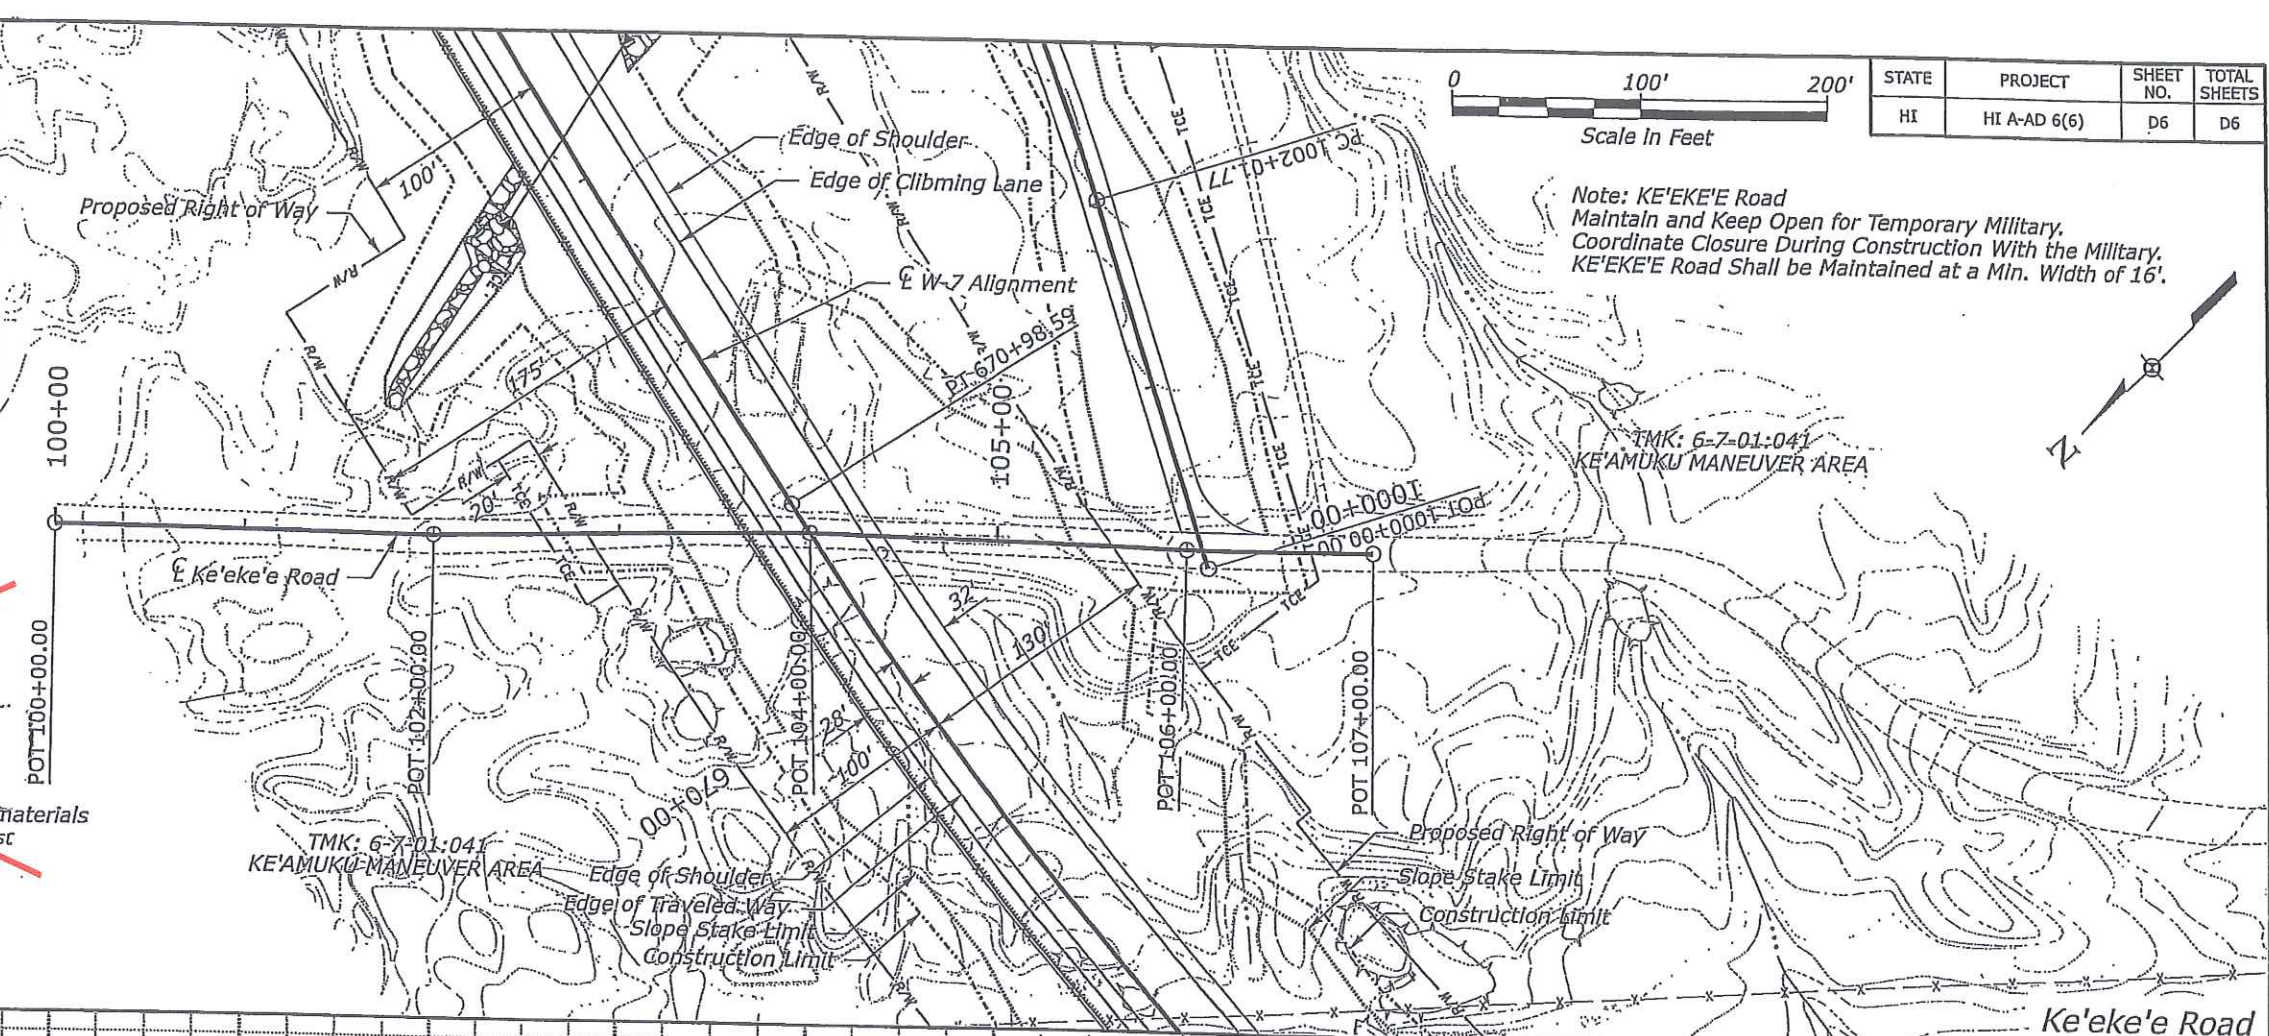


See Revised Sheet

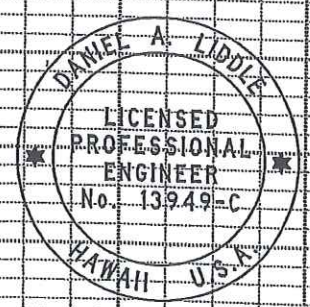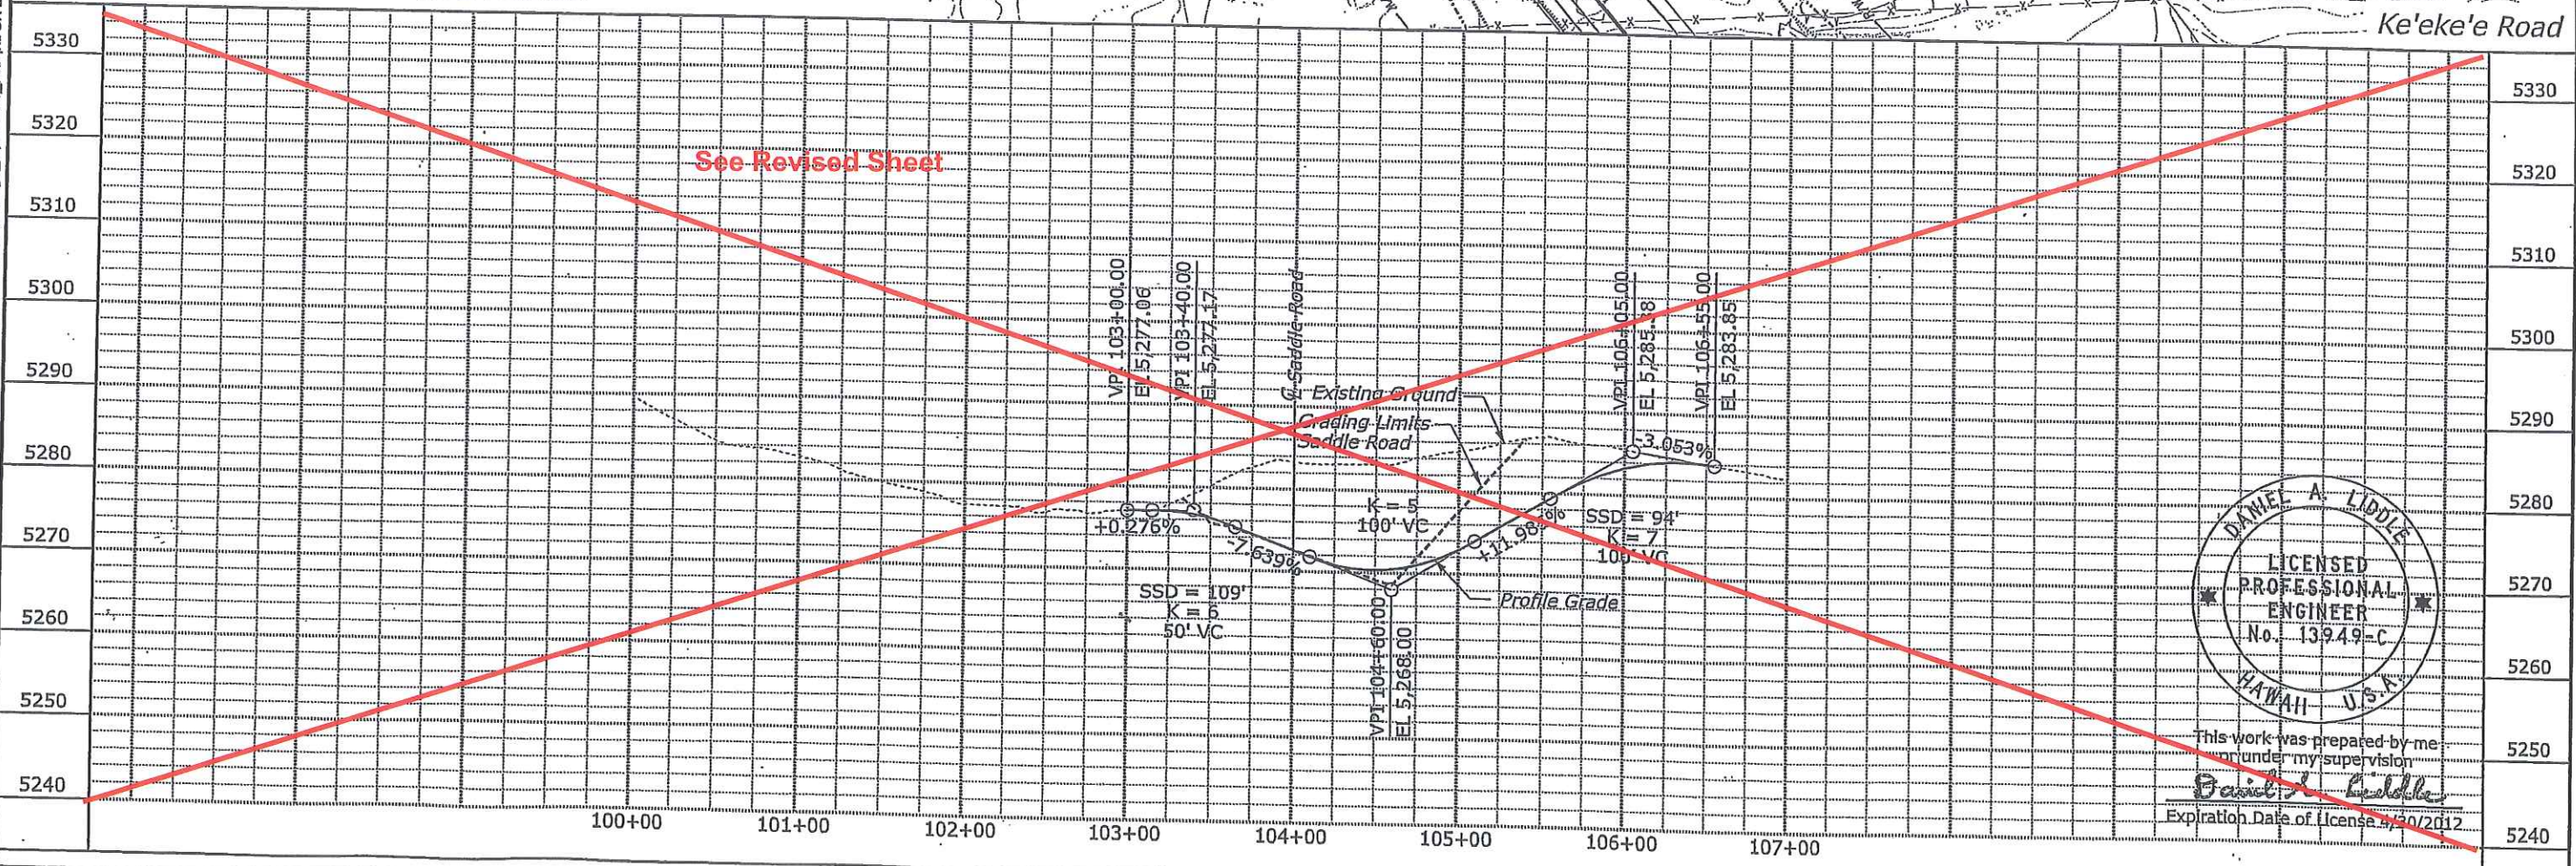


This work was prepared by me
under my supervision
Daniel A. Liddle
Expiration Date of License 4/30/2012

48835LT

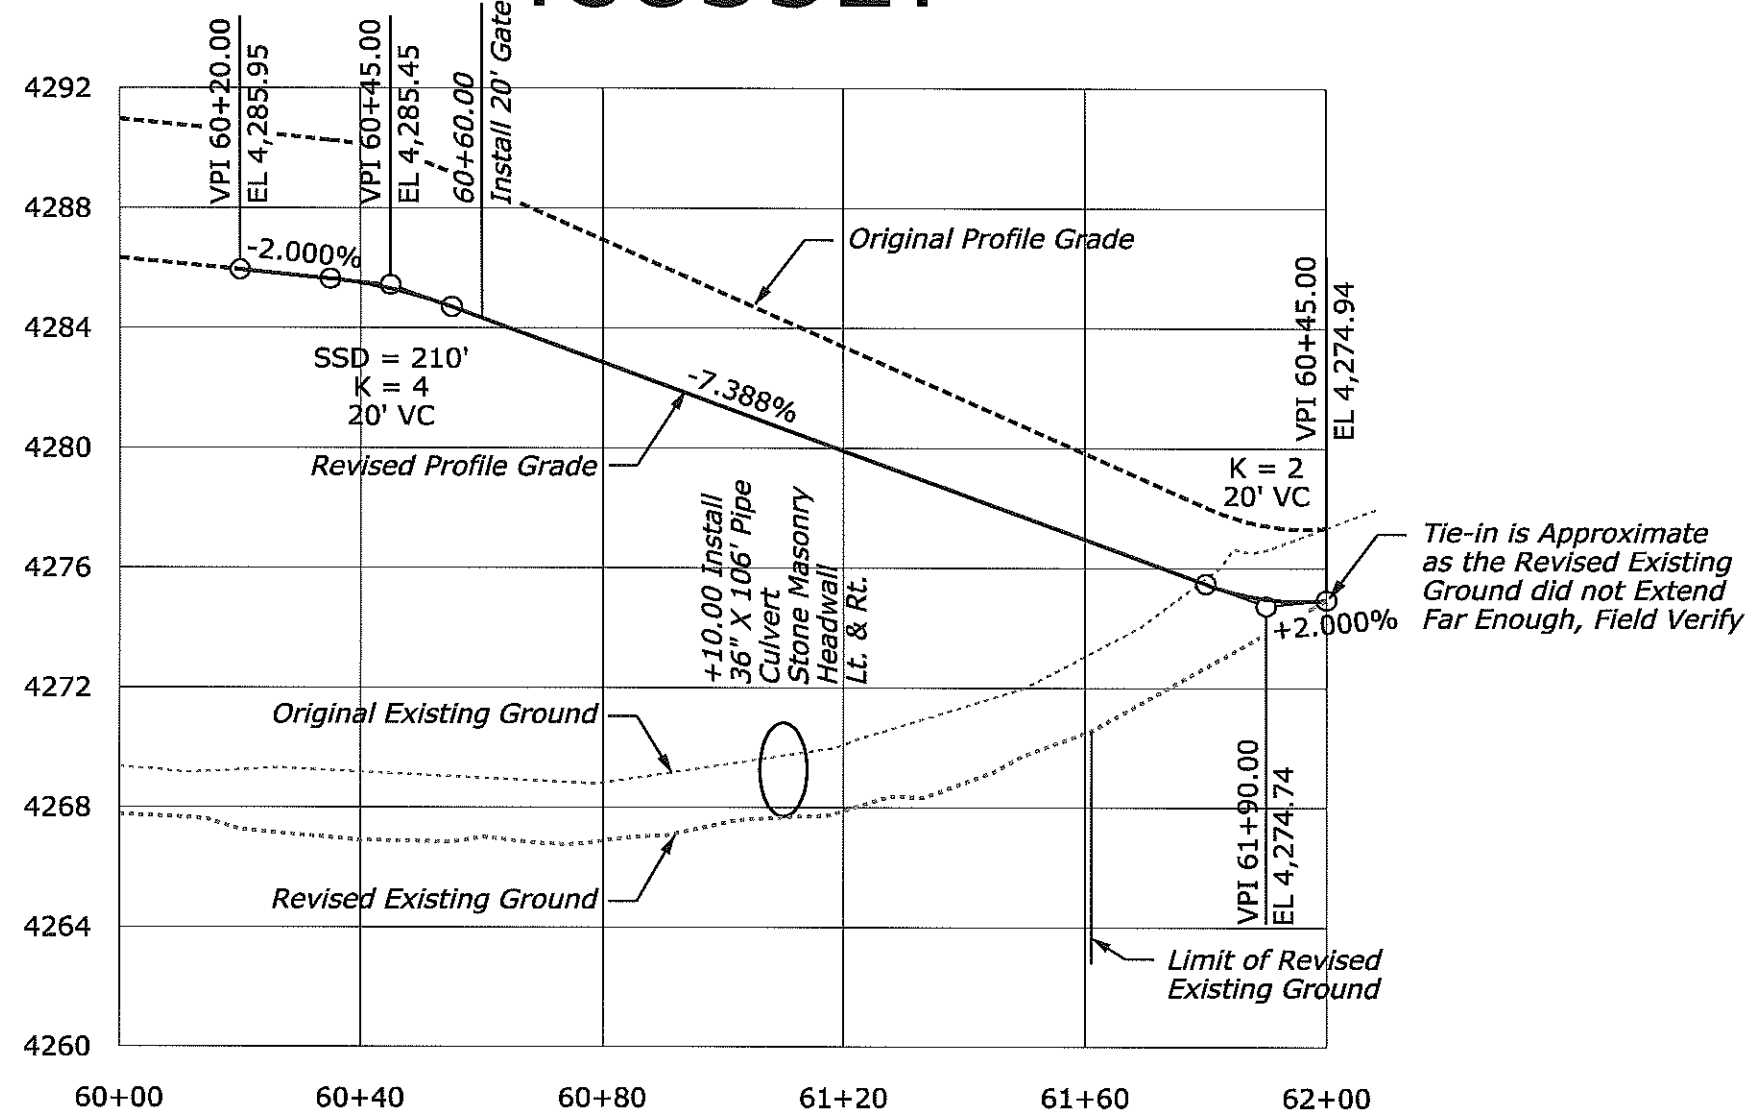

50200RT

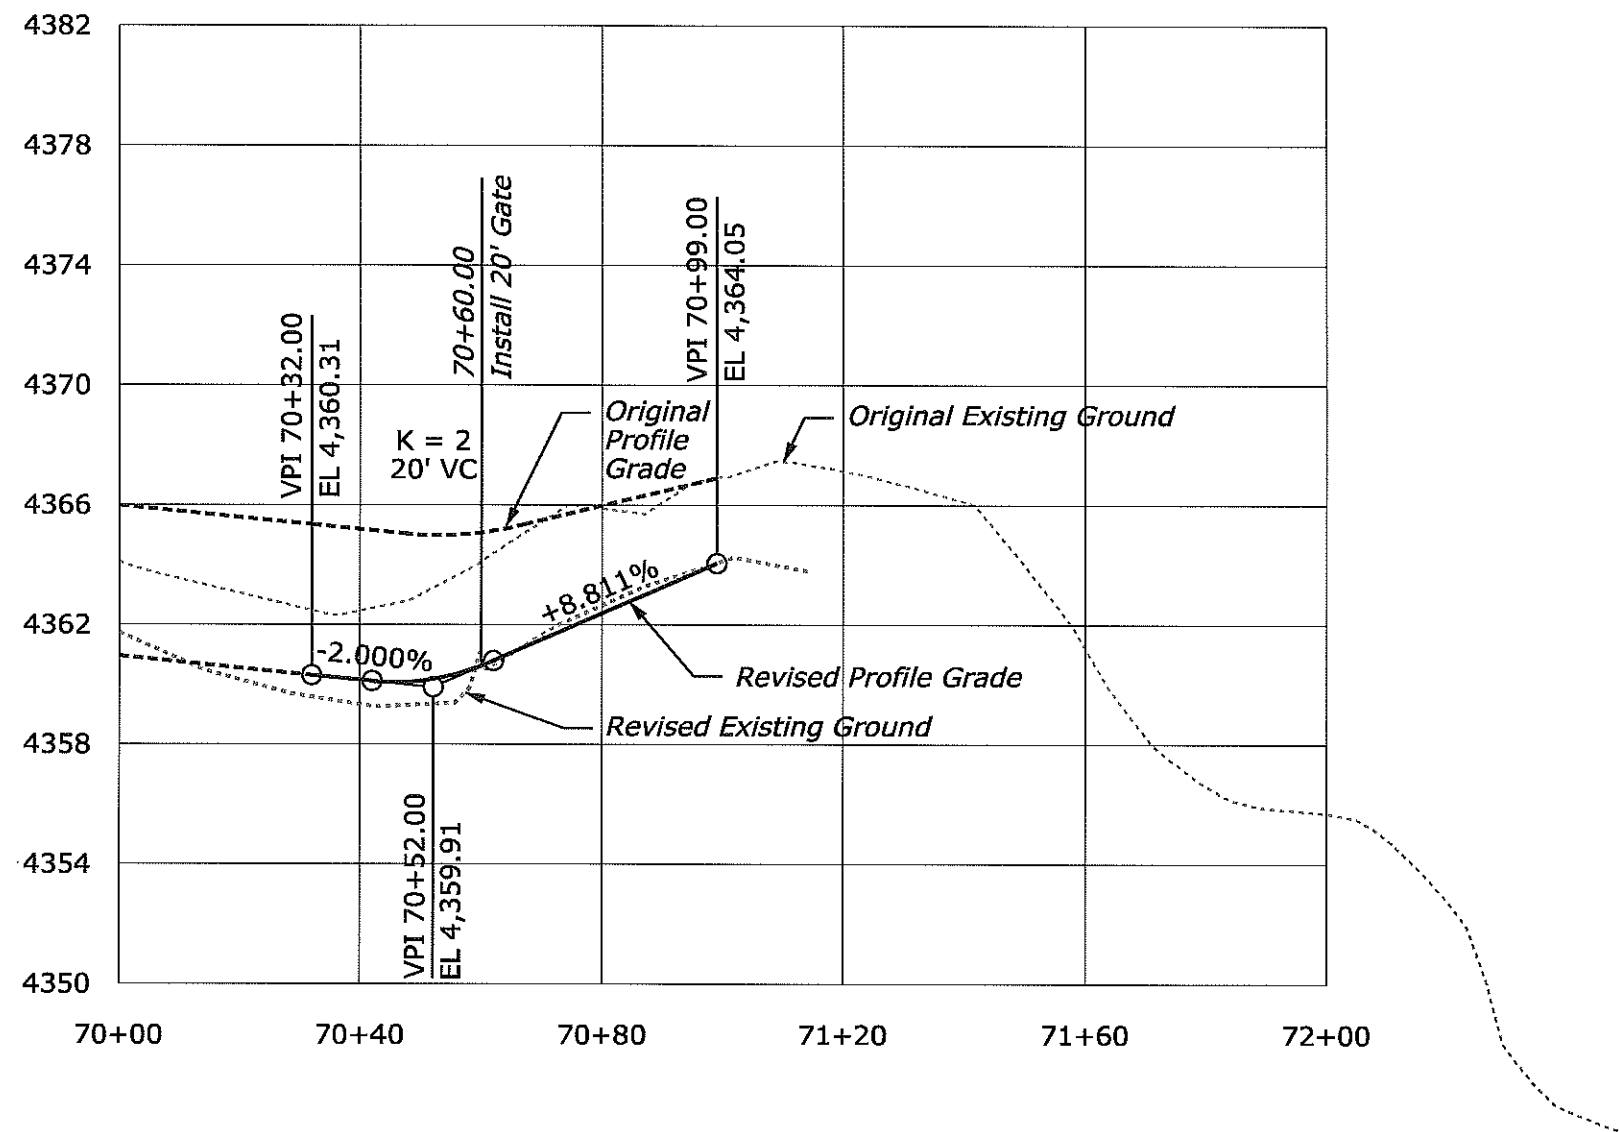

KE'EKE'E ROAD

