








M:\2006\2006_069_004 CFLHD Saddle Road_ West Side\G Drawings\Contract Documents\Civil\HI SR 200(00)_pnp_cul_01.dgn
8:51:42 AM
5/19/2011

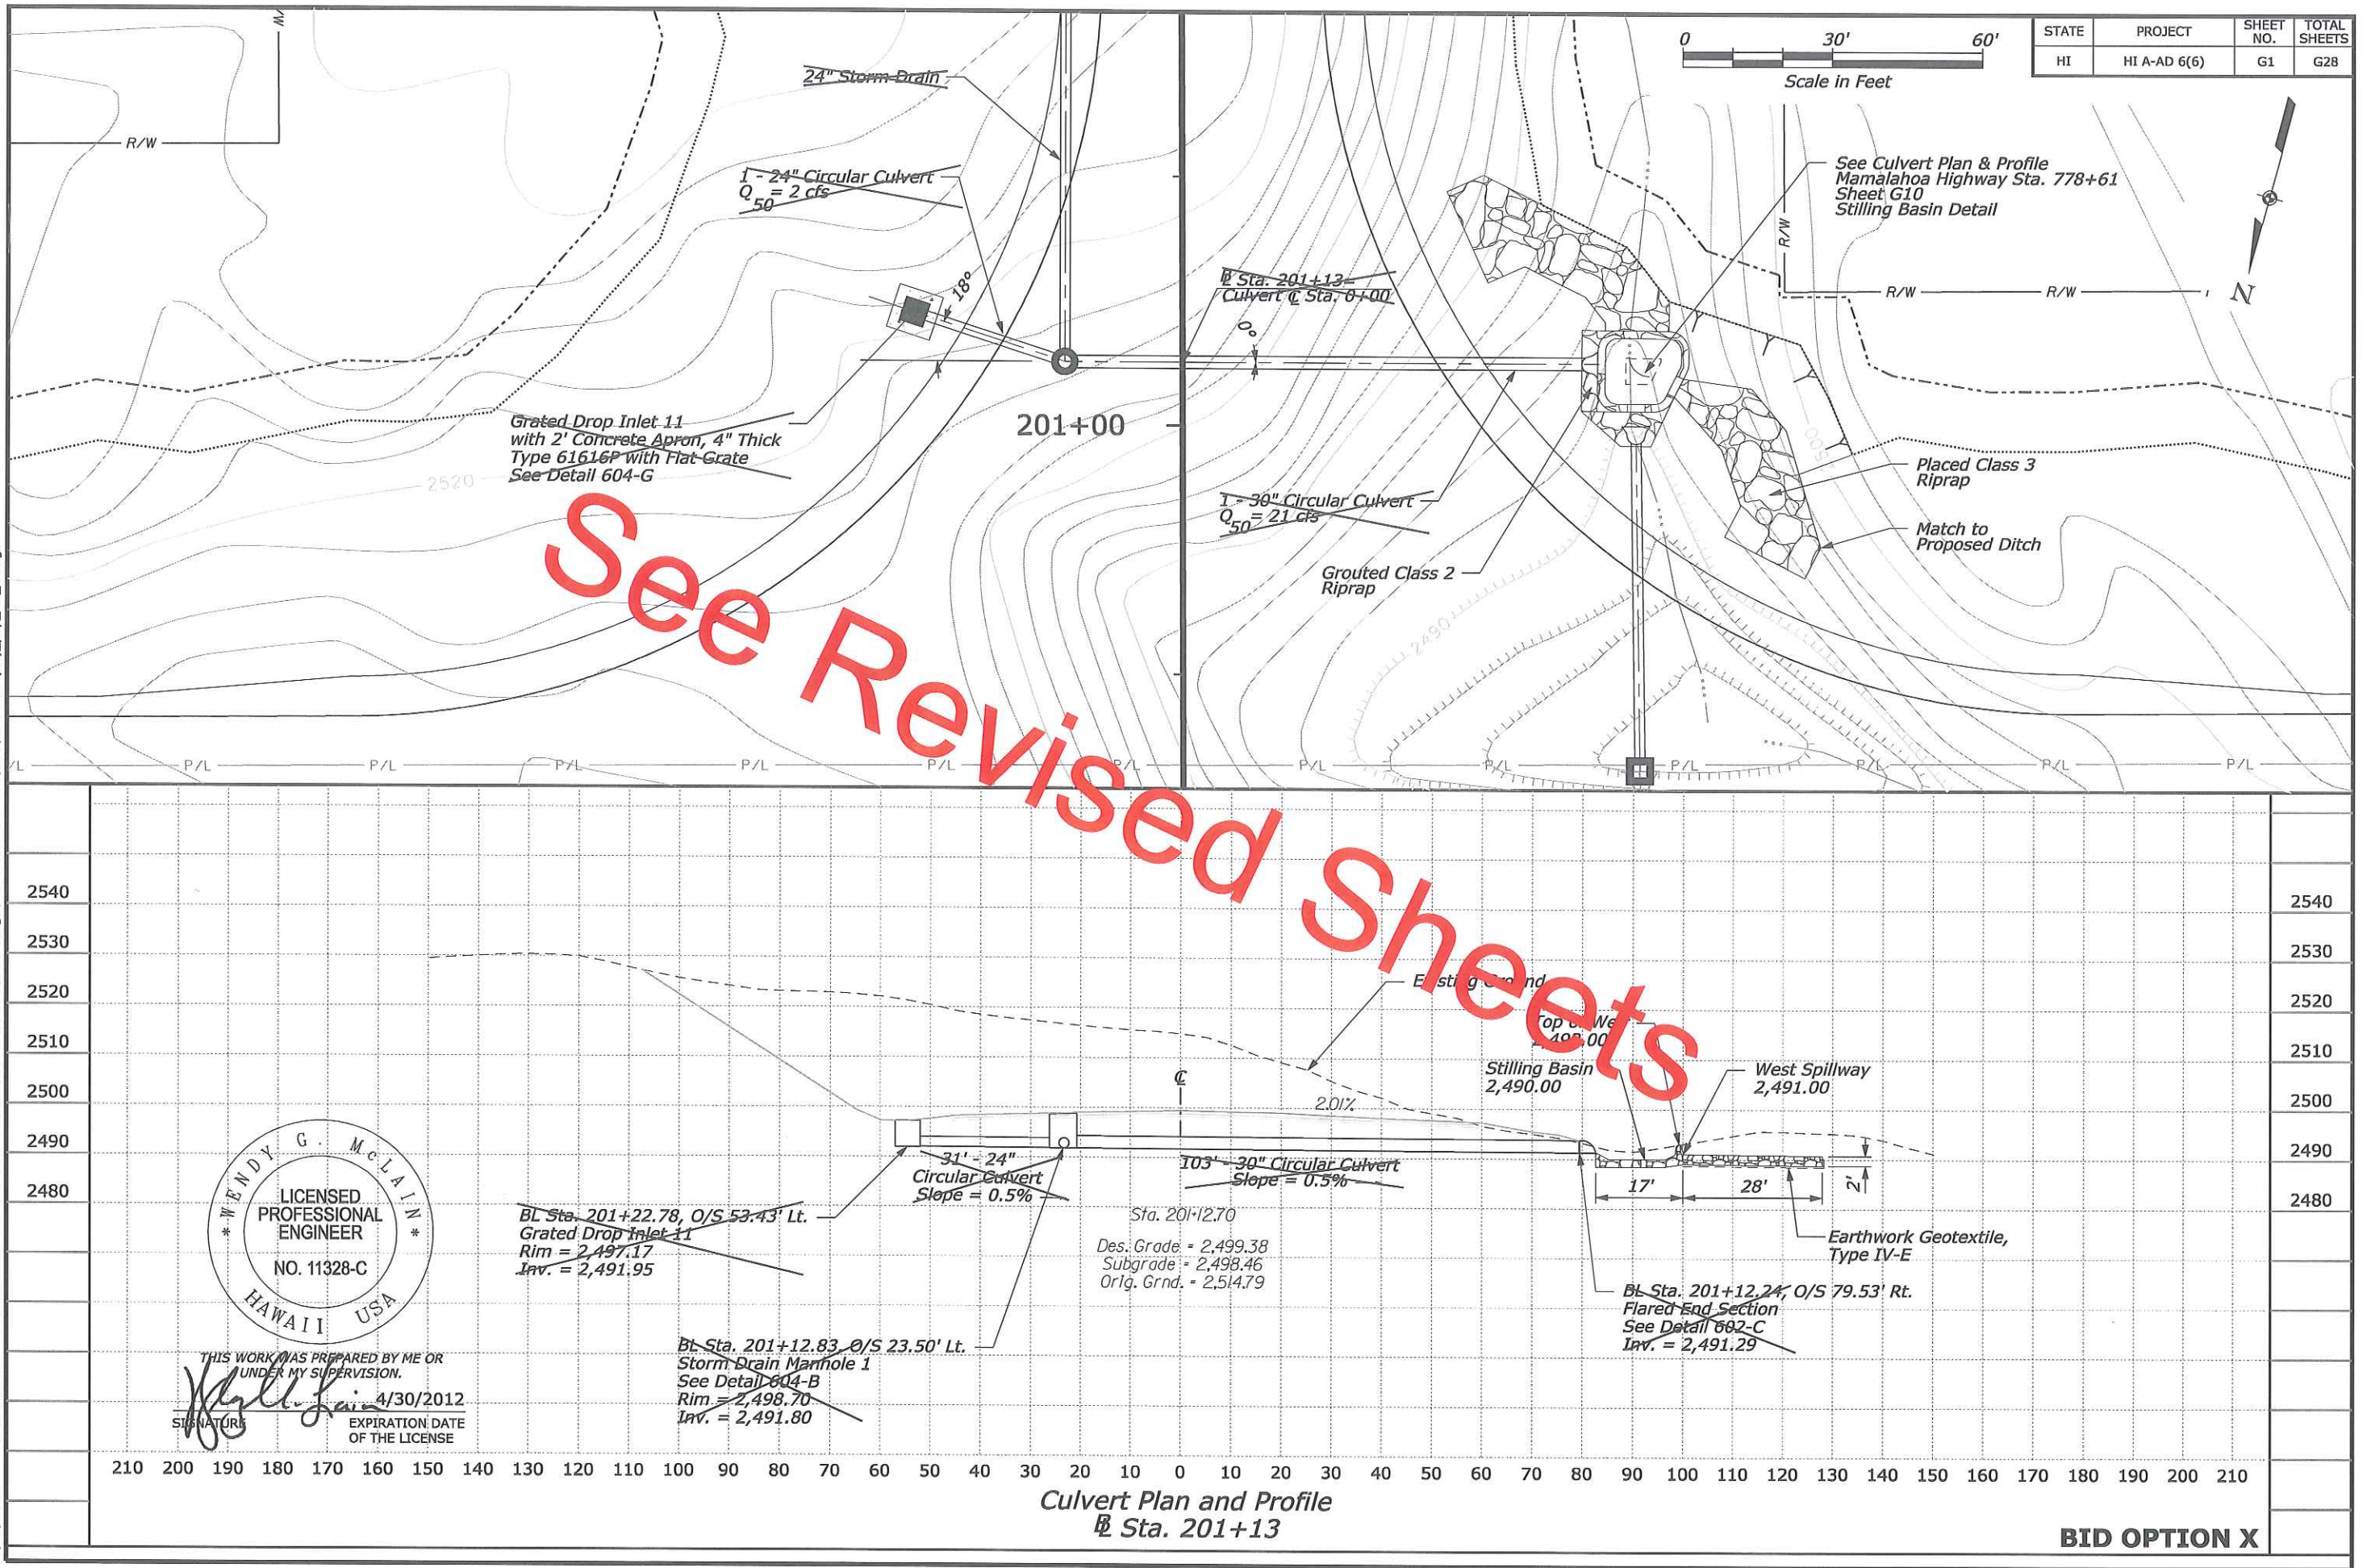

m:\2006\2006_069.004 cfm saddle road_west side\g drawings\contract documents\civil\HI SR 200(00).pnp_cul_02.dgn 5/18/2011 2:41:45 PM

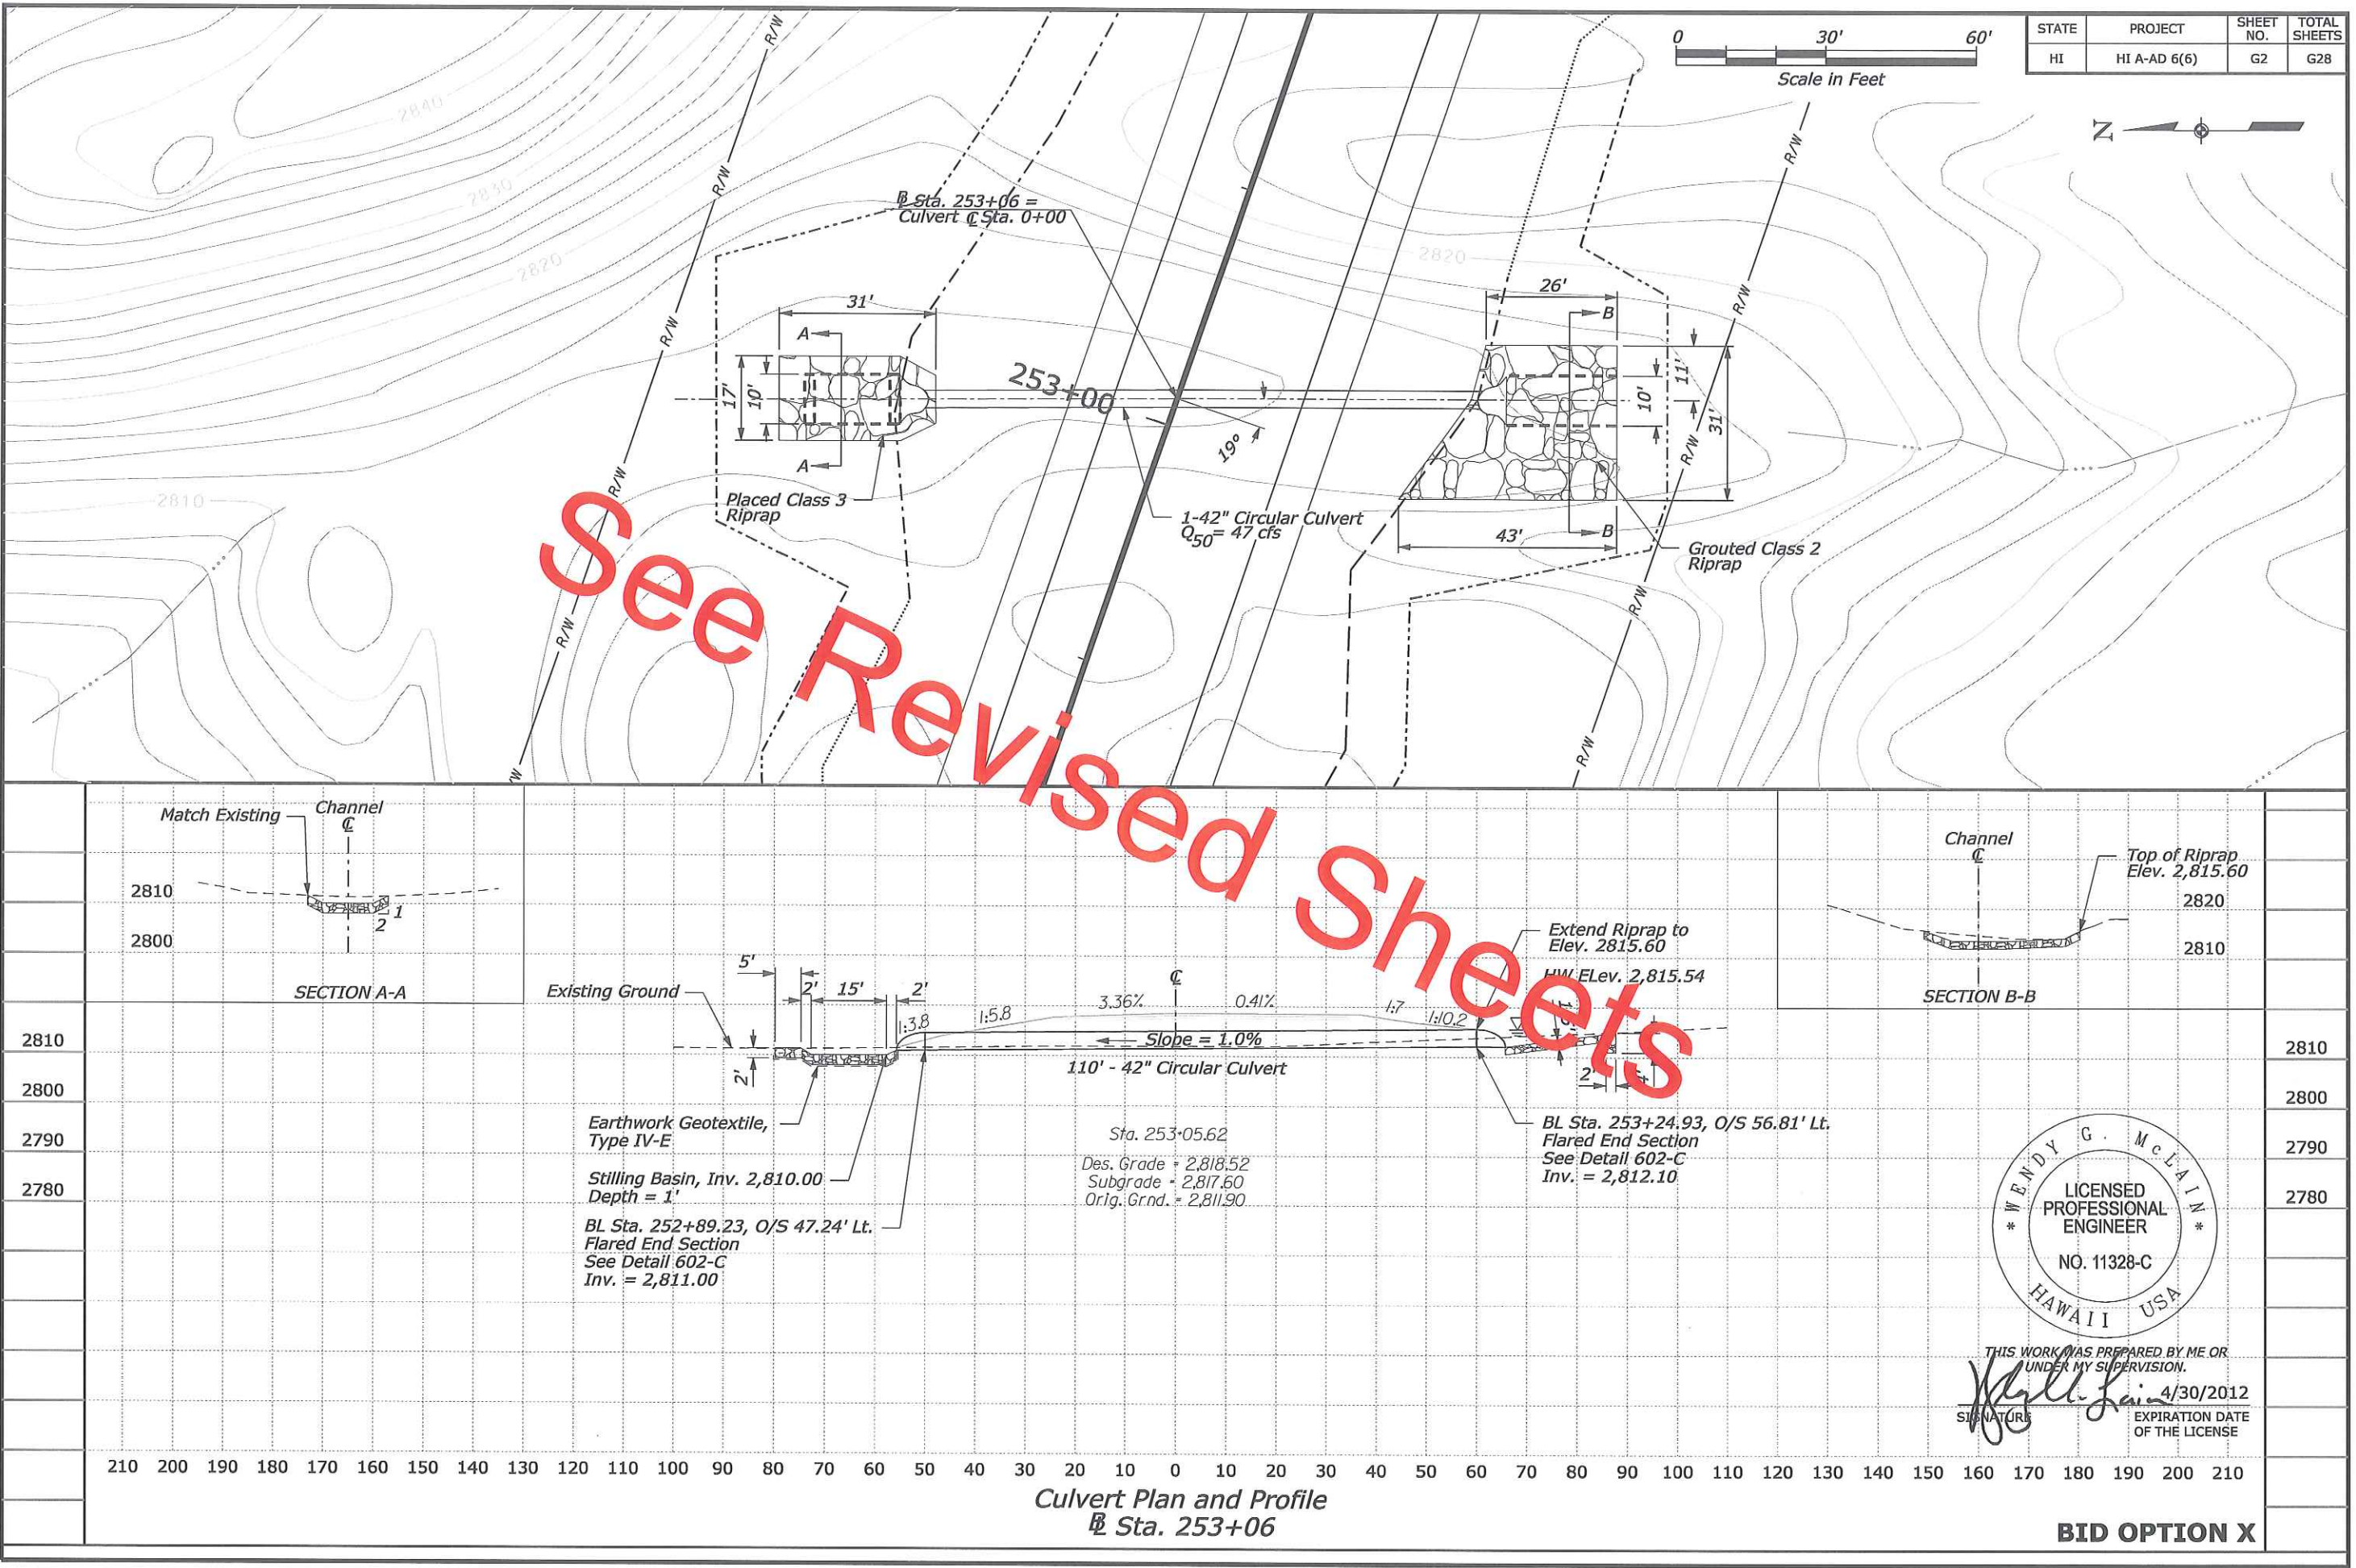

STATE	PROJECT	SHEET NO.	TOTAL SHEETS
HI	HI A-AD 6(6)	G2	G28

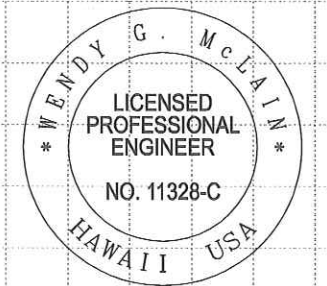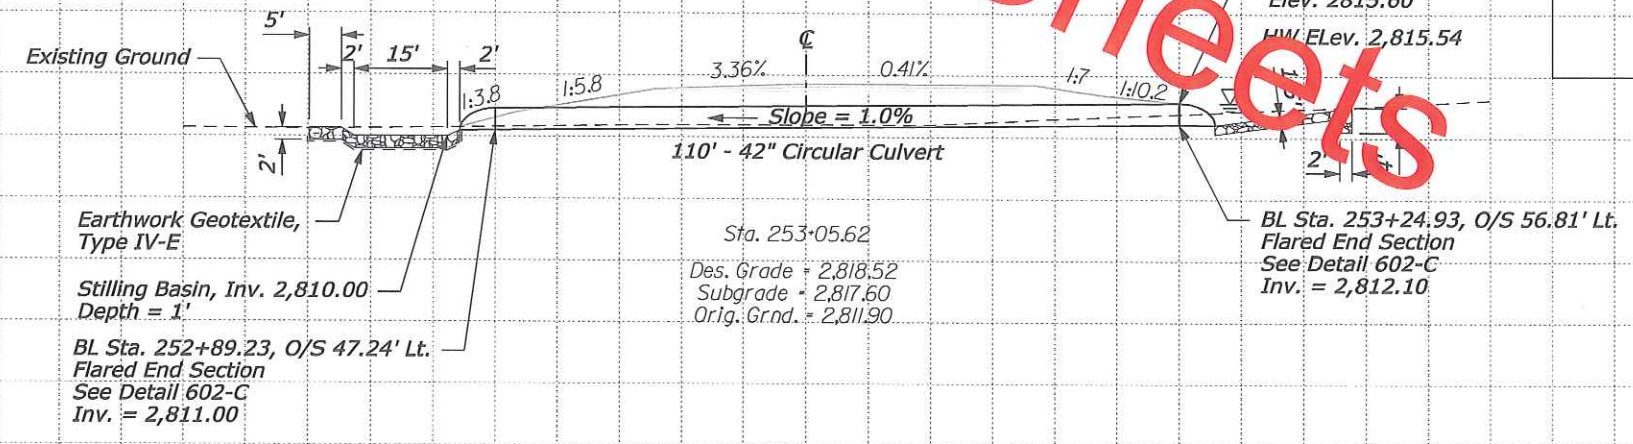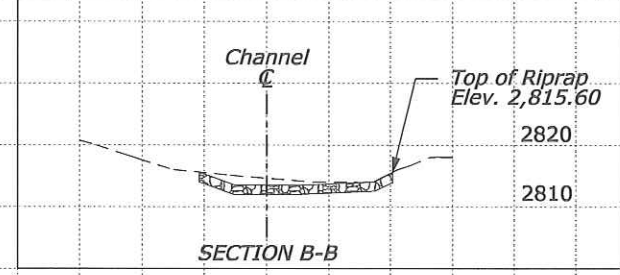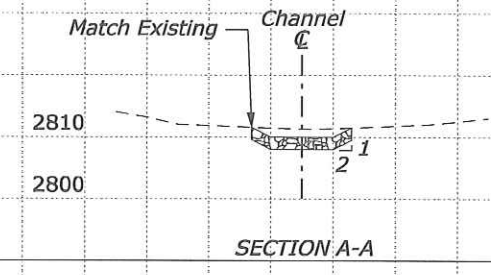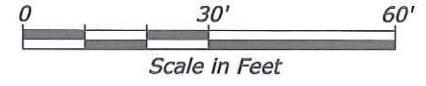



THIS WORK WAS PREPARED BY ME OR UNDER MY SUPERVISION.
SIGNATURE: [Signature] EXPIRATION DATE OF THE LICENSE: 4/30/2012

Culvert Plan and Profile
@ Sta. 253+06

BID OPTION X

SADDLE ROAD - WEST SIDE

HI A-AD 6(6) CULVERT PLAN AND PROFILE STATION 253+06

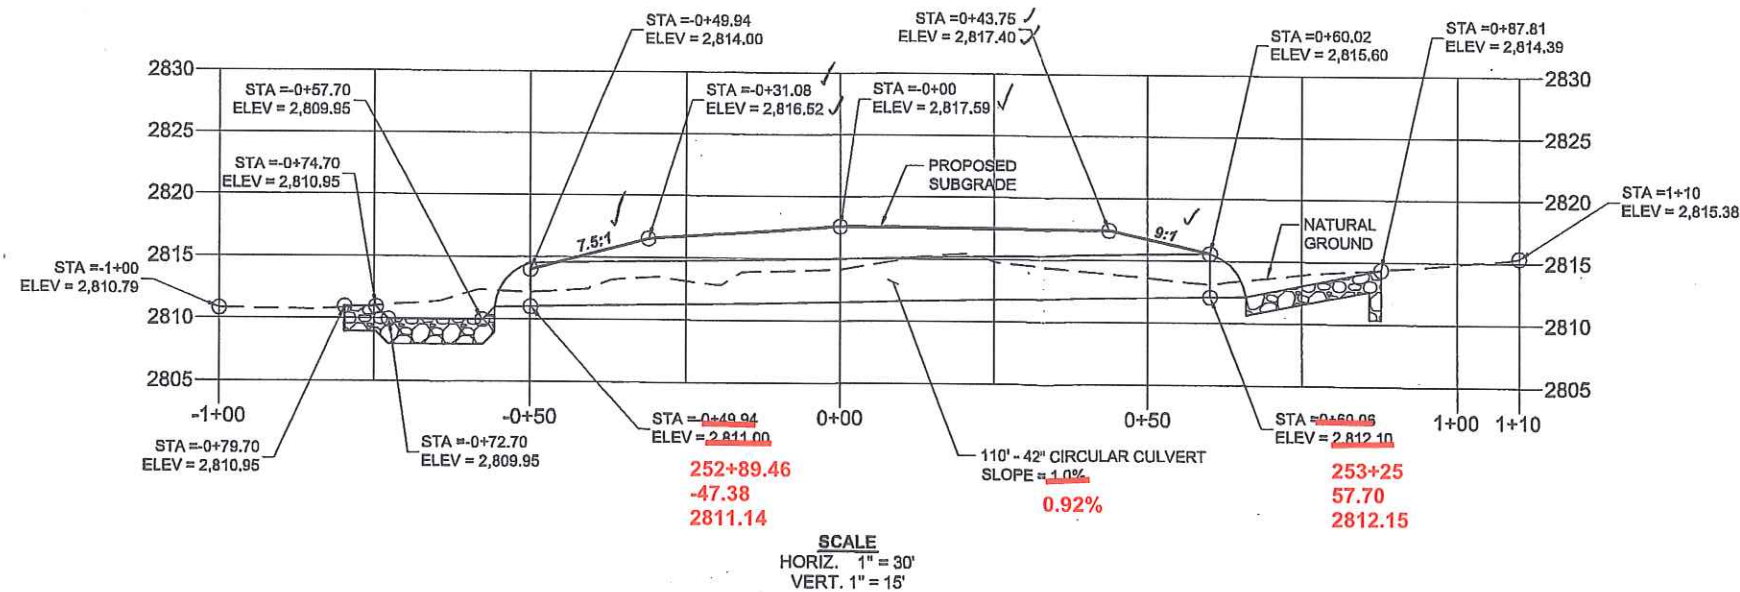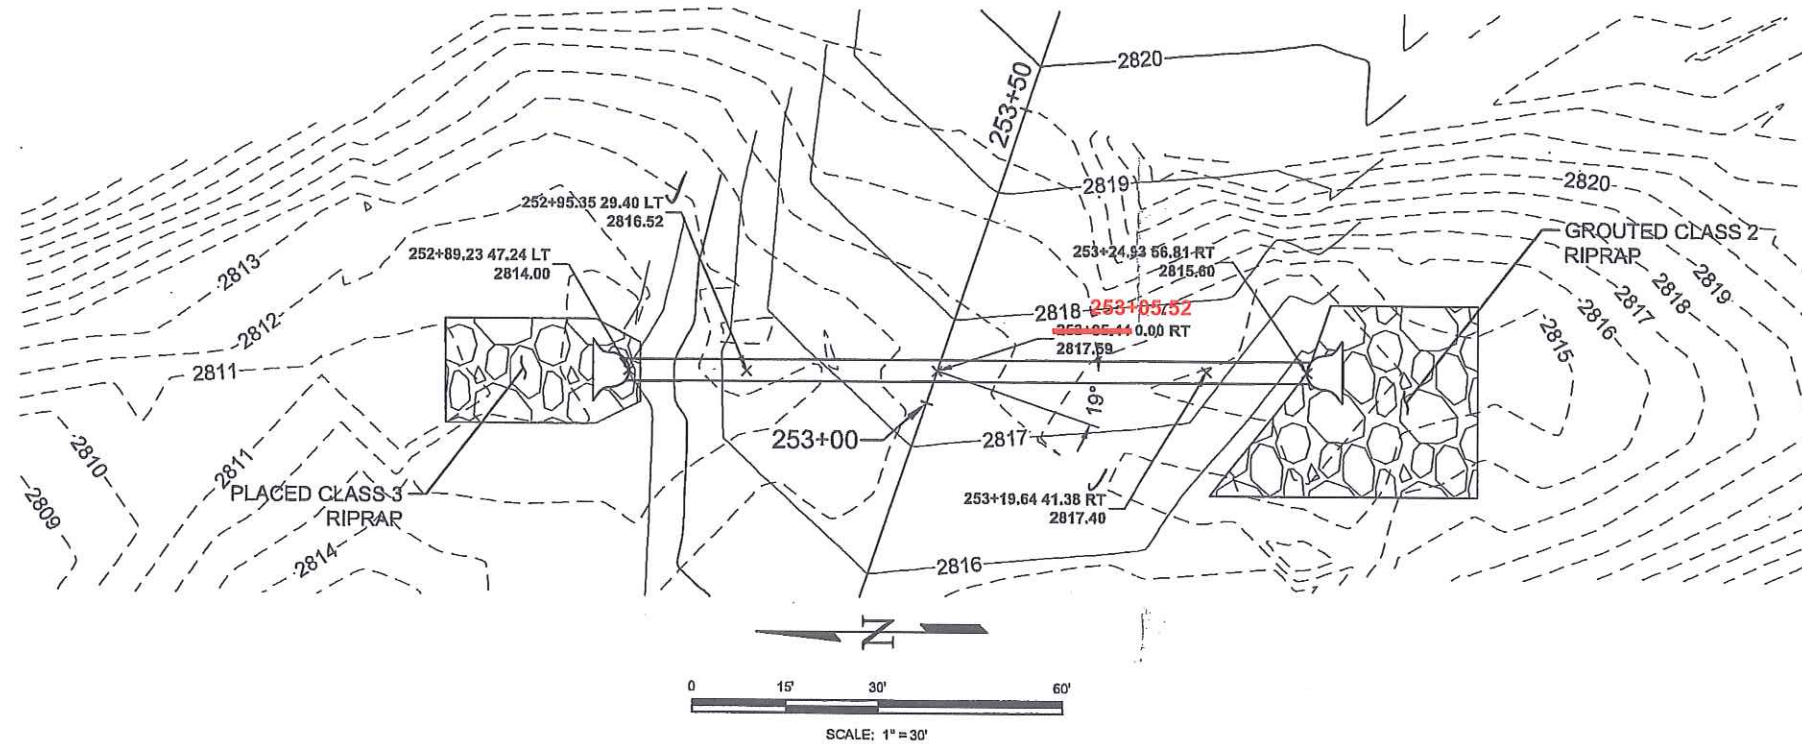

PLAN VIEW NOTES:

STATION AND OFFSET LABELS ARE BASED ON THE SADDLE ROAD CENTERLINE ALIGNMENT.

ELEVATION LABELED ON THE CENTERLINE OF PIPE ARE PROPOSED ROADWAY SUBGRADE.

PROFILE VIEW NOTES:

STATION AND OFFSET LABELS ARE BASED ON THE CENTERLINE OF PIPE ALIGNMENT.

PLAN REFERENCE: SHEET NO. G2

received
02/10/12 mm

Approved 02/13/12

mm

NO.	REVISIONS	DESCRIPTION	DATE


**EDWARD-JAMES
SURVEYING, INC.**
2764 Jantell Road
Colorado Springs, CO 80906
Office: (719) 576-1216
Fax: (719) 576-1206



SADDLE ROAD - WEST SIDE
HI A-AD 6(6)
CULVERT PLAN AND PROFILE
STATION 253+06

DRAWN BY	ERF
CHECKED BY	ERF
H-SCALE	1" = 30'
JOB NO.	1017.00
DATE CREATED	02/03/12
DATE ISSUED	02/08/12
SHEET NO.	1 OF 1

m:\2006\12006_069.004 affhd saddle road_west side\g drawings\contract documents\civil\sr 200(00)_pmp_cul_03.dgn 5/18/2011 2:41:50 PM

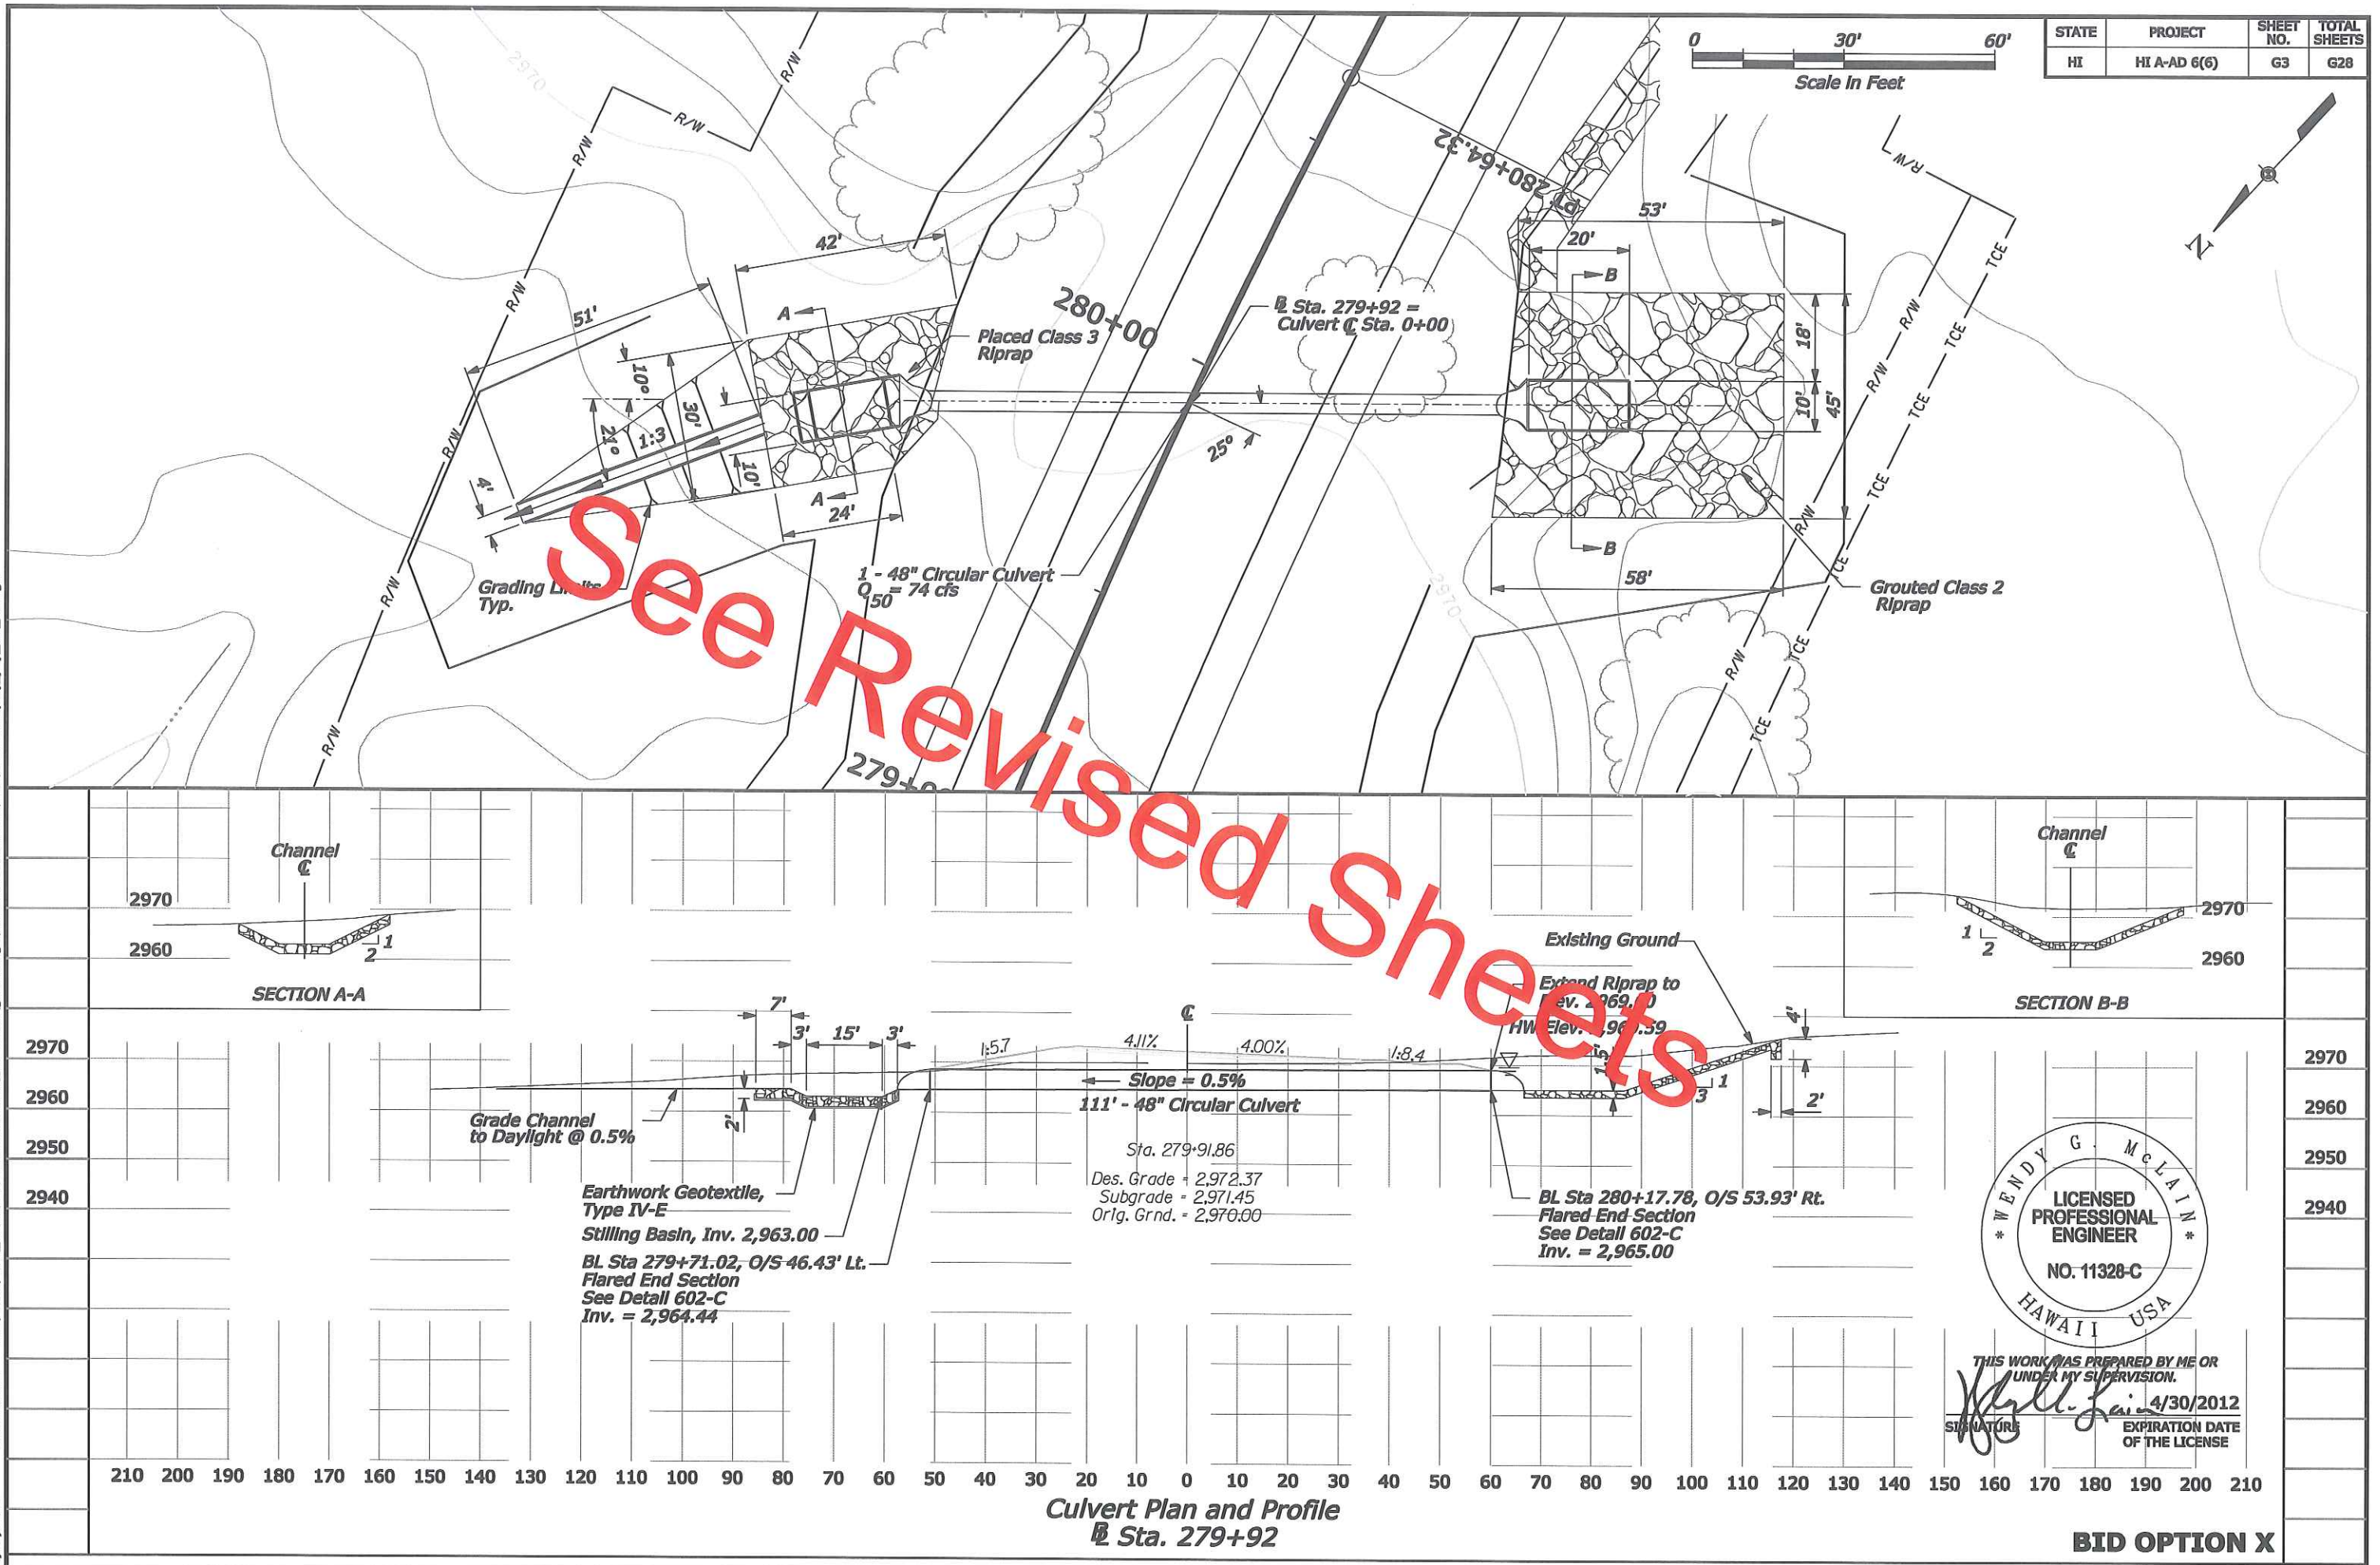

HI A-AD 6(6)
CULVERT PLAN AND PROFILE
STATION 279+92 - *Revised*



ELEVATION LABELED ON THE CENTERLINE OF
PIPE ARE PROPOSED ROADWAY SUBGRADE.



PLAN REFERENCE: SHEET NO. G3

Approved 02/24/12


[illegible]

**EDWARD-JAMES
SURVEYING, INC.**
2764 Janitell Road
Colorado Springs, CO 80906
Office: (719) 576-1216
Fax: (719) 576-1206

4732 Eagleridge Circle
Pueblo, CO 81008
Office: (719) 545-6240
Fax: (719) 545-6247




SADDLE ROAD - WEST SIDE
HI A-AD 6(6)


CULVERT PLAN AND PROFILE
STATION 279+92

DRAWN BY	ERF
CHECKED BY	ERF
H-SCALE	1" = 30'
JOB NO.	1017.00
DATE CREATED	02/21/12
DATE ISSUED	02/23/12
SHEET NO.	1 OF 1

m:\2006\2006_069_004 cihd saddle road_west side\g drawings\contract documents\civil\HI SK 200(00)_enp_cul_04.dgn 5/18/2011 2:41:55 PM

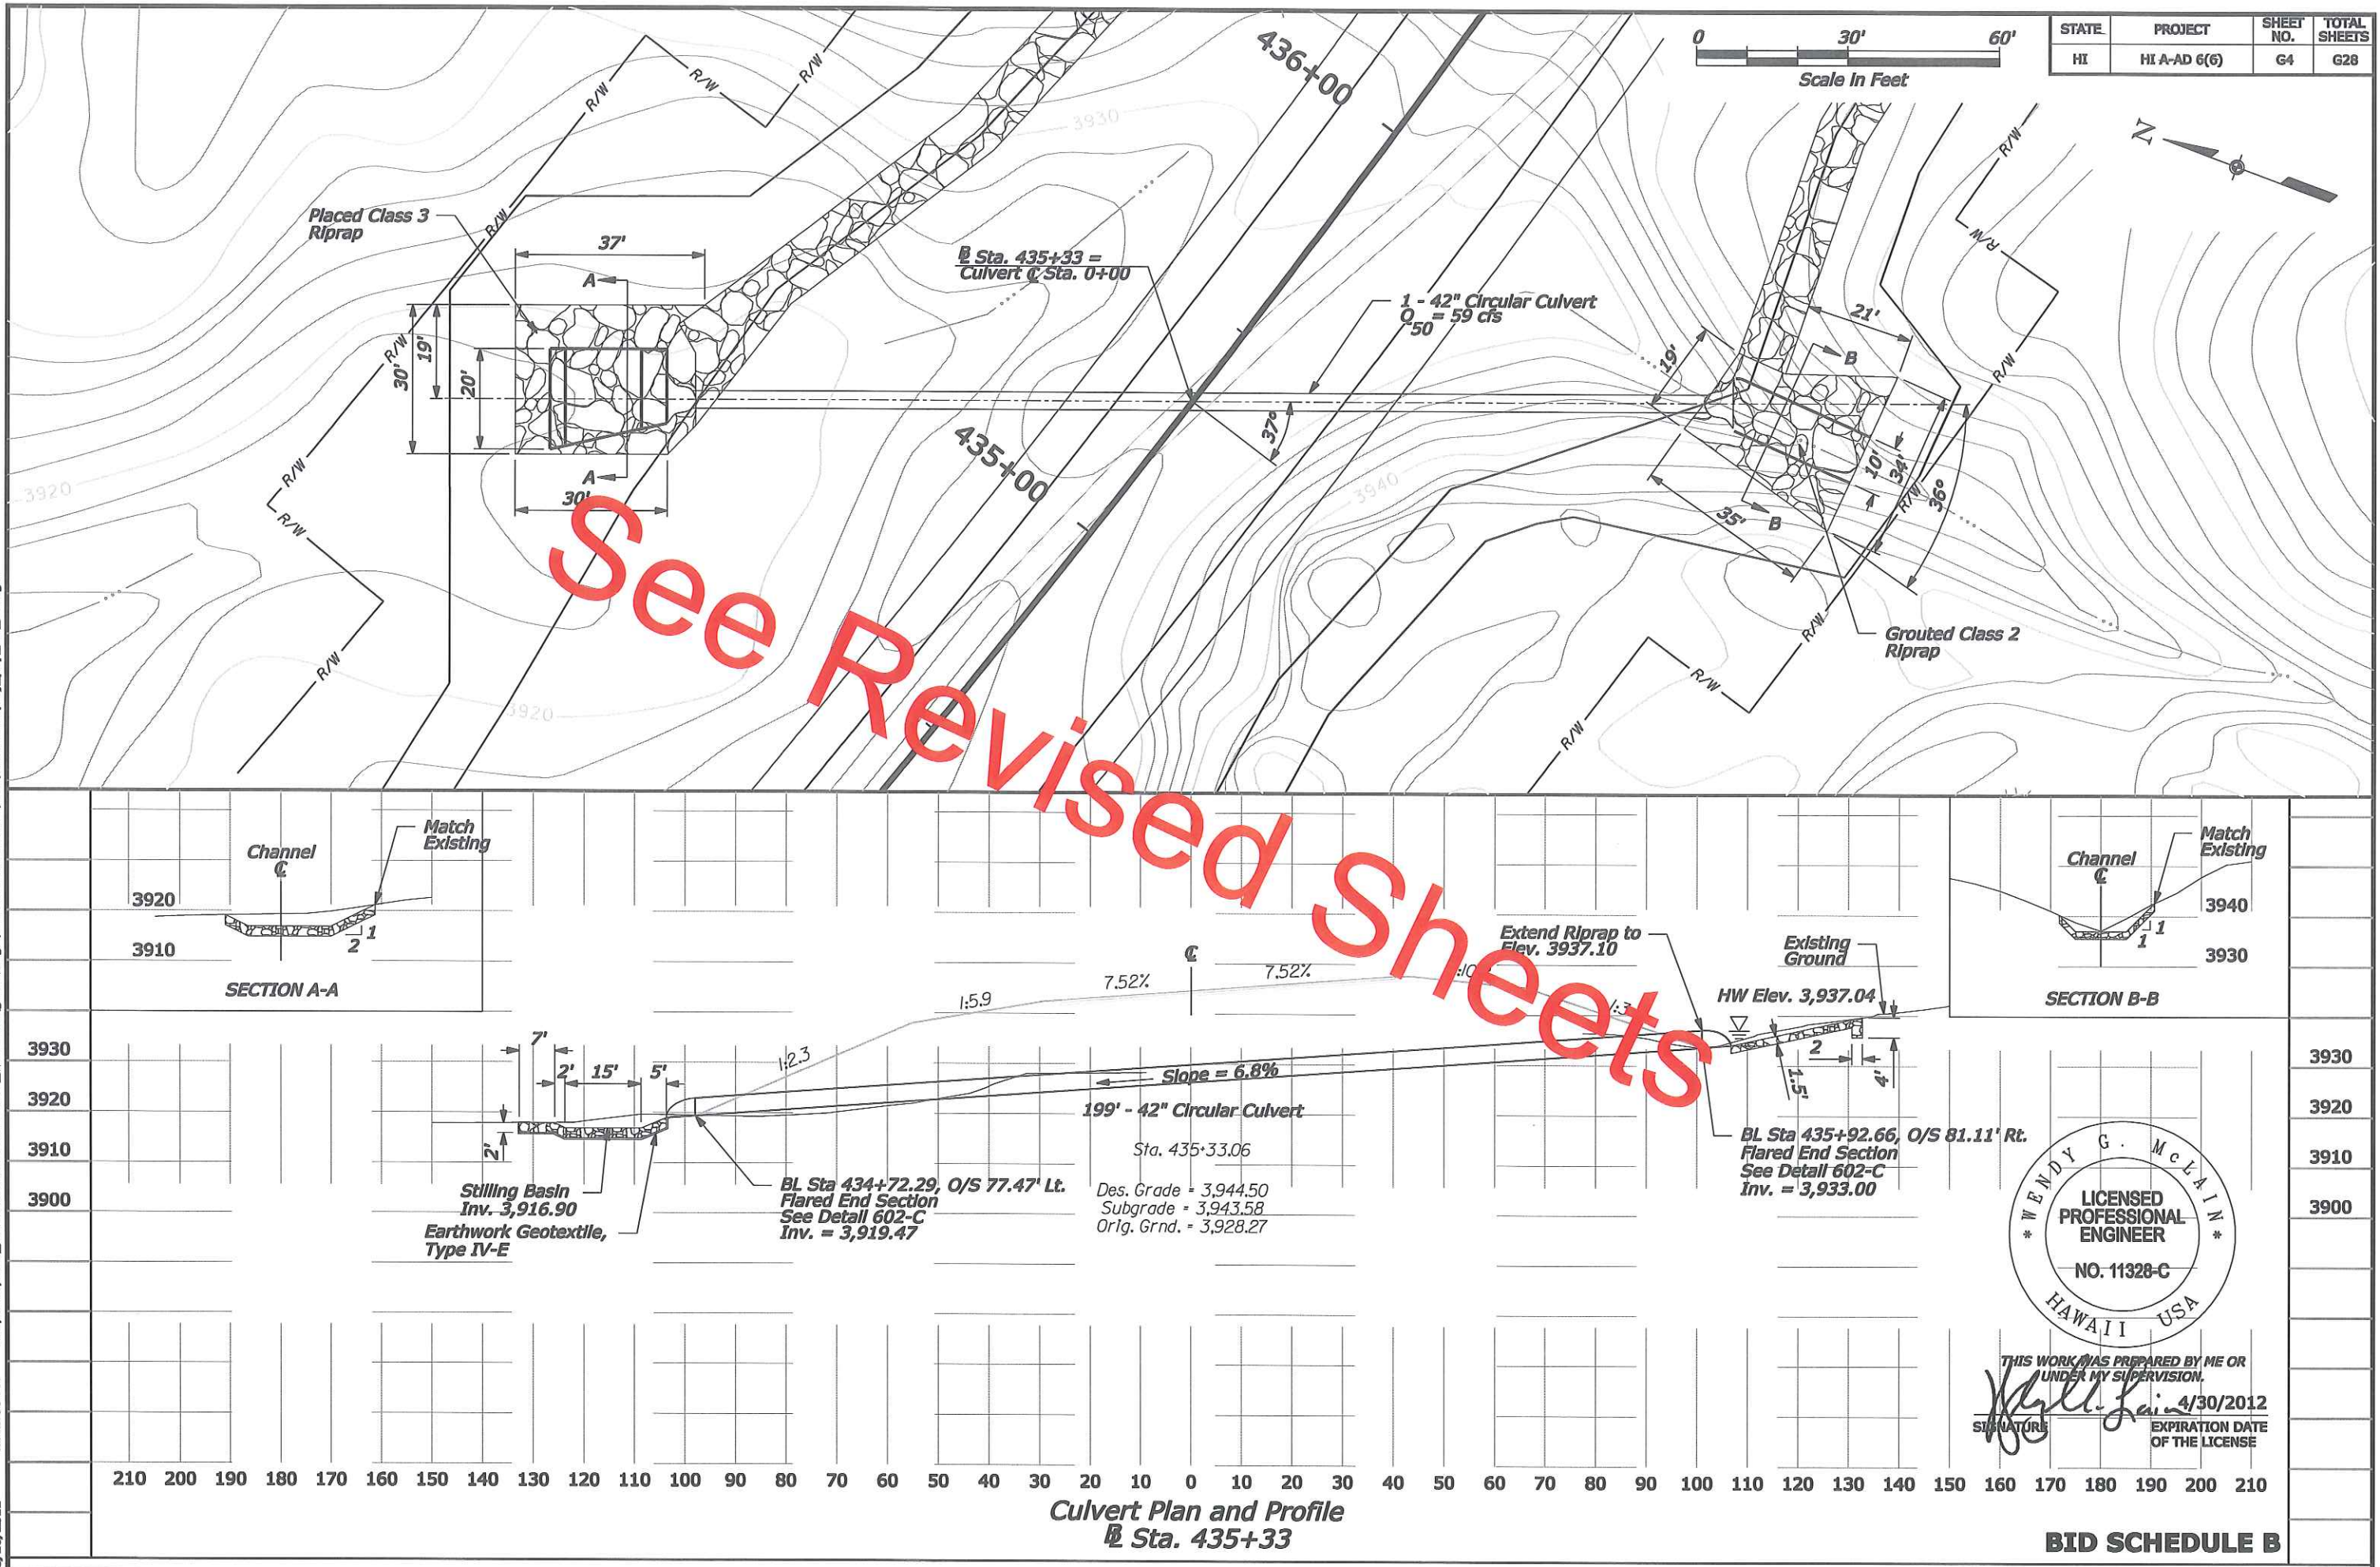

STATE	PROJECT	SHEET NO.	TOTAL SHEETS
HI	HI A-AD 6(6)	G4	G28

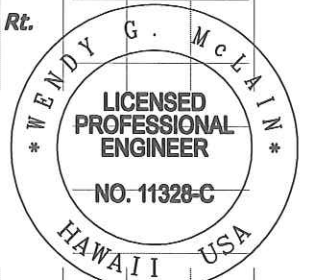

THIS WORK WAS PREPARED BY ME OR UNDER MY SUPERVISION.
4/30/2012
SIGNATURE EXPIRATION DATE OF THE LICENSE


BID SCHEDULE B

SADDLE ROAD - WEST SIDE

HI A-AD 6(6)

CULVERT PLAN AND PROFILE



STATION 435+33

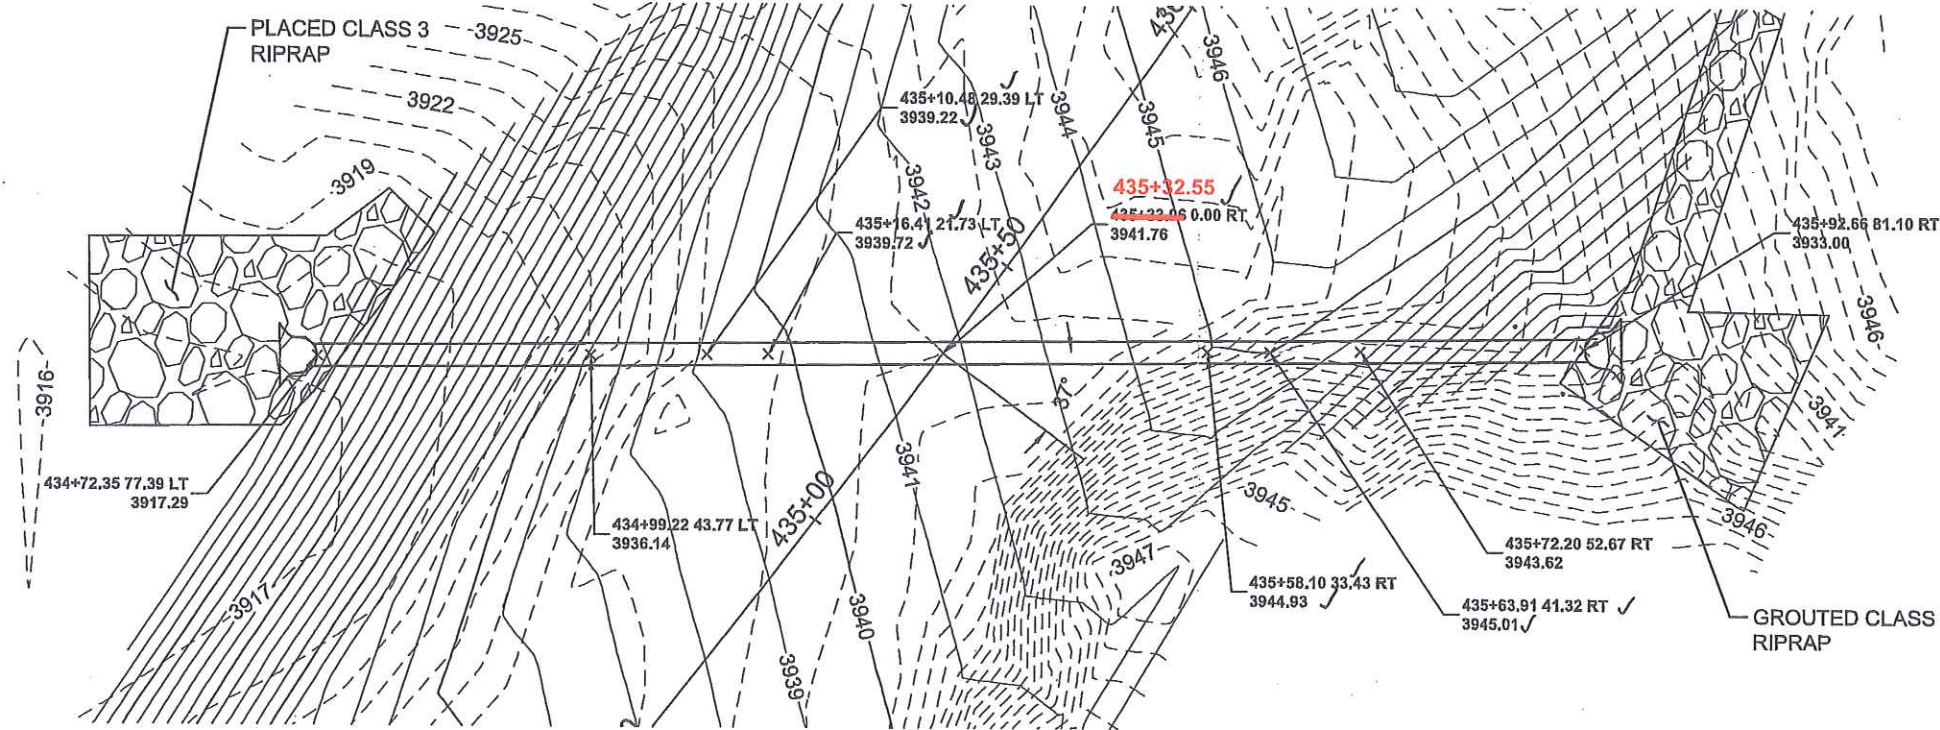

PLAN VIEW NOTES:

STATION AND OFFSET LABELS ARE BASED ON THE SADDLE ROAD CENTERLINE ALIGNMENT.

ELEVATION LABELED ON THE CENTERLINE OF PIPE ARE PROPOSED ROADWAY SUBGRADE.

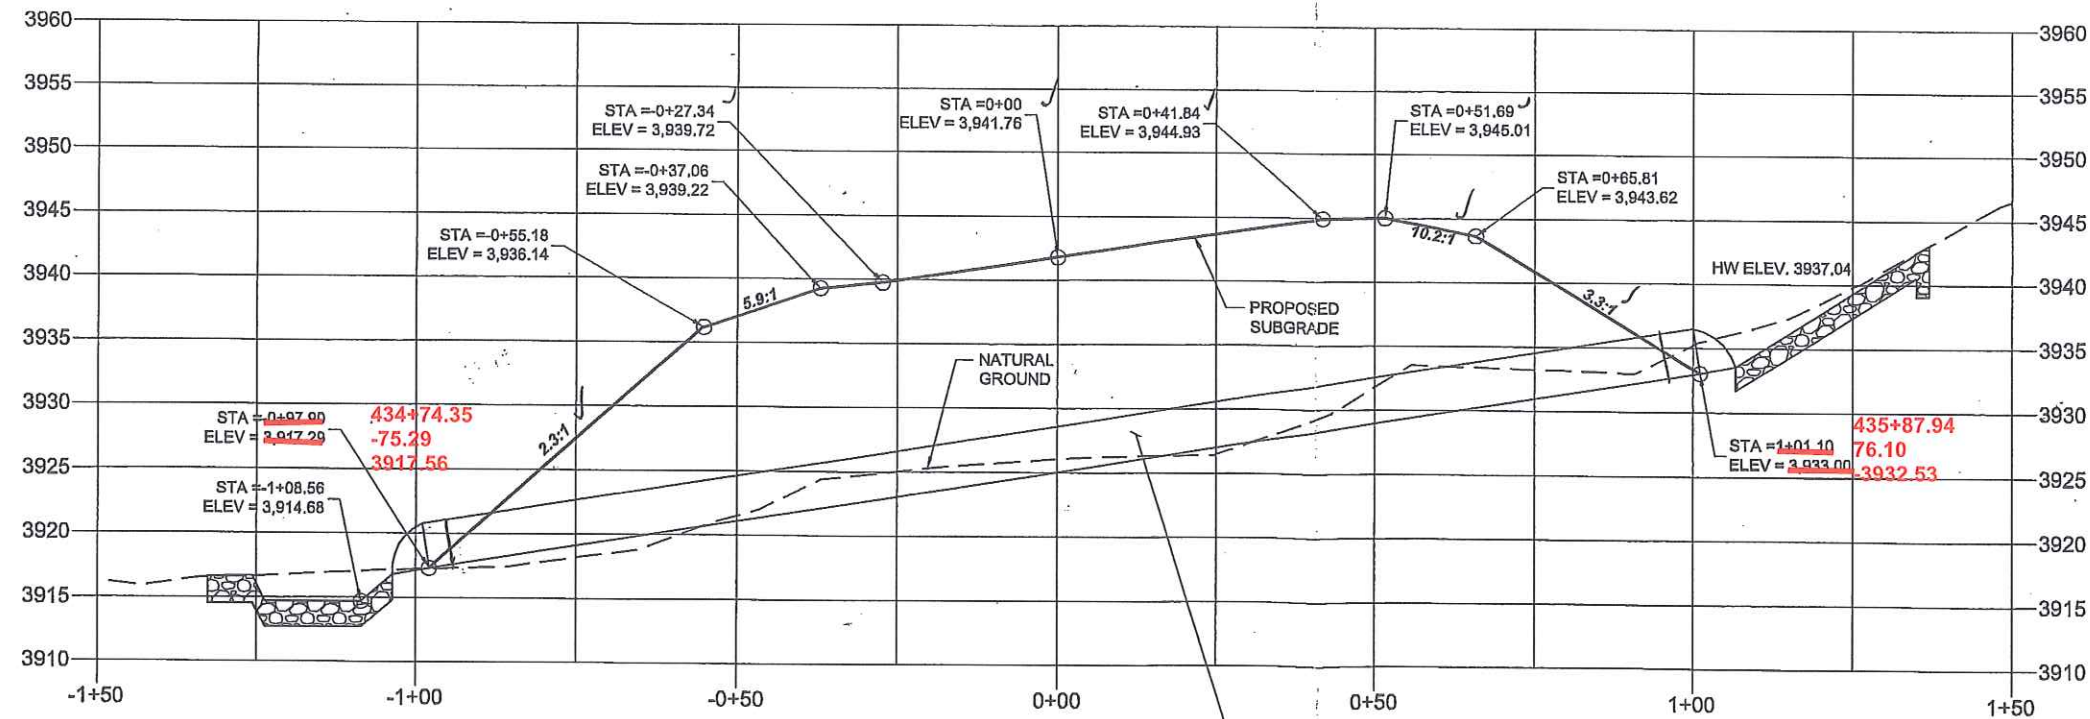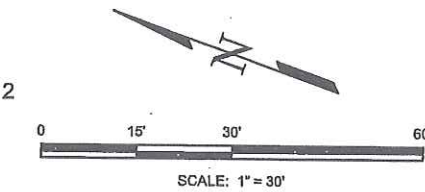

PROFILE VIEW NOTES:

STATION AND OFFSET LABELS ARE BASED ON THE CENTERLINE OF PIPE ALIGNMENT.

PLAN REFERENCE: SHEET NO. G4

Outlet
Sta 0+93.9
Elev ~~3917.29~~

SCALE
HORIZ. 1" = 30'
VERT. 1" = 15'

39" - 42" CIRCULAR CULVERT
SLOPE = 7.88%
L = 190.0'

Inlet
Sta. 0+95.5
Elev = ~~3917.29~~

received
02/29/12 MML

Approved as noted

MML 03/05/12

NO.	REVISIONS	DESCRIPTION	DATE


EDWARD-JAMES SURVEYING, INC.
4732 Eaglebridge Circle
Pueblo, CO 81008
Office: (719) 545-6240
Fax: (719) 545-6247



SADDLE ROAD - WEST SIDE
HI A-AD 6(6)
CULVERT PLAN AND PROFILE
STATION 435+33

DRAWN BY	ERF
CHECKED BY	ERF
H-SCALE	1" = 30'
JOB NO.	1017.00
DATE CREATED	02/24/12
DATE ISSUED	02/29/12
SHEET NO.	1 OF 1

m:\2006\2006_069_004 cihd saddle road_west side\g drawings\contract documents\HI SR 200(00)_pnp_cil_05.dgn 5/18/2011 2:42:00 PM

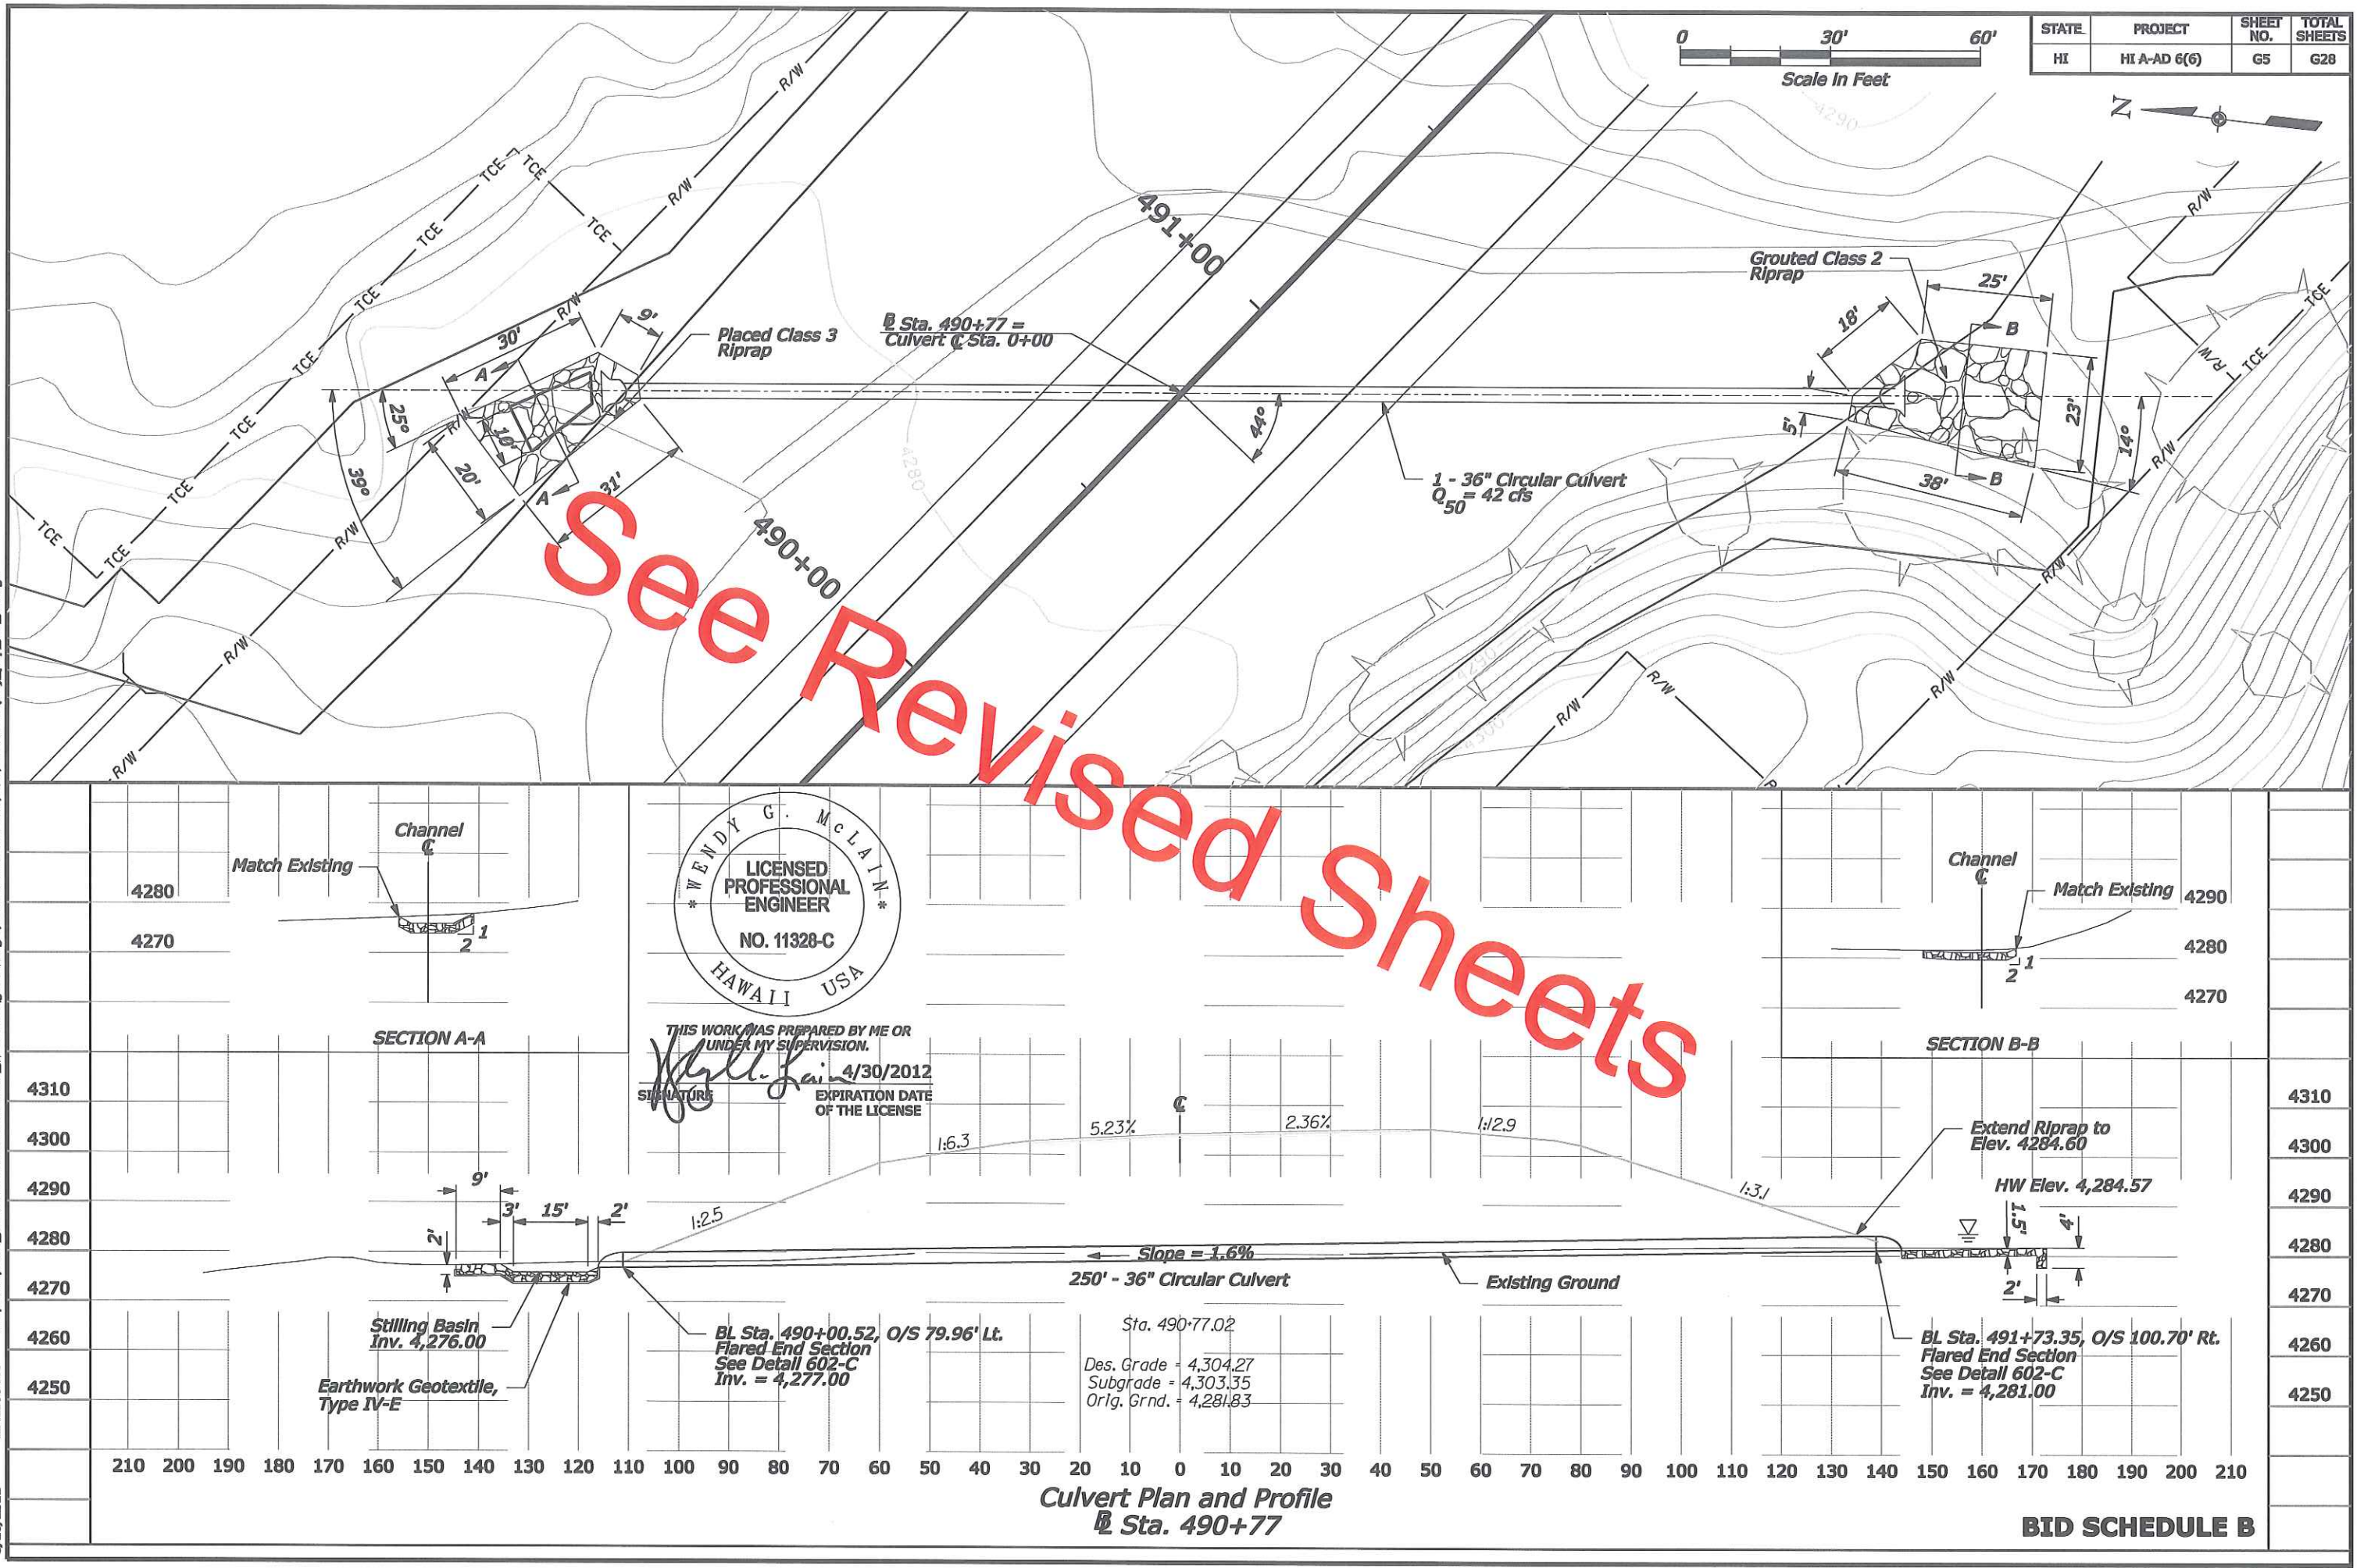


STATE	PROJECT	SHEET NO.	TOTAL SHEETS
HI	HI A-AD 6(6)	G5	G28

STATION 490+77

PLAN REFERENCE: SHEET NO. G5



m:\2006\2006_069_004 cihd saddle road_west side\ drawings\contract documents\civil\HI SR 200(00)_pnp_cul_06.dgn 5/18/2011 2:42:05 PM

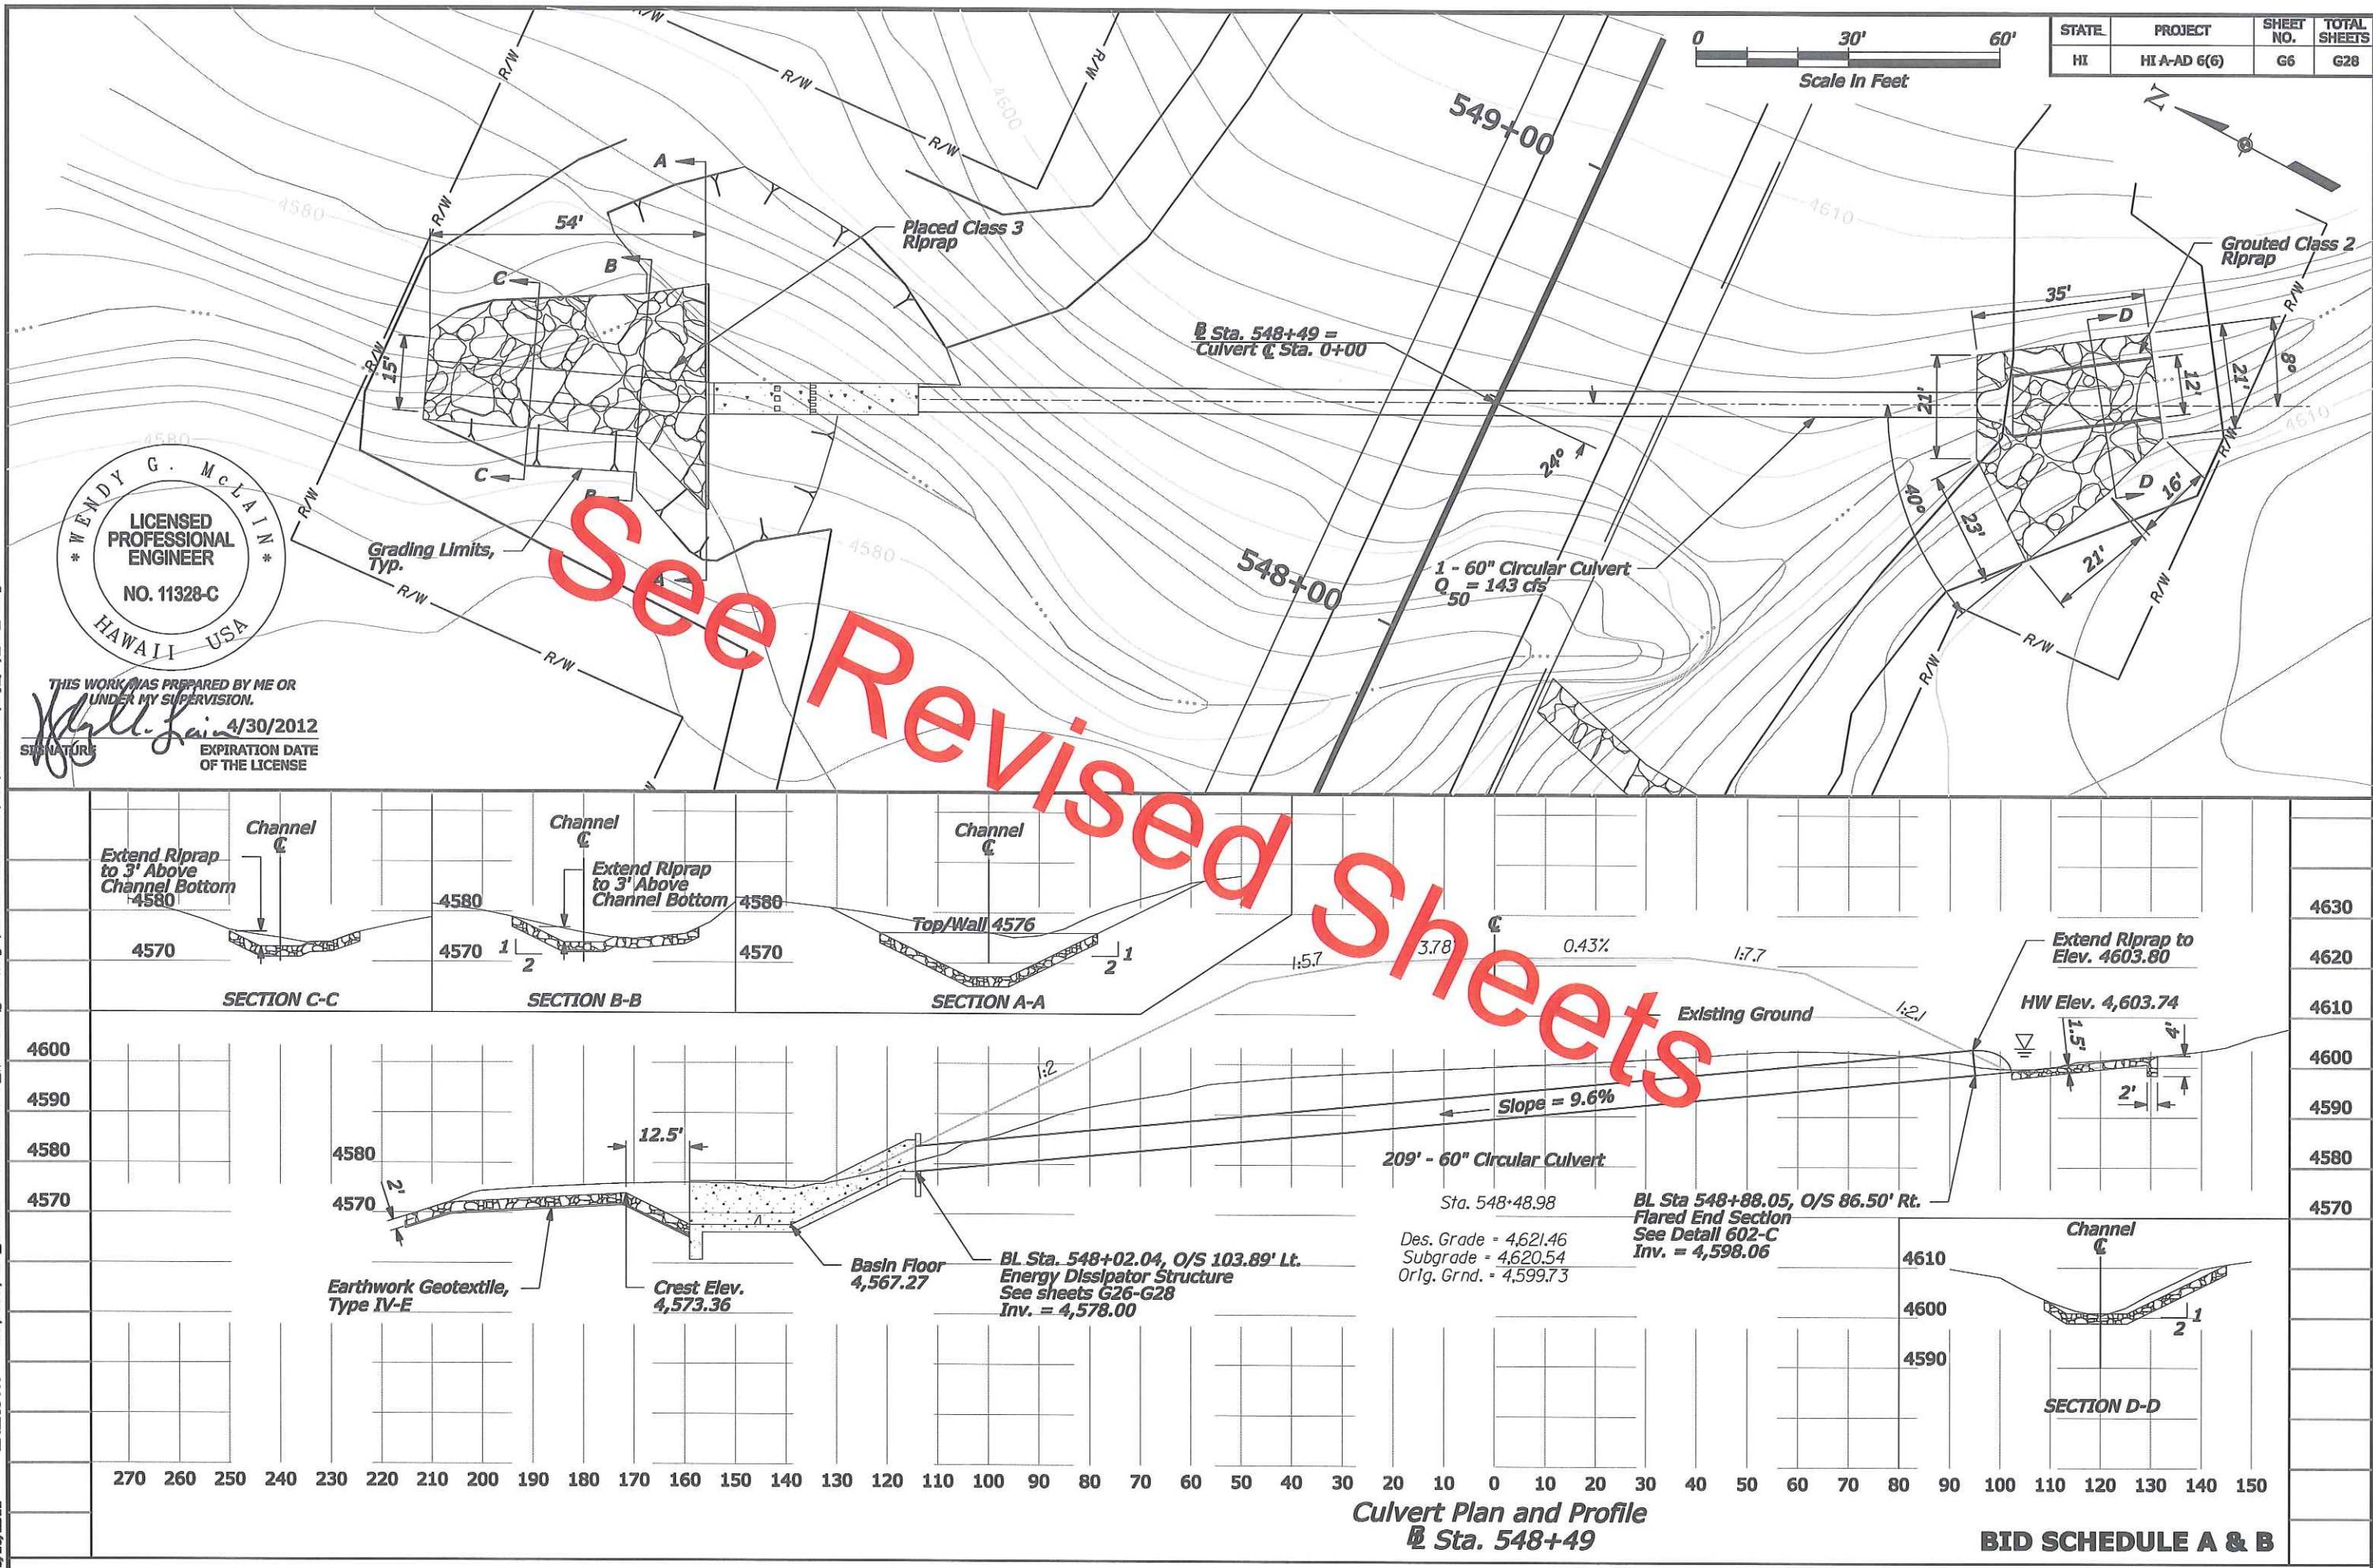

SADDLE ROAD - WEST SIDE

HI A-AD 6(6) CULVERT PLAN AND PROFILE STATION 548+49

Received 3/15/2012
Approved as received
3/16/2012 MHL

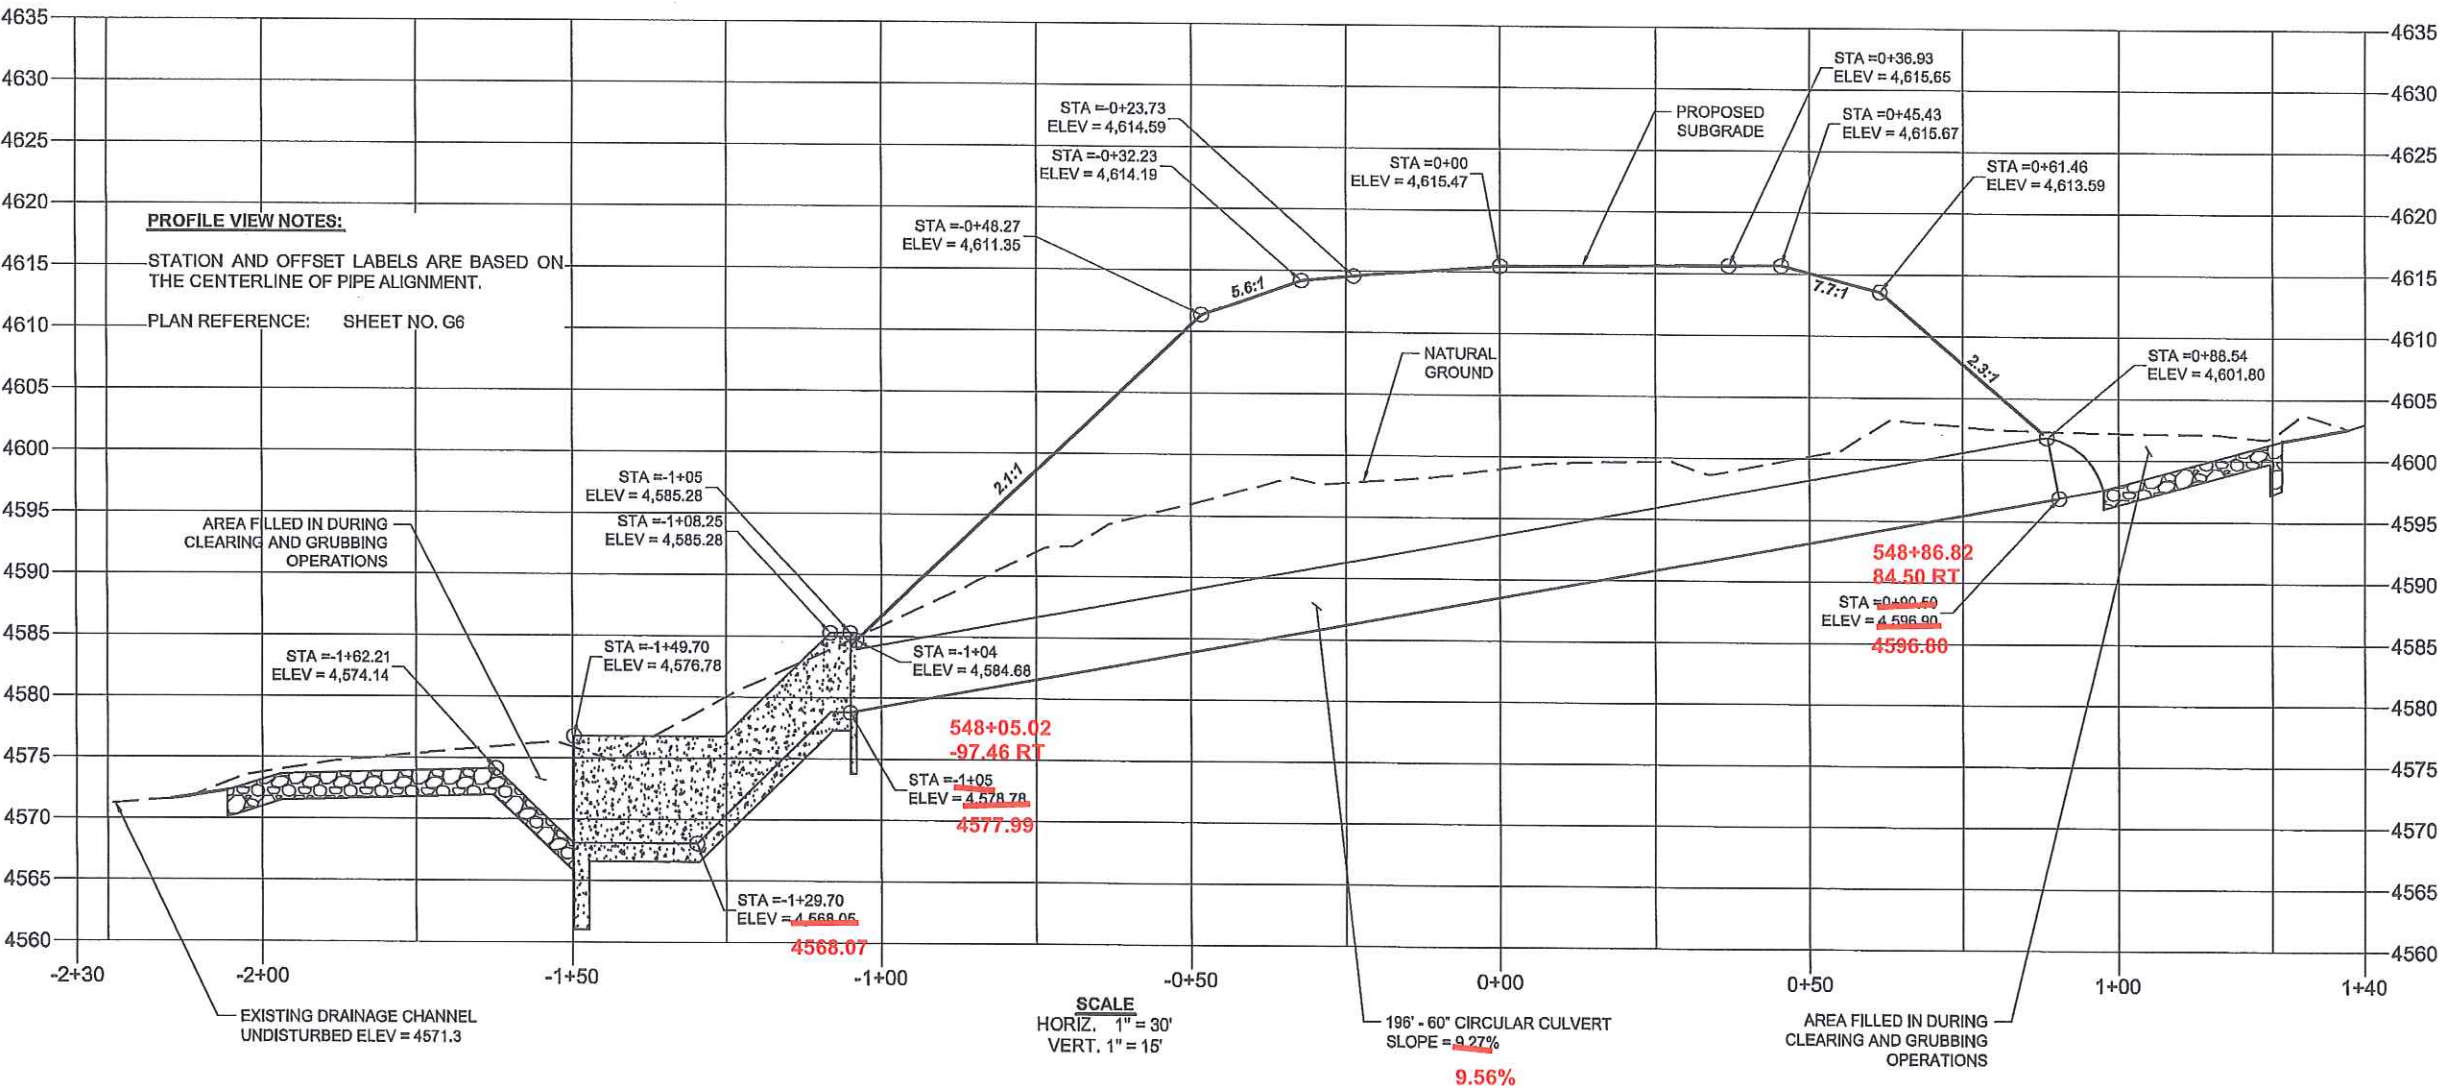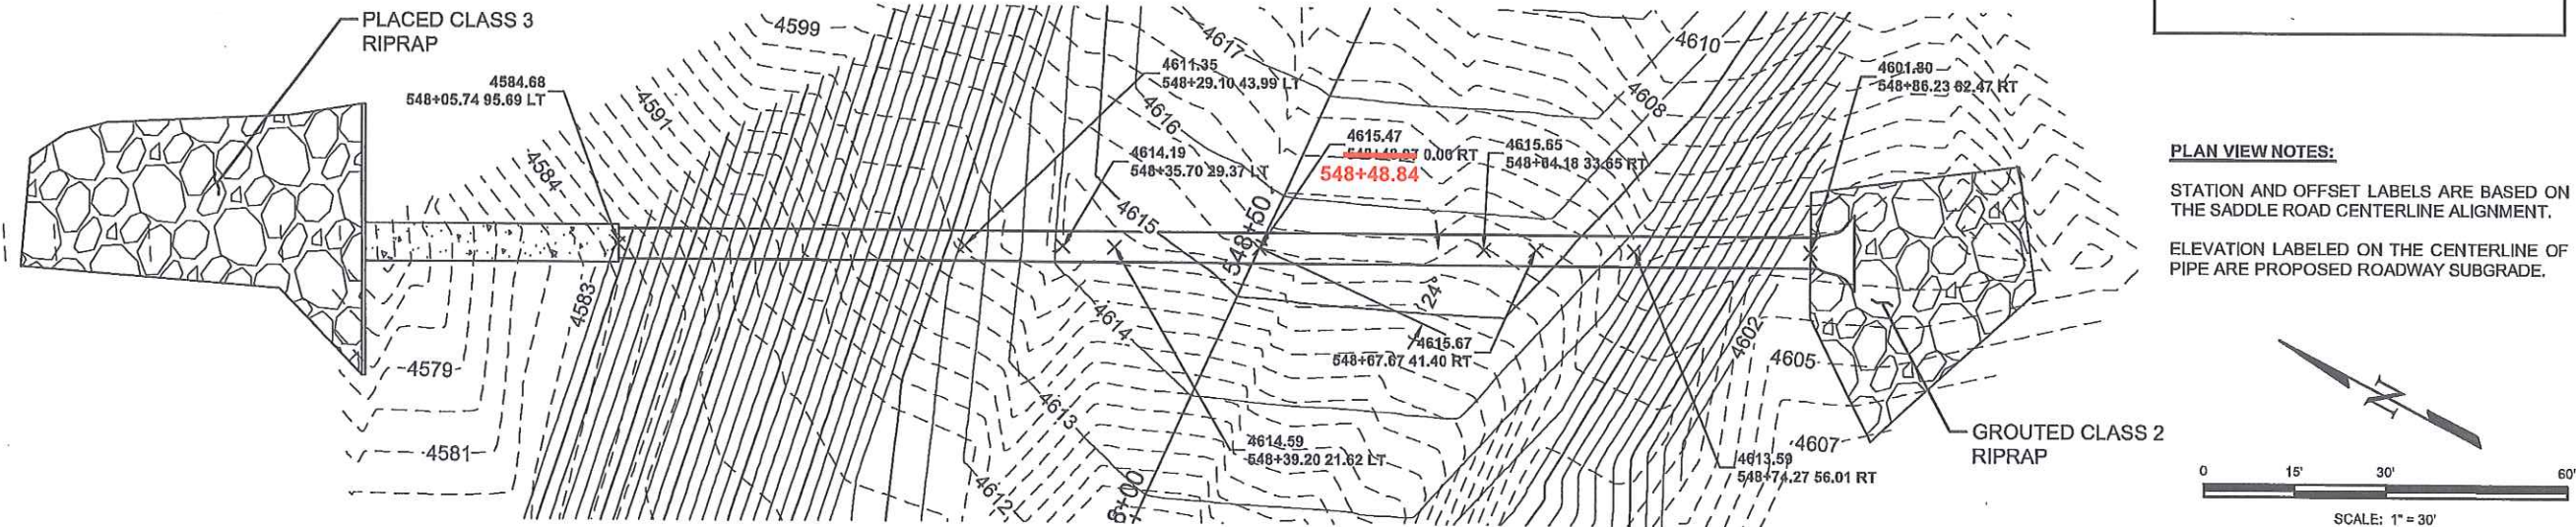

NO.	REVISIONS	DESCRIPTION	DATE


EDWARD-JAMES
SURVEYING, INC.
2764 Janitell Road
Colorado Springs, CO 80906
Office: (719) 576-1216
Fax: (719) 576-1206



SADDLE ROAD - WEST SIDE
HI A-AD 6(6)
CULVERT PLAN AND PROFILE
STATION 548+49



DRAWN BY	ERF
CHECKED BY	ERF
H-SCALE	1" = 30'
JOB NO.	1017.00
DATE CREATED	02/24/12
DATE ISSUED	03/15/12
SHEET NO.	1 OF 1

m:\2006\2006_069_004 cihd saddle road_west side\g drawings\contract documents\HI SR 200(00)_pnp_cal_07.dgn 5/18/2011 2:42:11 PM

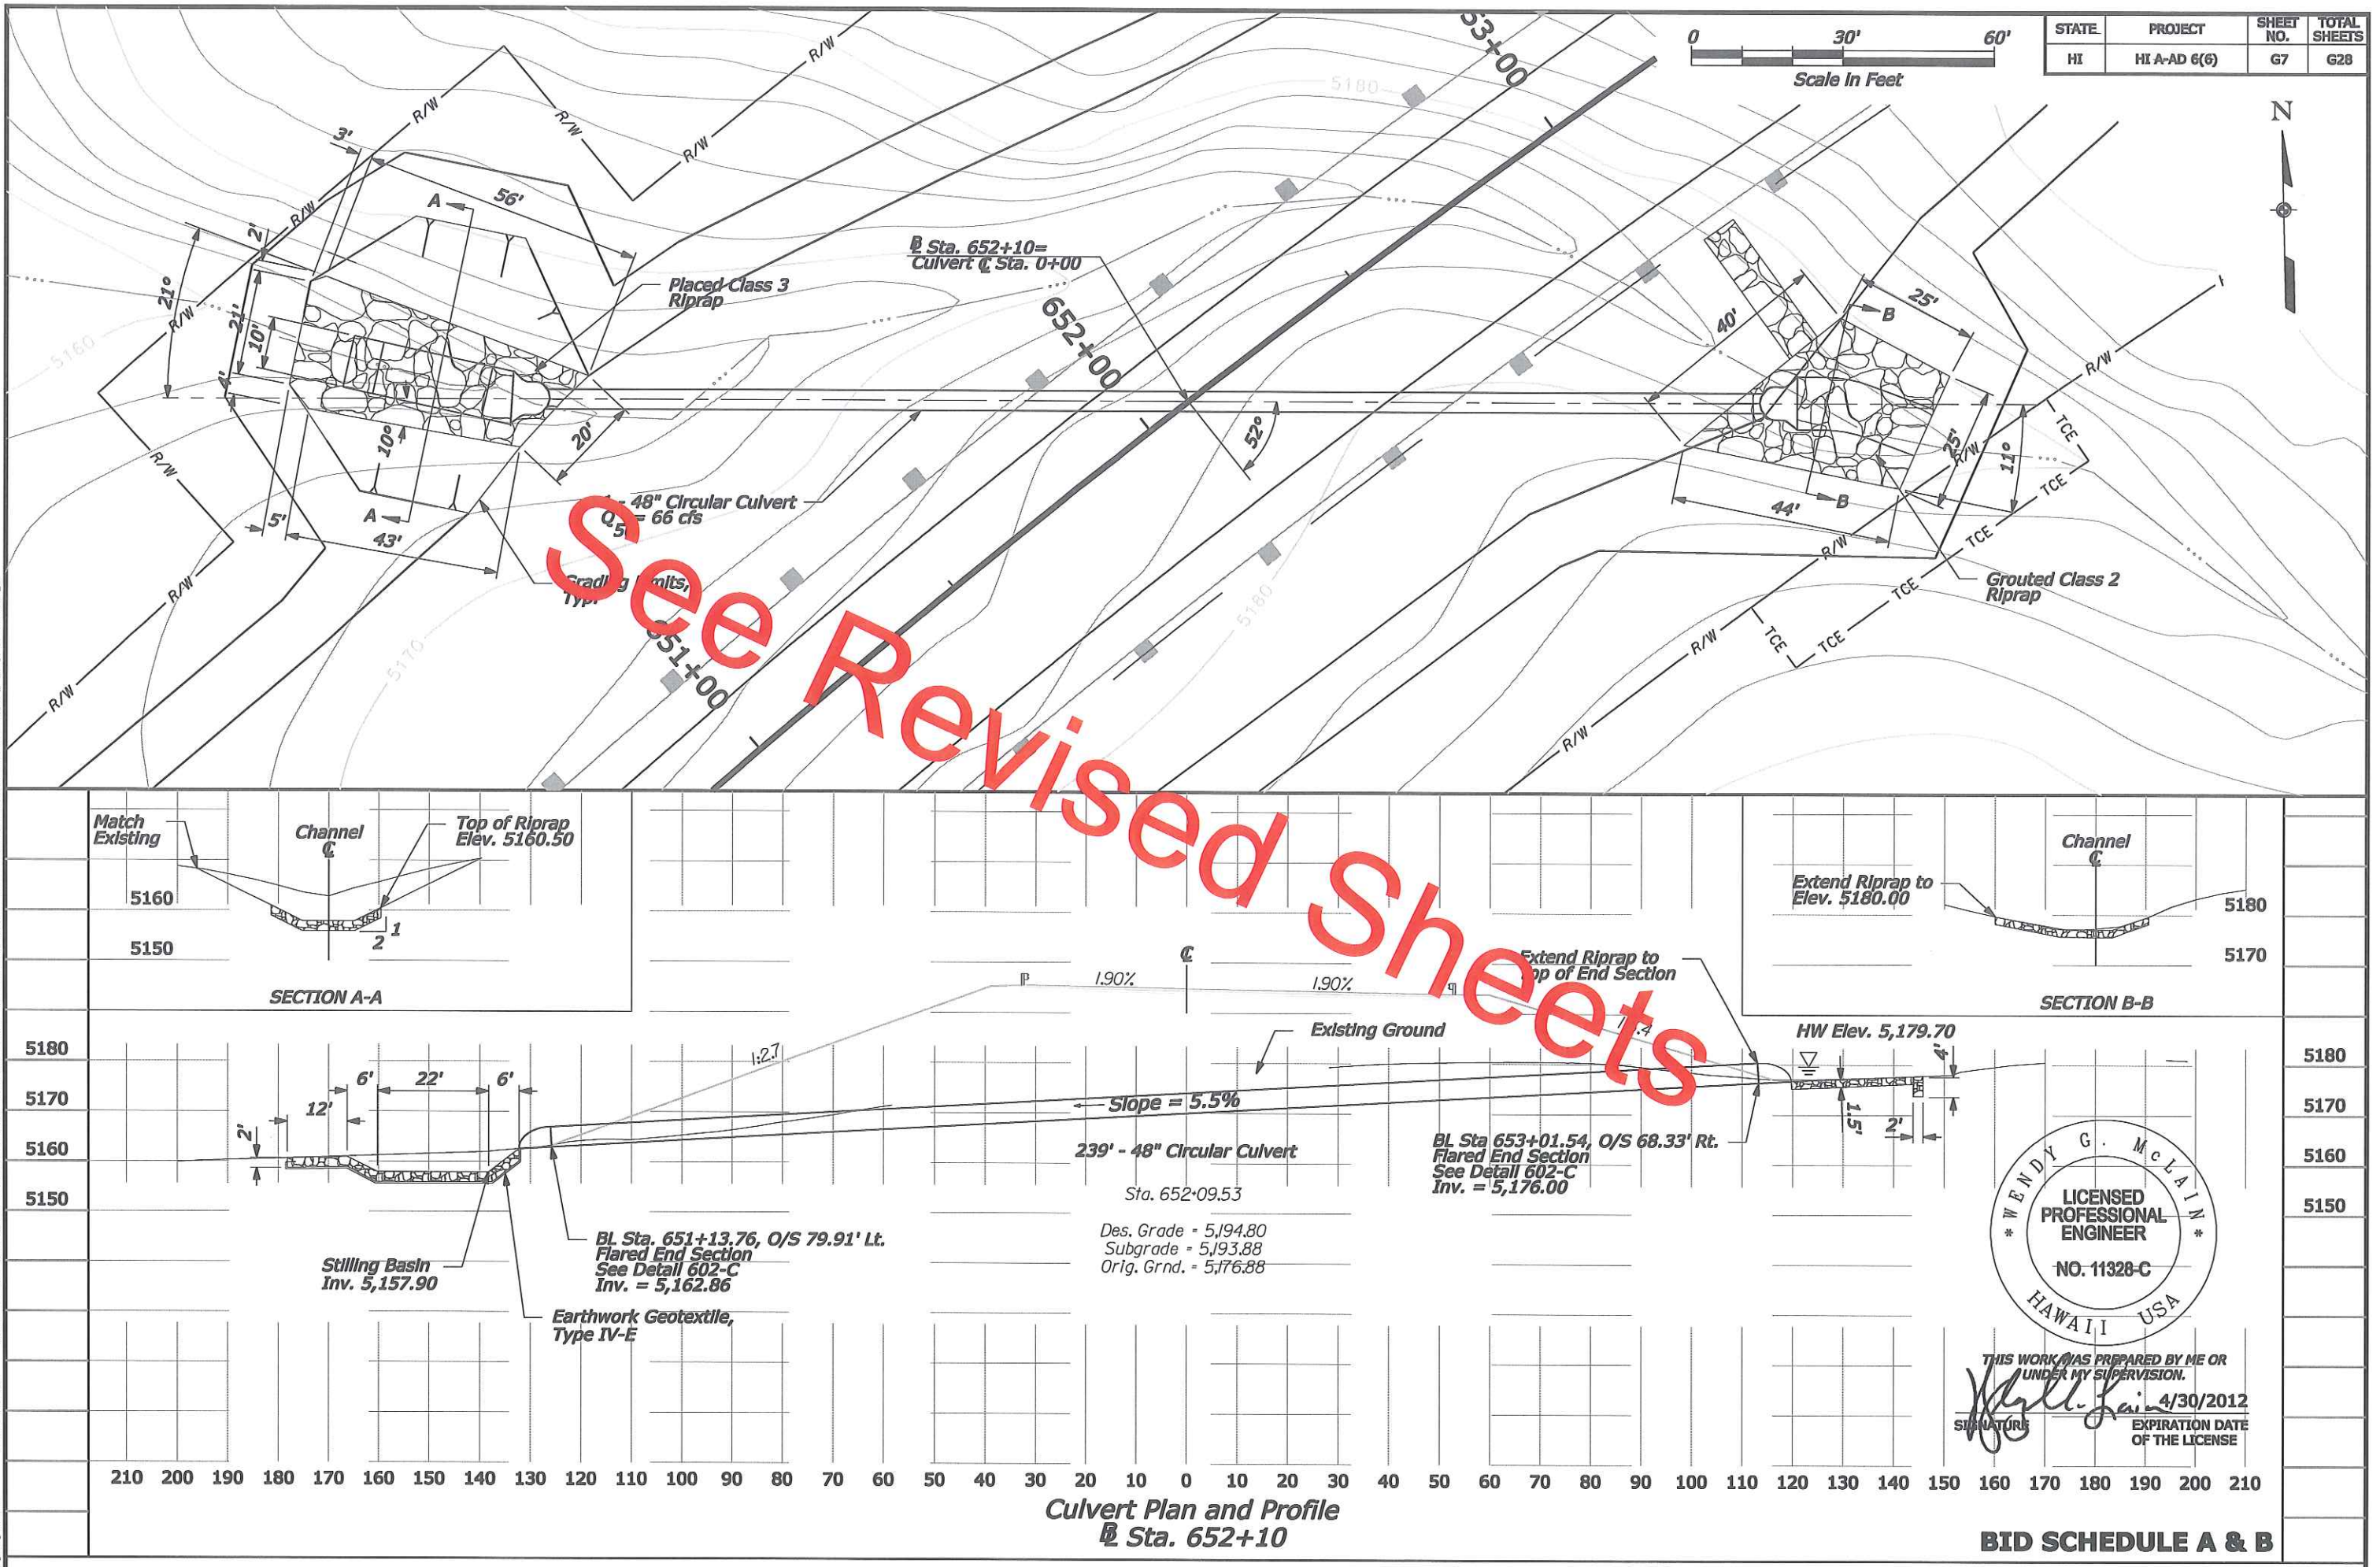


SADDLE ROAD - WEST SIDE

HI A-AD 6(6) CULVERT PLAN AND PROFILE STATION 652+10

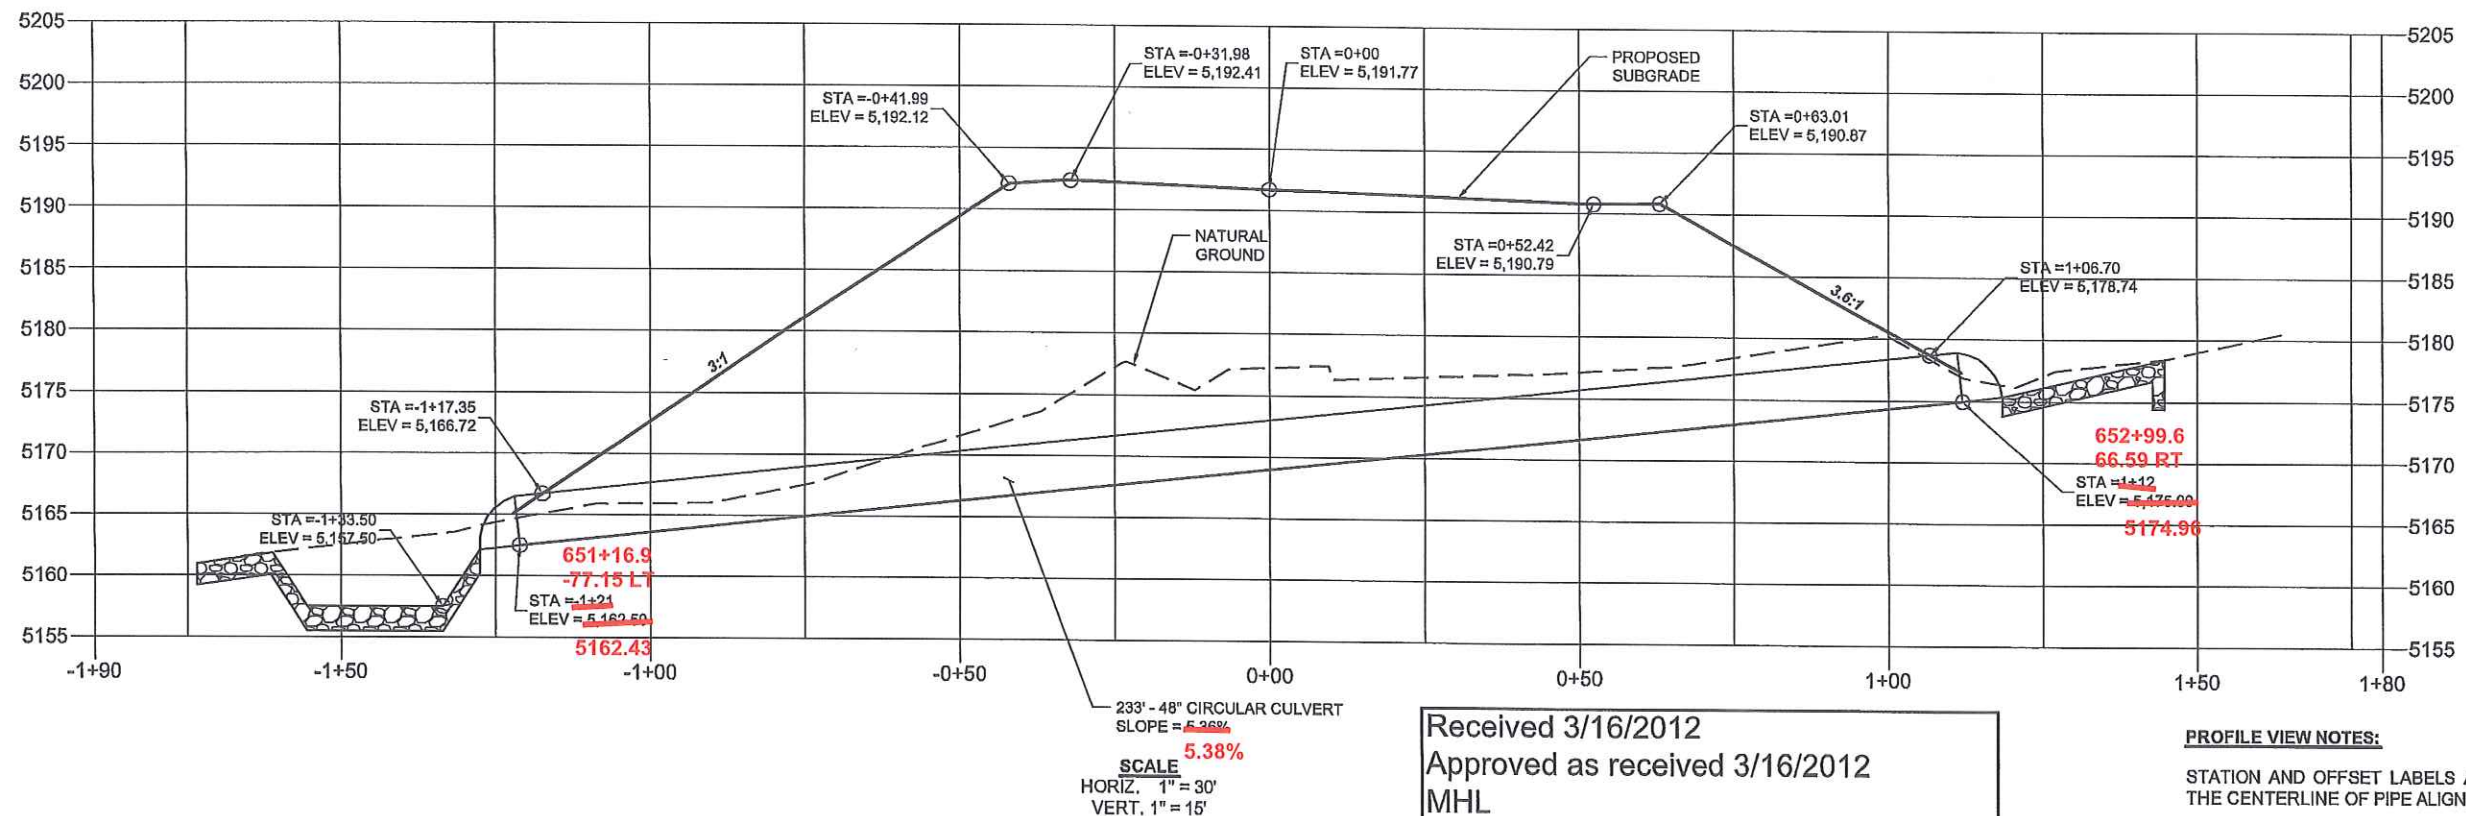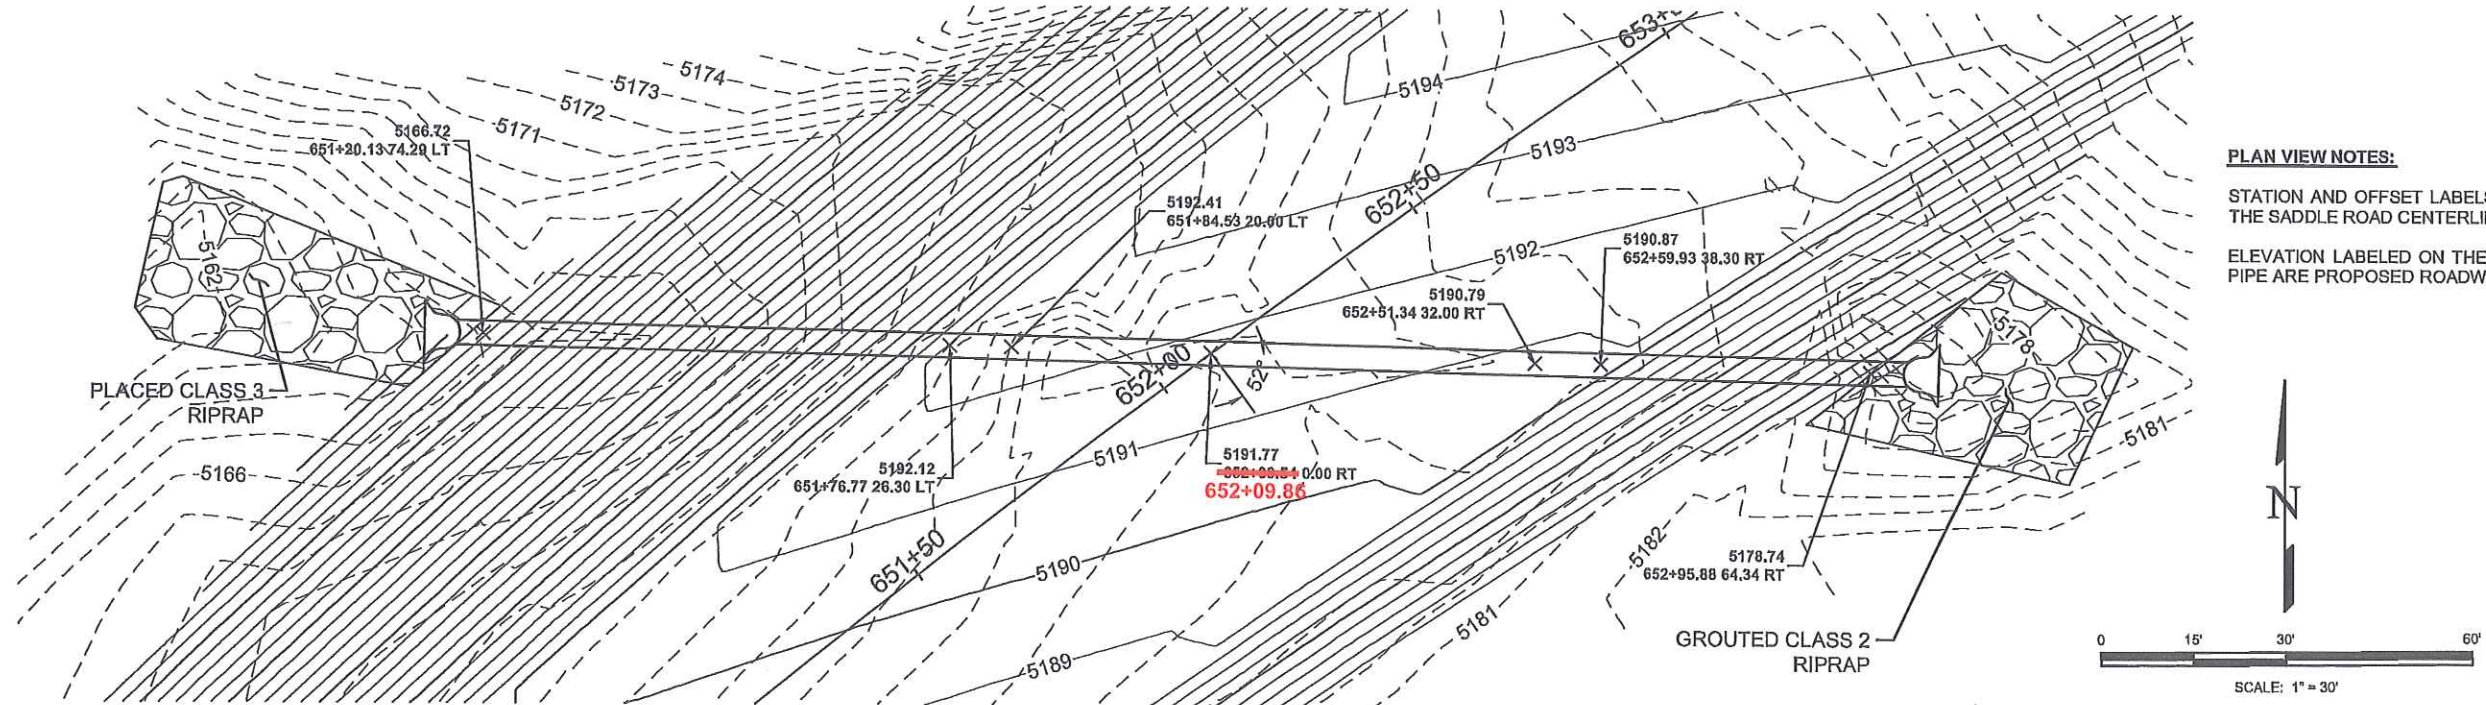

NO.	REVISIONS	DESCRIPTION	DATE

**EDWARD-JAMES
SURVEYING, INC.**
4732 Eagle Ridge Circle
Pueblo, CO 81008
Office: (719) 545-6240
Fax: (719) 545-6247

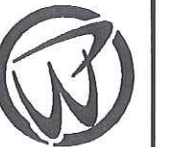

SADDLE ROAD - WEST SIDE
HI A-AD 6(6)
CULVERT PLAN AND PROFILE
STATION 652+10

DRAWN BY ERF
CHECKED BY ERF

H-SCALE 1" = 30'

JOB NO. 1017.00
DATE CREATED 03/07/12
DATE ISSUED 03/15/12
SHEET NO. 1 OF 1



PROFILE VIEW NOTES:

STATION AND OFFSET LABELS ARE BASED ON THE CENTERLINE OF PIPE ALIGNMENT.

PLAN REFERENCE: SHEET NO. G7

SADDLE ROAD - WEST SIDE

HI A-AD 6(6)
CULVERT PLAN AND PROFILE
STATION 673+24

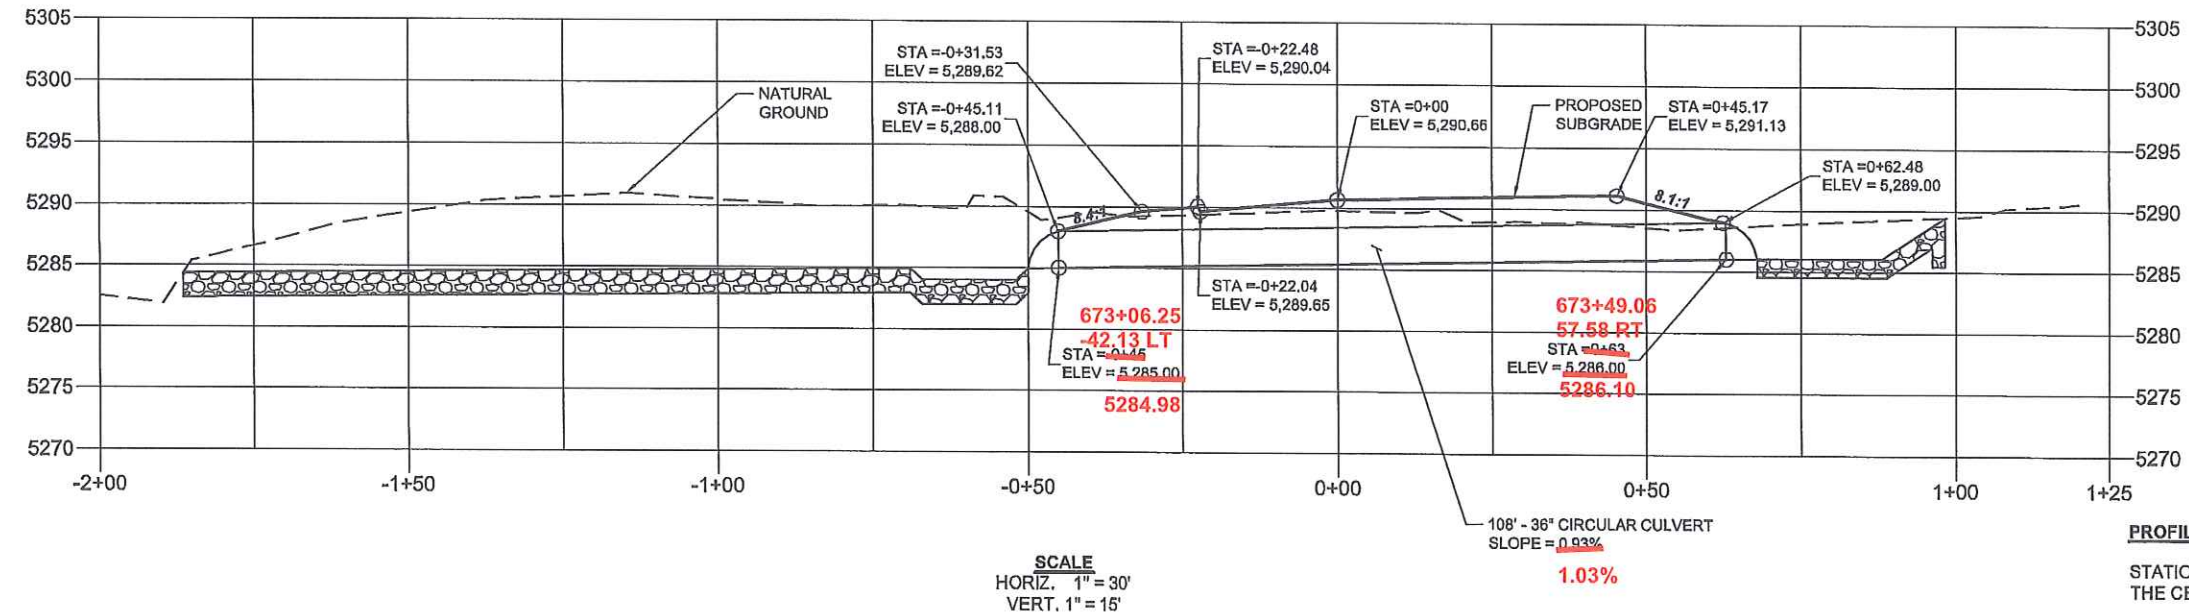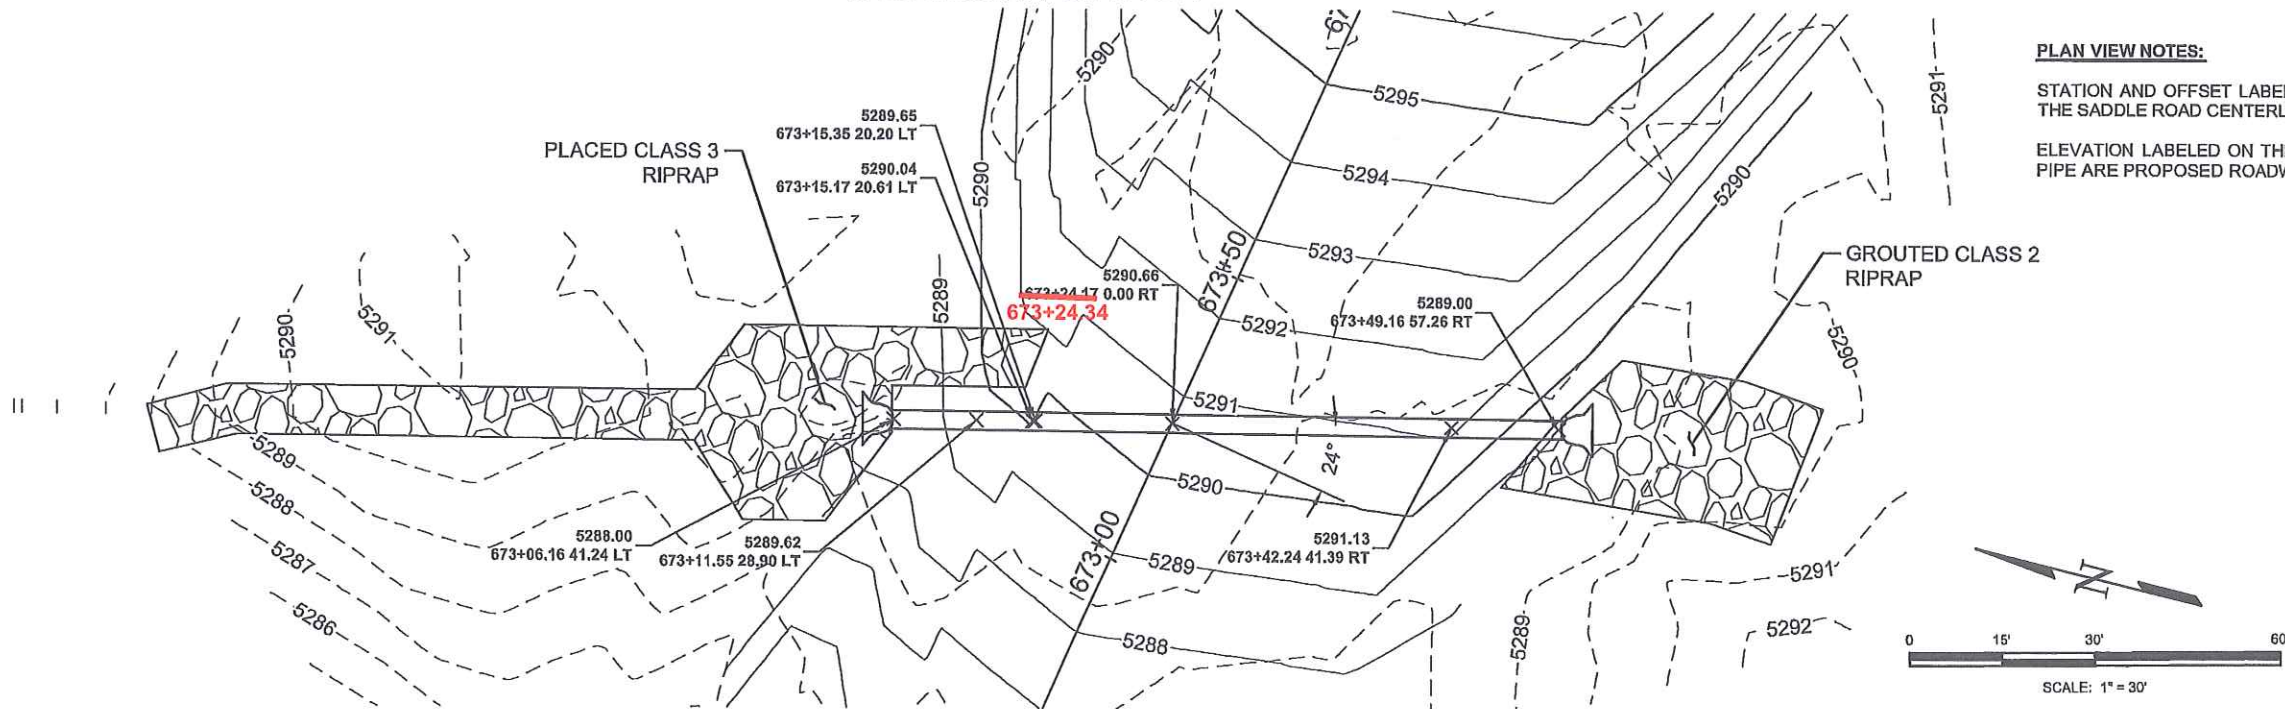

Received 3/16/2012
Approved as received
3/16/2012
MHL

REVISIONS	NO.	DESCRIPTION	DATE


EDWARD-JAMES
SURVEYING, INC.
2764 Jarrell Road
Colorado Springs, CO 80906
Office: (719) 576-1216
Fax: (719) 576-1206
4732 Eagle Ridge Circle
Pueblo, CO 81008
Office: (719) 545-6240
Fax: (719) 545-6247






SADDLE ROAD - WEST SIDE
HI A-AD 6(6)
CULVERT PLAN AND PROFILE
STATION 673+24

DRAWN BY	ERF
CHECKED BY	ERF
H-SCALE	1" = 30'
JOB NO.	1017.00
DATE CREATED	03/07/12
DATE ISSUED	03/16/12
SHEET NO.	1 OF 1


m:\2006\2006_069_004 affhd saddle road_west side\g drawings\contract documents\civil\HI SR 200(00).pnp_cul_09.dgn 5/19/2011 2:42:22 PM

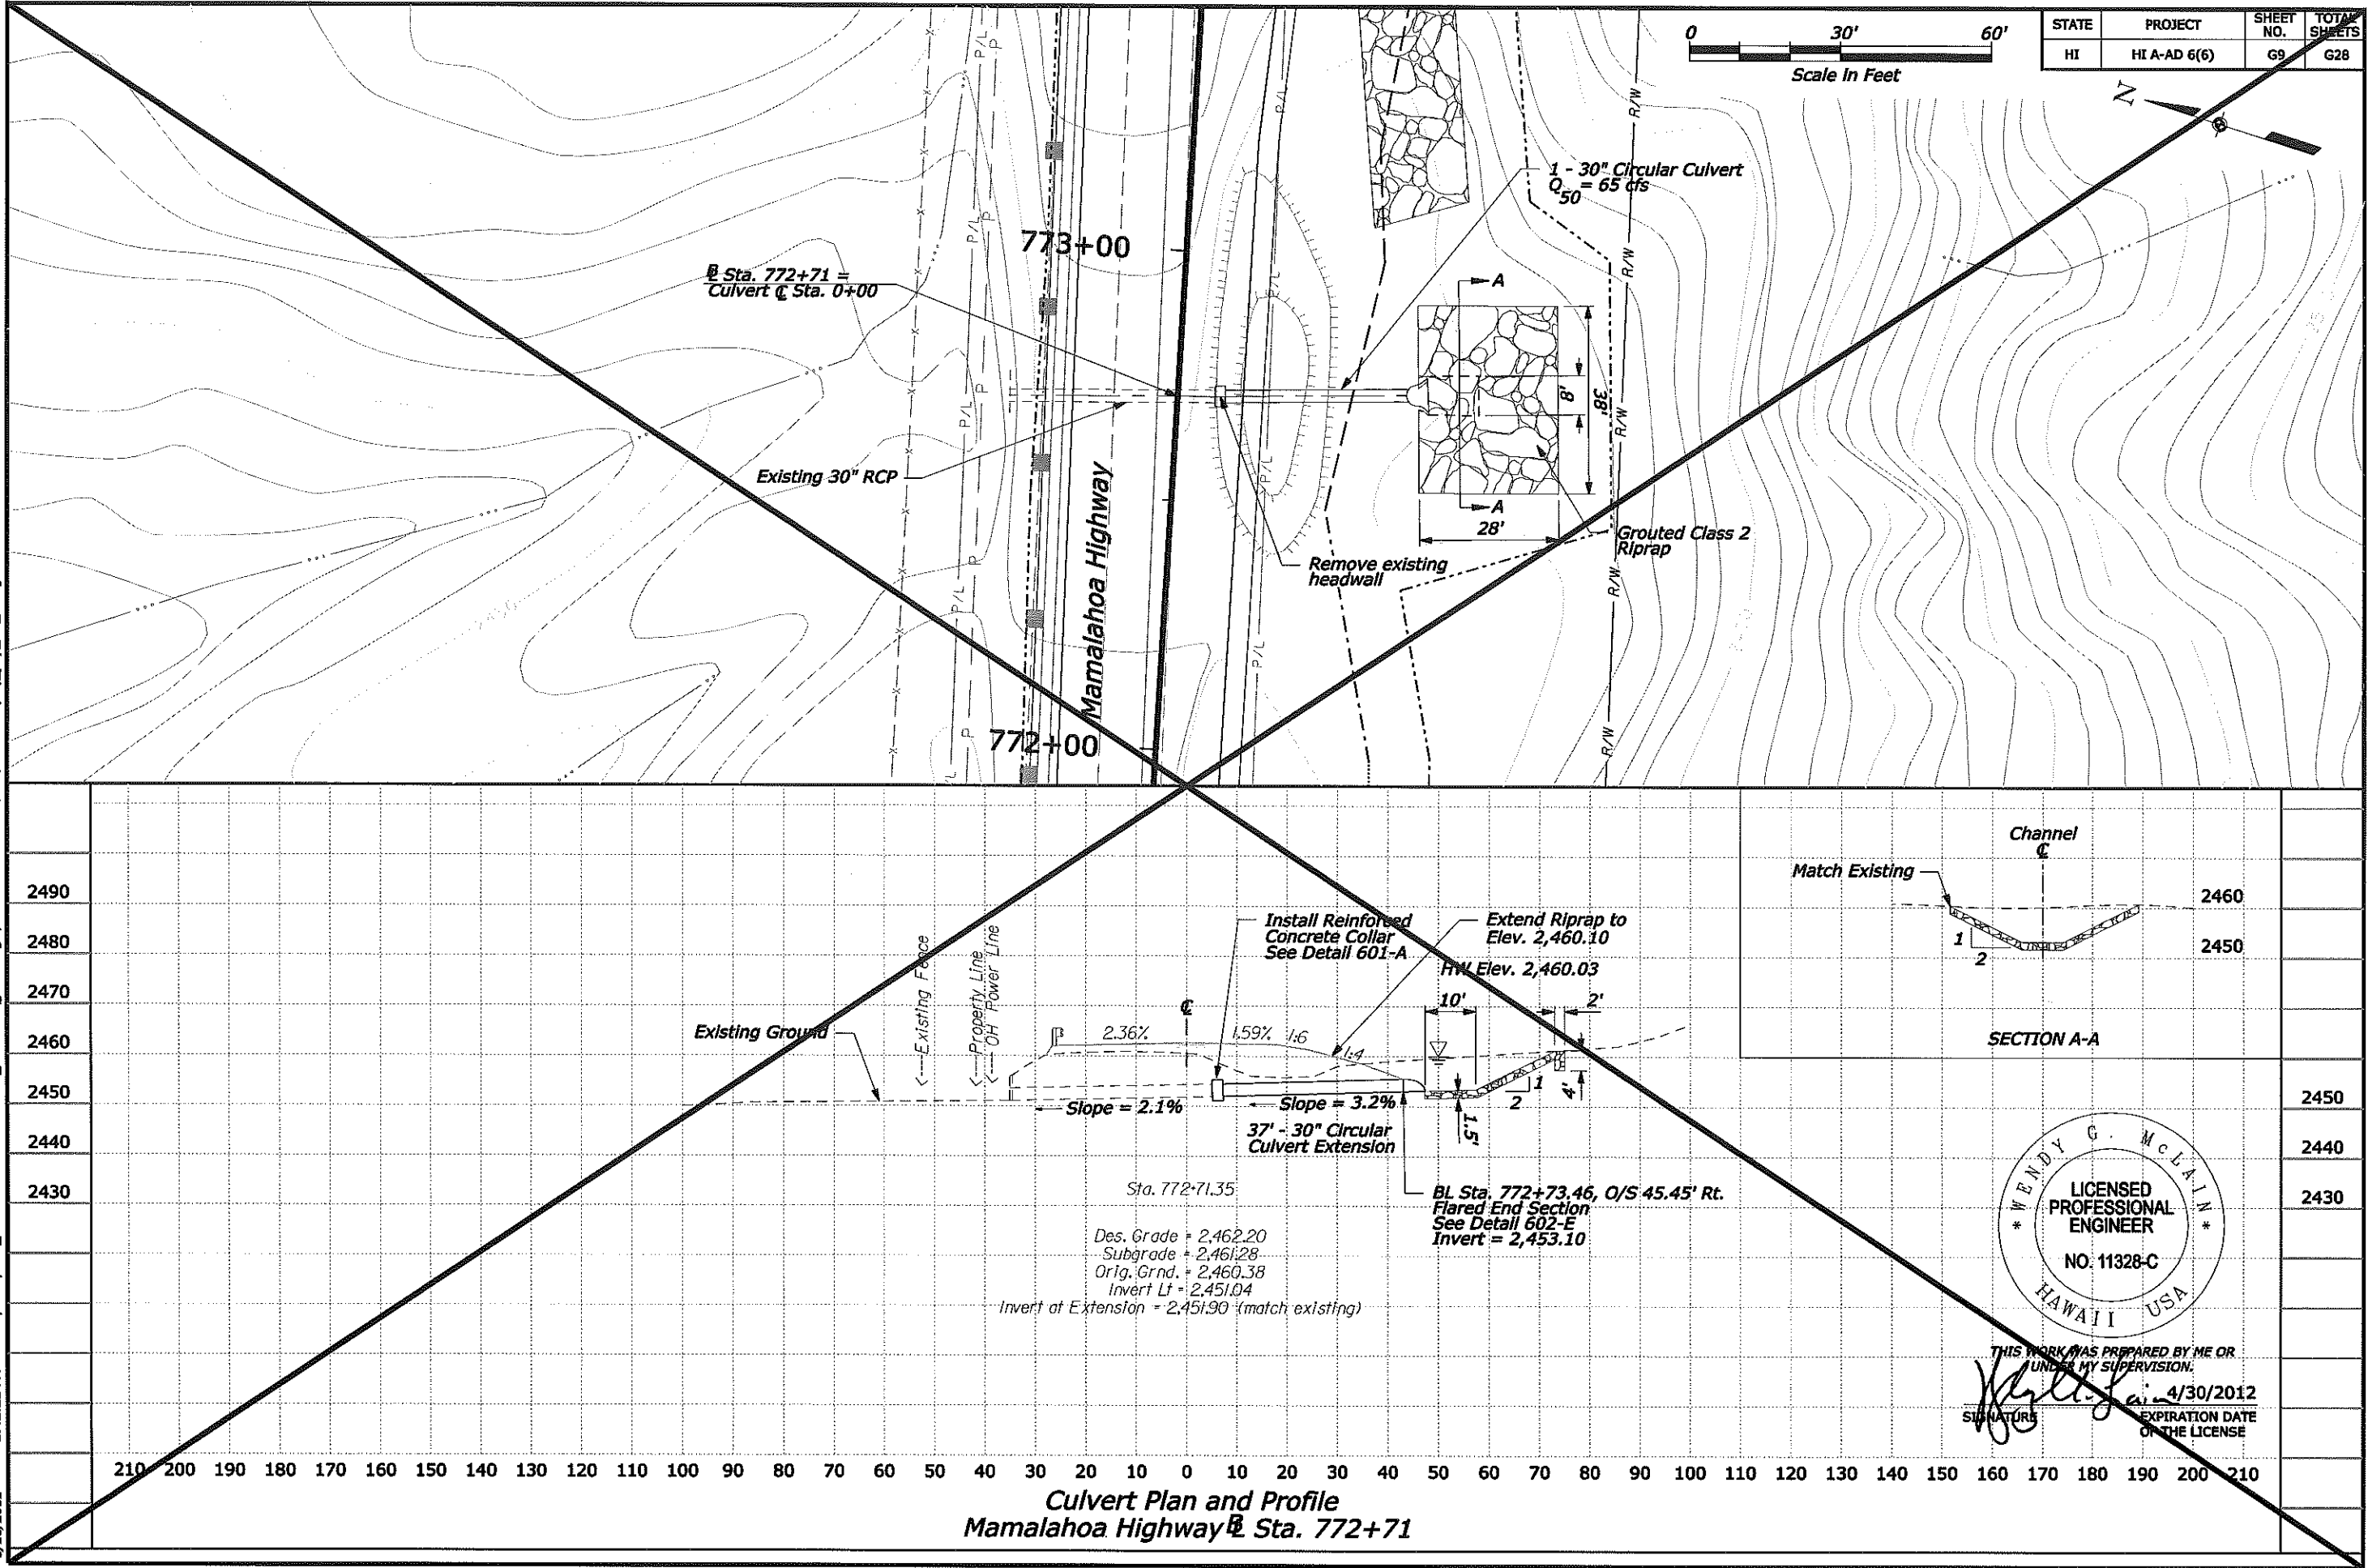

5/18/2011 2:42:28 PM m:\2006\2006_069.004 cflnd saddle road_west side\g drawings\contract documents\cflnd\sr 200(00)_pnp_cul_10.dgn

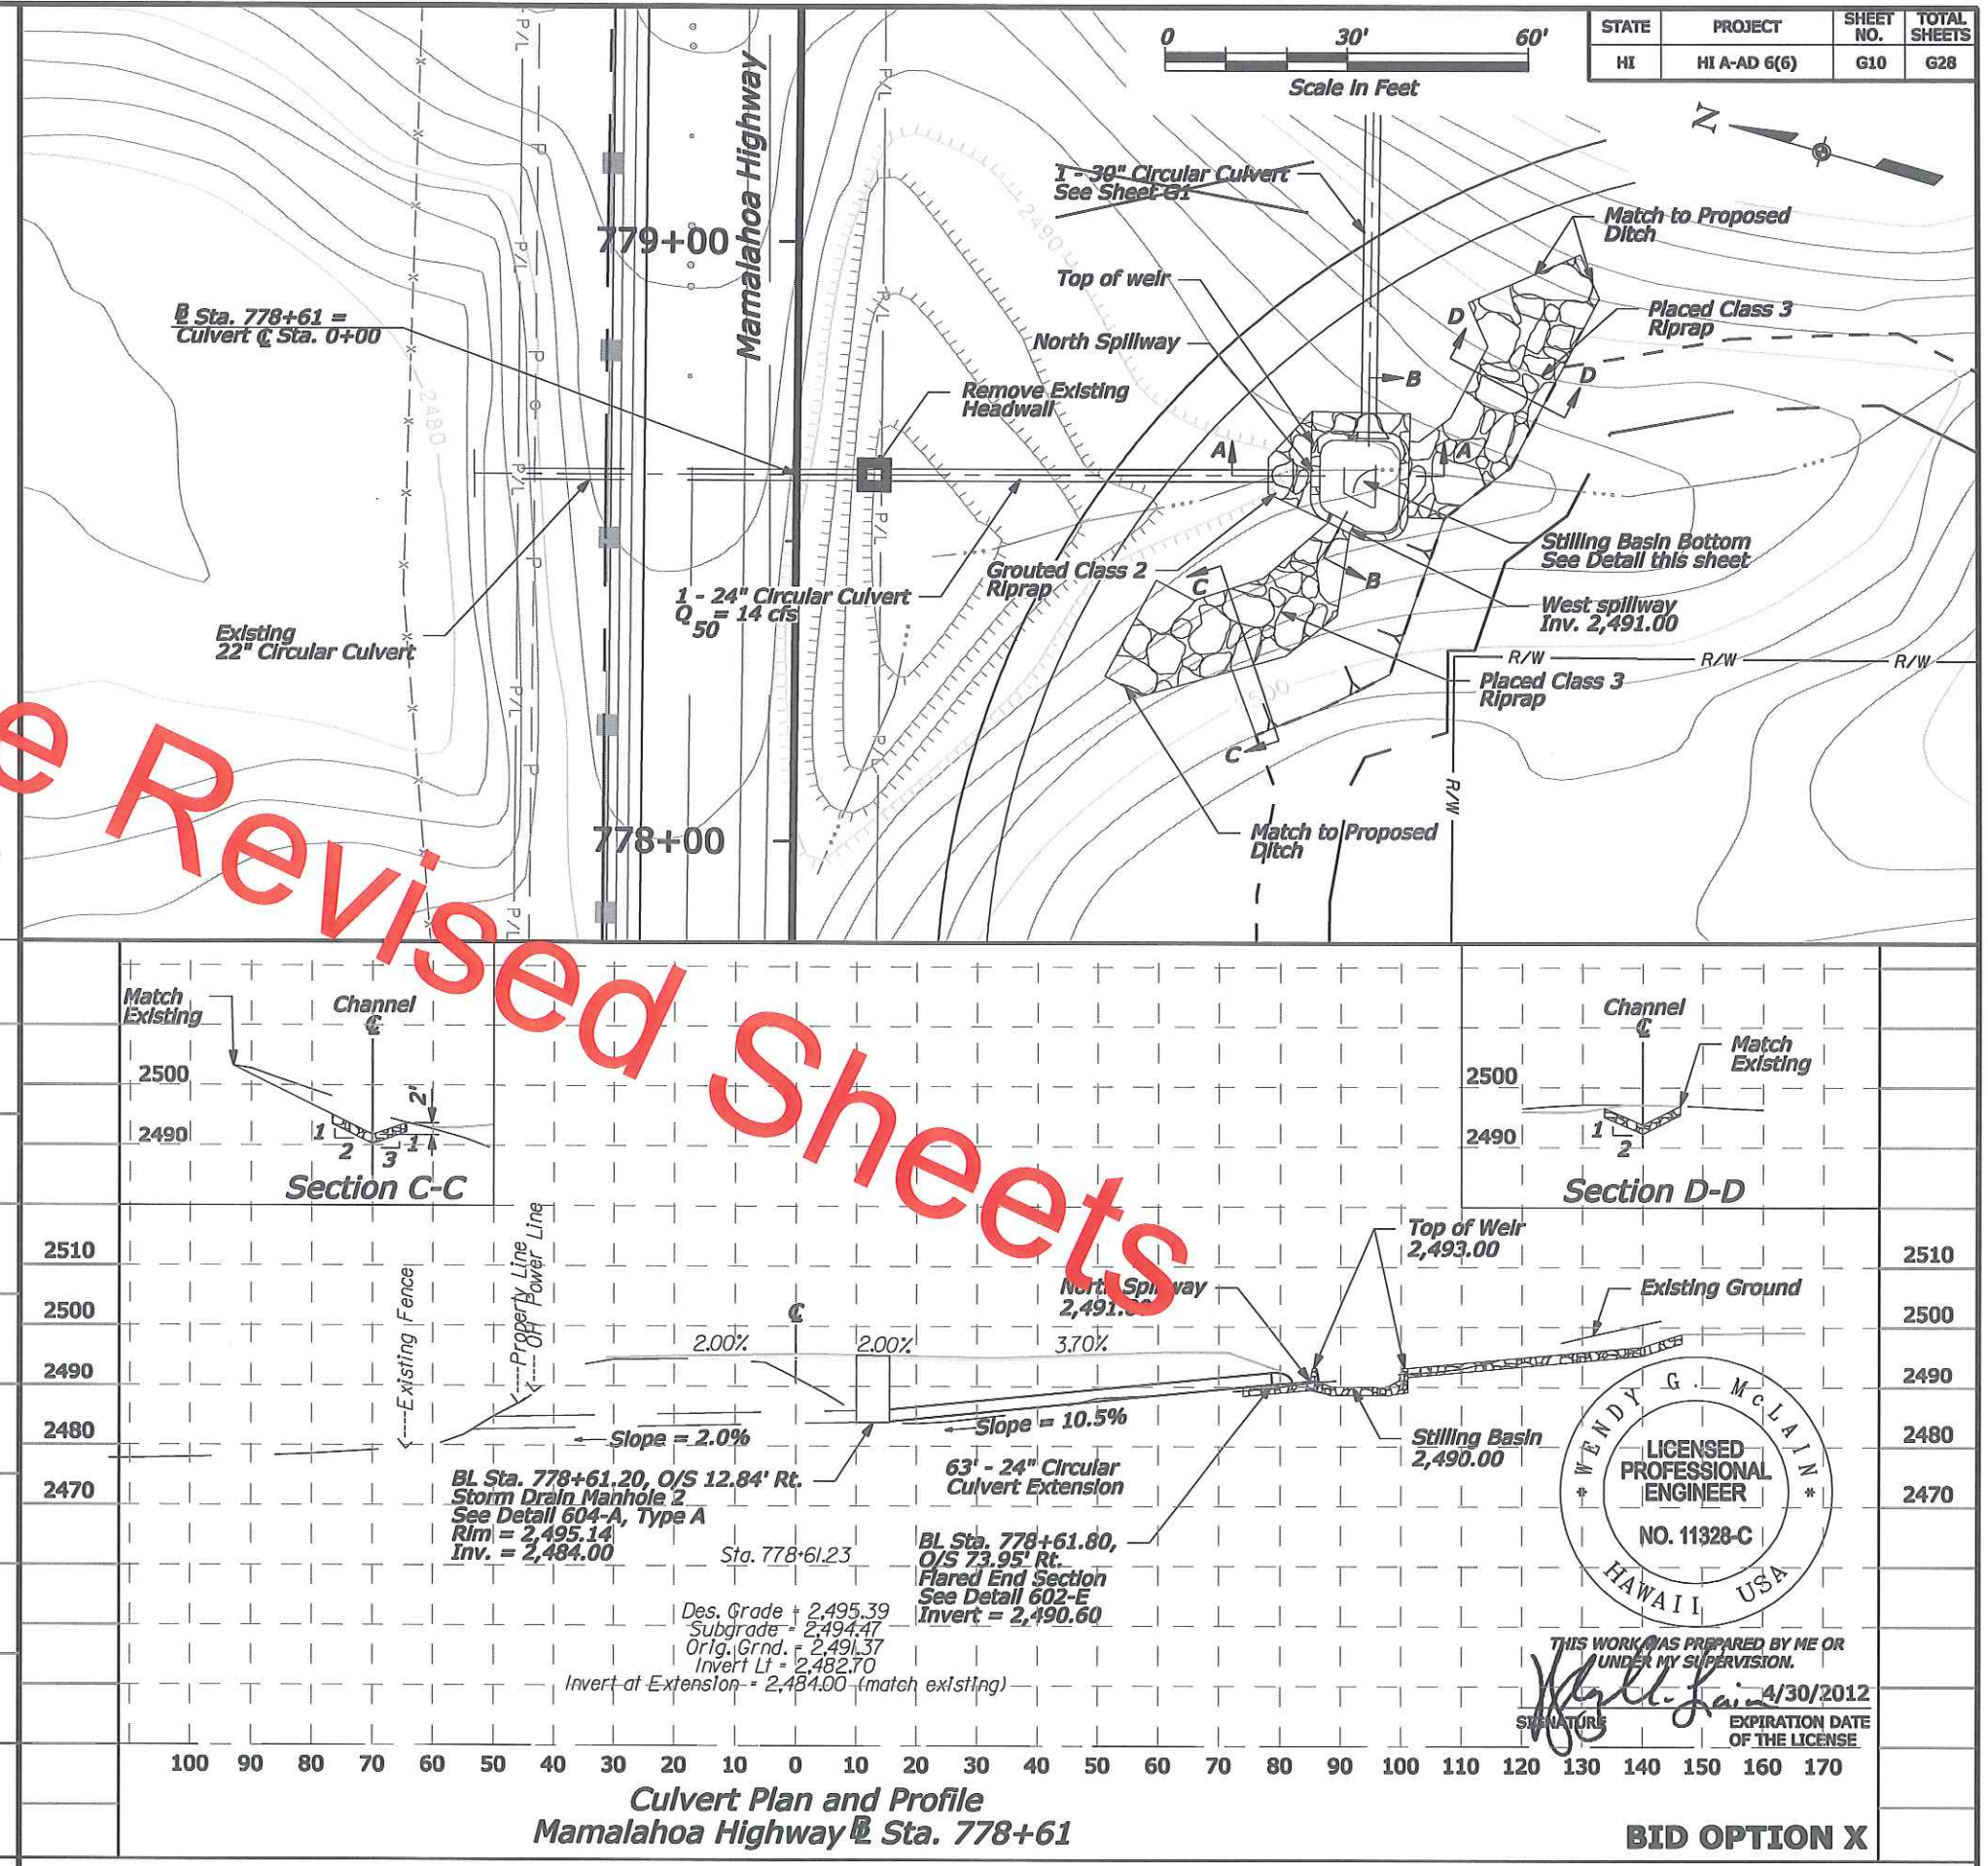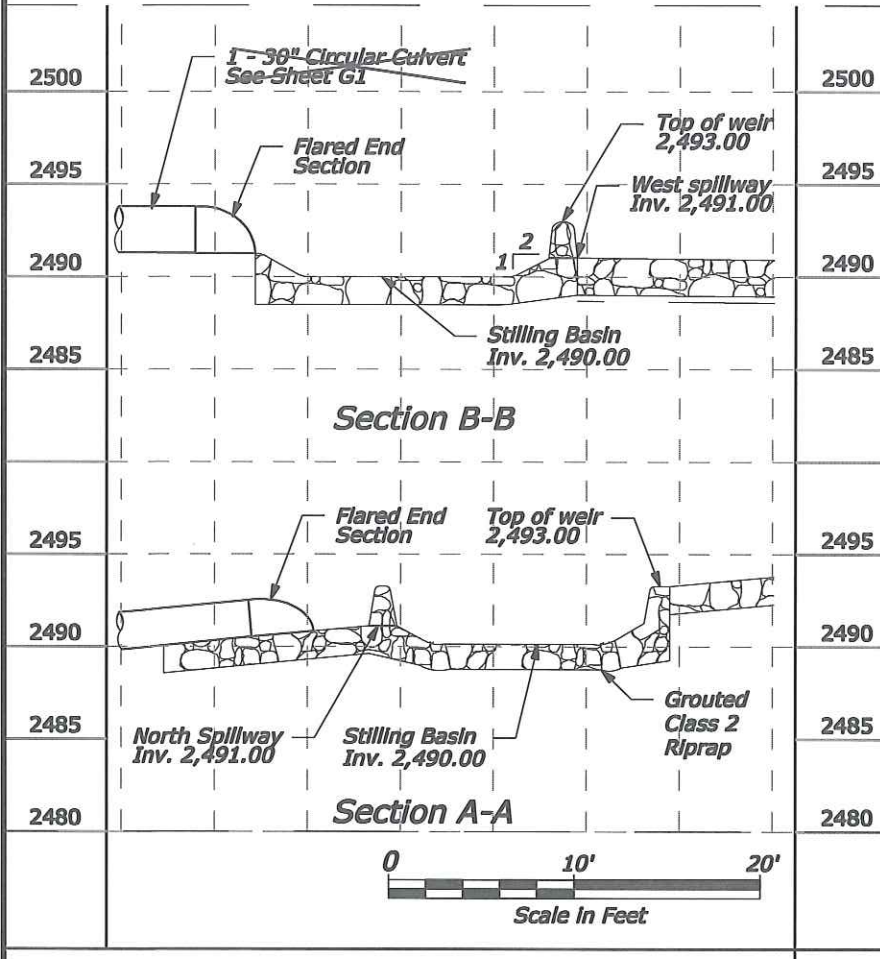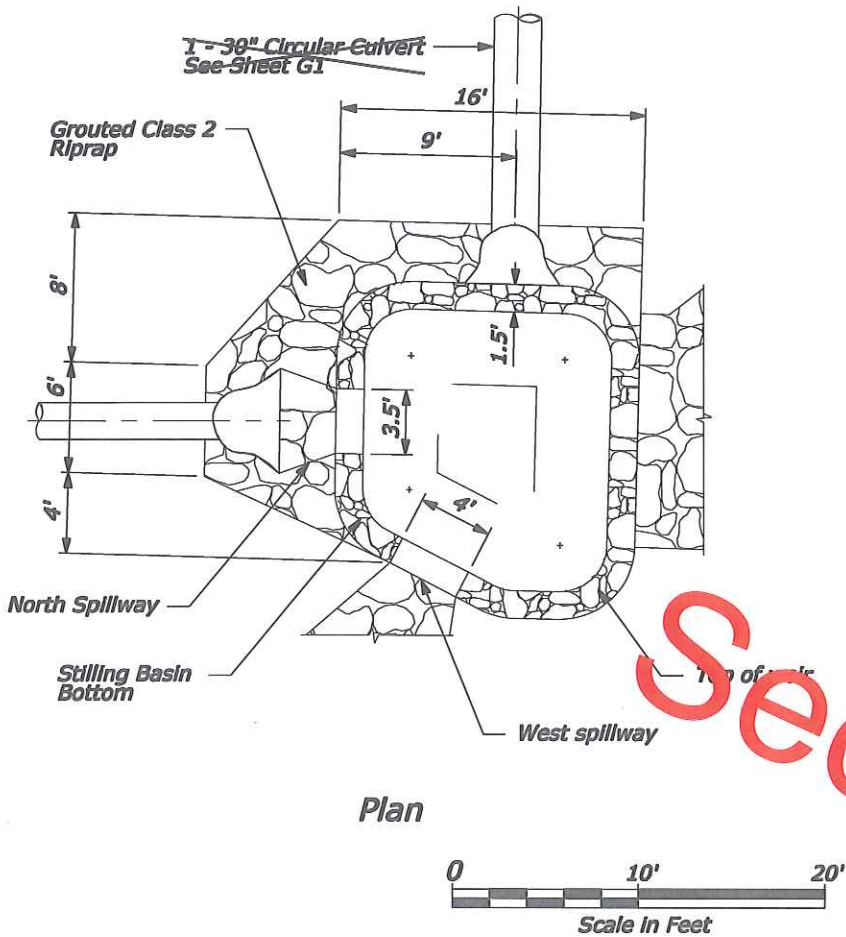



SADDLE ROAD - WEST SIDE
HI A-AD 6(6)
CULVERT PLAN AND PROFILE
STATION 778+61

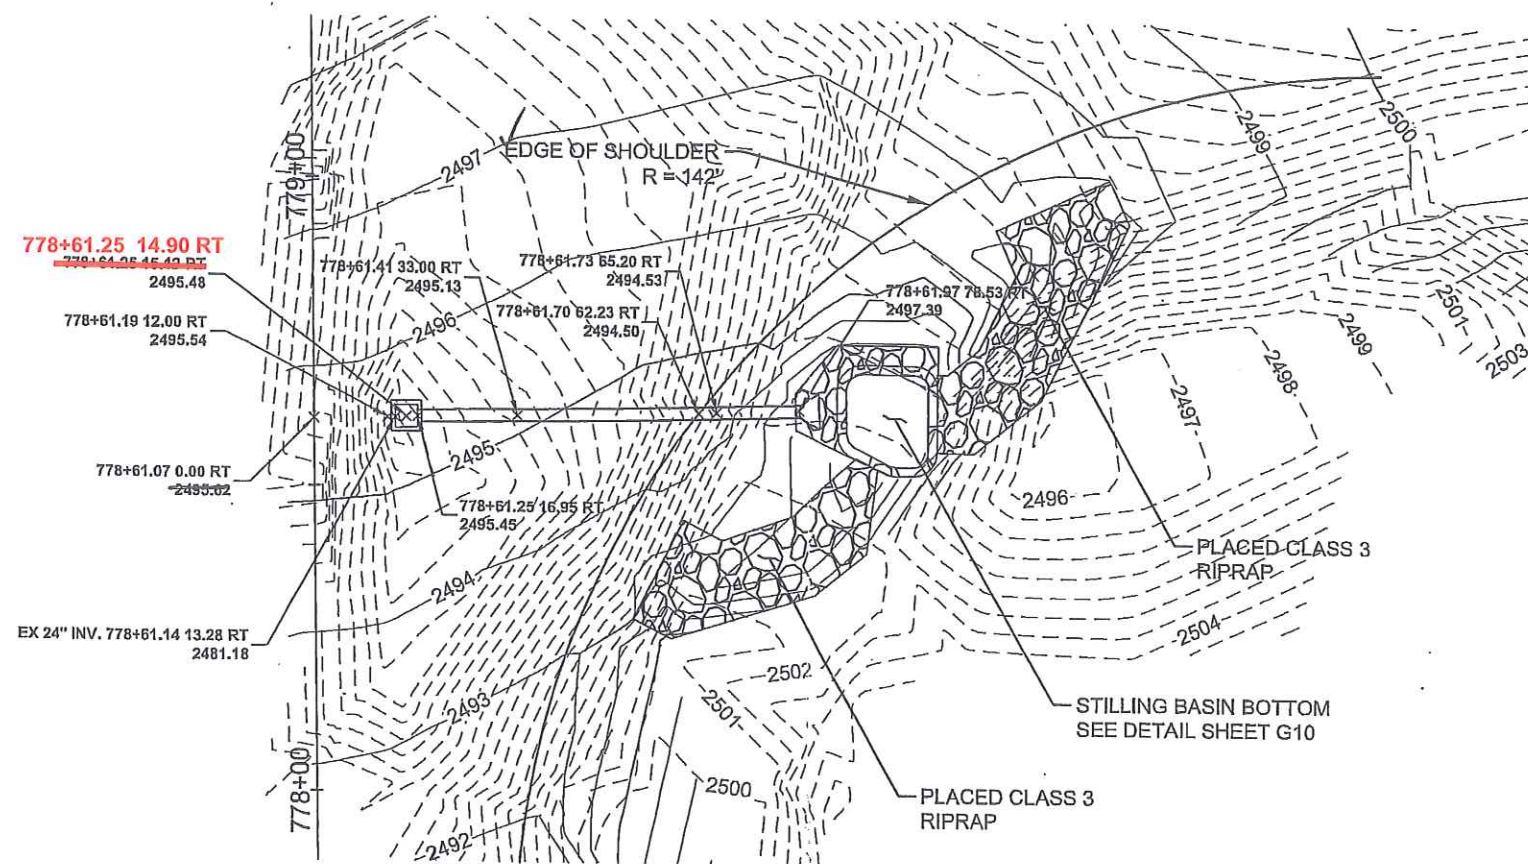

PLAN VIEW NOTES:

STATION AND OFFSET LABELS ARE BASED ON
THE MAMALAHOA HIGHWAY ALIGNMENT.

ELEVATION LABELED ON THE CENTERLINE OF
PIPE ARE PROPOSED ROADWAY SUBGRADE.

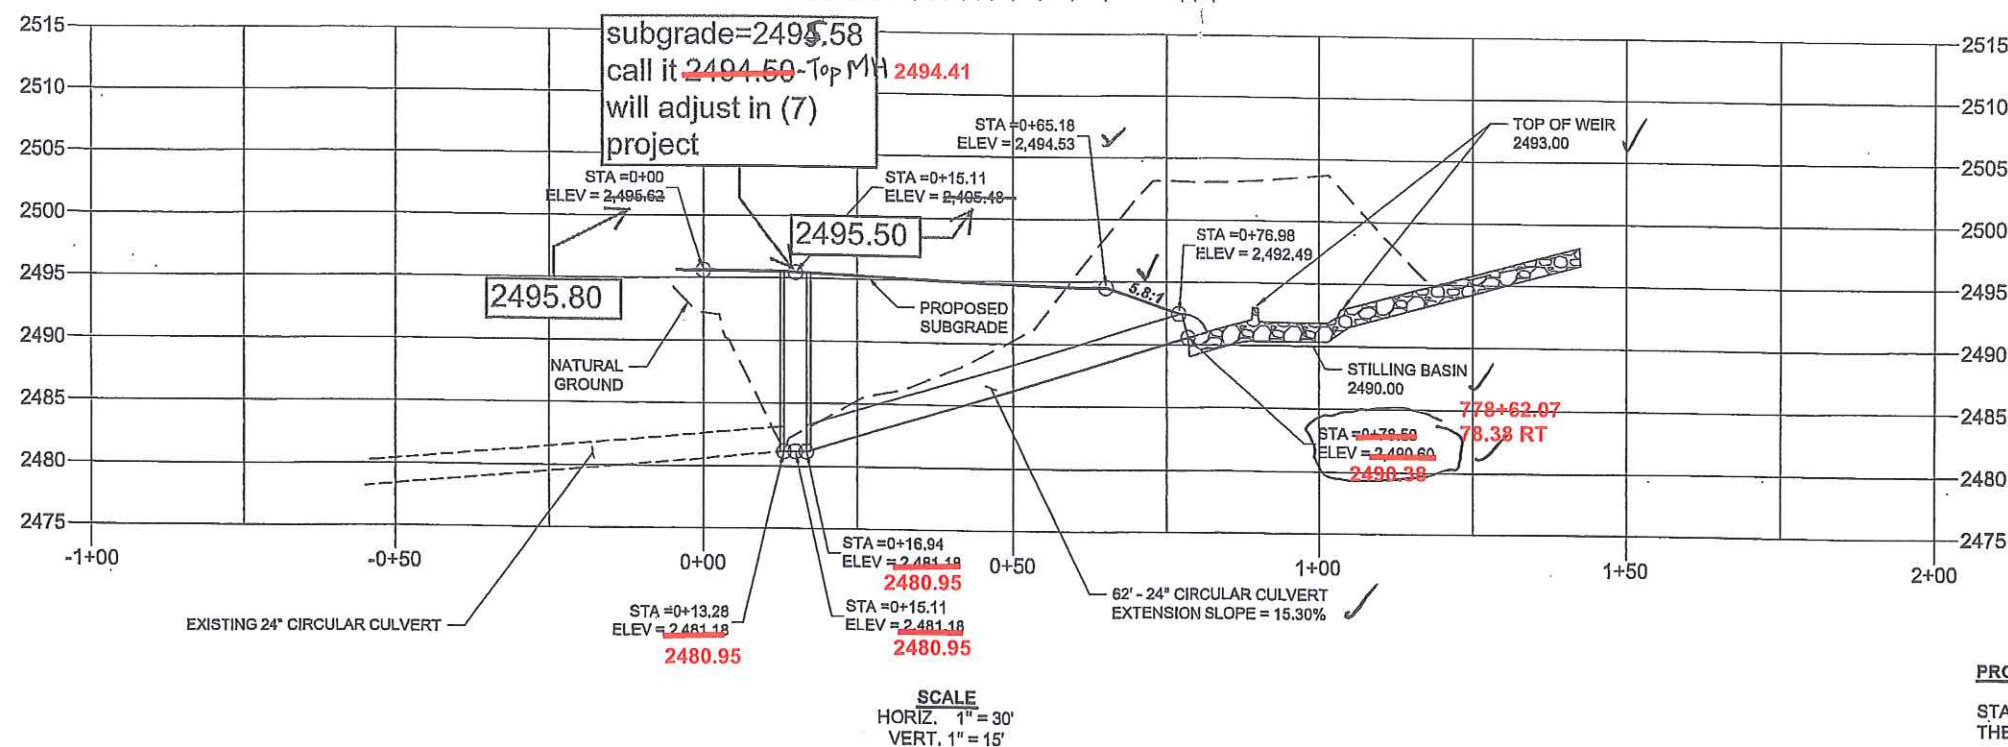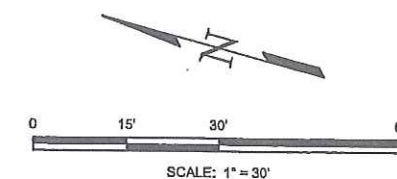

received
03/03/12 mm

"Approved as noted"

PROFILE VIEW NOTES:

STATION AND OFFSET LABELS ARE BASED ON
THE CENTERLINE OF PIPE ALIGNMENT.

PLAN REFERENCE: SHEET NO. G10

[illegible]

**EDWARD-JAMES
SURVEYING, INC.**

2764 Jamitell Road
Colorado Springs, CO 80906
Office: (719) 576-4216
Fax: (719) 576-1206

4732 Eagleridge Circle
Pueblo, CO 81008
Office: (719) 545-6240
Fax: (719) 545-6247



SADDLE ROAD - WEST SIDE

ROAD - WEST
HT A-AD 666

CULVERT PLAN AND PROFILE


DRAWN BY	ERF
CHECKED BY	ERF

H-SCALE 1" = 30'

JOB NO. 1017.00

DATE ISSUED	03/13/12
-------------	----------

5/19/2011 2:42:33 PM m:\2006\2006_069.004 cfm saddle road_west side\drawings\contract documents\civil\HI SR 200(00)_pnp_cul_11.dgn

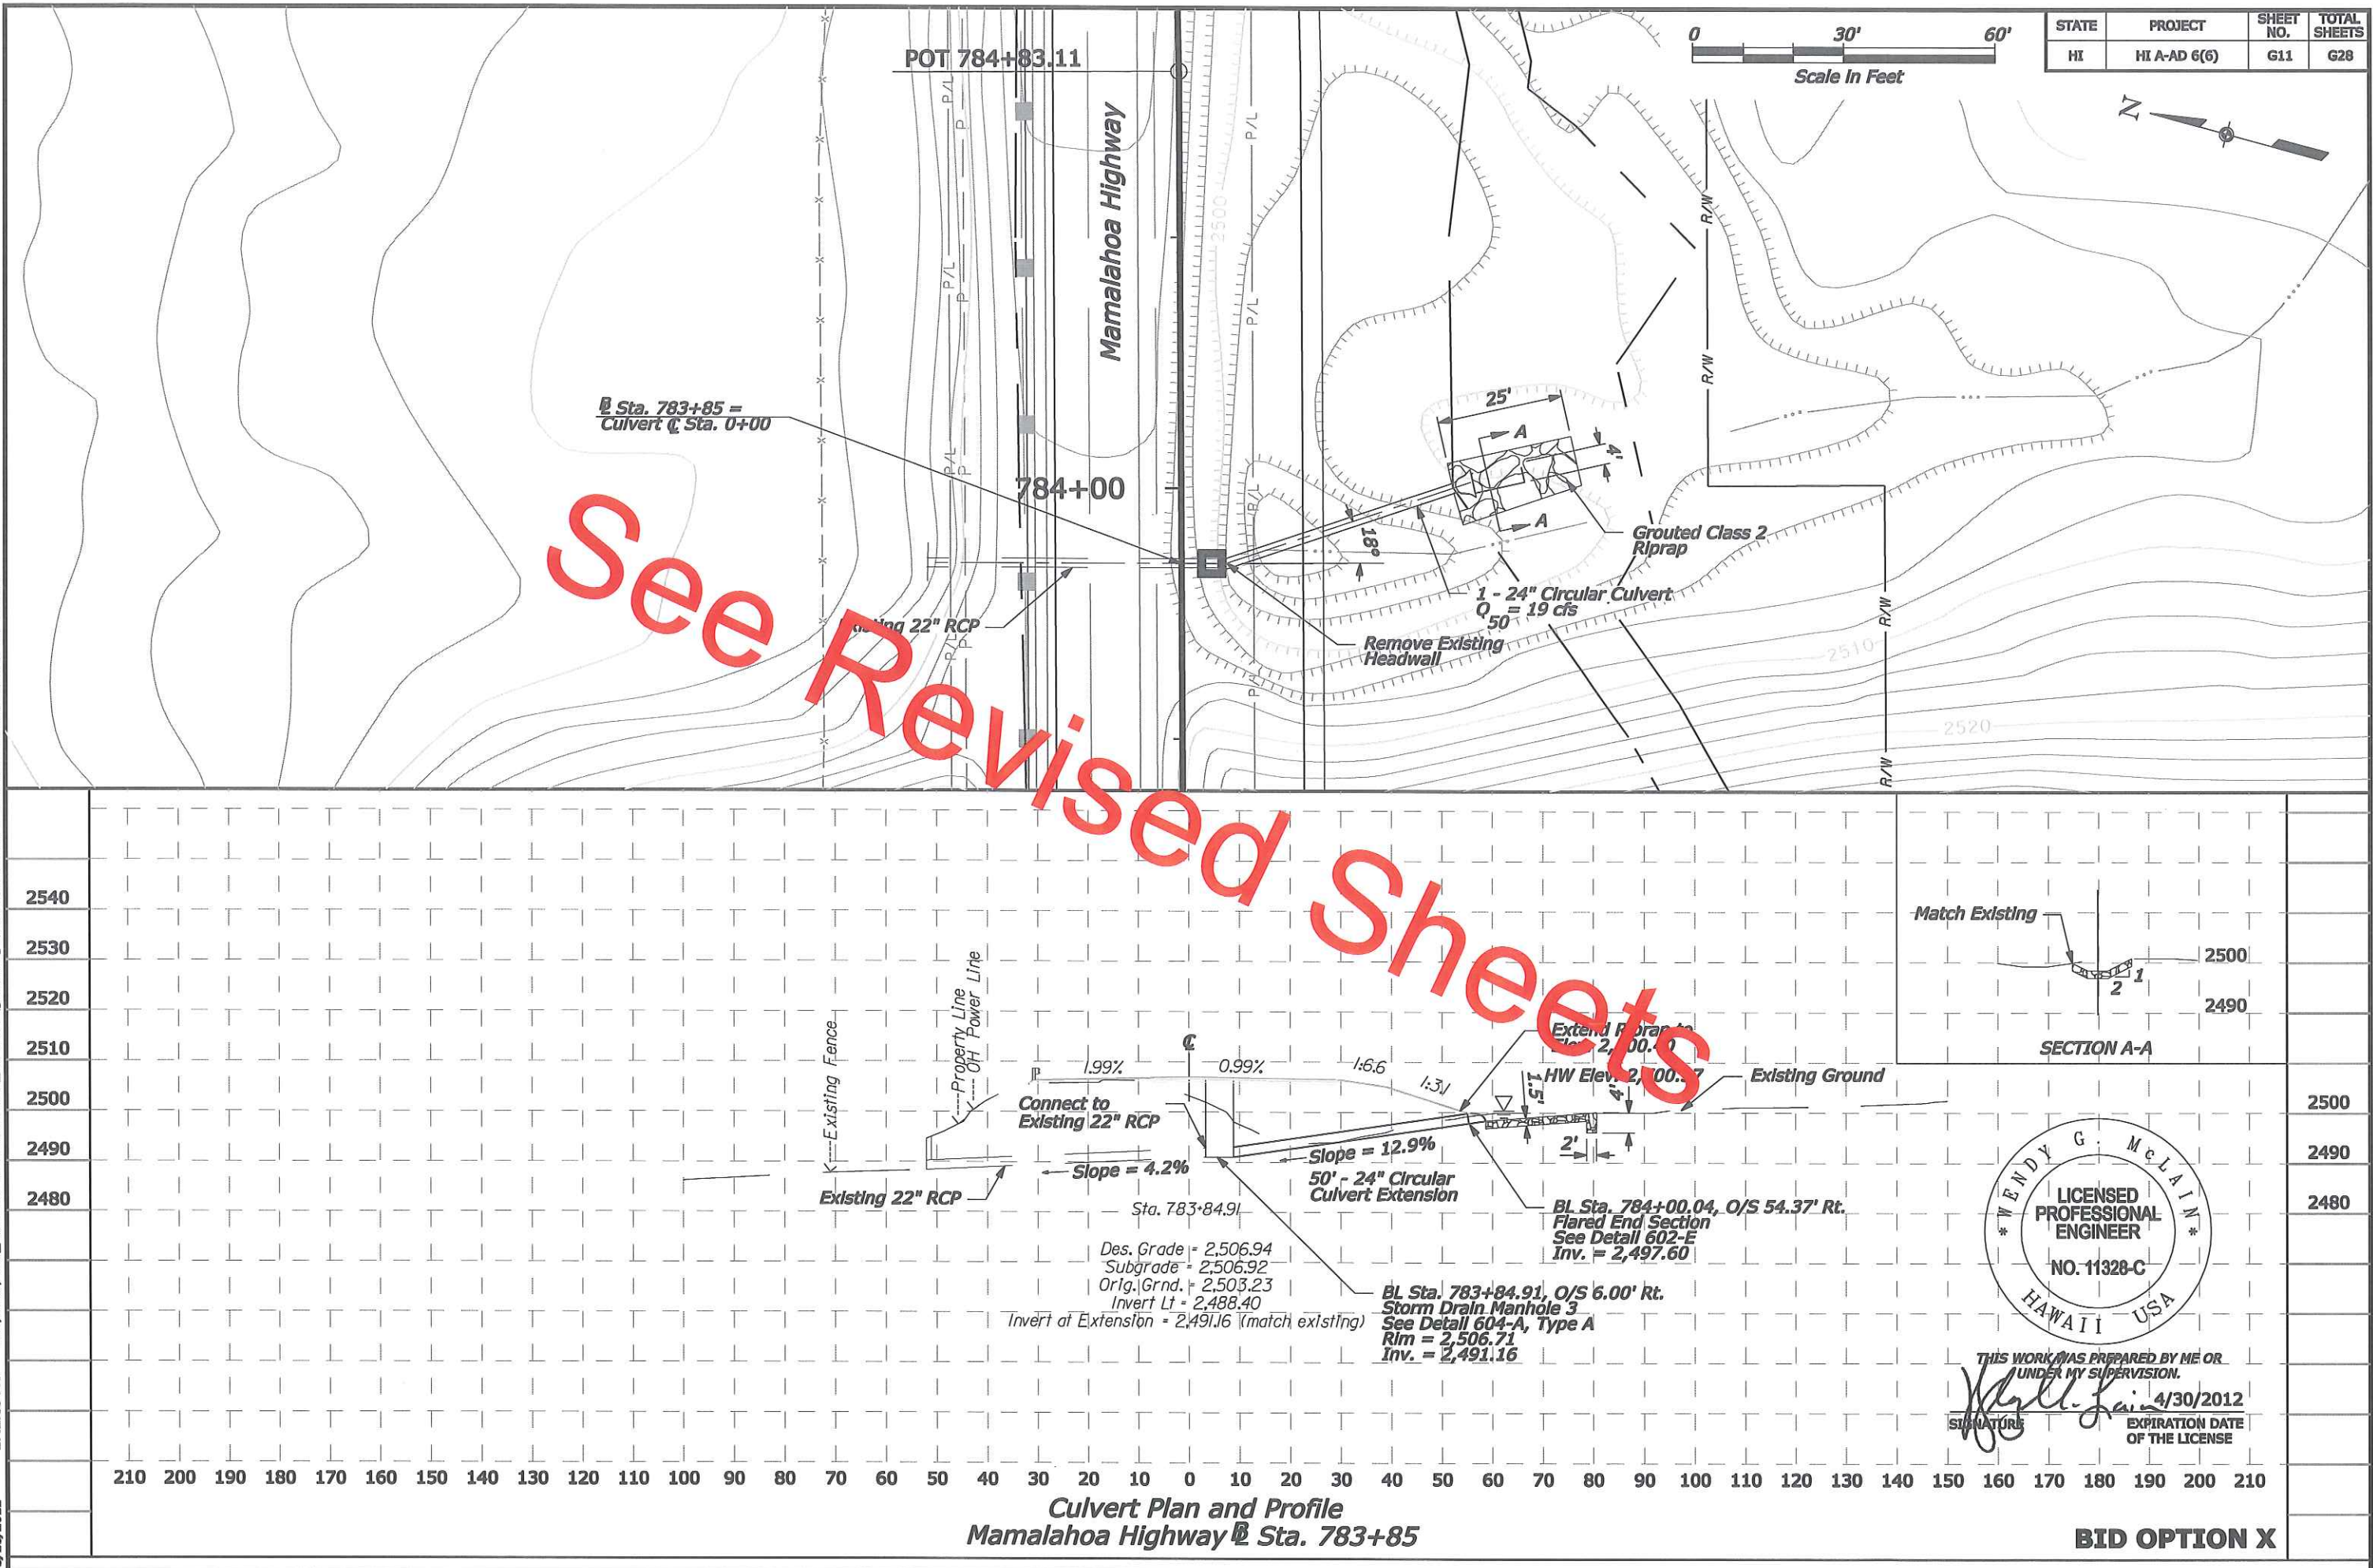


SADDLE ROAD - WEST SIDE

HI A-AD 6(6)

CULVERT PLAN AND PROFILE


STATION 783+85

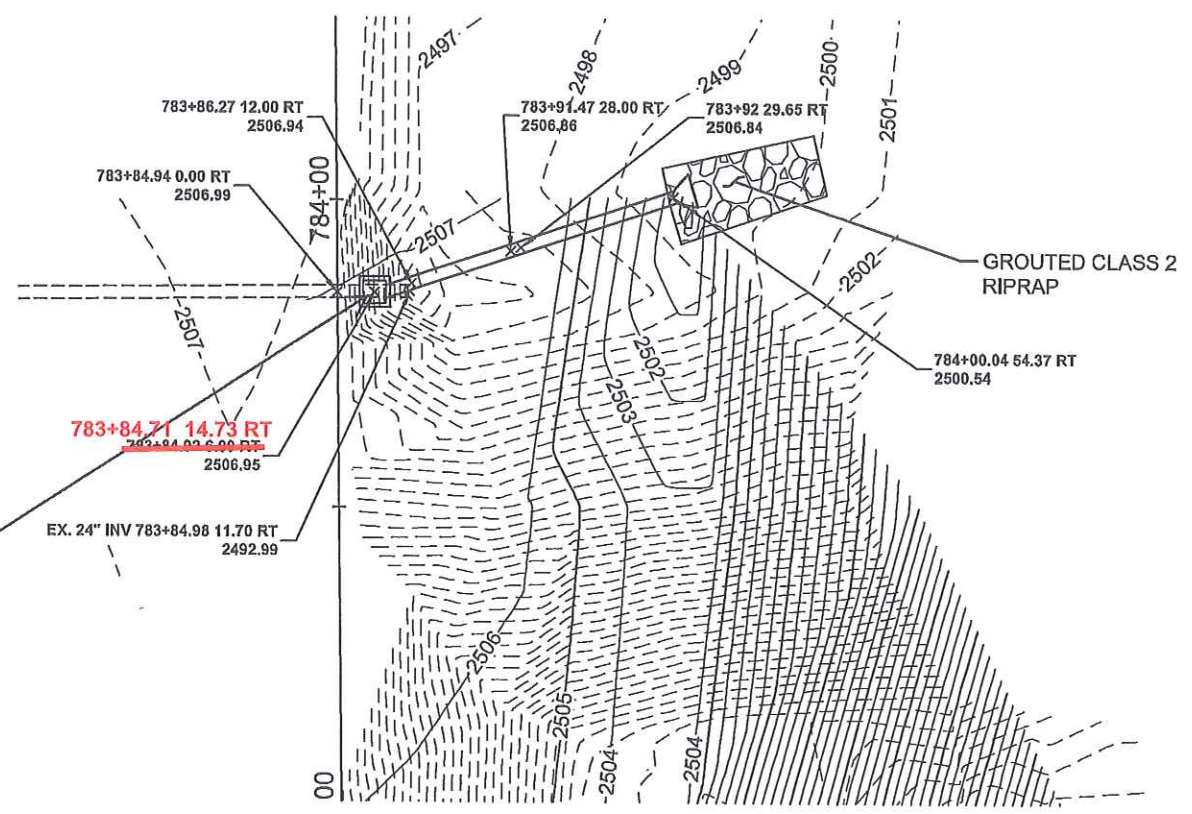

PLAN VIEW NOTES:


STATION AND OFFSET LABELS ARE BASED ON THE MAMALAHOA HIGHWAY ALIGNMENT.

ELEVATION LABELED ON THE CENTERLINE OF PIPE ARE PROPOSED ROADWAY SUBGRADE.

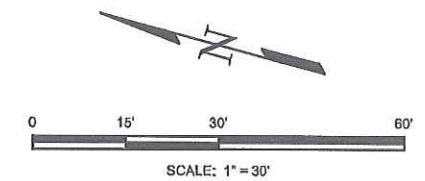

2506.79
Top manhole elev. = ~~2506.00~~. Adjust on 6(7) project.

2506.79
Top manhole elev. = ~~2506.00~~. Adjust on 6(7) project.

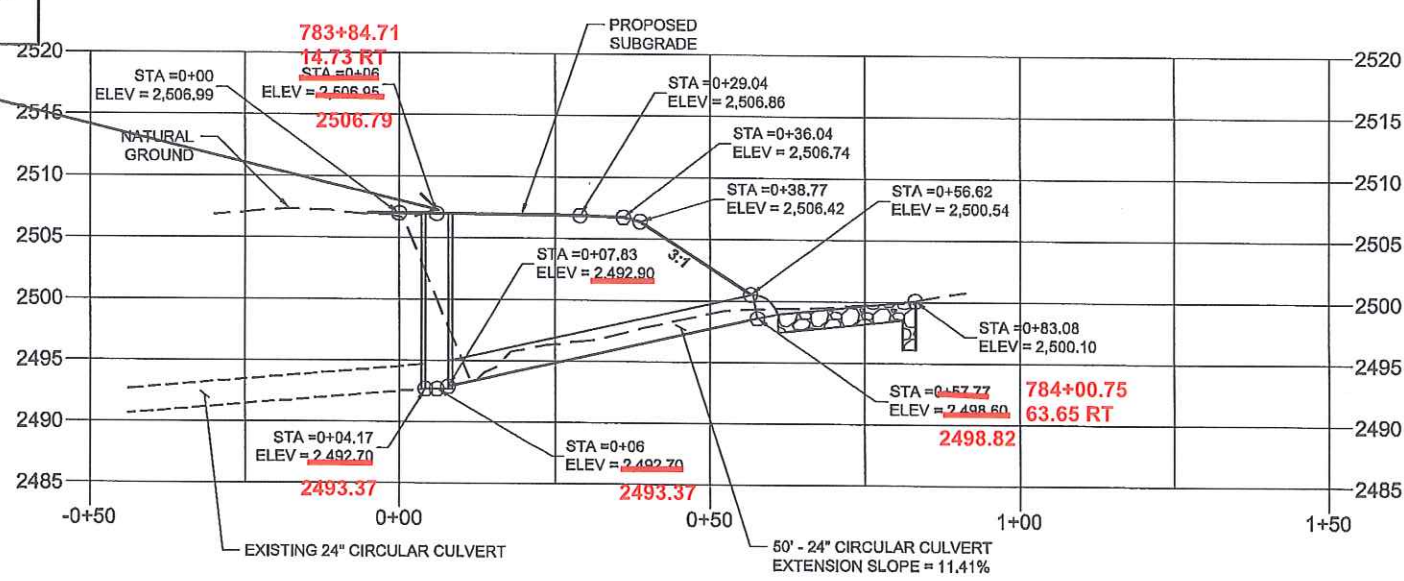

SCALE
HORIZ. 1" = 30'
VERT. 1" = 15'

Received 03/15/12
MHL

Approved as
noted, MHL
03/15/2012

PROFILE VIEW NOTES:

STATION AND OFFSET LABELS ARE BASED ON THE CENTERLINE OF PIPE ALIGNMENT.

PLAN REFERENCE: SHEET NO. G11

NO.	REVISIONS	DESCRIPTION	DATE

EDWARD-JAMES SURVEYING, INC.
2764 Janitell Road
Colorado Springs, CO 80906
Office: (719) 576-1216
Fax: (719) 576-1206




SADDLE ROAD - WEST SIDE
HI A-AD 6(6)
CULVERT PLAN AND PROFILE
STATION 783+85

DRAWN BY	ERF
CHECKED BY	ERF
H-SCALE	1" = 30'
JOB NO.	1017.00
DATE CREATED	03/02/12
DATE ISSUED	03/15/12
SHEET NO.	1 OF 1

SADDLE ROAD - WEST SIDE



HI A-AD 6(6) CULVERT PLAN AND PROFILE STATION 61+10

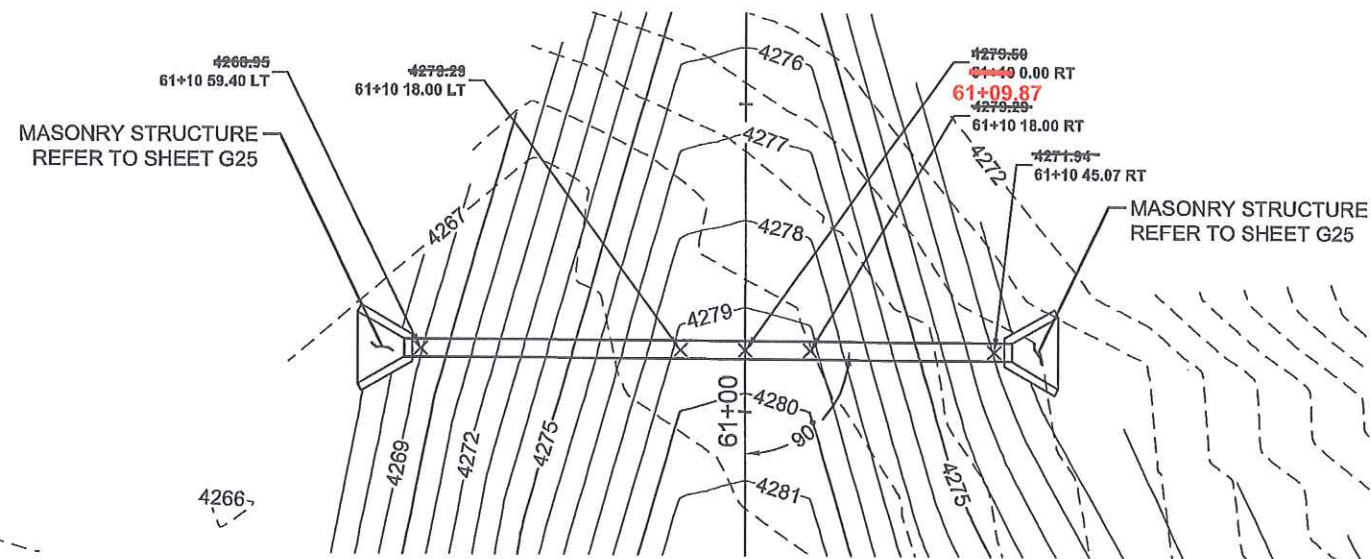

PLAN VIEW NOTES:

STATION AND OFFSET LABELS ARE BASED ON THE 488+35 APPROACH ROAD CENTERLINE ALIGNMENT.

ELEVATION LABELED ON THE CENTERLINE OF PIPE ARE PROPOSED APPROACH ROAD SUBGRADE.

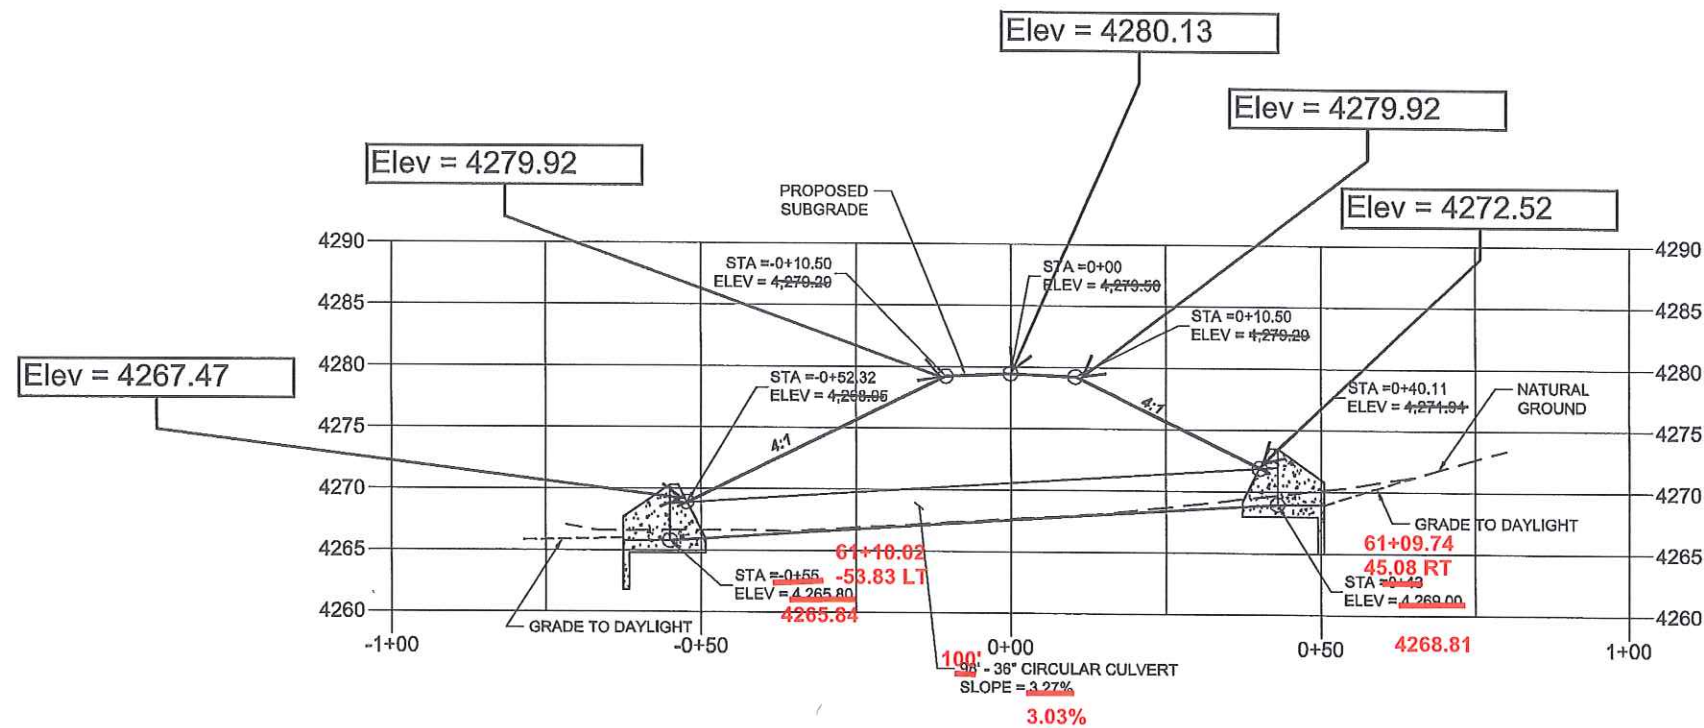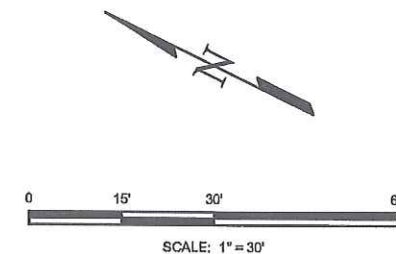

PROFILE VIEW NOTES:


STATION AND OFFSET LABELS ARE BASED ON THE CENTERLINE OF PIPE ALIGNMENT.

PLAN REFERENCE: SHEET NO. D4 AND G25

Received 03/23/2012 MHL
Approved as noted 03/23/2012 MHL
Approach Road Elevations are to subgrade.

REVISIONS	NO.	DESCRIPTION	DATE
1	1	CHANGED ROAD WIDTH TO 21'	3/23/12

EDWARD-JAMES SURVEYING, INC.
2764 Janitell Road
Colorado Springs, CO 80906
Office: (719) 576-1216
Fax: (719) 576-1206


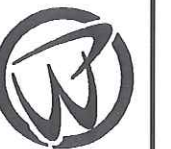


SADDLE ROAD - WEST SIDE
HI A-AD 6(6)
CULVERT PLAN AND PROFILE
STATION 61+10

DRAWN BY	ERF
CHECKED BY	ERF
H-SCALE	1" = 30'
JOB NO.	1017.00
DATE CREATED	03/21/12
DATE ISSUED	03/23/12
SHEET NO.	1 OF 1

SADDLE ROAD - WEST SIDE

HI A-AD 6(6) CULVERT PLAN AND PROFILE STATION 21+39

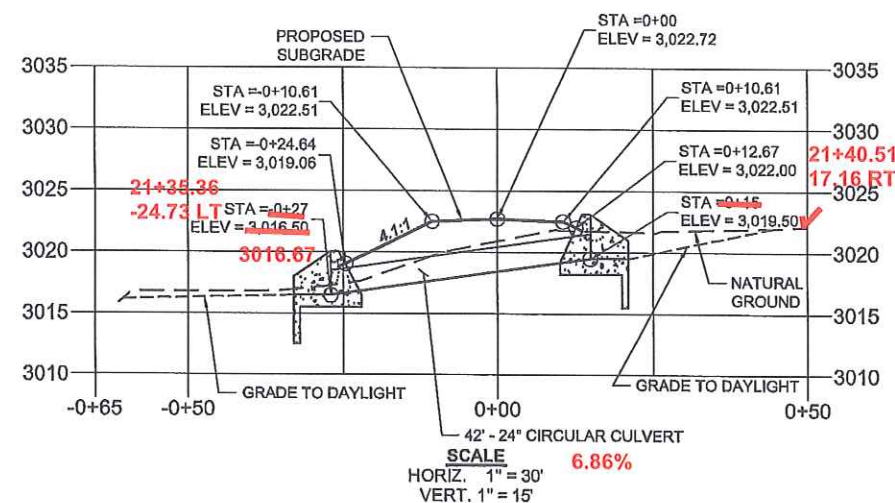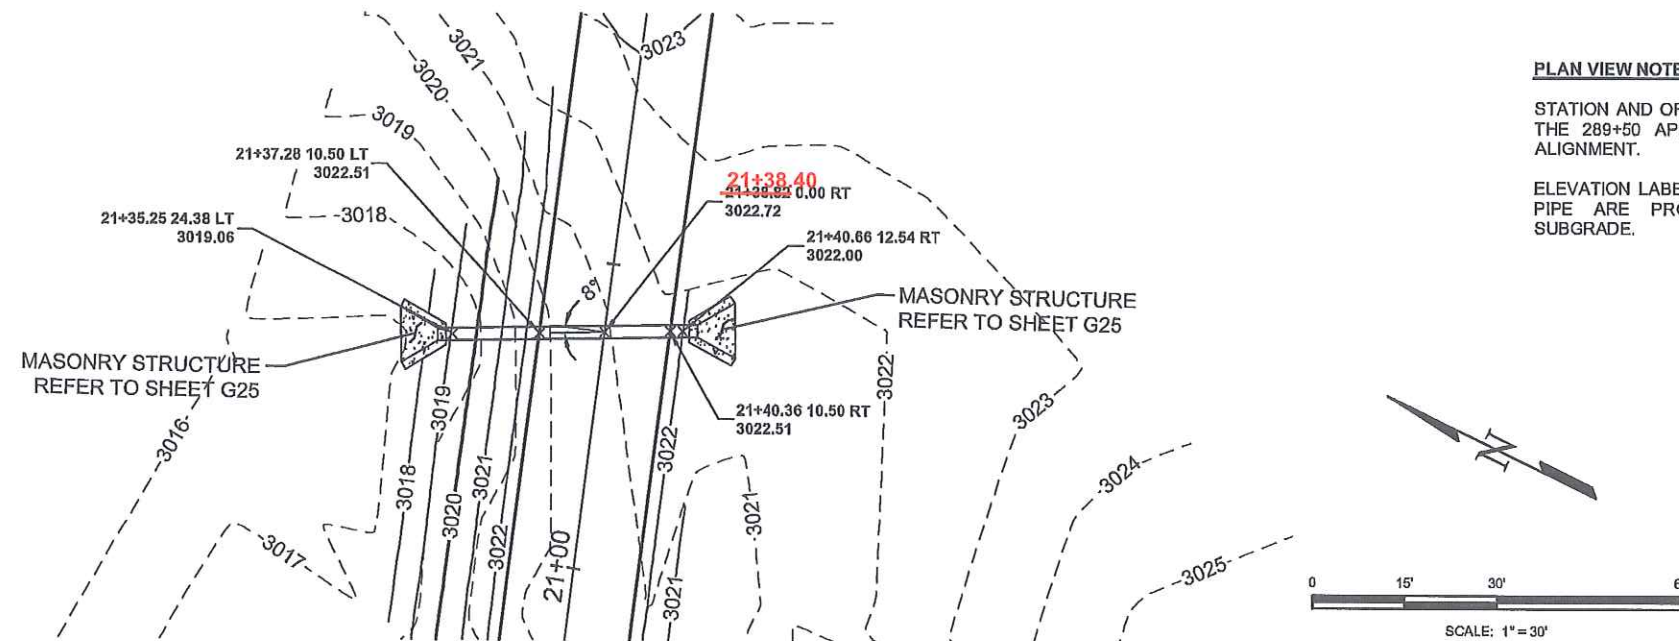

Received 03/22/2012
Approved as received
03/22/2012
MHL

NO.	REVISIONS	DESCRIPTION	DATE
1	1	PIPE MOVED 0.6' LEFT	2/23/12

**EDWARD-JAMES
SURVEYING, INC.**
4732 Eagle Ridge Circle
Pueblo, CO 81008
Office: (719) 545-6240
Fax: (719) 545-6247



SADDLE ROAD - WEST SIDE
HI A-AD 6(6)
CULVERT PLAN AND PROFILE
STATION 21+39

DRAWN BY	ERF
CHECKED BY	ERF
H-SCALE	1" = 30'
JOB NO.	1017.00
DATE CREATED	03/16/12
DATE ISSUED	03/22/12
SHEET NO.	1 OF 1