


5/19/2011 9:09:05 AM M:\2006\2006_069.004 CFLHD Saddle Road_West Side\G Drawings\Contract Documents\Civil\HI SR 200(00)_ecp120.dgn



NOTE:

1. Erosion and sediment control devices not to scale.
2. Refer to the Conventional Plan Symbols and Abbreviations sheet for erosion and sediment control symbols.

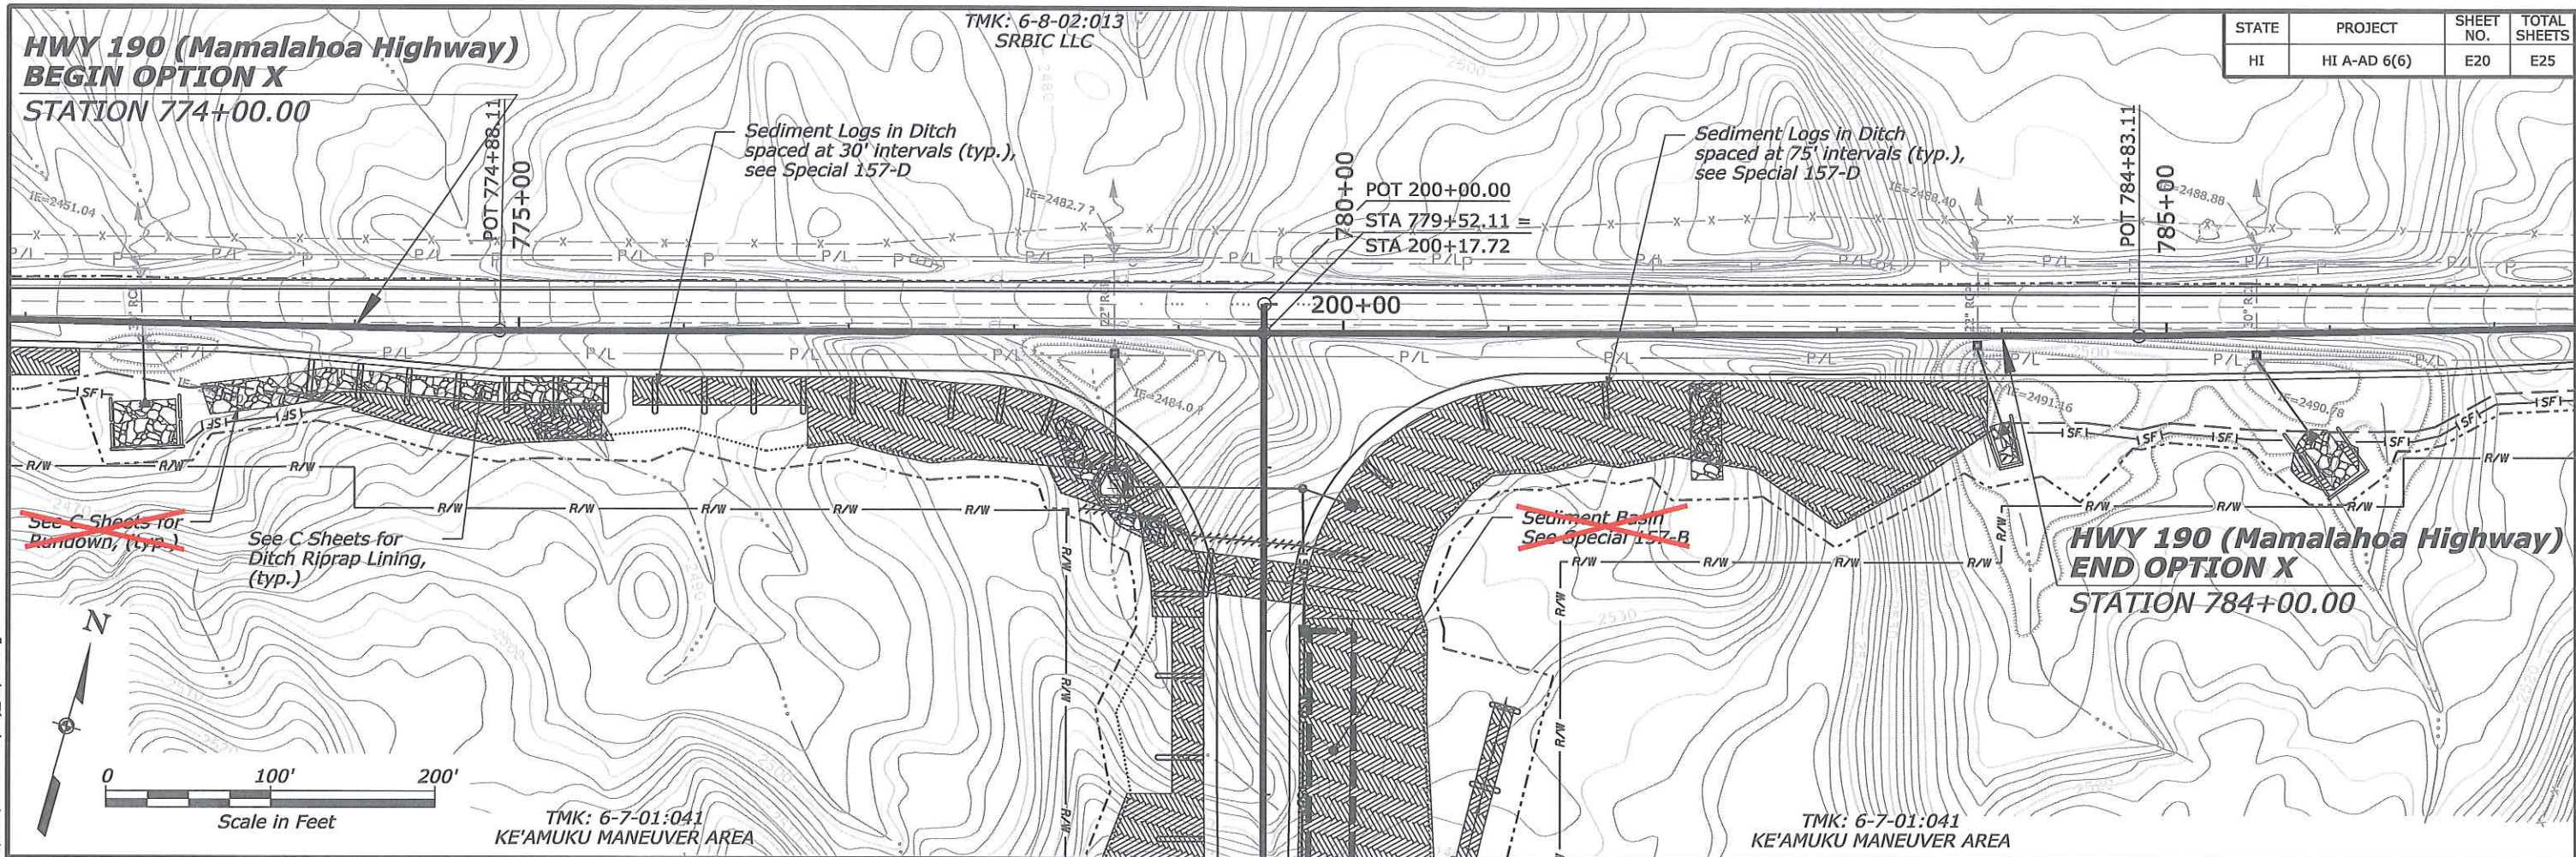

THIS WORK WAS PREPARED BY ME OR
UNDER MY SUPERVISION.
4/30/2012
SIGNATURE EXPIRATION DATE
OF THE LICENSE

U.S. DEPARTMENT OF TRANSPORTATION
FEDERAL HIGHWAY ADMINISTRATION
CENTRAL FEDERAL LANDS HIGHWAY DIVISION

HWY 190 (Mamalahoa Hwy)
EROSION AND SEDIMENT
CONTROL PLAN
764+00 to 787+00