












S:\Tranproj\100013746-SR\HwyDes\Roadway\Sheets\_Bld\_Package\_1\1C-ML\_P&P\HI SR 200(00).pp03.dgn  
6:46:06 AM  
5/16/2011

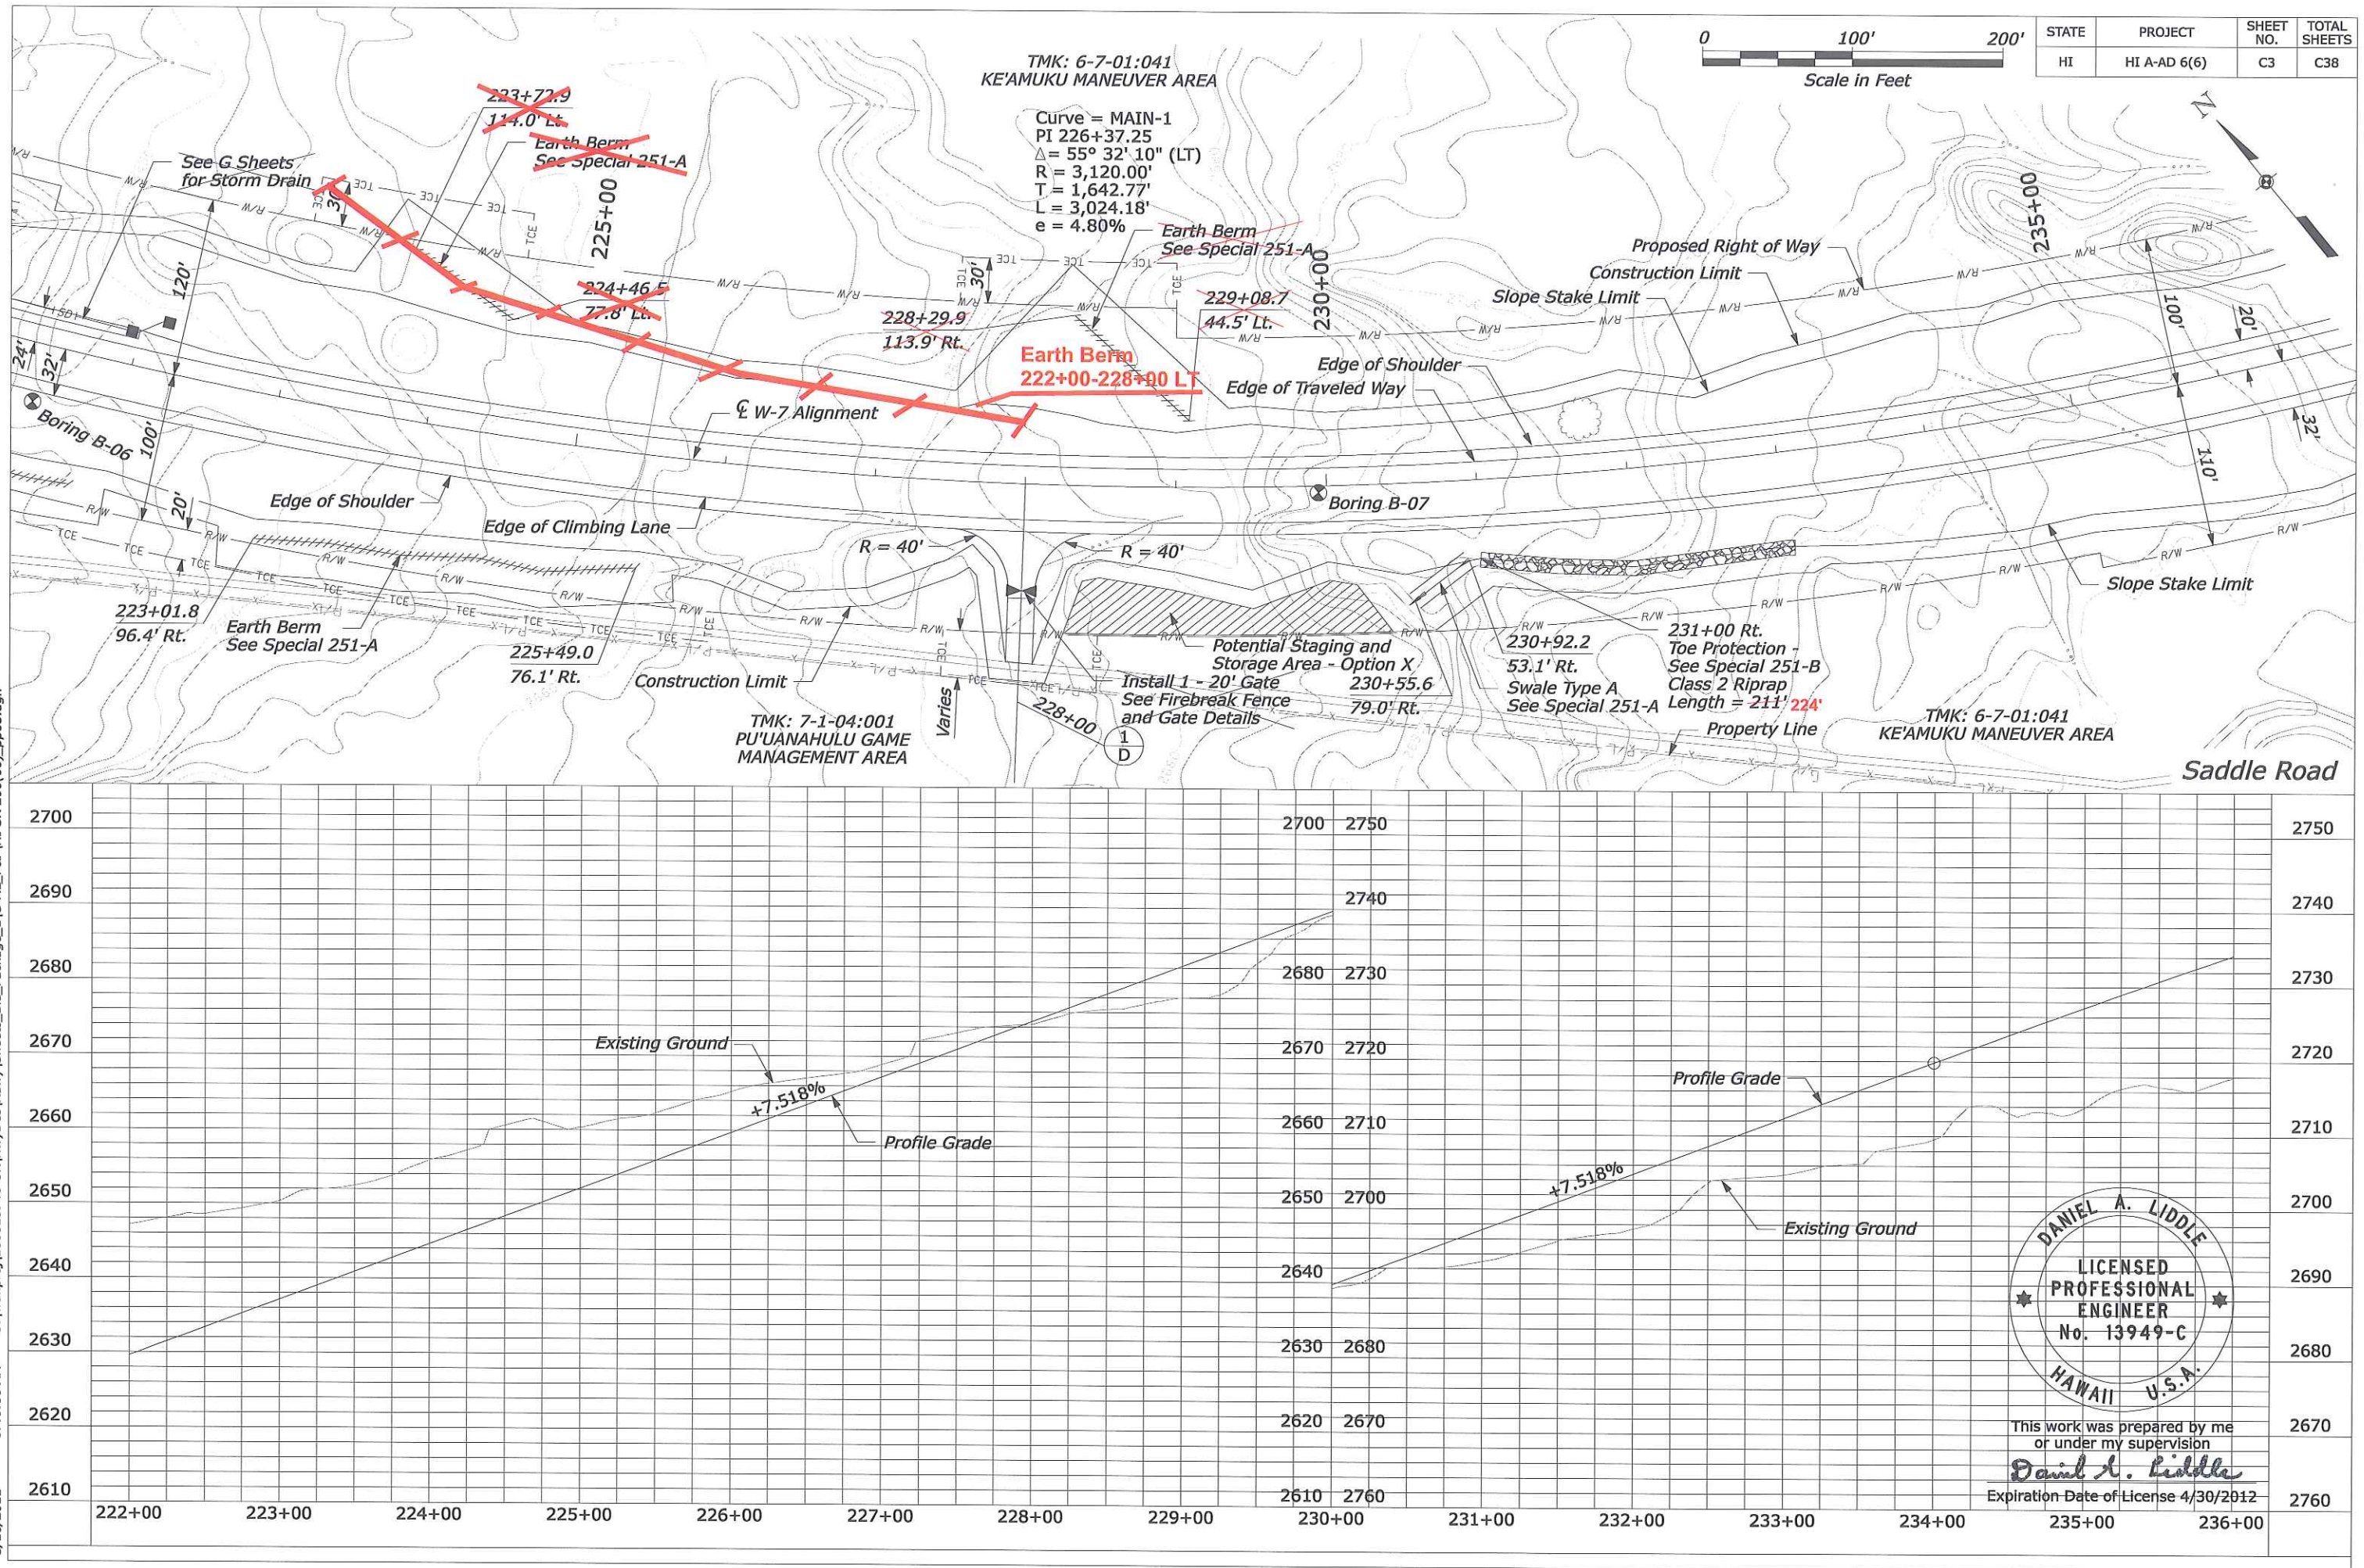




5/19/2011 12:54:11 PM S:\Temp\proj\100013746-SR\HW\Des\Raw\Sheets\_Bld\_Package\_1\C-MIL\_P&P\HI SR 200(00)\_pp04.dgn

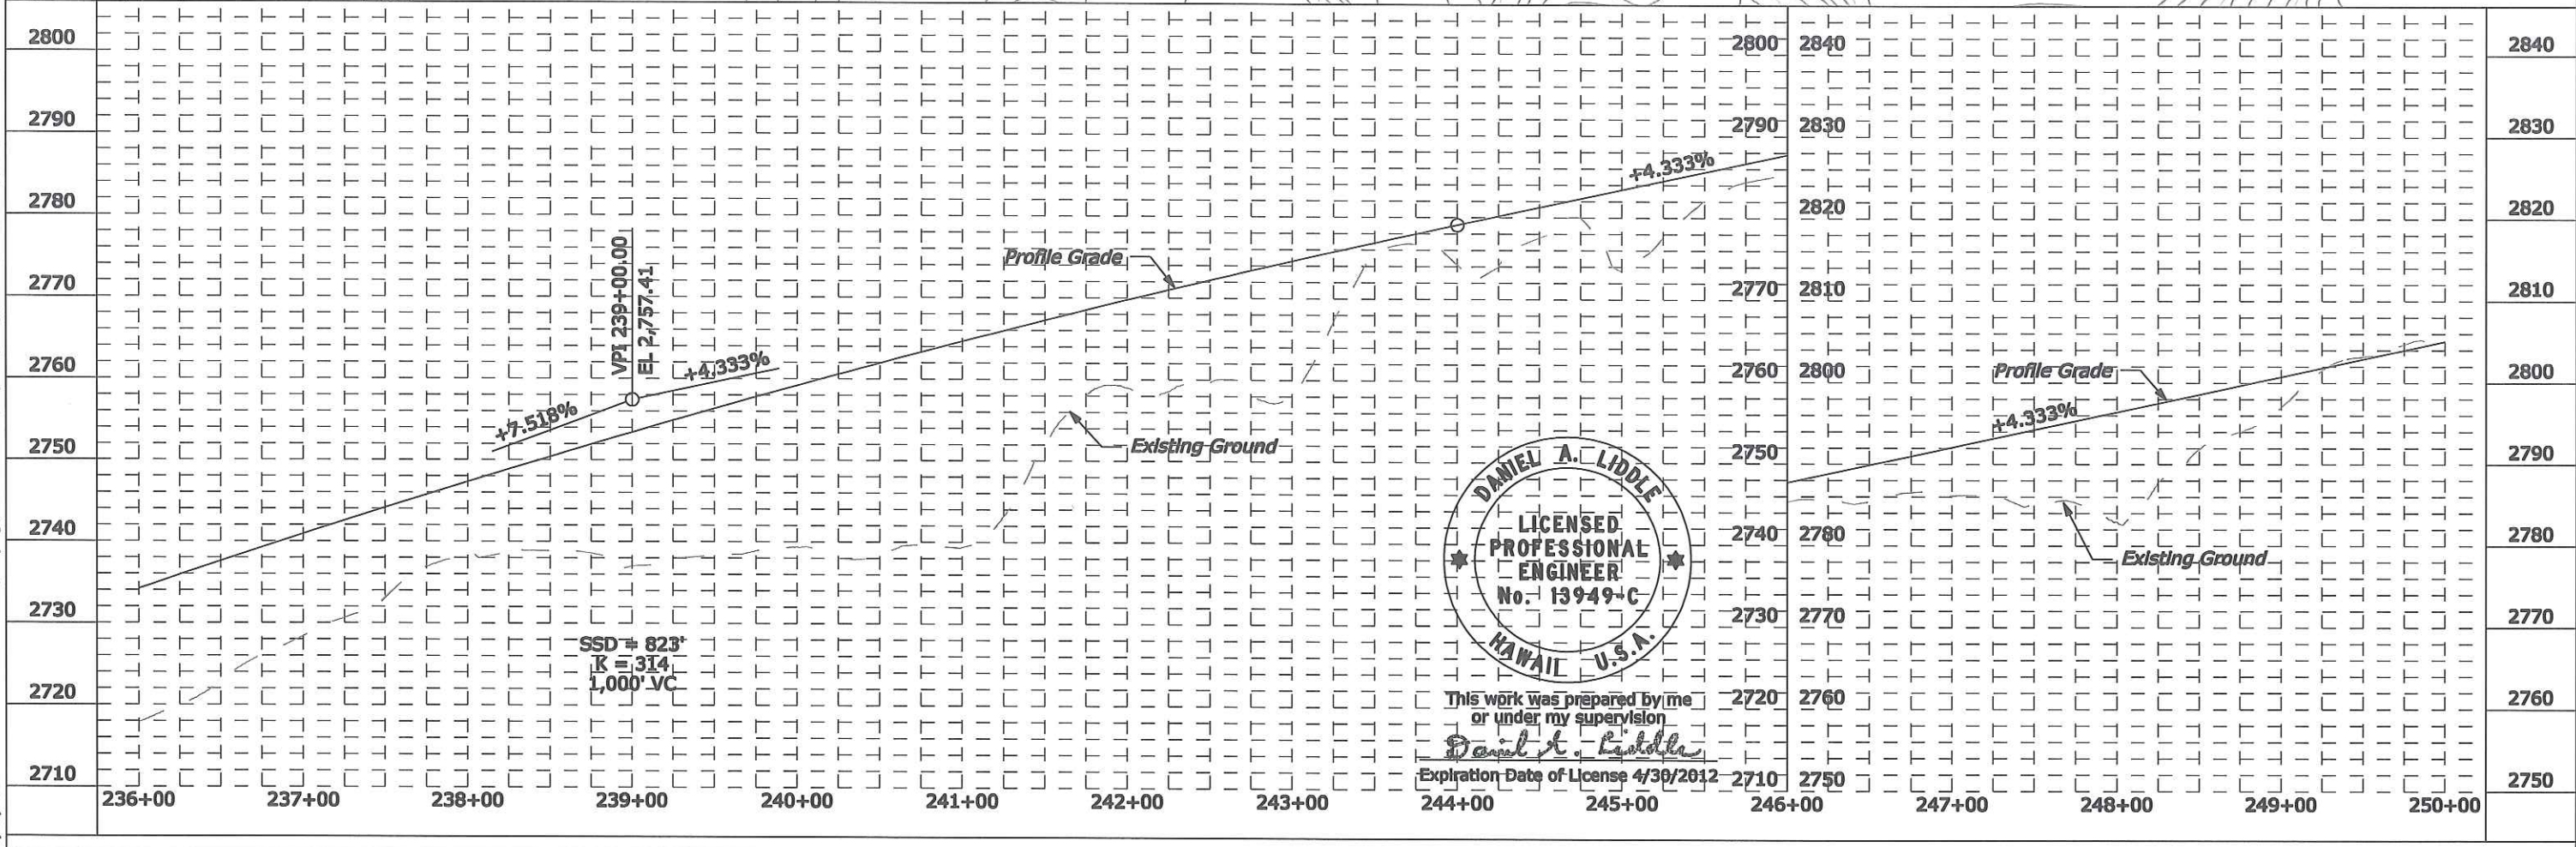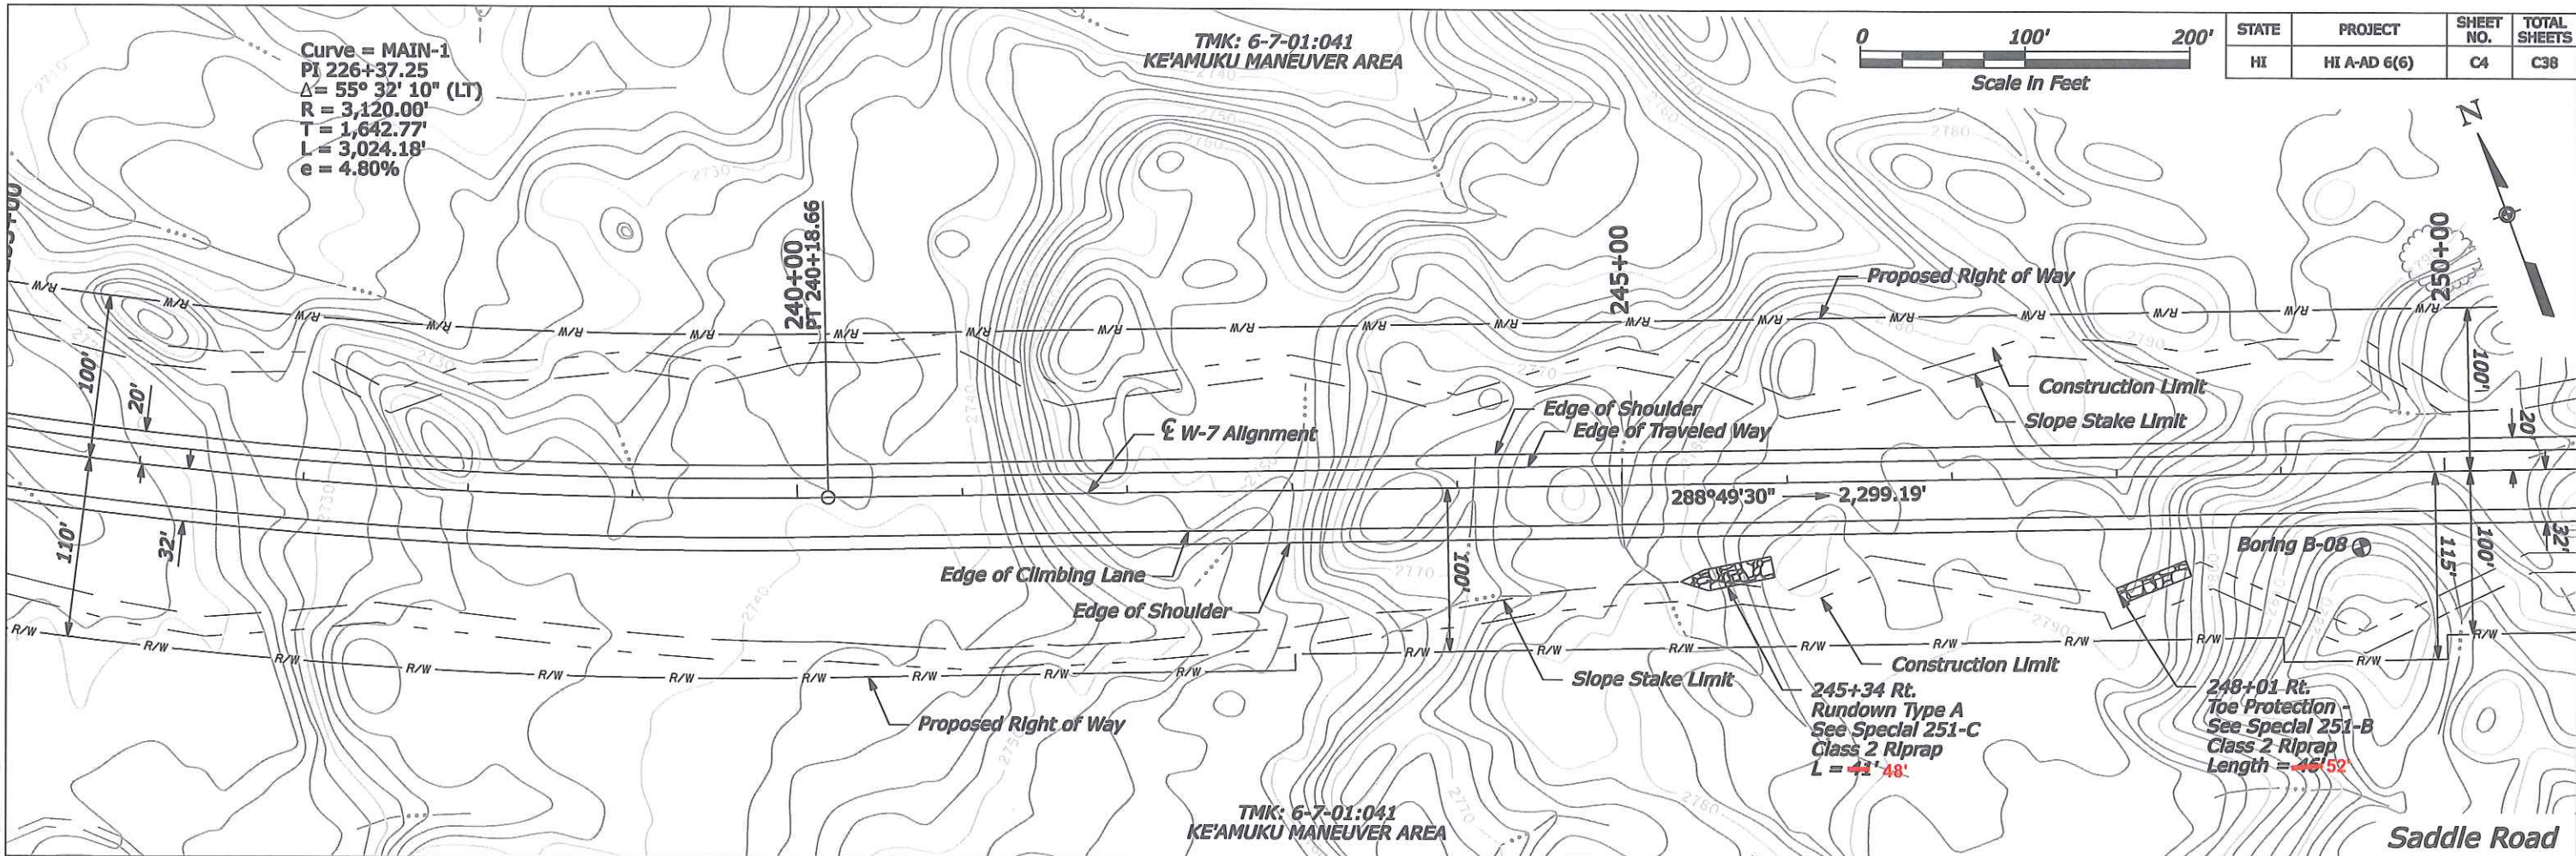





5/18/2011 5:58:55 AM S:\Temp\proj100013746-SR\HWYDes\Draw\Sheets\_Bld\_Package\_1\C-ML\_P&P\HI SR 200(00)\_pp05.dgn

TMK: 6-7-01:041  
KE'AMUKU MANEUVER AREA


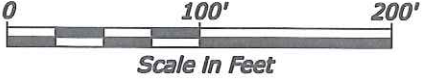


| STATE | PROJECT      | SHEET NO. | TOTAL SHEETS |
|-------|--------------|-----------|--------------|
| HI    | HI A-AD 6(6) | C5        | C38          |

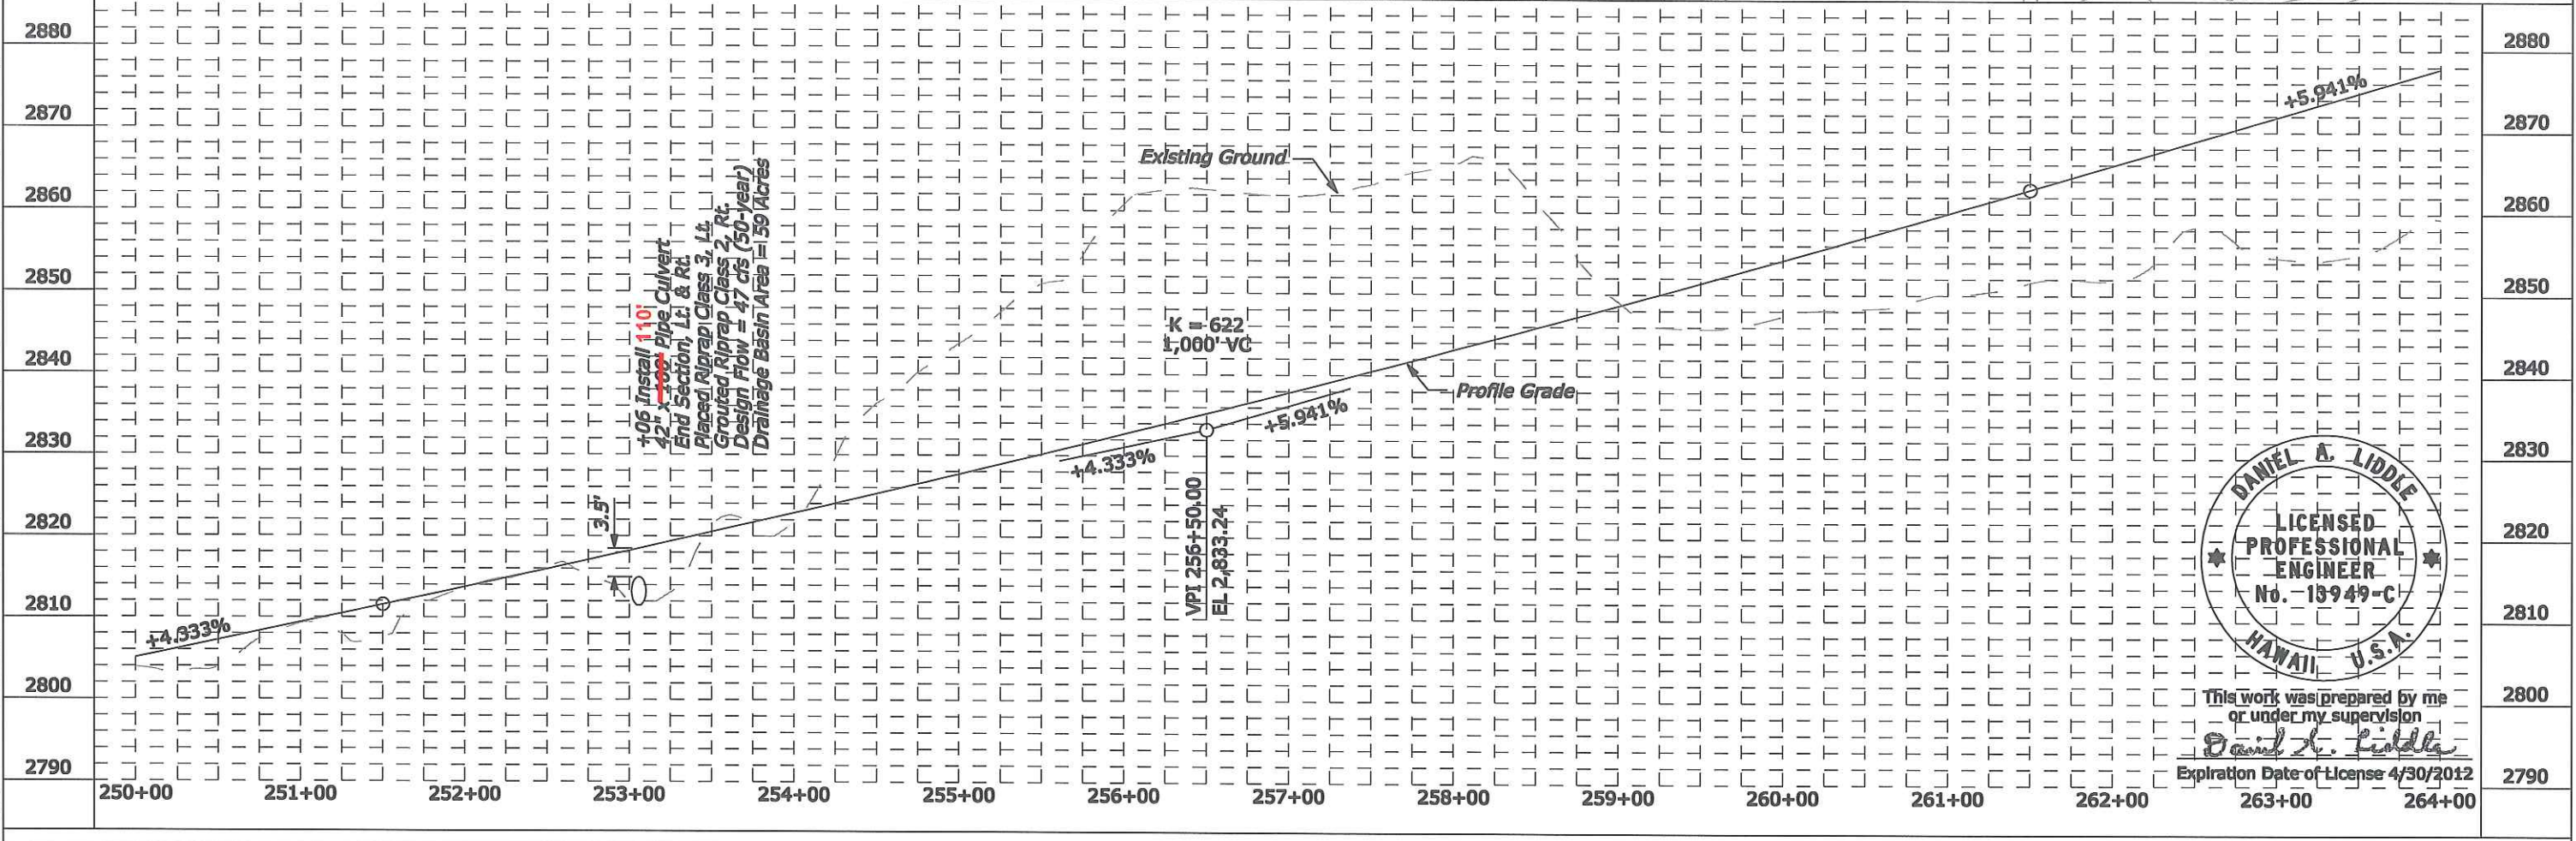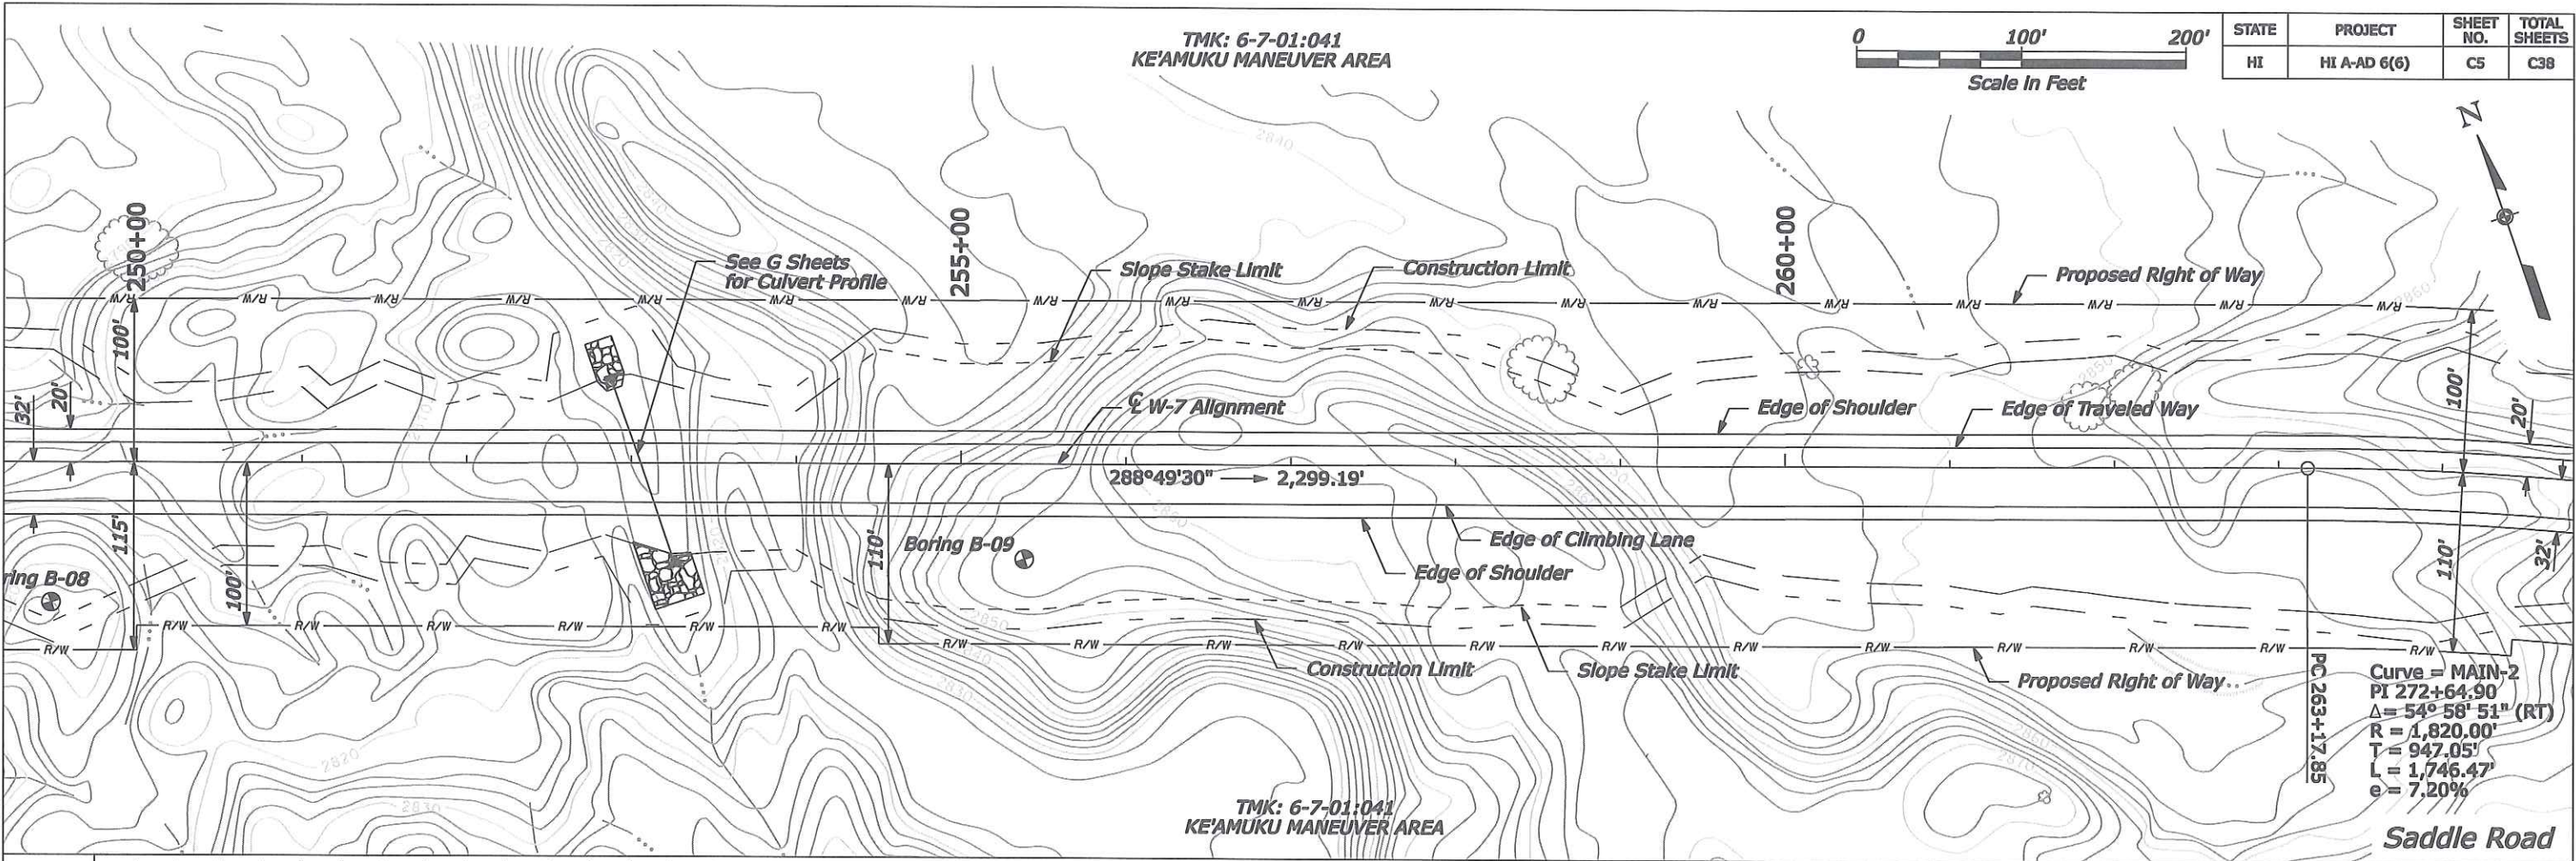




5/16/2011 6:49:35 AM S:\Transport\100013746-SR\HwyDes\Drawings\Sheets\_Bld\_Package\_1\C-MIL\_Prop\Hwy SR 200(00)\_pp06.dgn

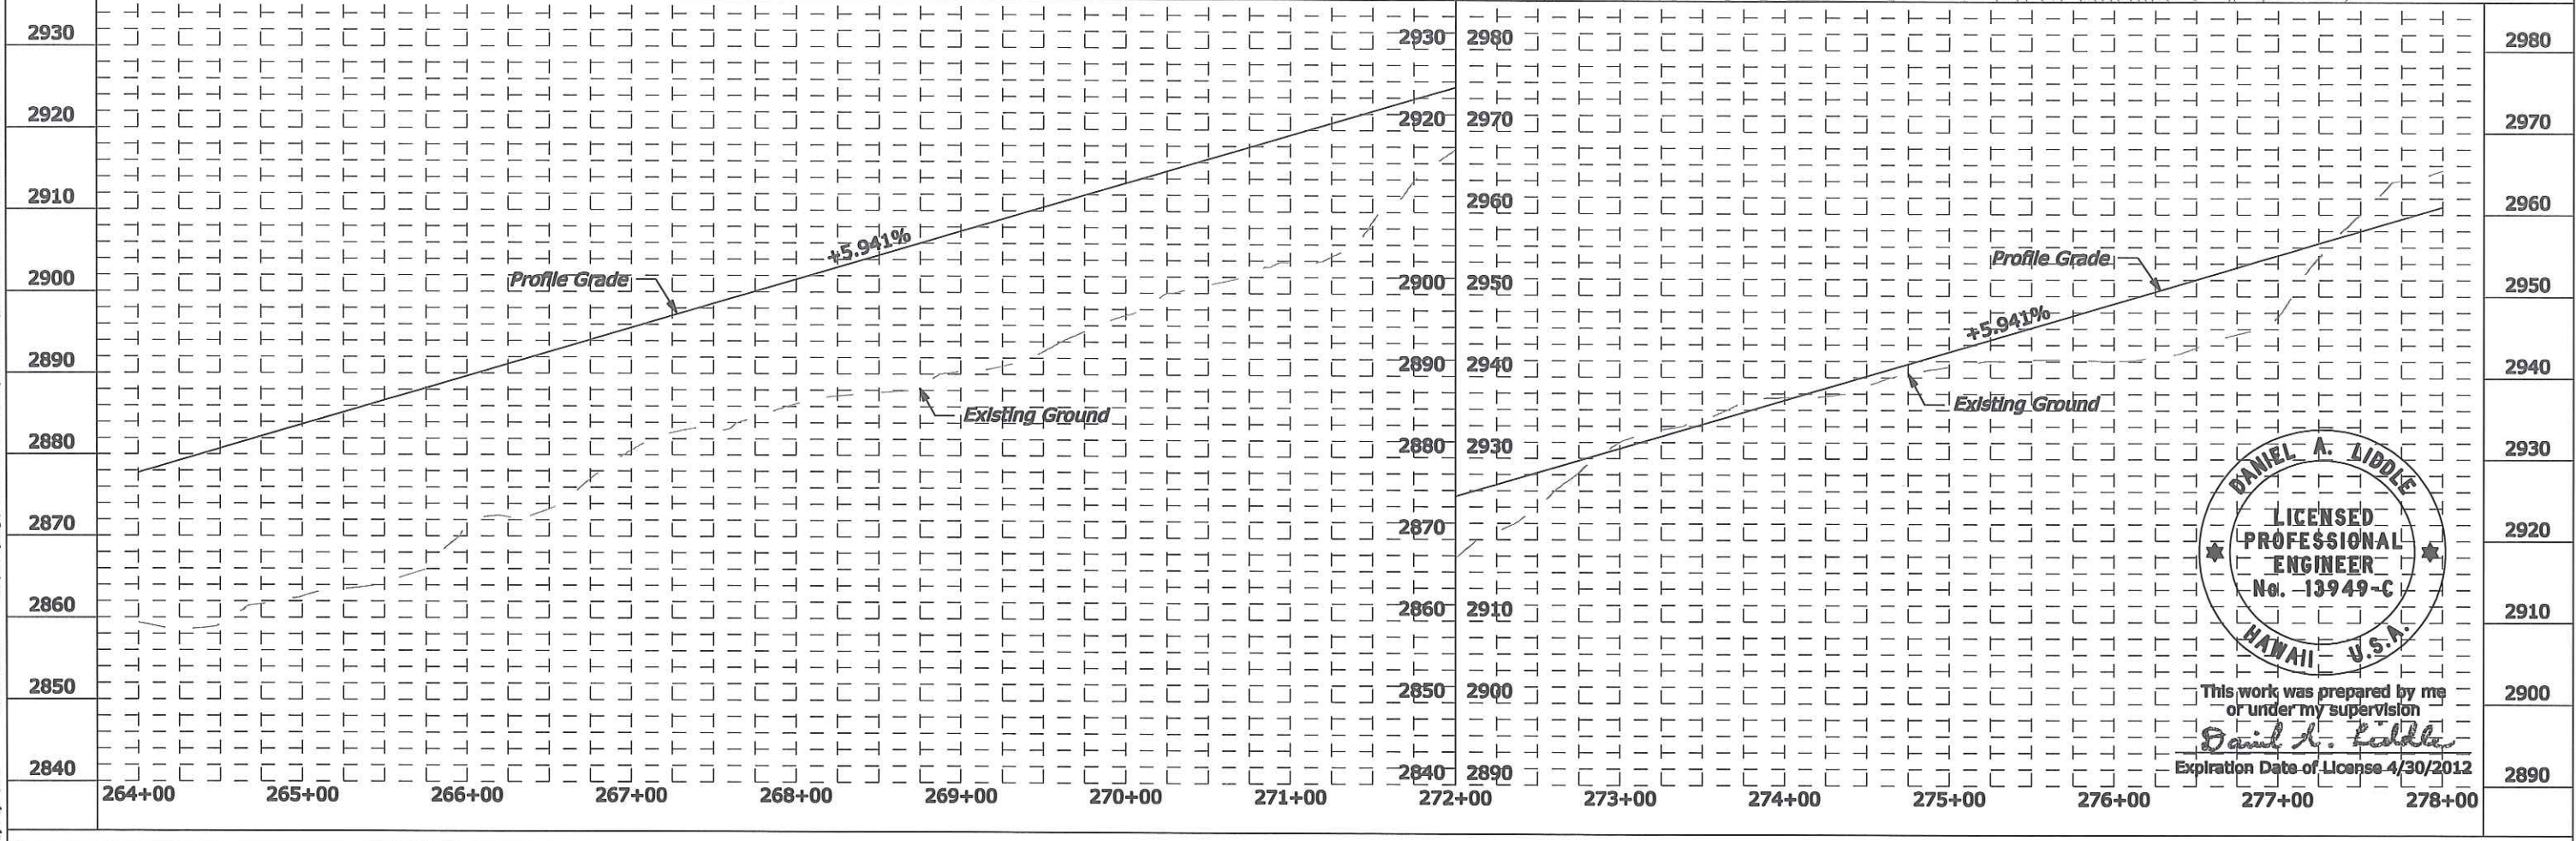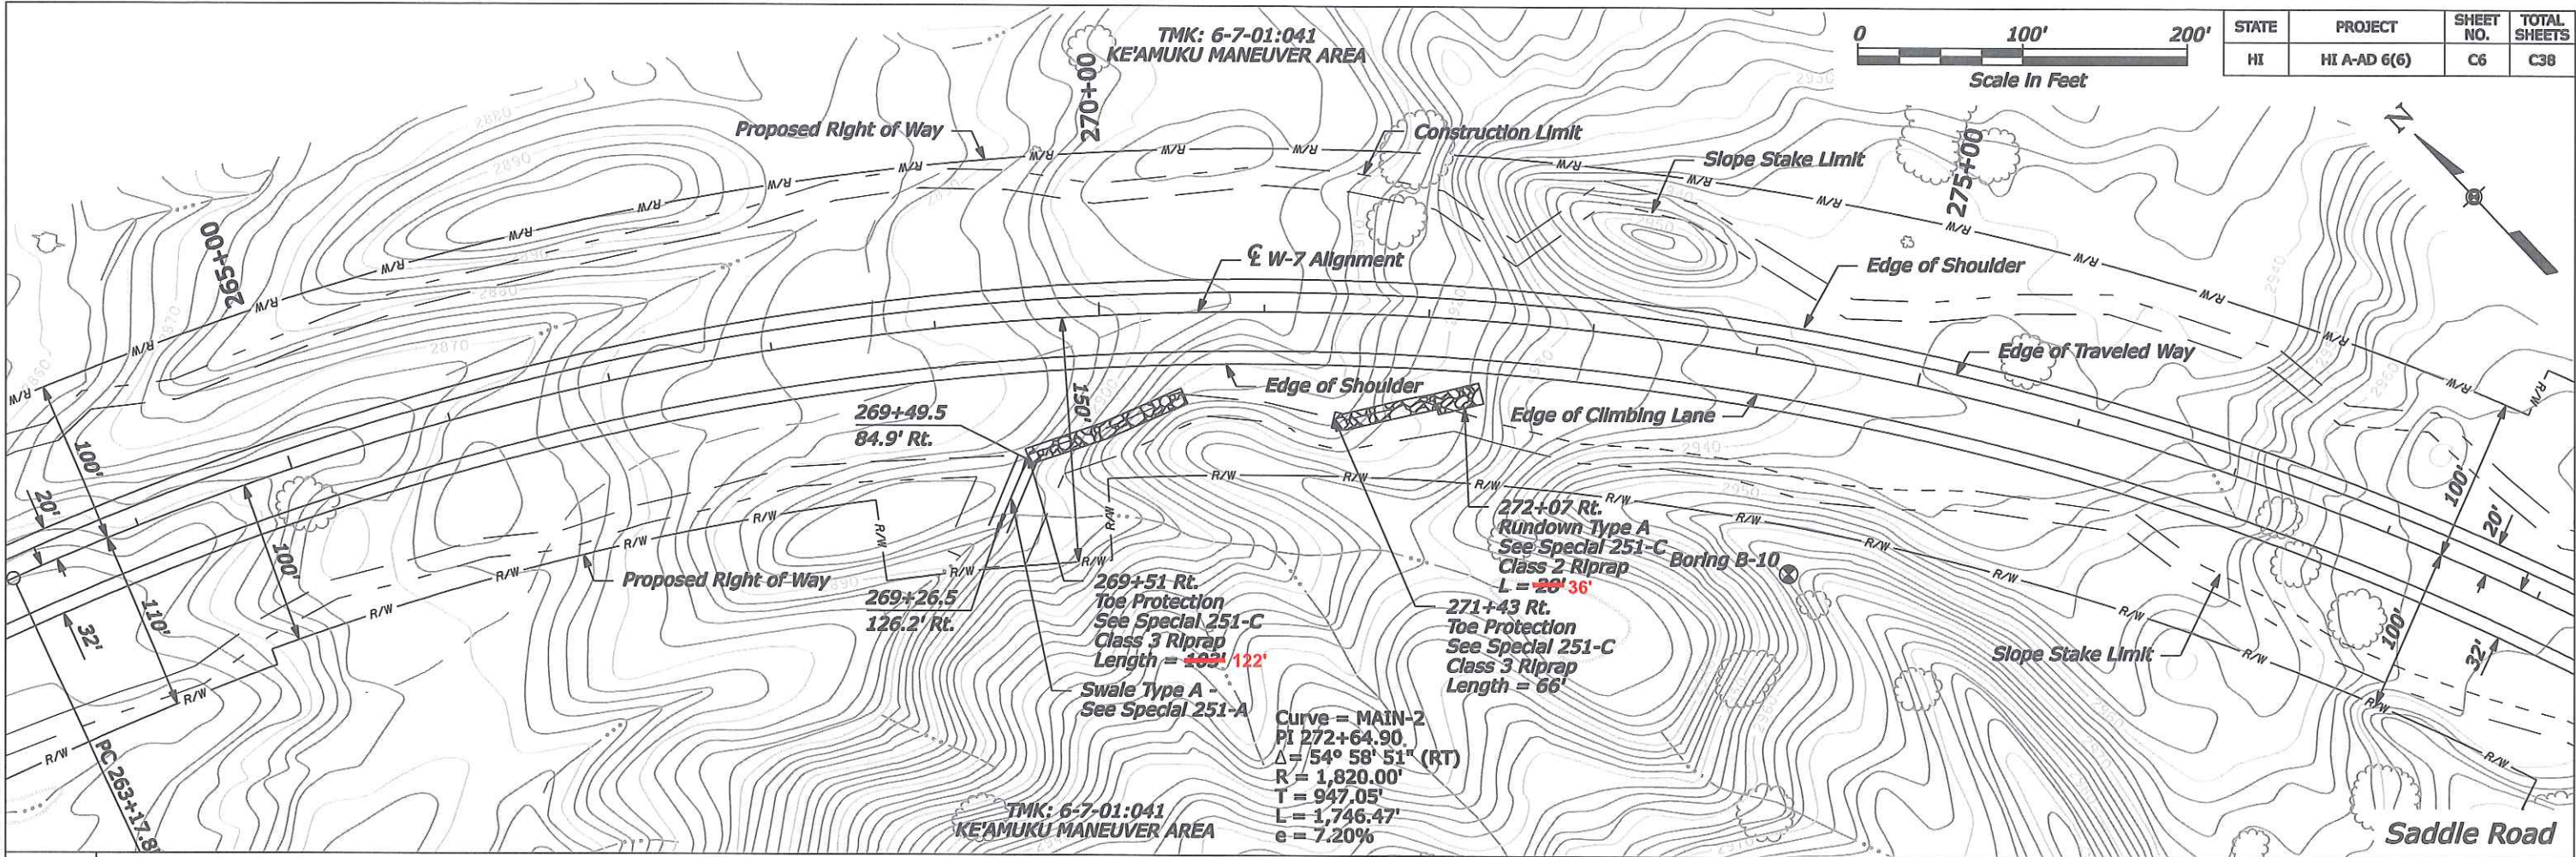




5/18/2011 5:54:25 AM S:\Temp\proj\100013746-SR\HW\Des\Draw\Sheets\_Bld\_Package\_1\C-M\A\_Pop\HW SR 200(00)\_pp07.dgn

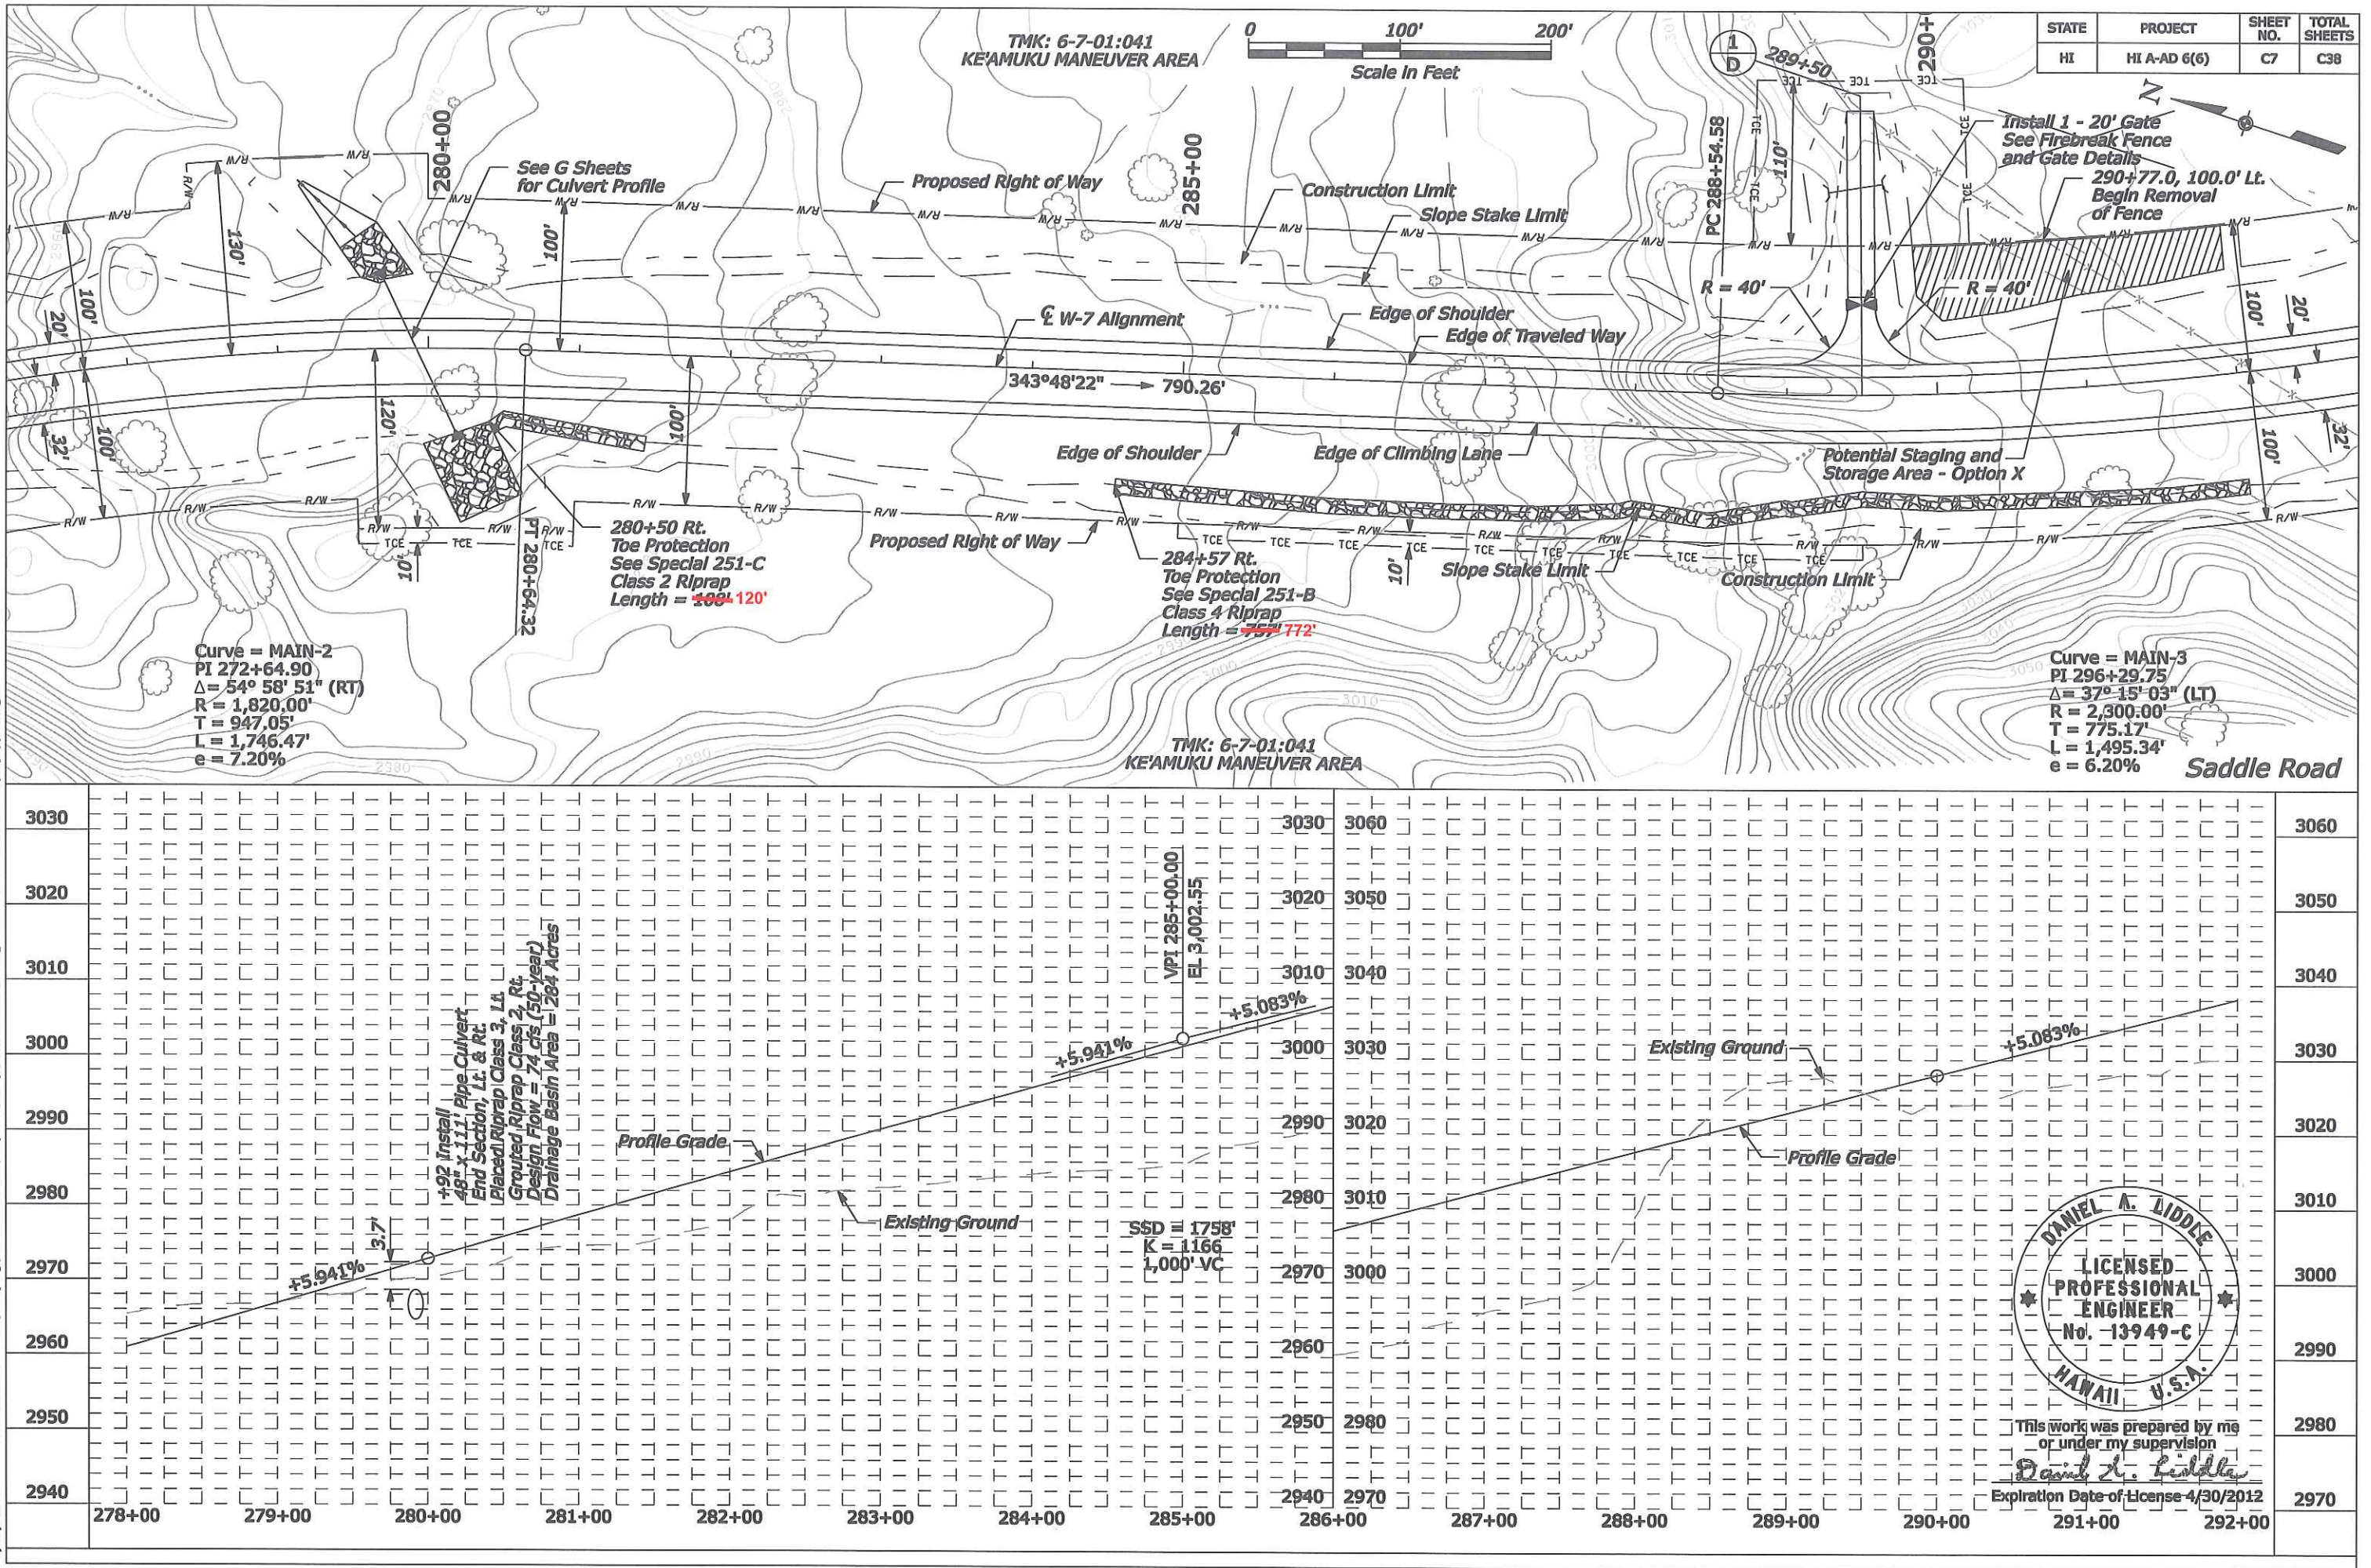





5/16/2011 6:53:59 AM S:\Tranpro\100013746-SR\HwyDes\Drawings\Sheets\_Bld\_Package\_1\C-M\_L\_P&P\HI SR 200(00)\_pp08.dgn

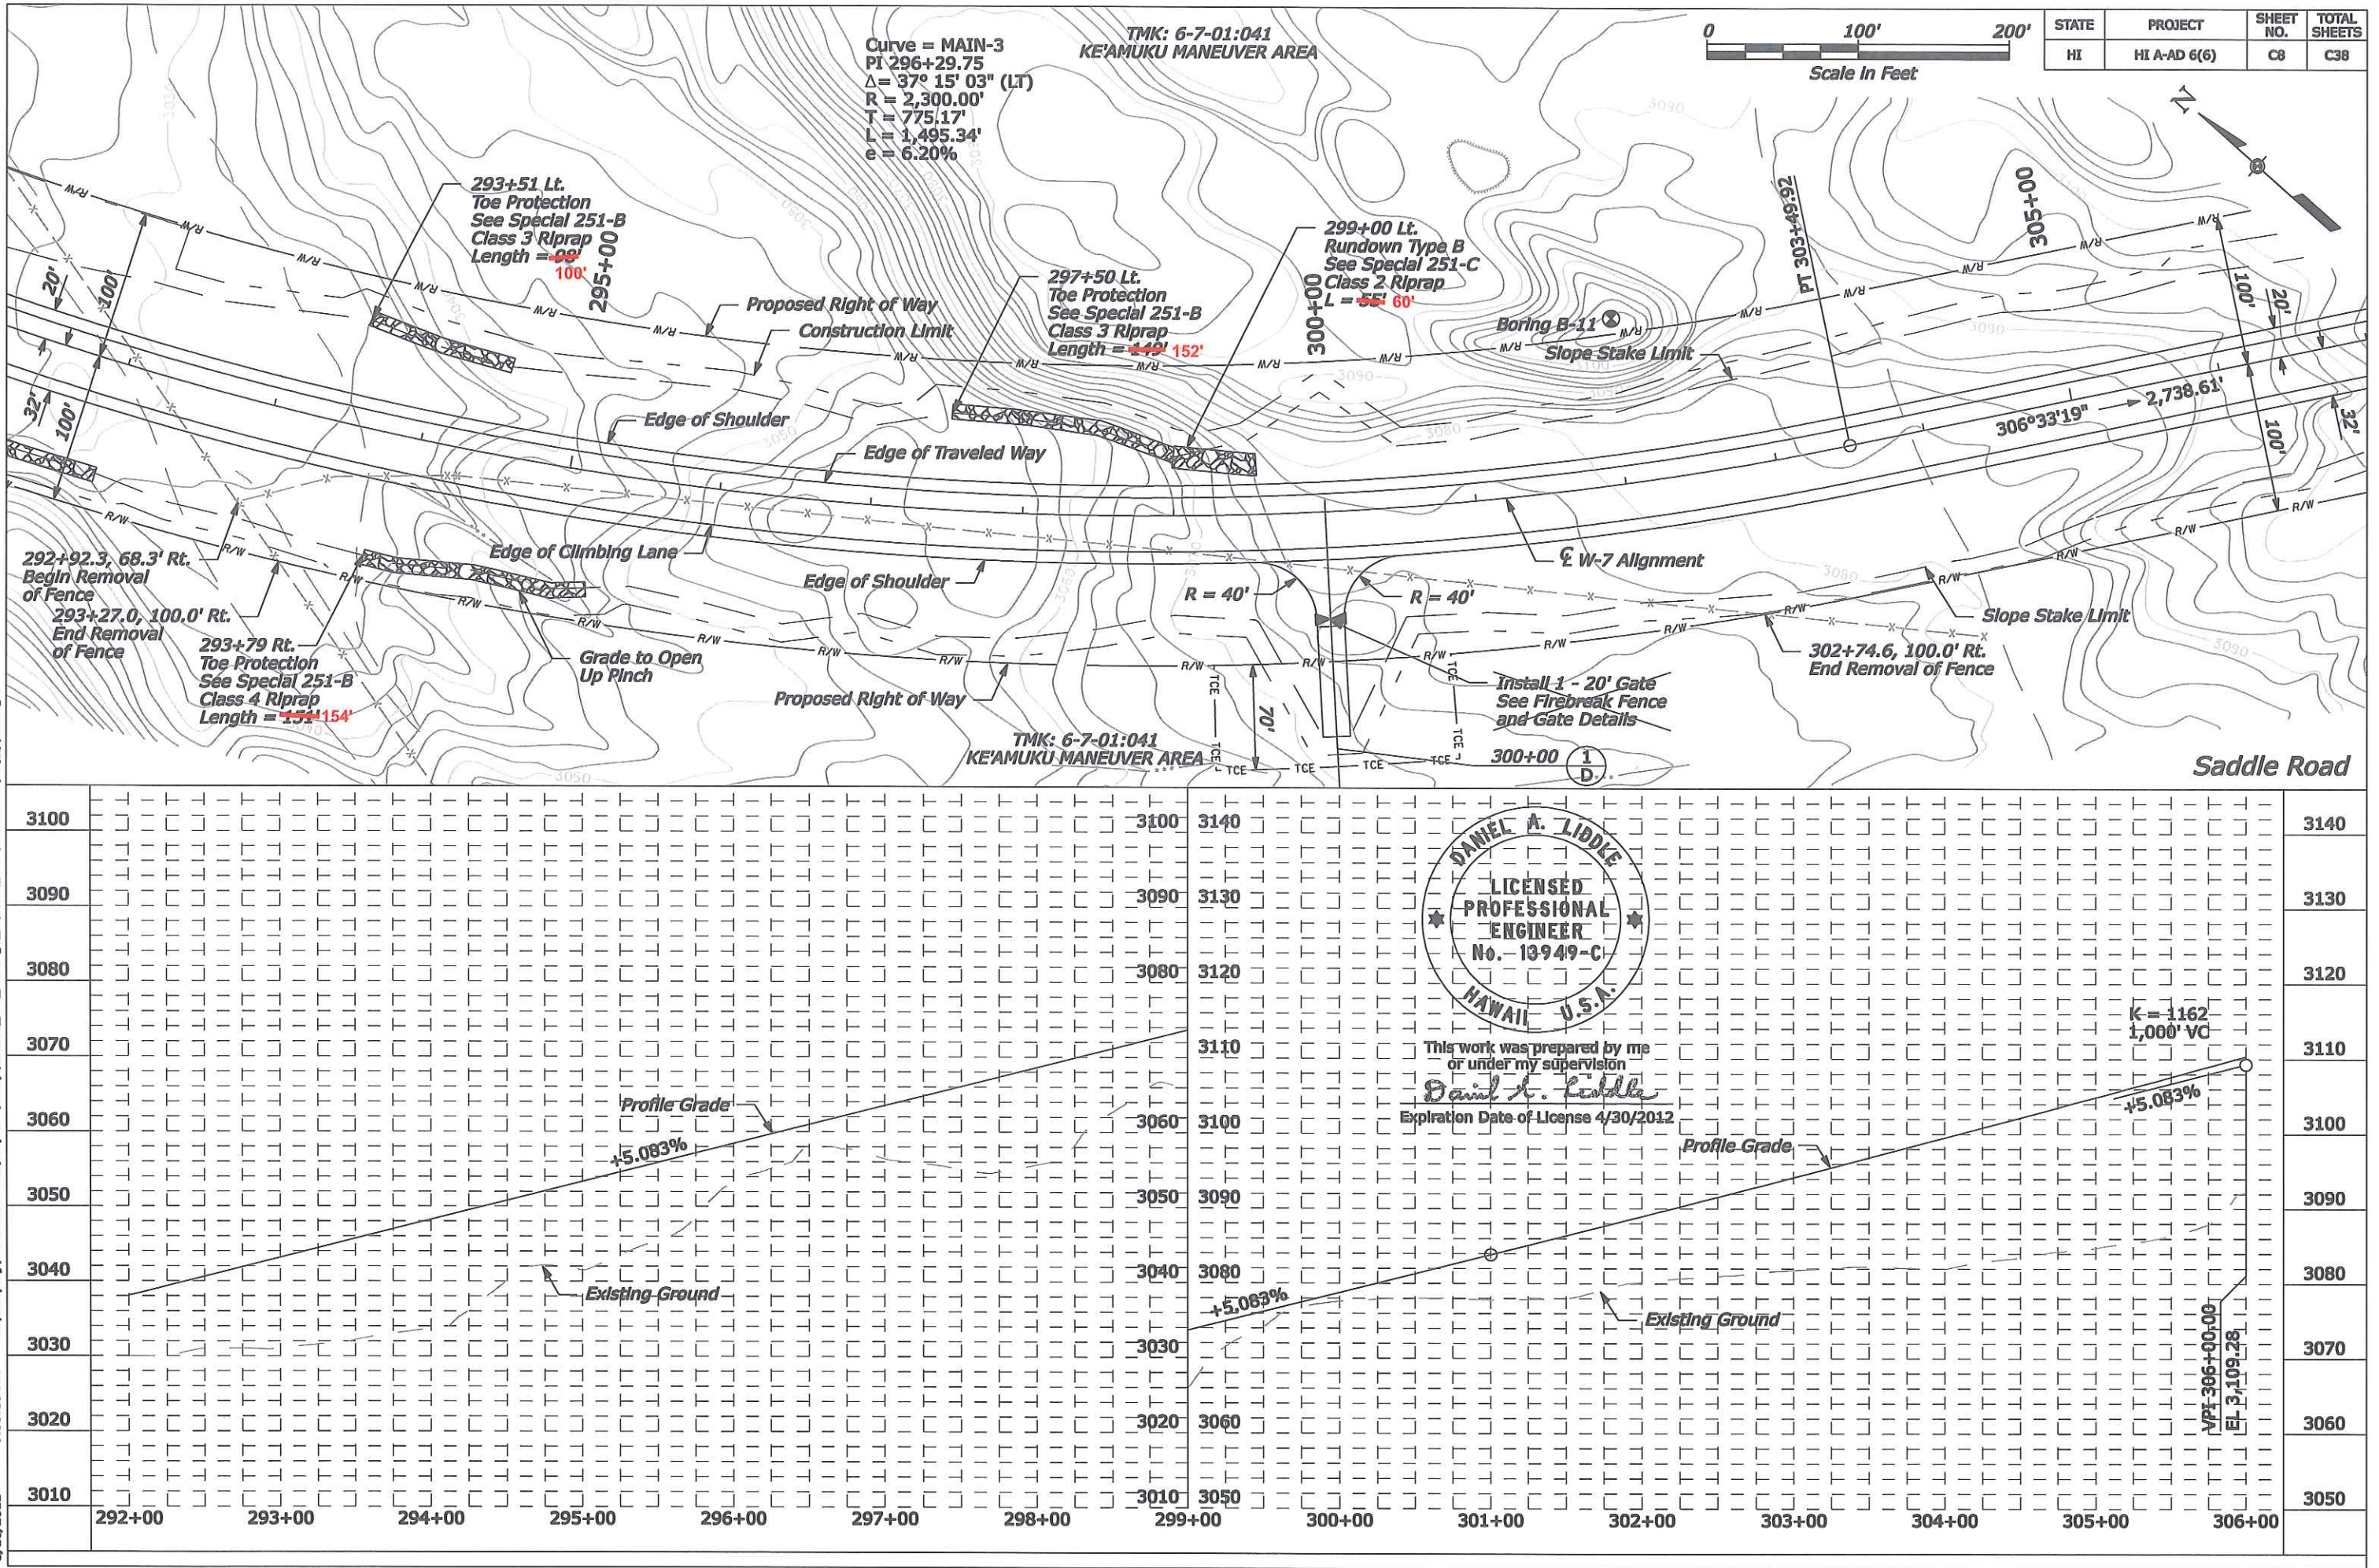




5/16/2011 6:54:24 AM S:\Transport\100013746-SR\HwyDes\Drawings\Sheets\_Bld\_Package\_1\C-MIL\_PEP\H1 SR 200(00)\_pp09.dgn

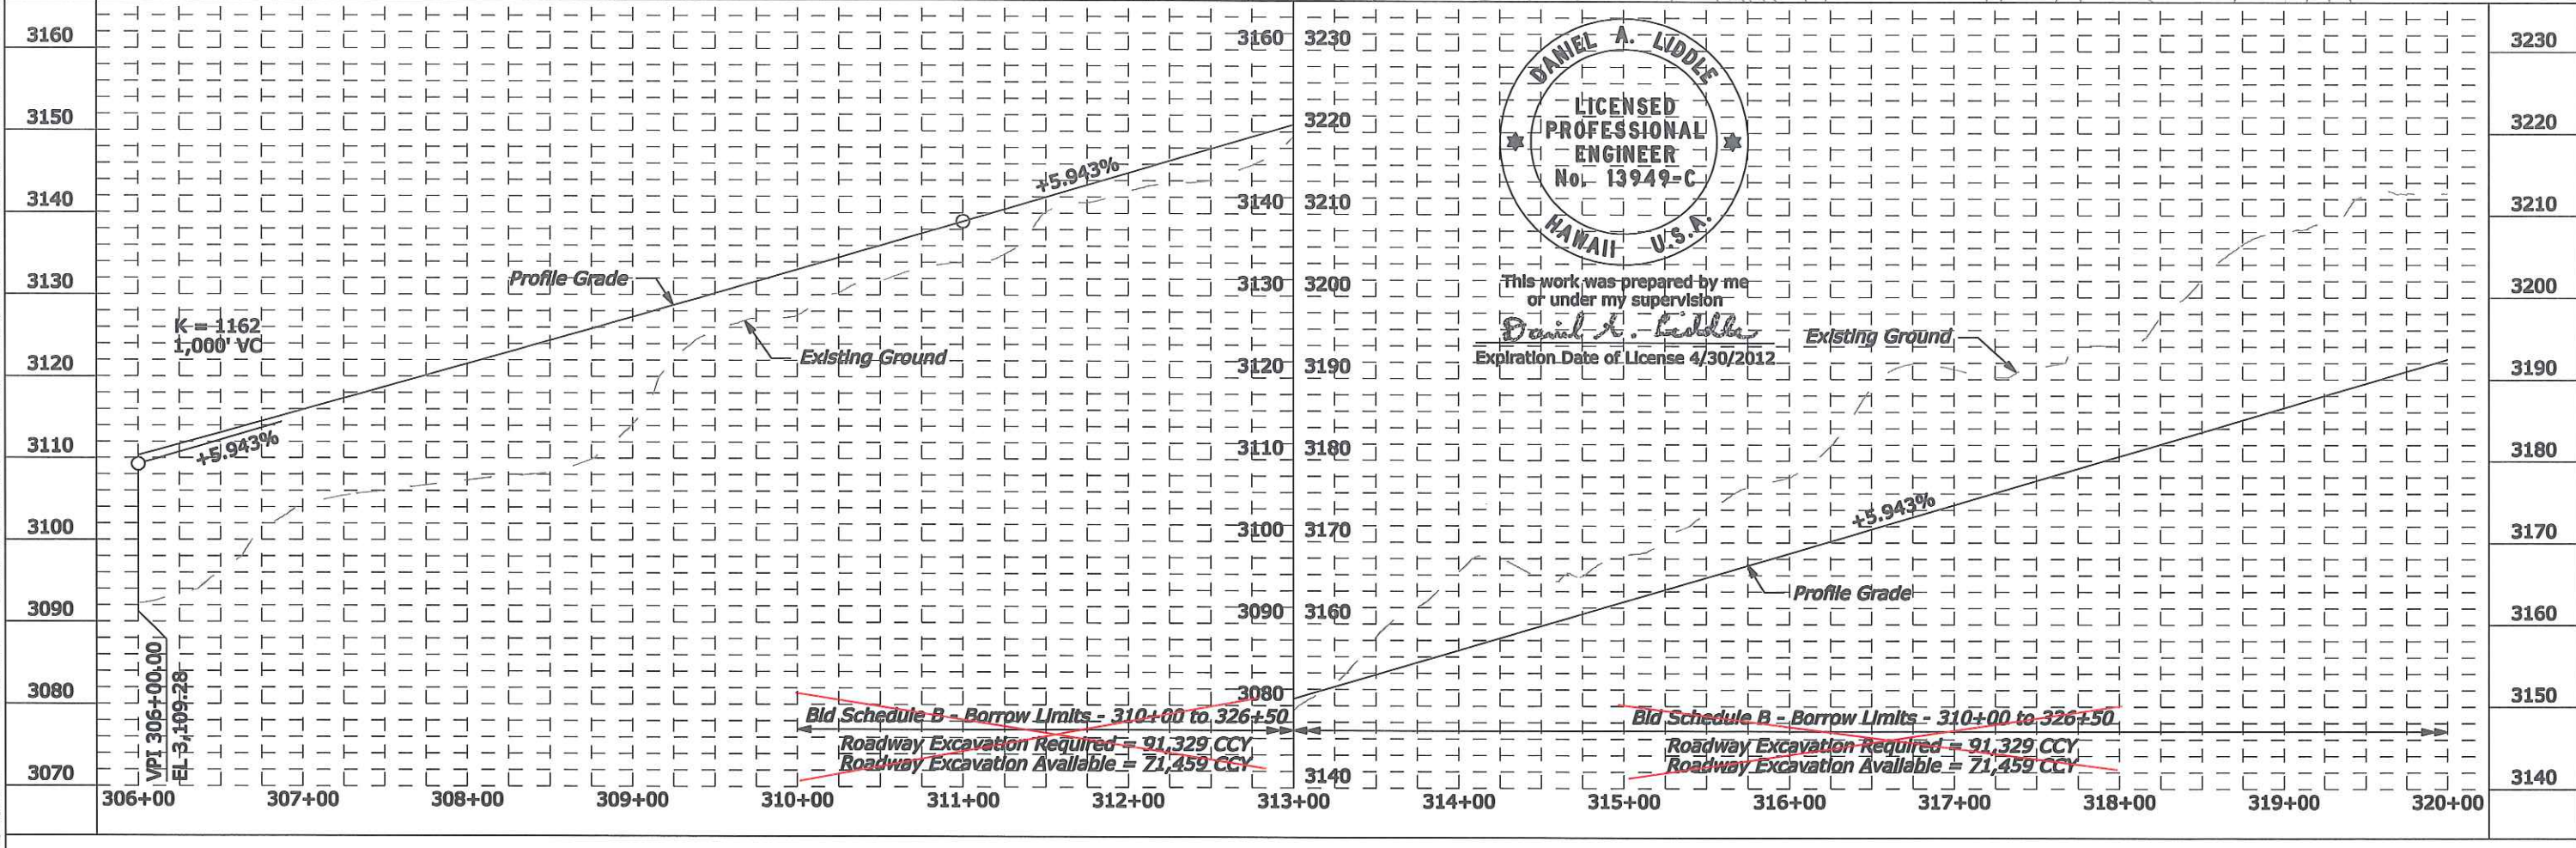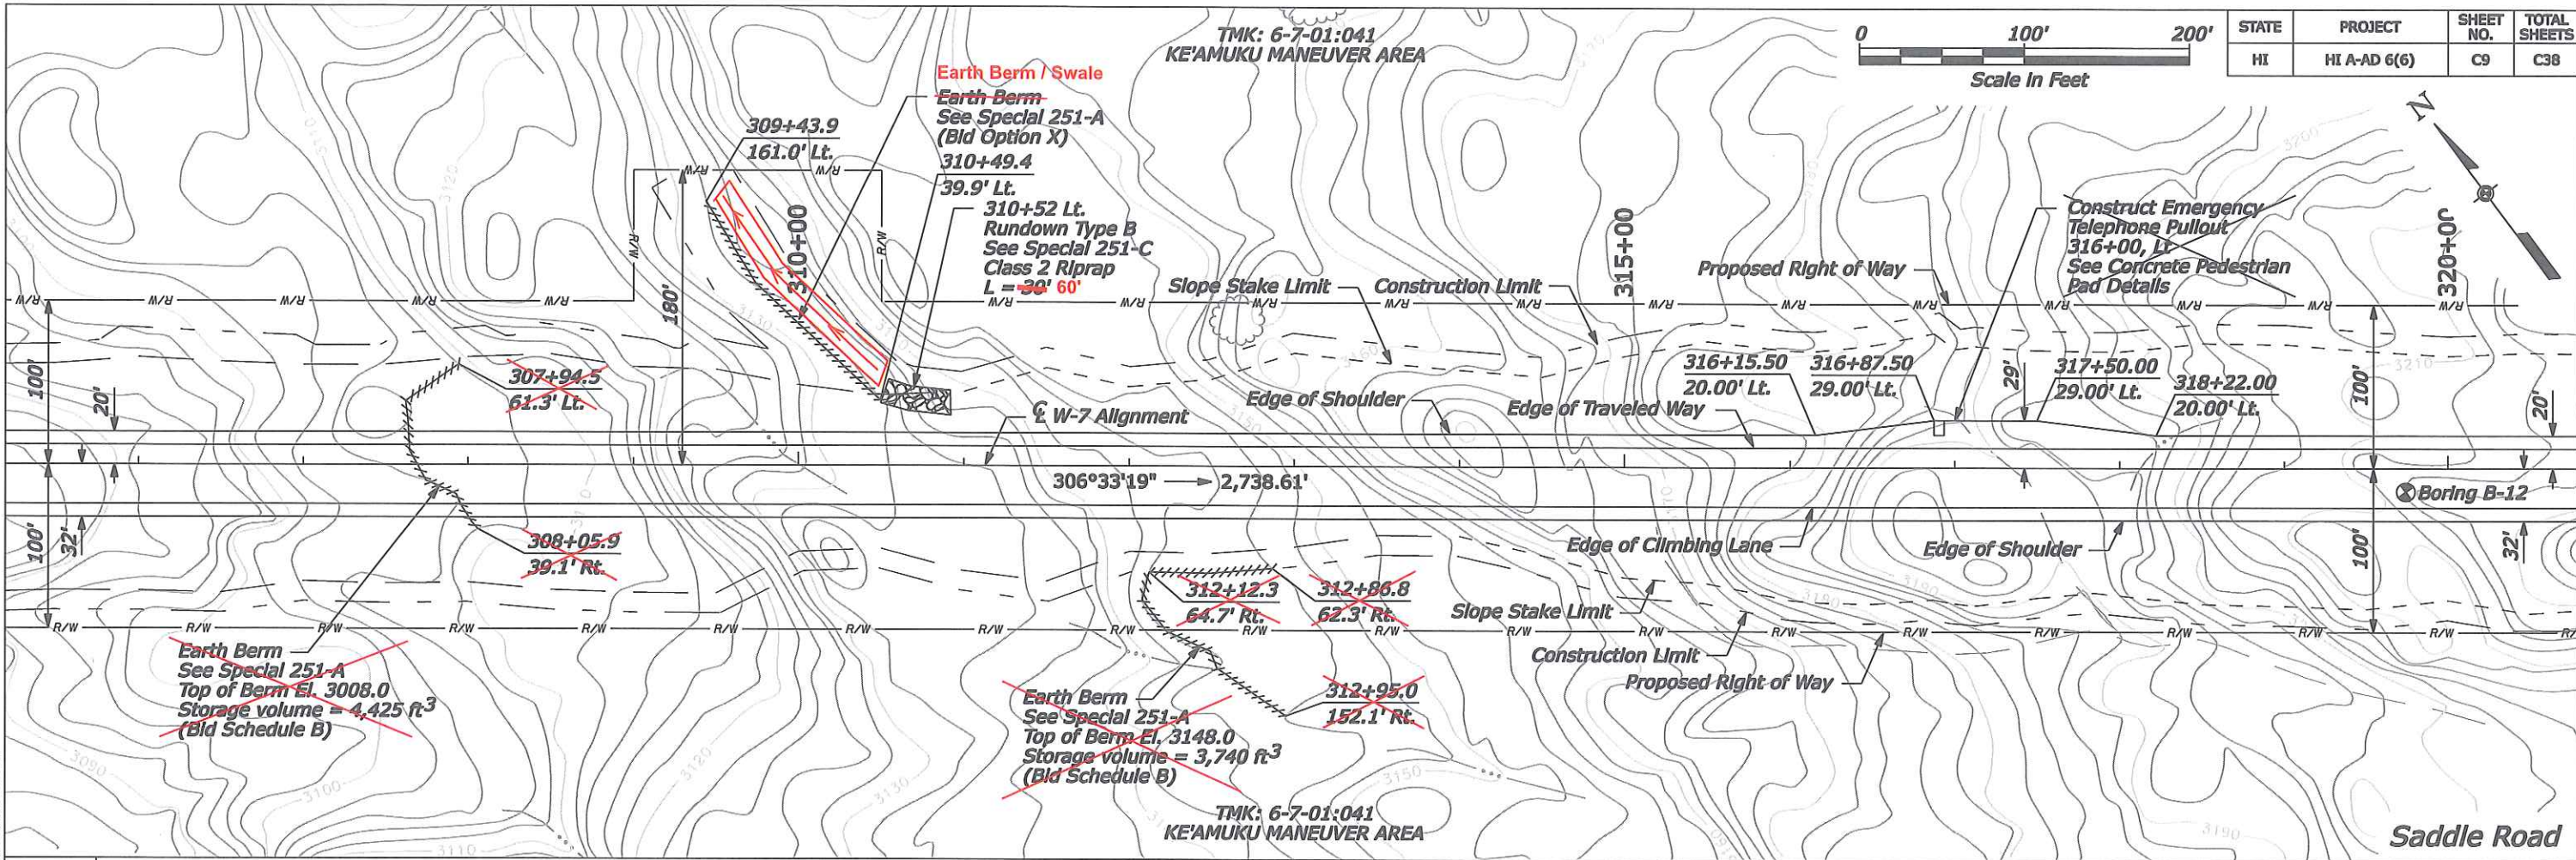




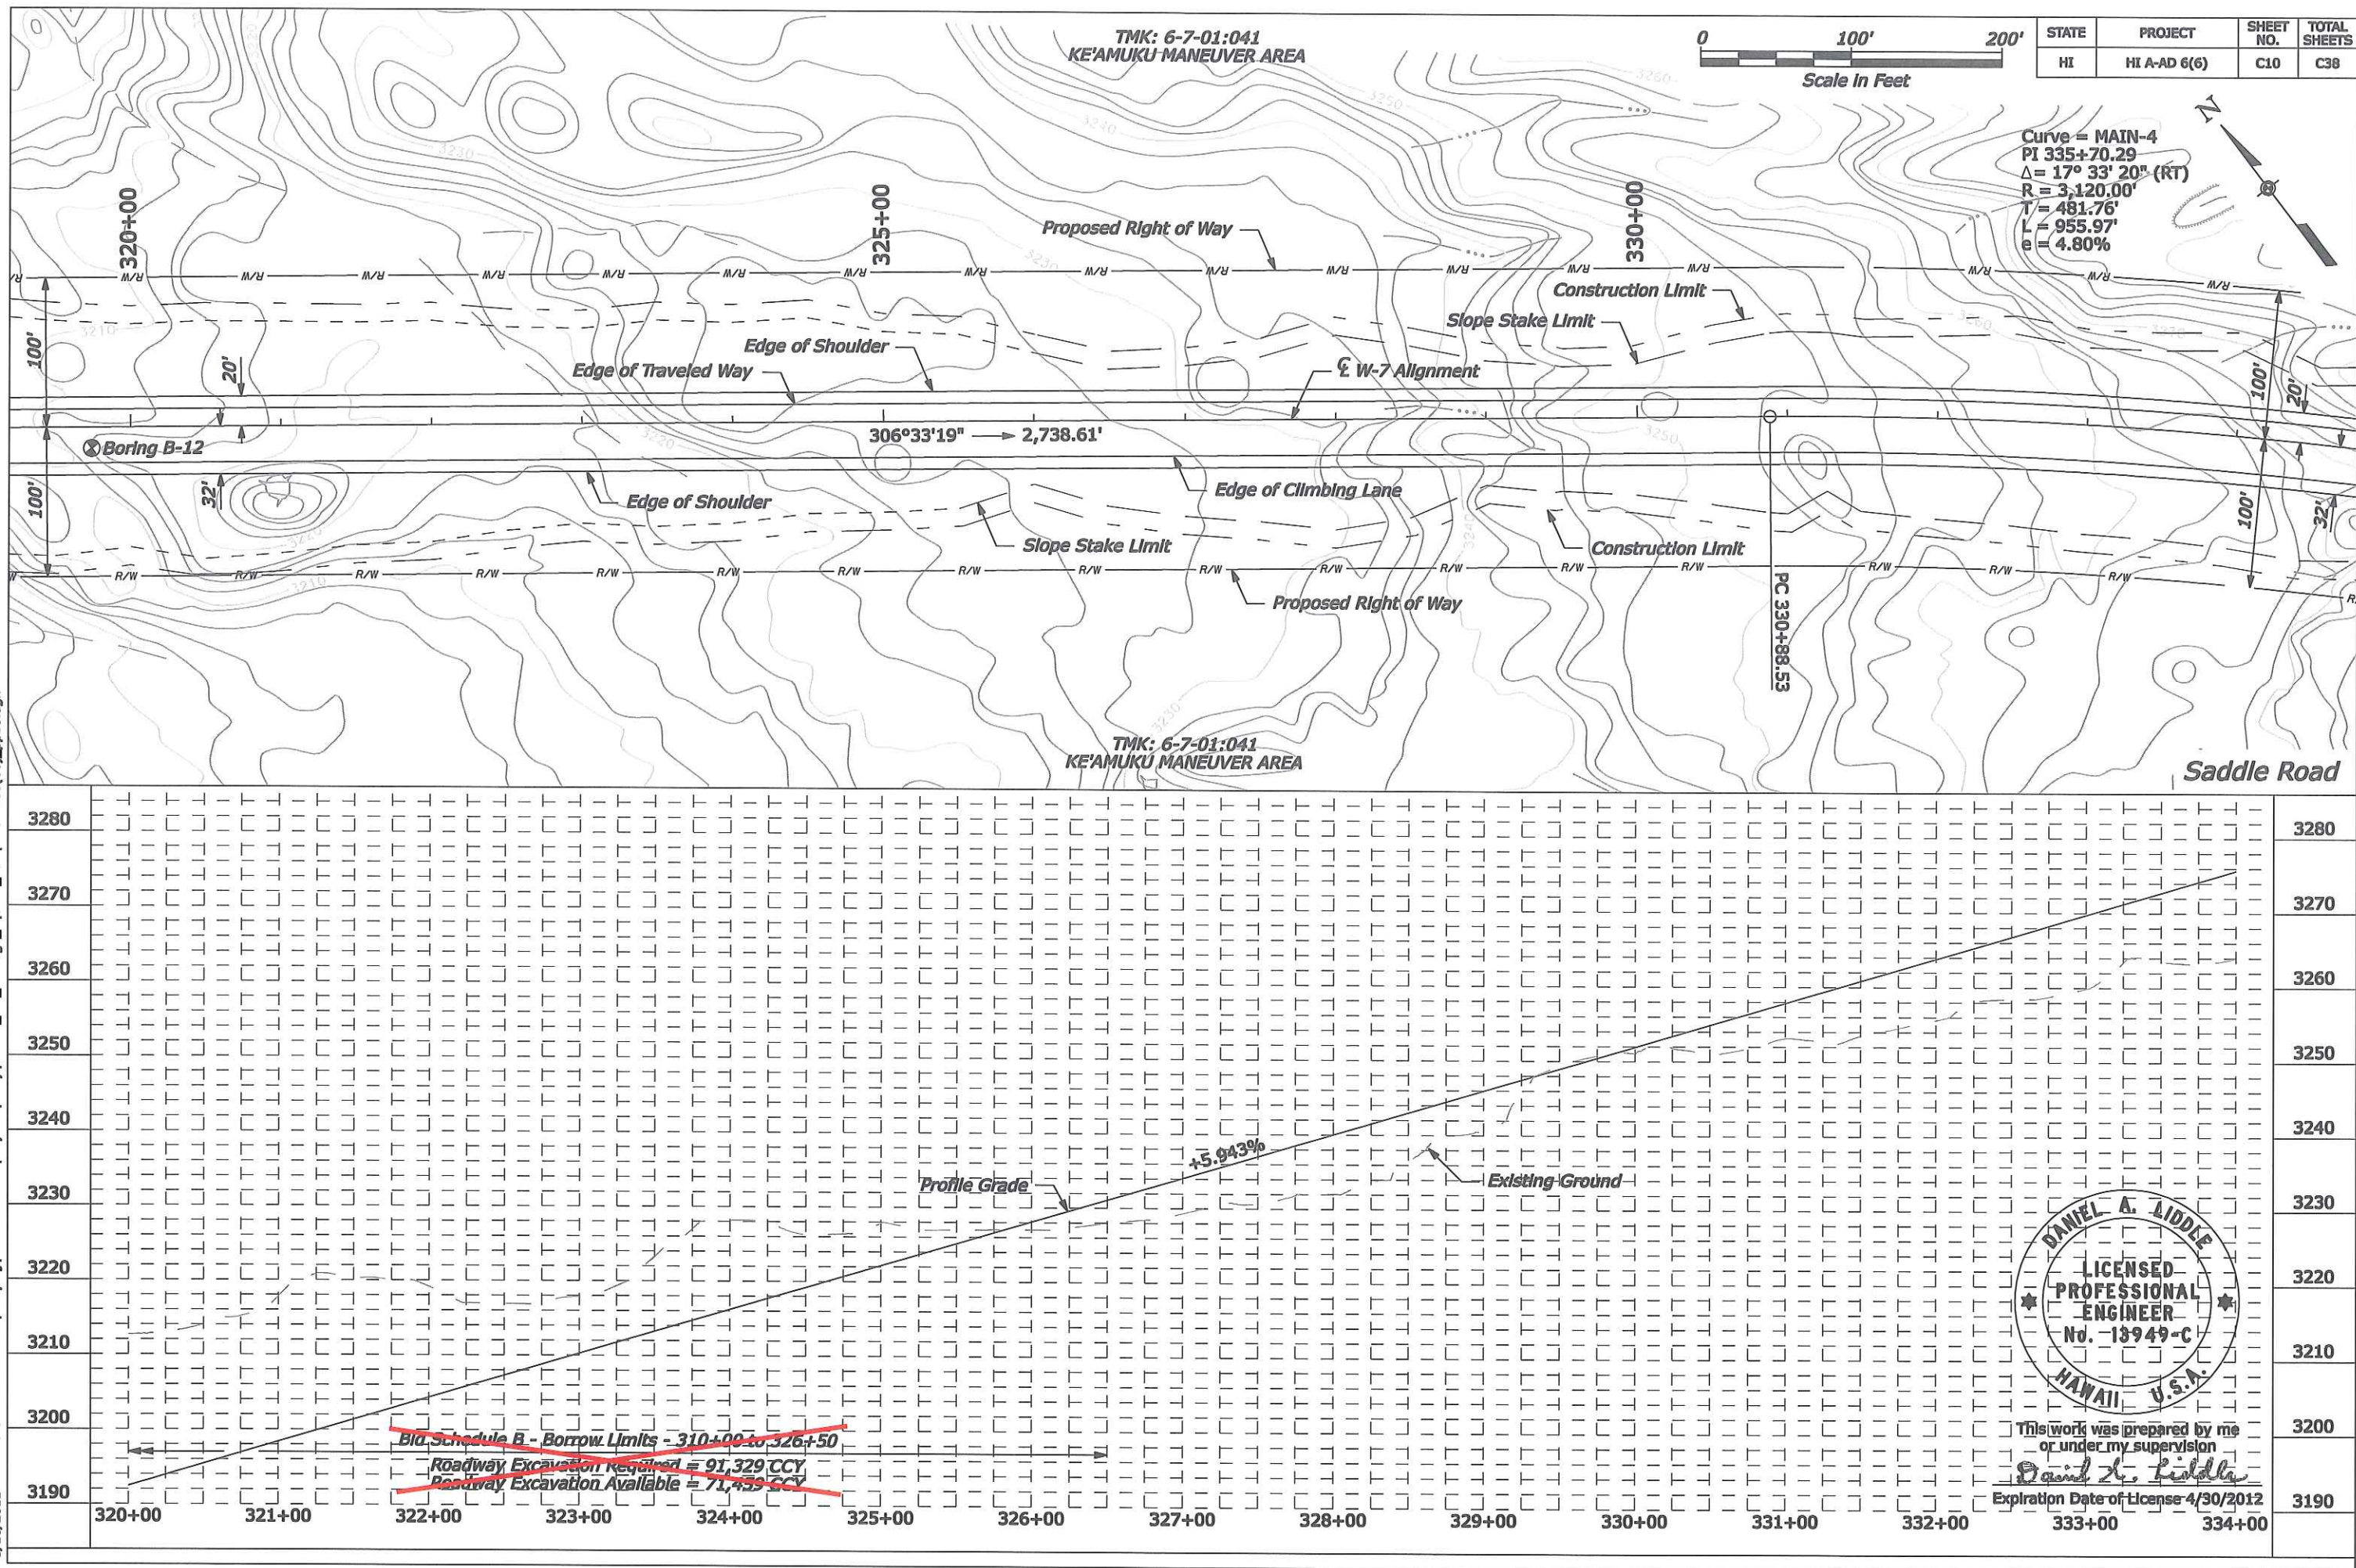




S:\Temp\proj\100013746-SR\HWDes\Draws\Sheets\_Bld\_Package\_1\1C-MIL\_P&P\HW SR 200(00)\_pp11.dgn 5/16/2011 6:59:22 AM

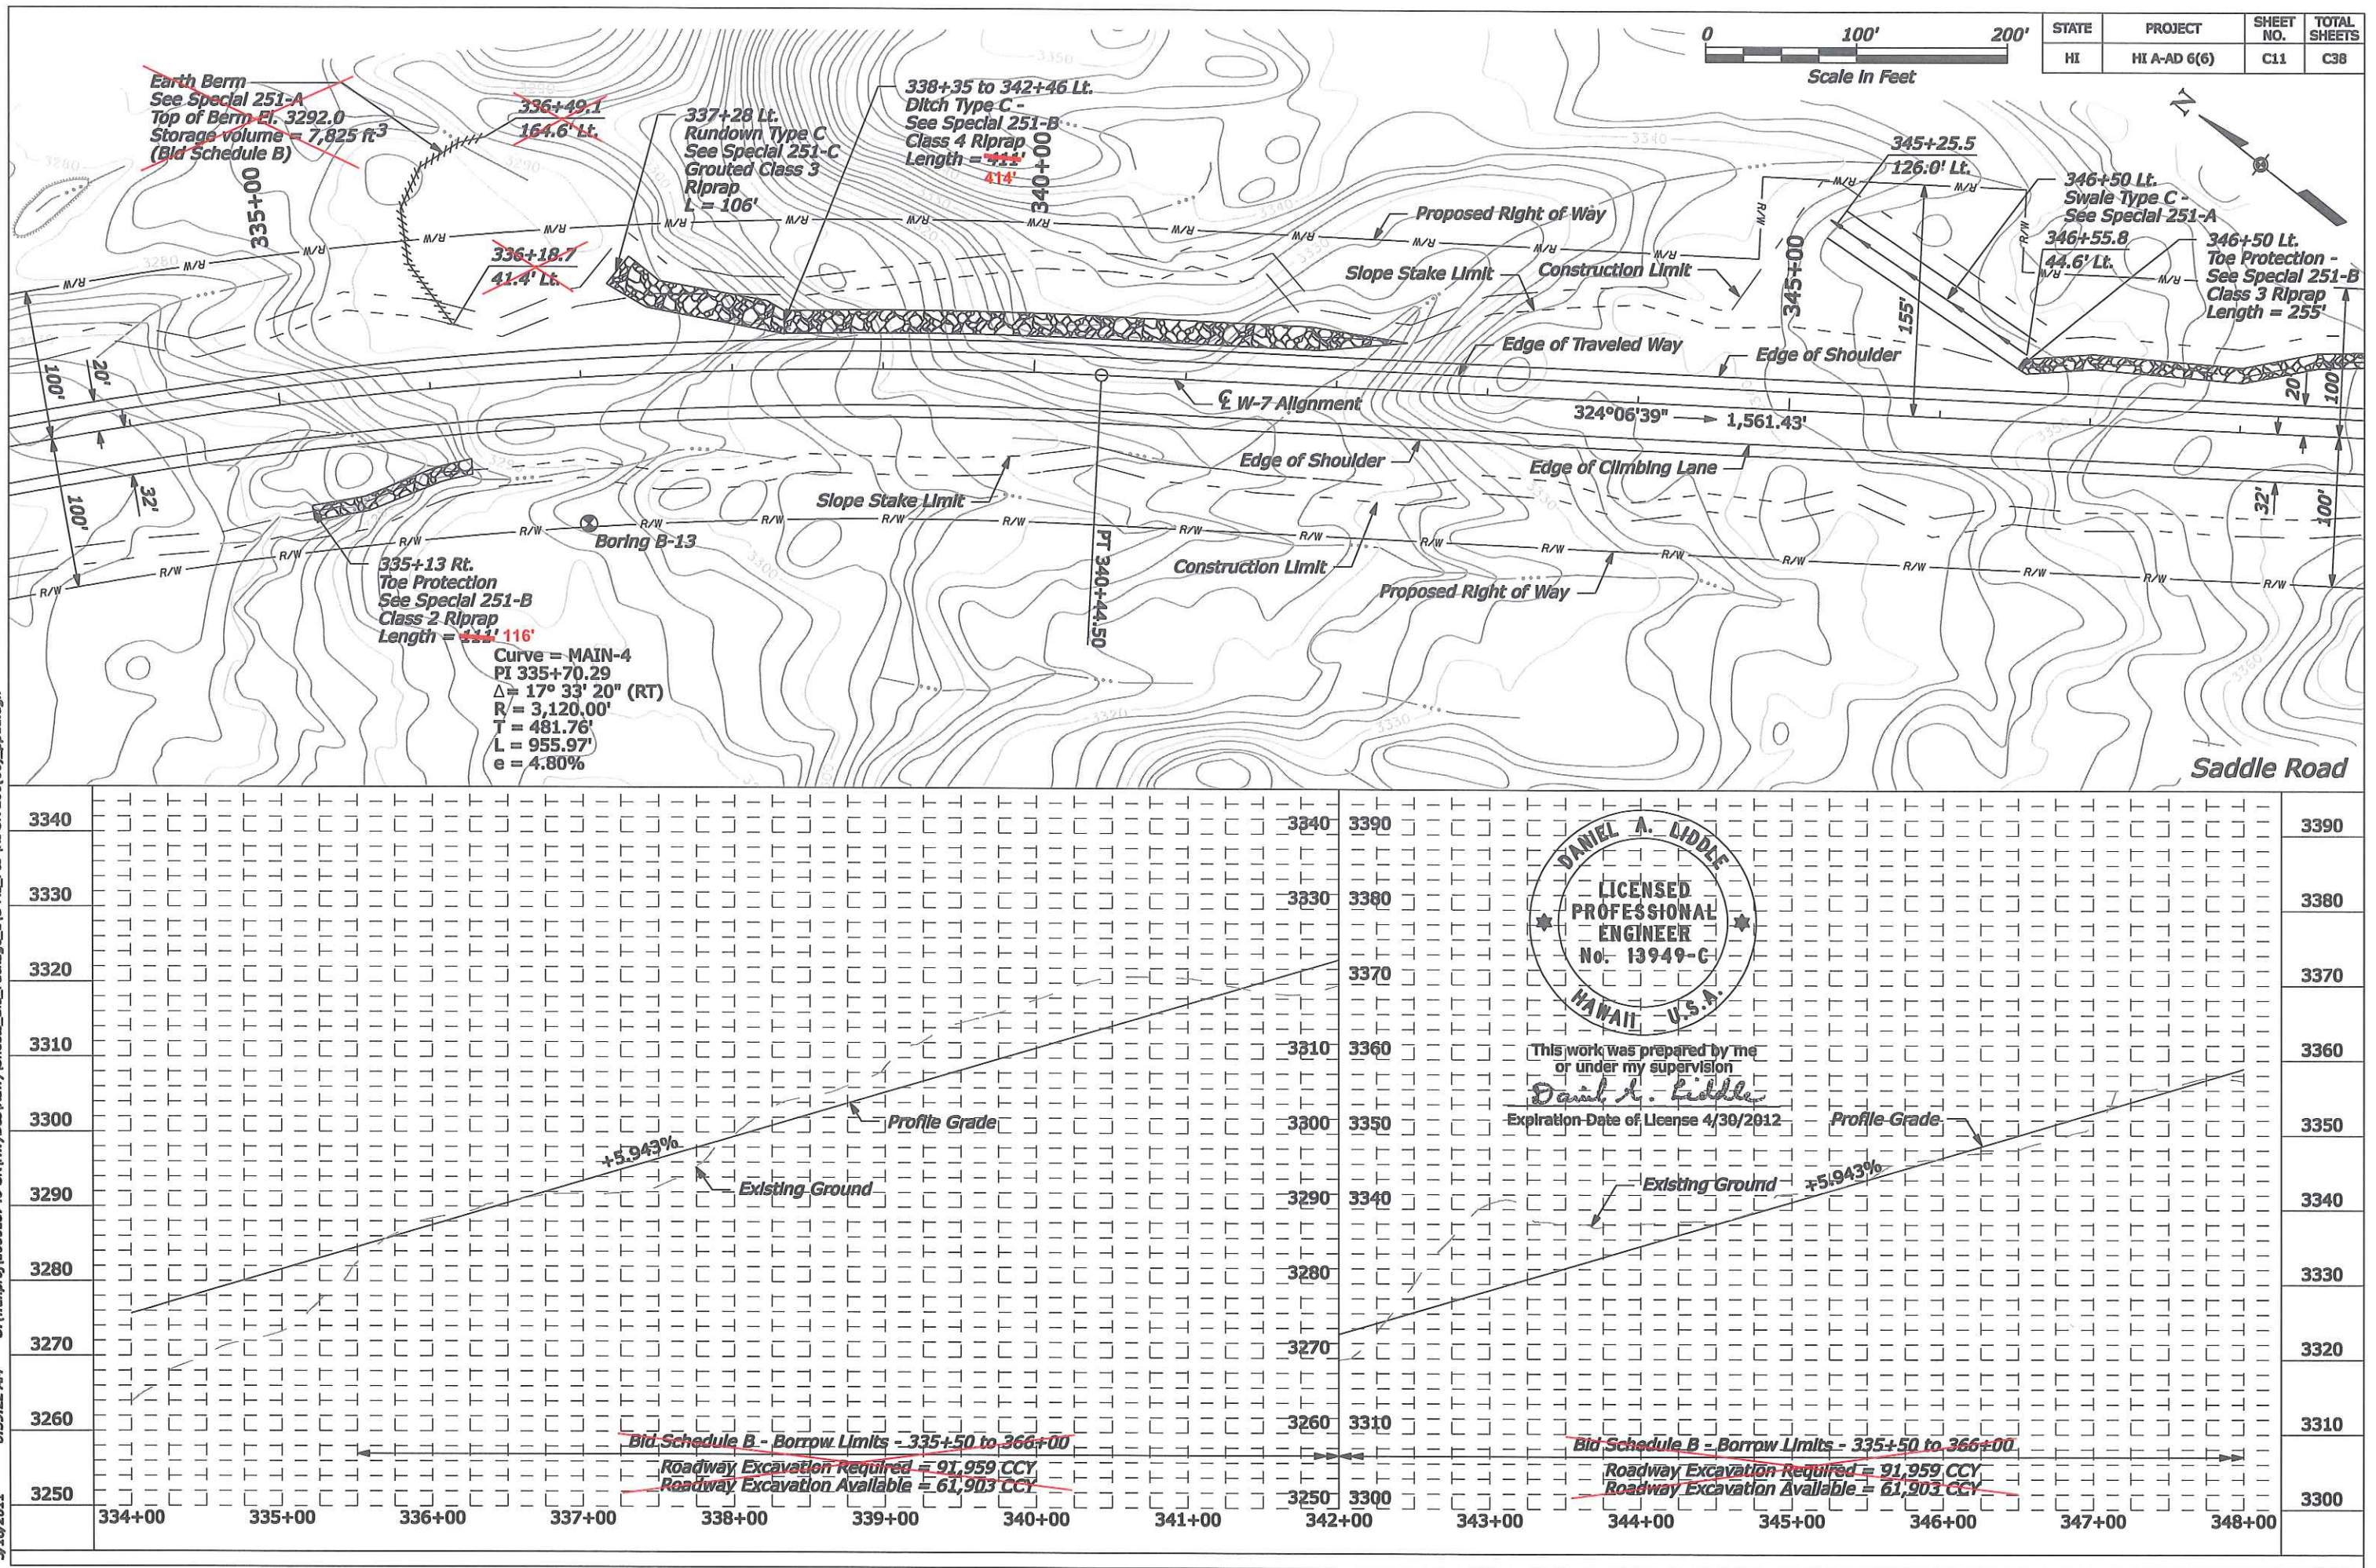








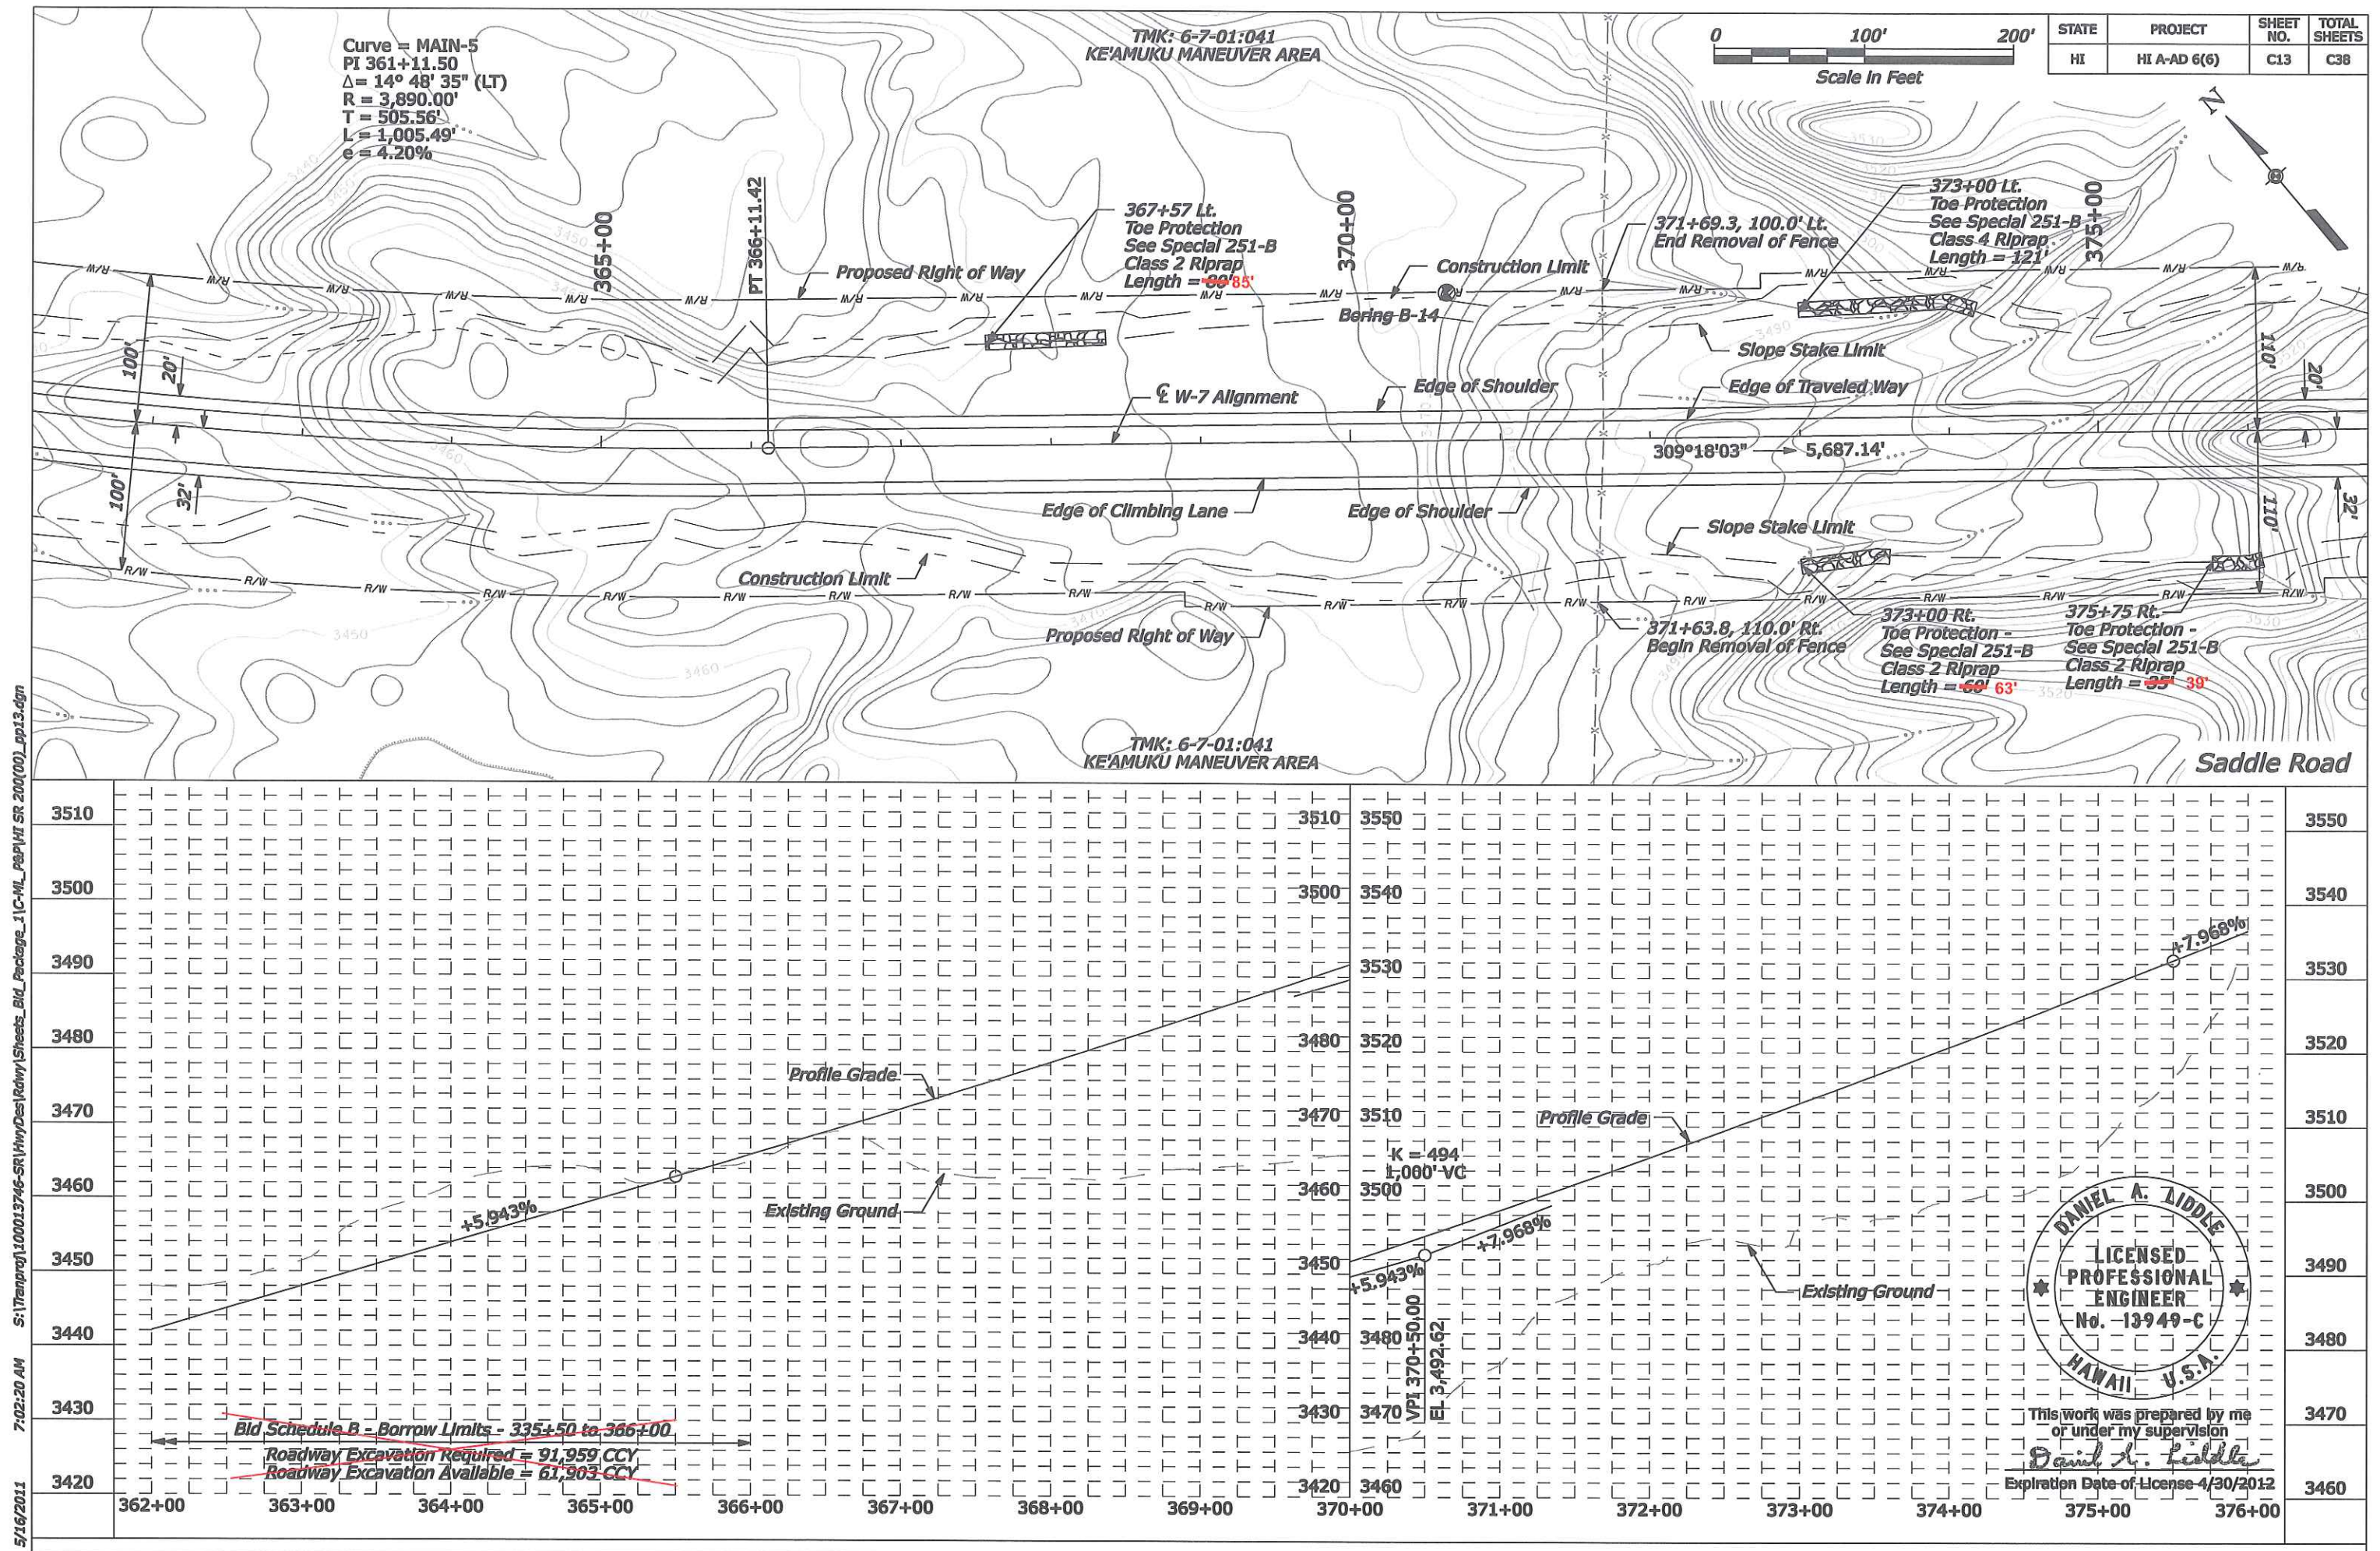




5/16/2011 7:07:36 AM S:\Temp\proj\100013746-SR\MyDes\Railway\Sheets\_Bld\_Package\_1\C-M\_L\_PSP\HI SR 200(00)\_pp14.dgn

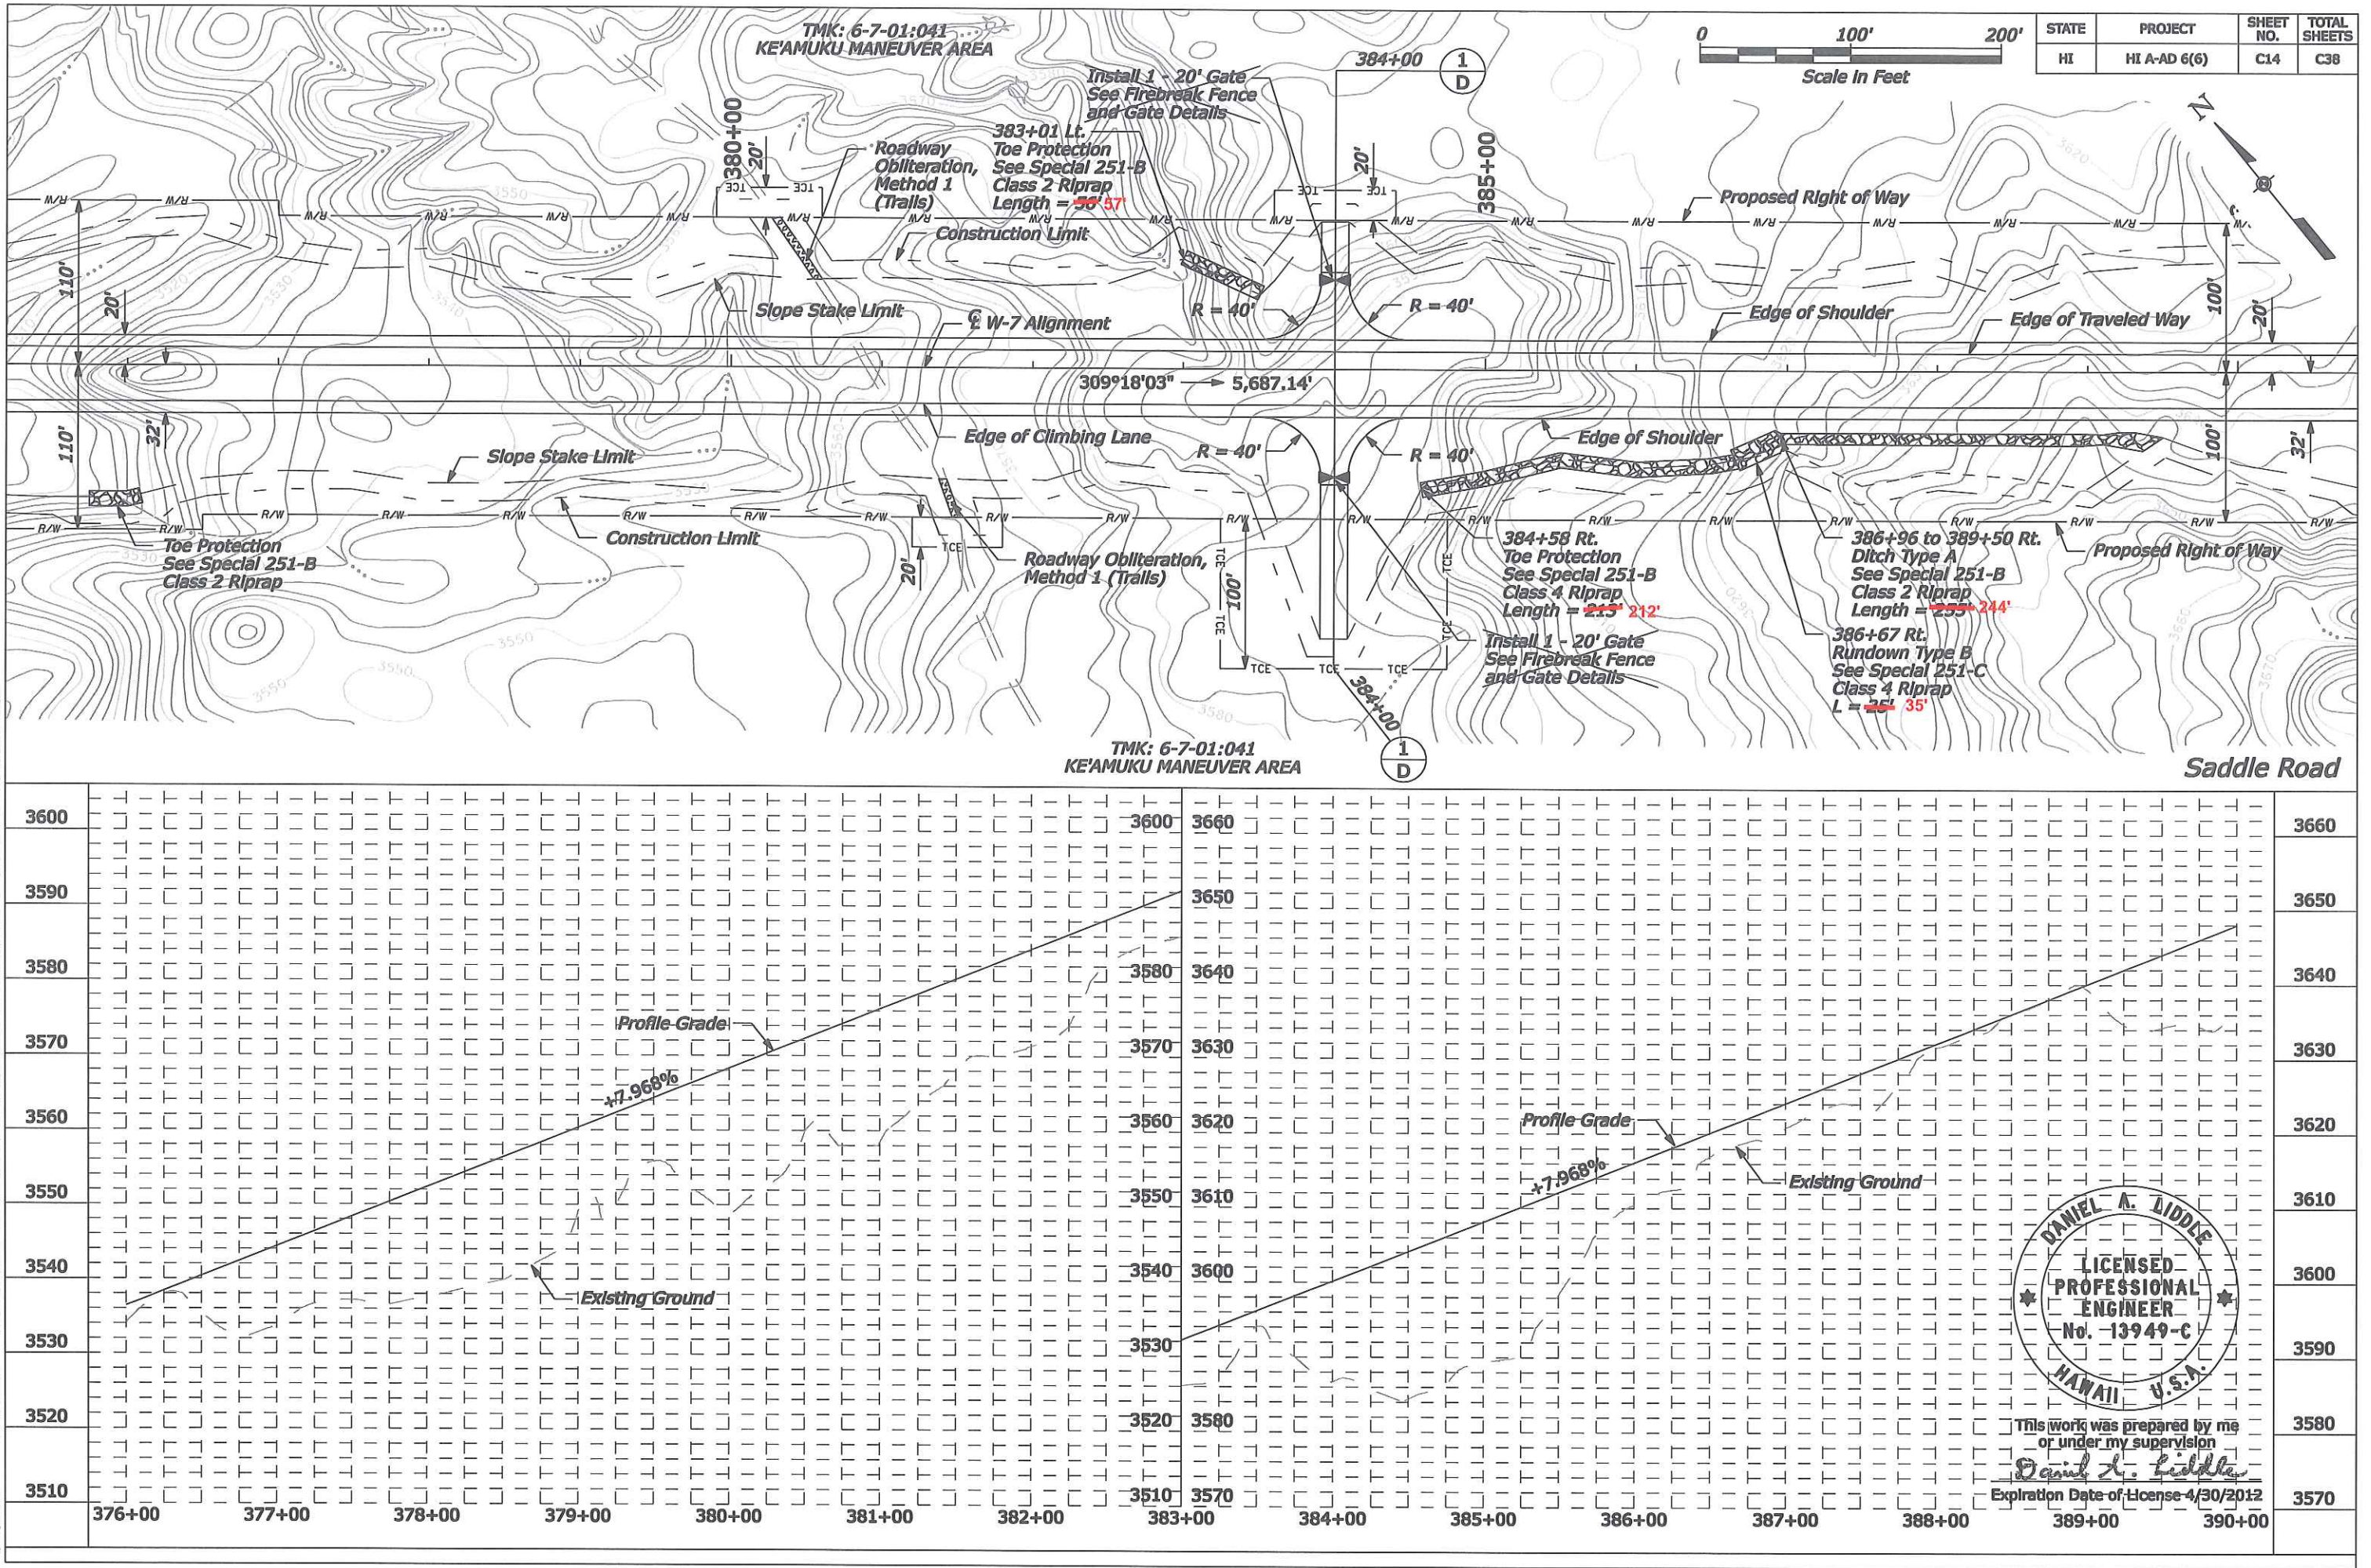



S:\Temp\100013746-SR(HwyDes)\Sheets\_Bld\_Package\_1\C-M-L\_P&P\HI SR 200(00)\_pp15.dgn 5/16/2011 7:11:29 AM

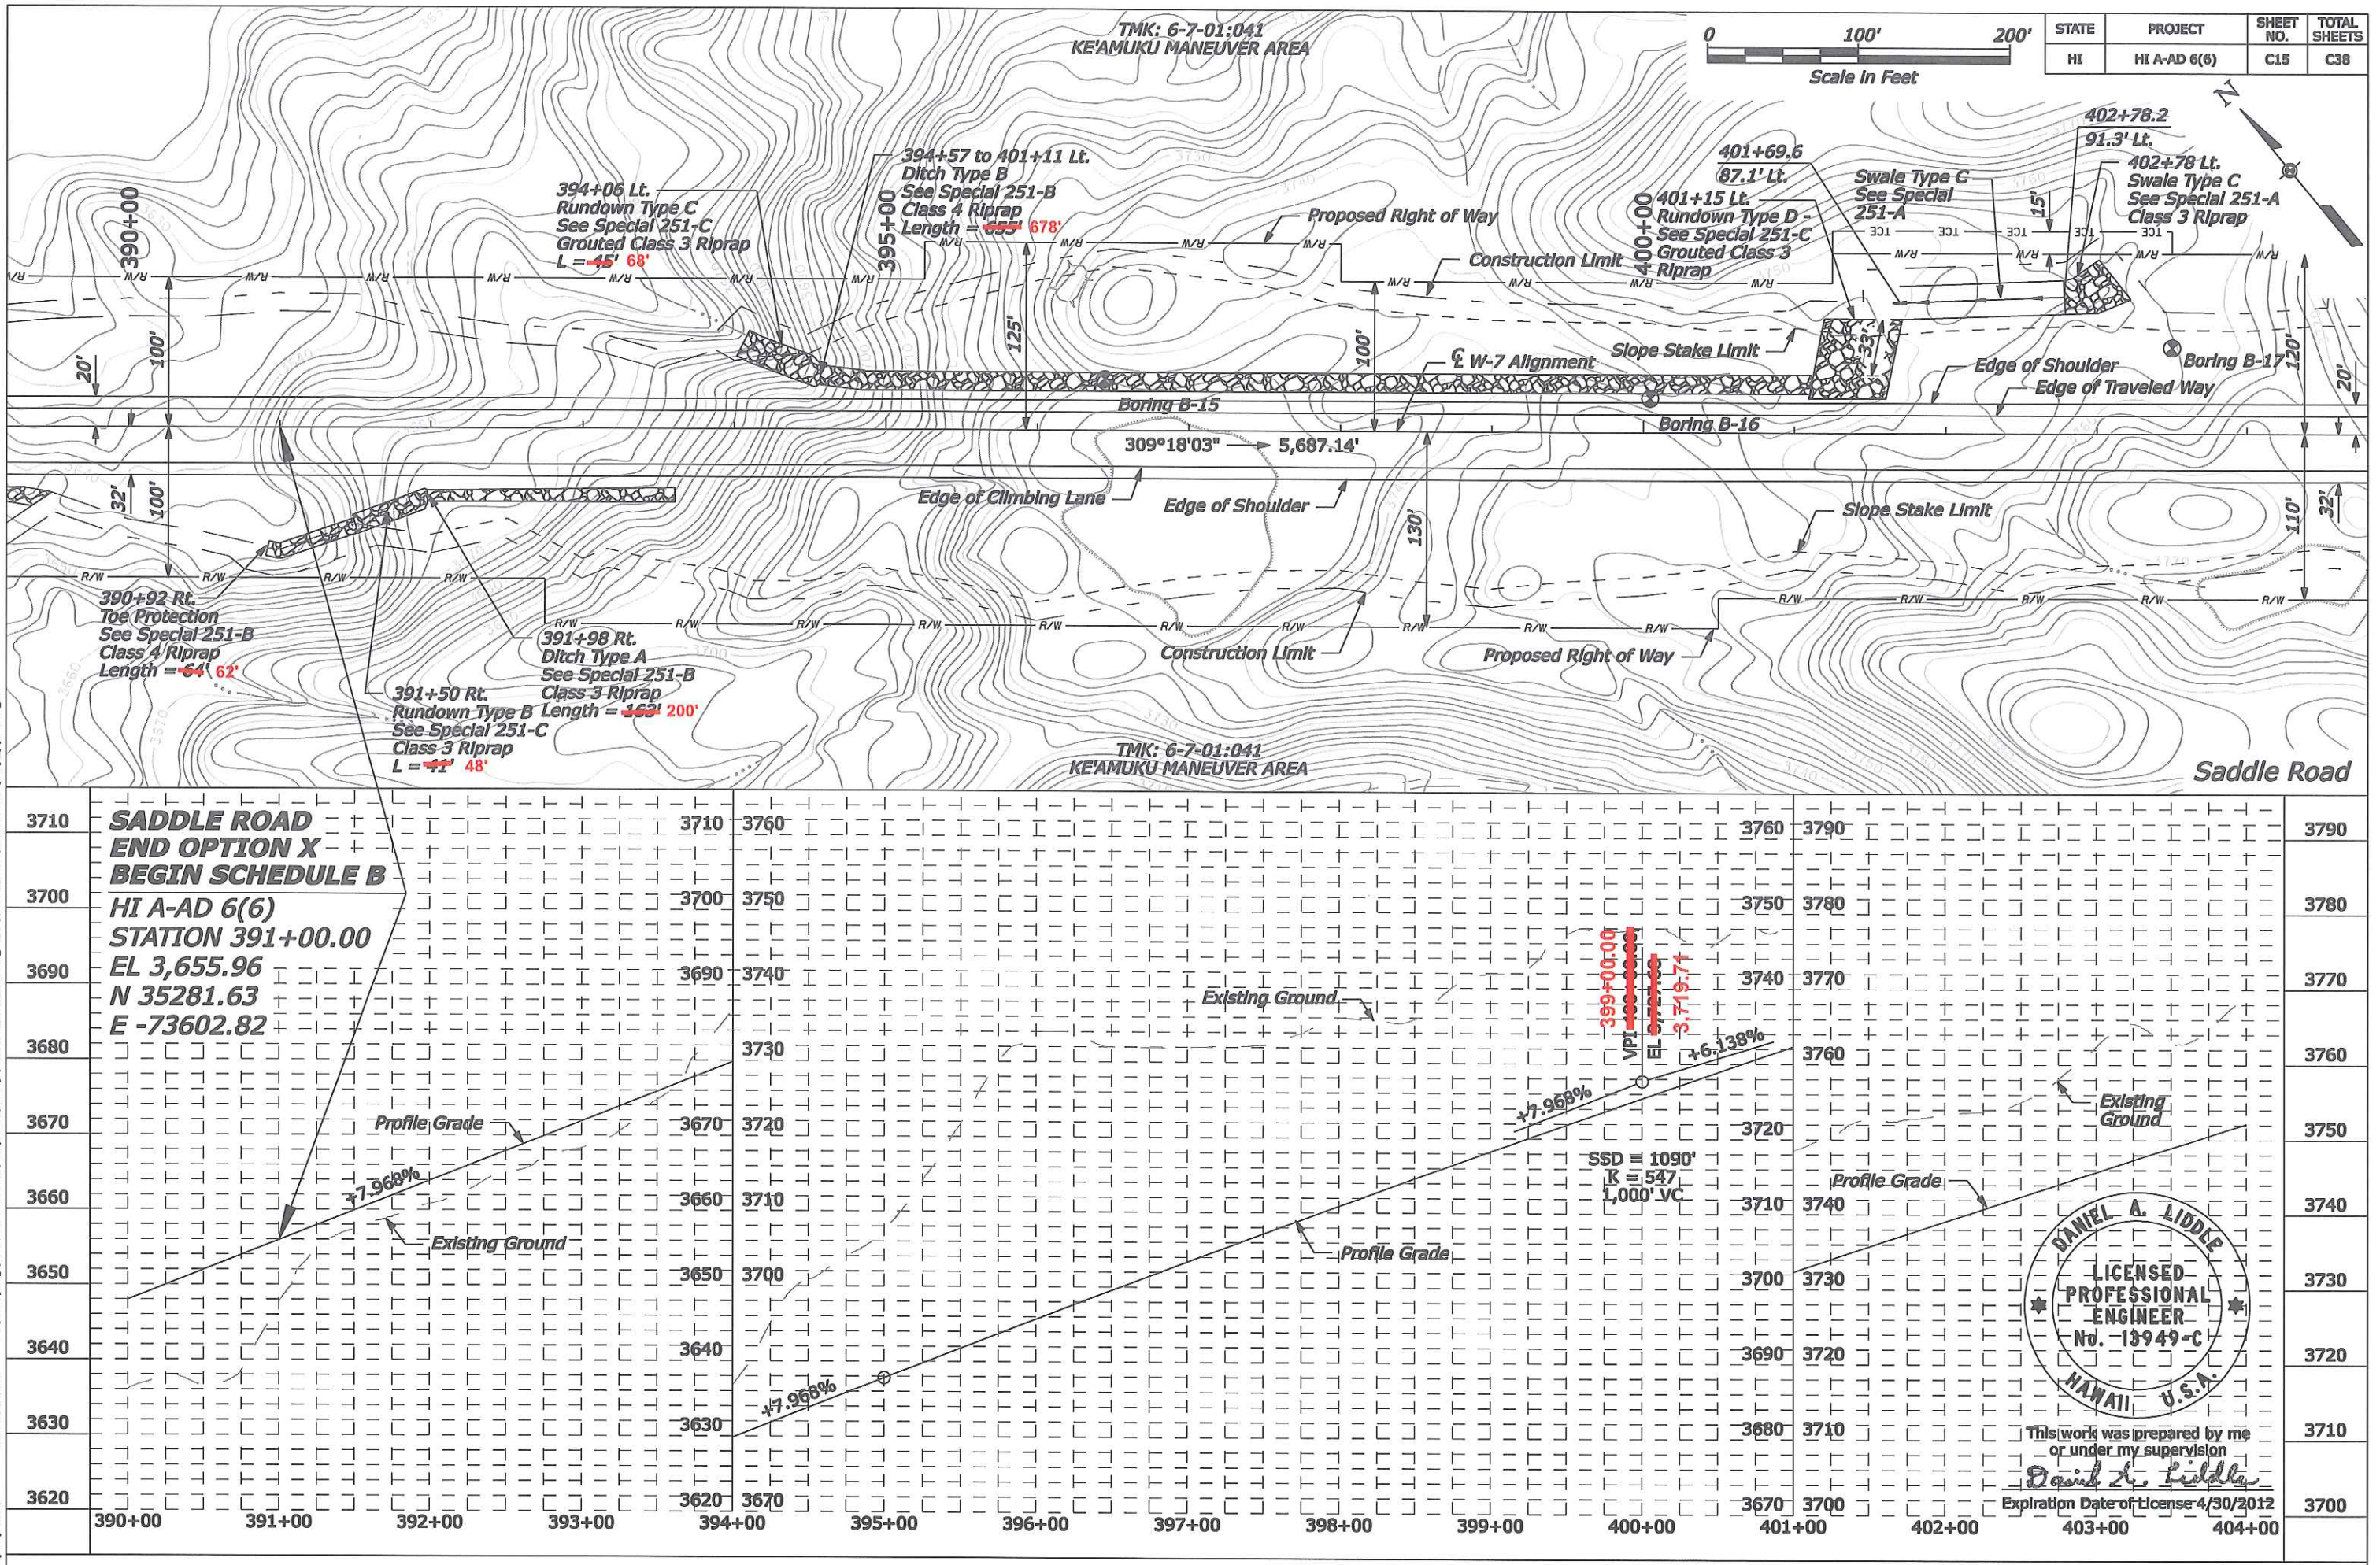













5/16/2011 7:16:25 AM S:\Transport\100013746-SR\HwyDes\Drawings\Sheets\_Bld\_Package\_1\C-ML\_P&P\HI SR 200(00)\_pp18.dgn

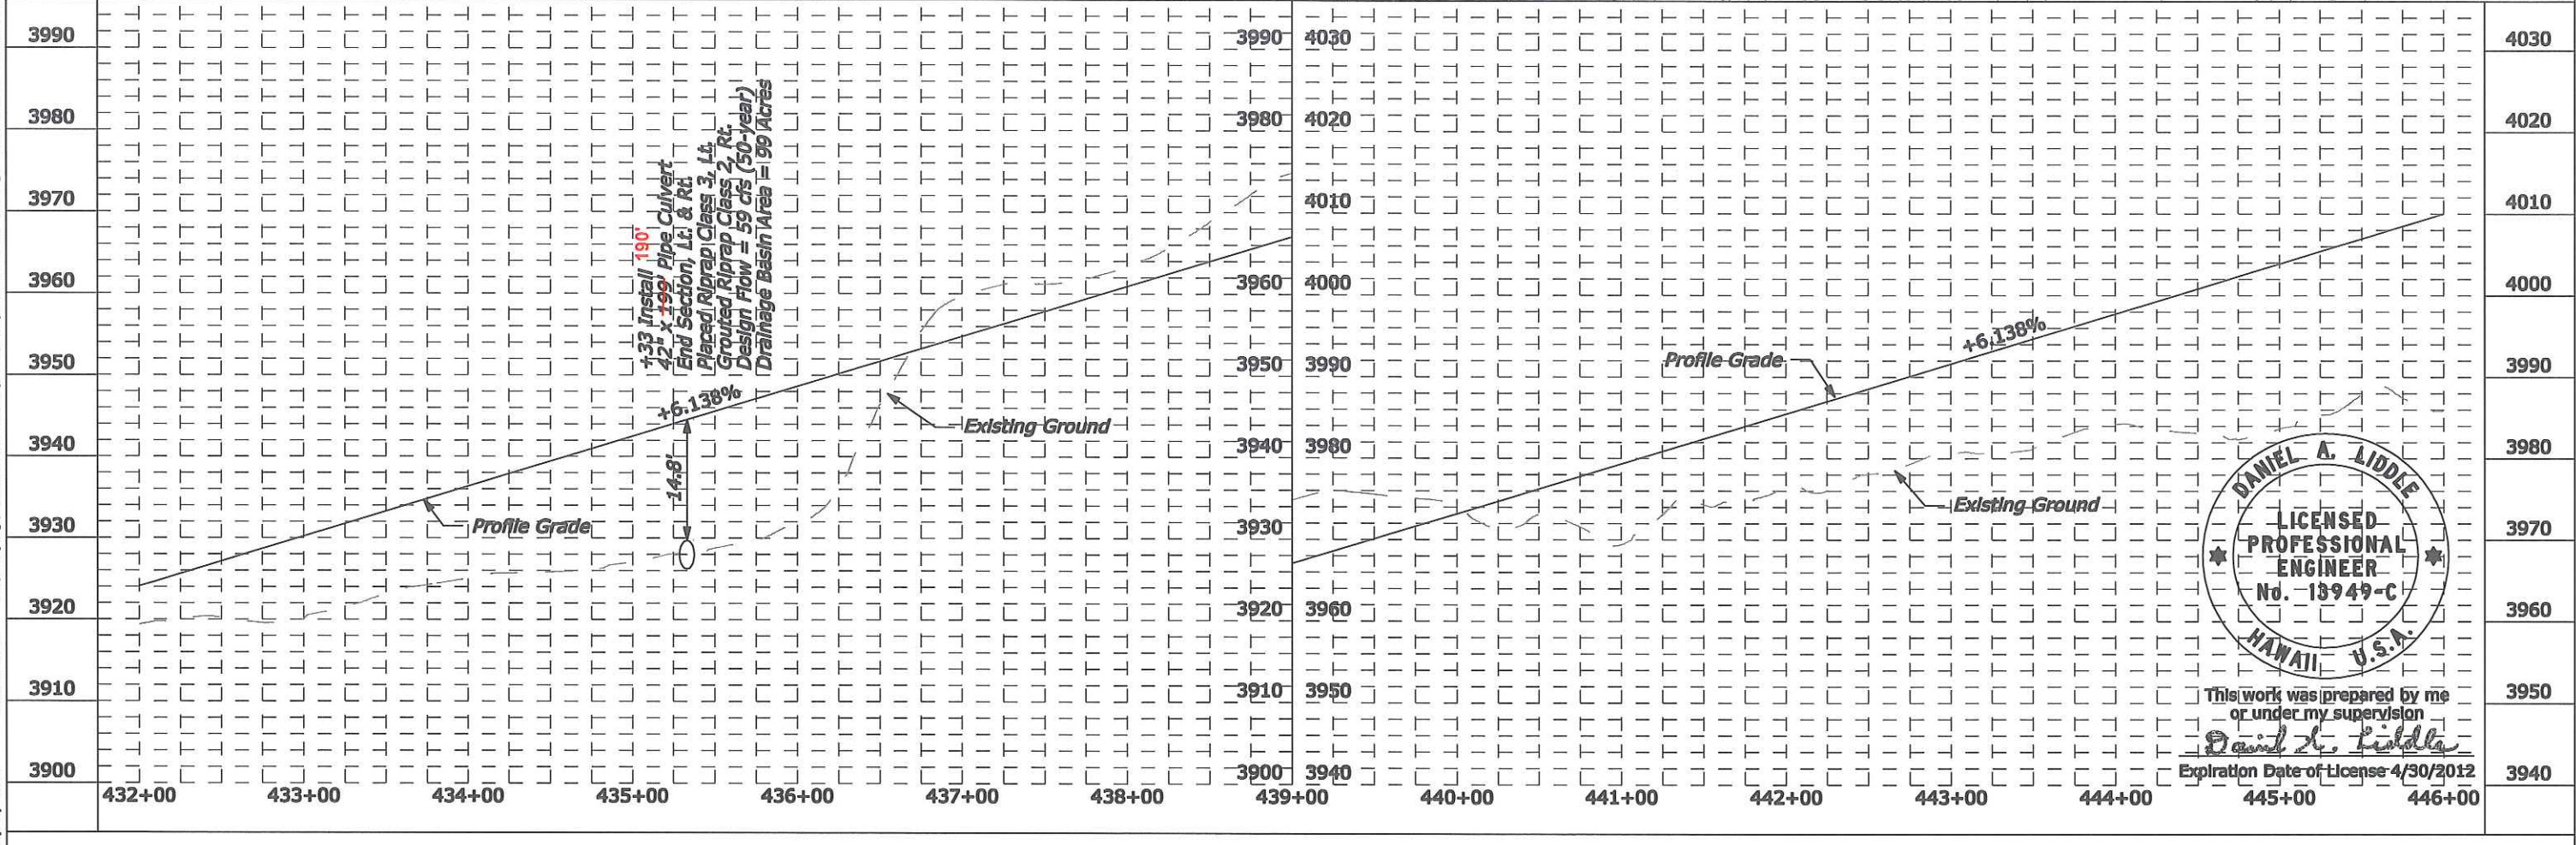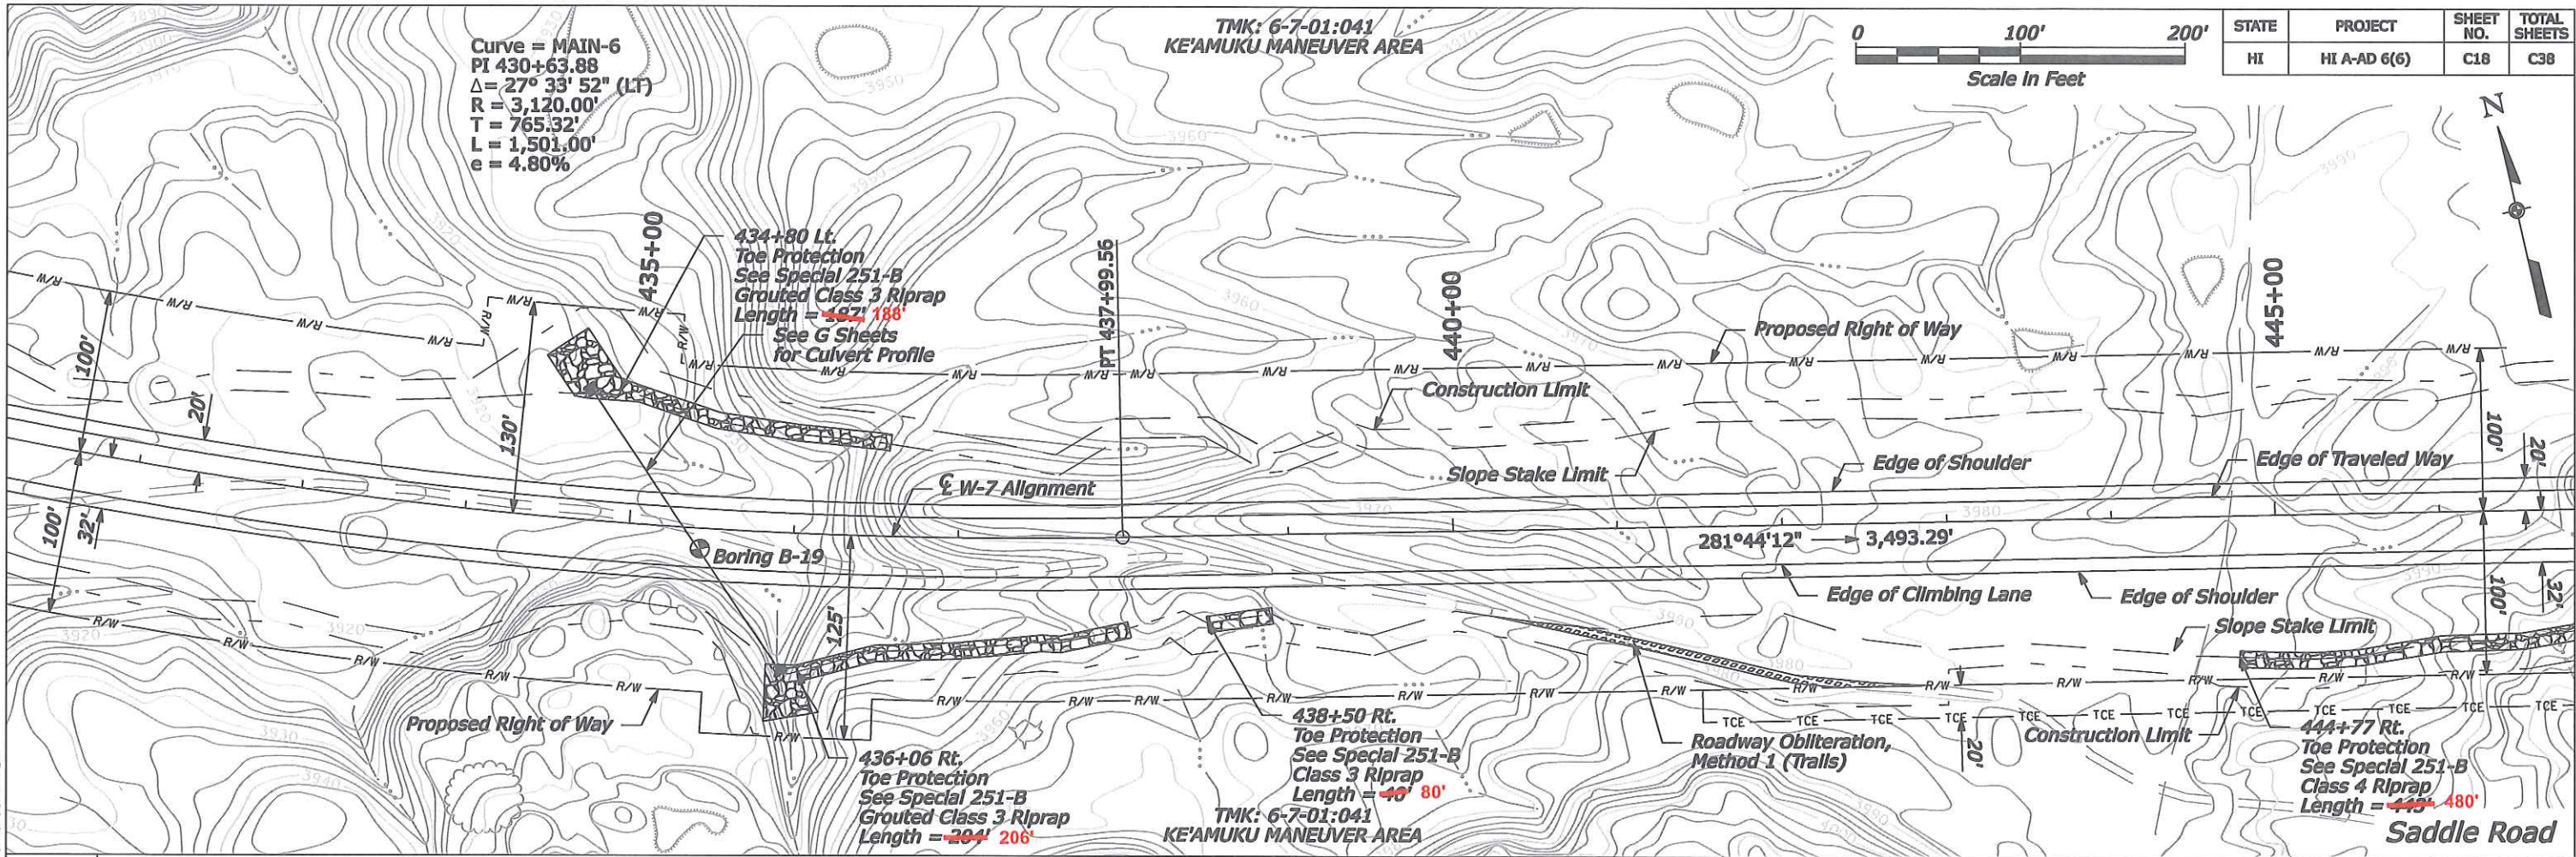









S:\Temp\100013746-SR\HwyDes\Drawings\Sheets\_Bld\_Package\_1\1C-MW\_P&P\HI SR 200(00)\_pp20.dgn 5/16/2011 7:21:43 AM

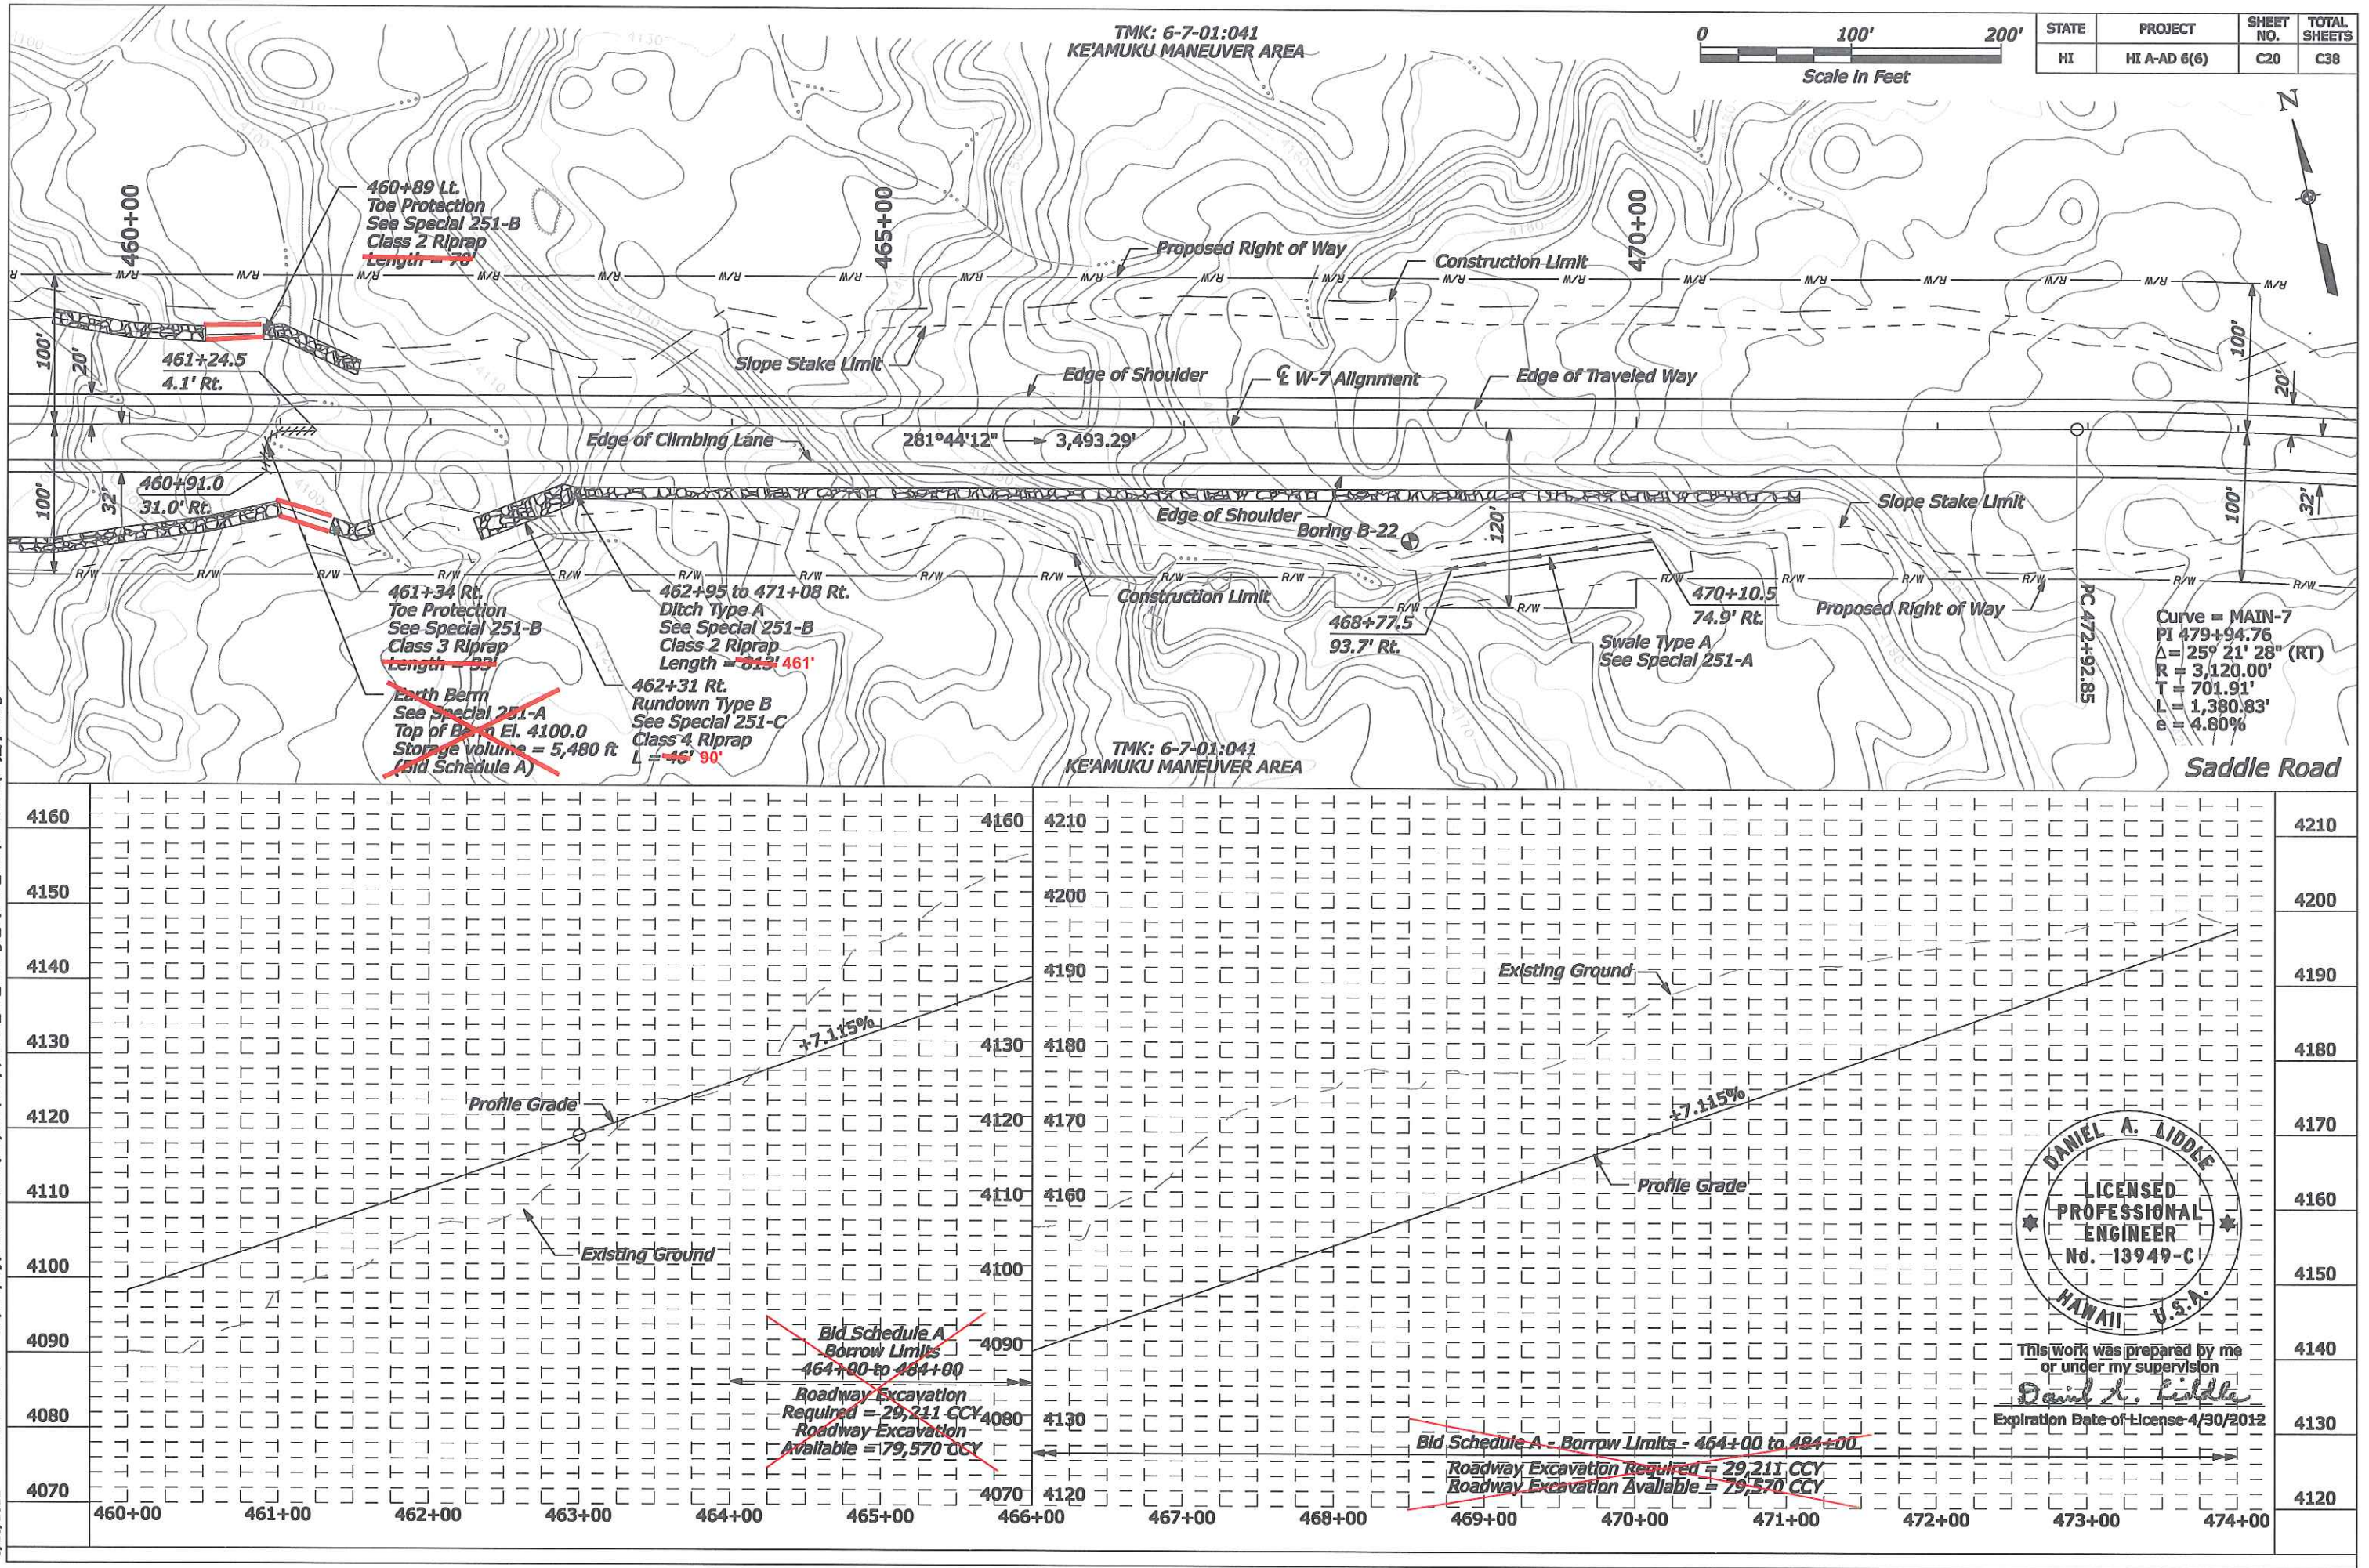




5/16/2011 7:23:50 AM S:\Temp\proj\100013746-SR\MyDes\Raw\Sheets\_Bld\_Package\_1\1C-MIL\_Prop\HI SR 200(00)\_pp21.dgn

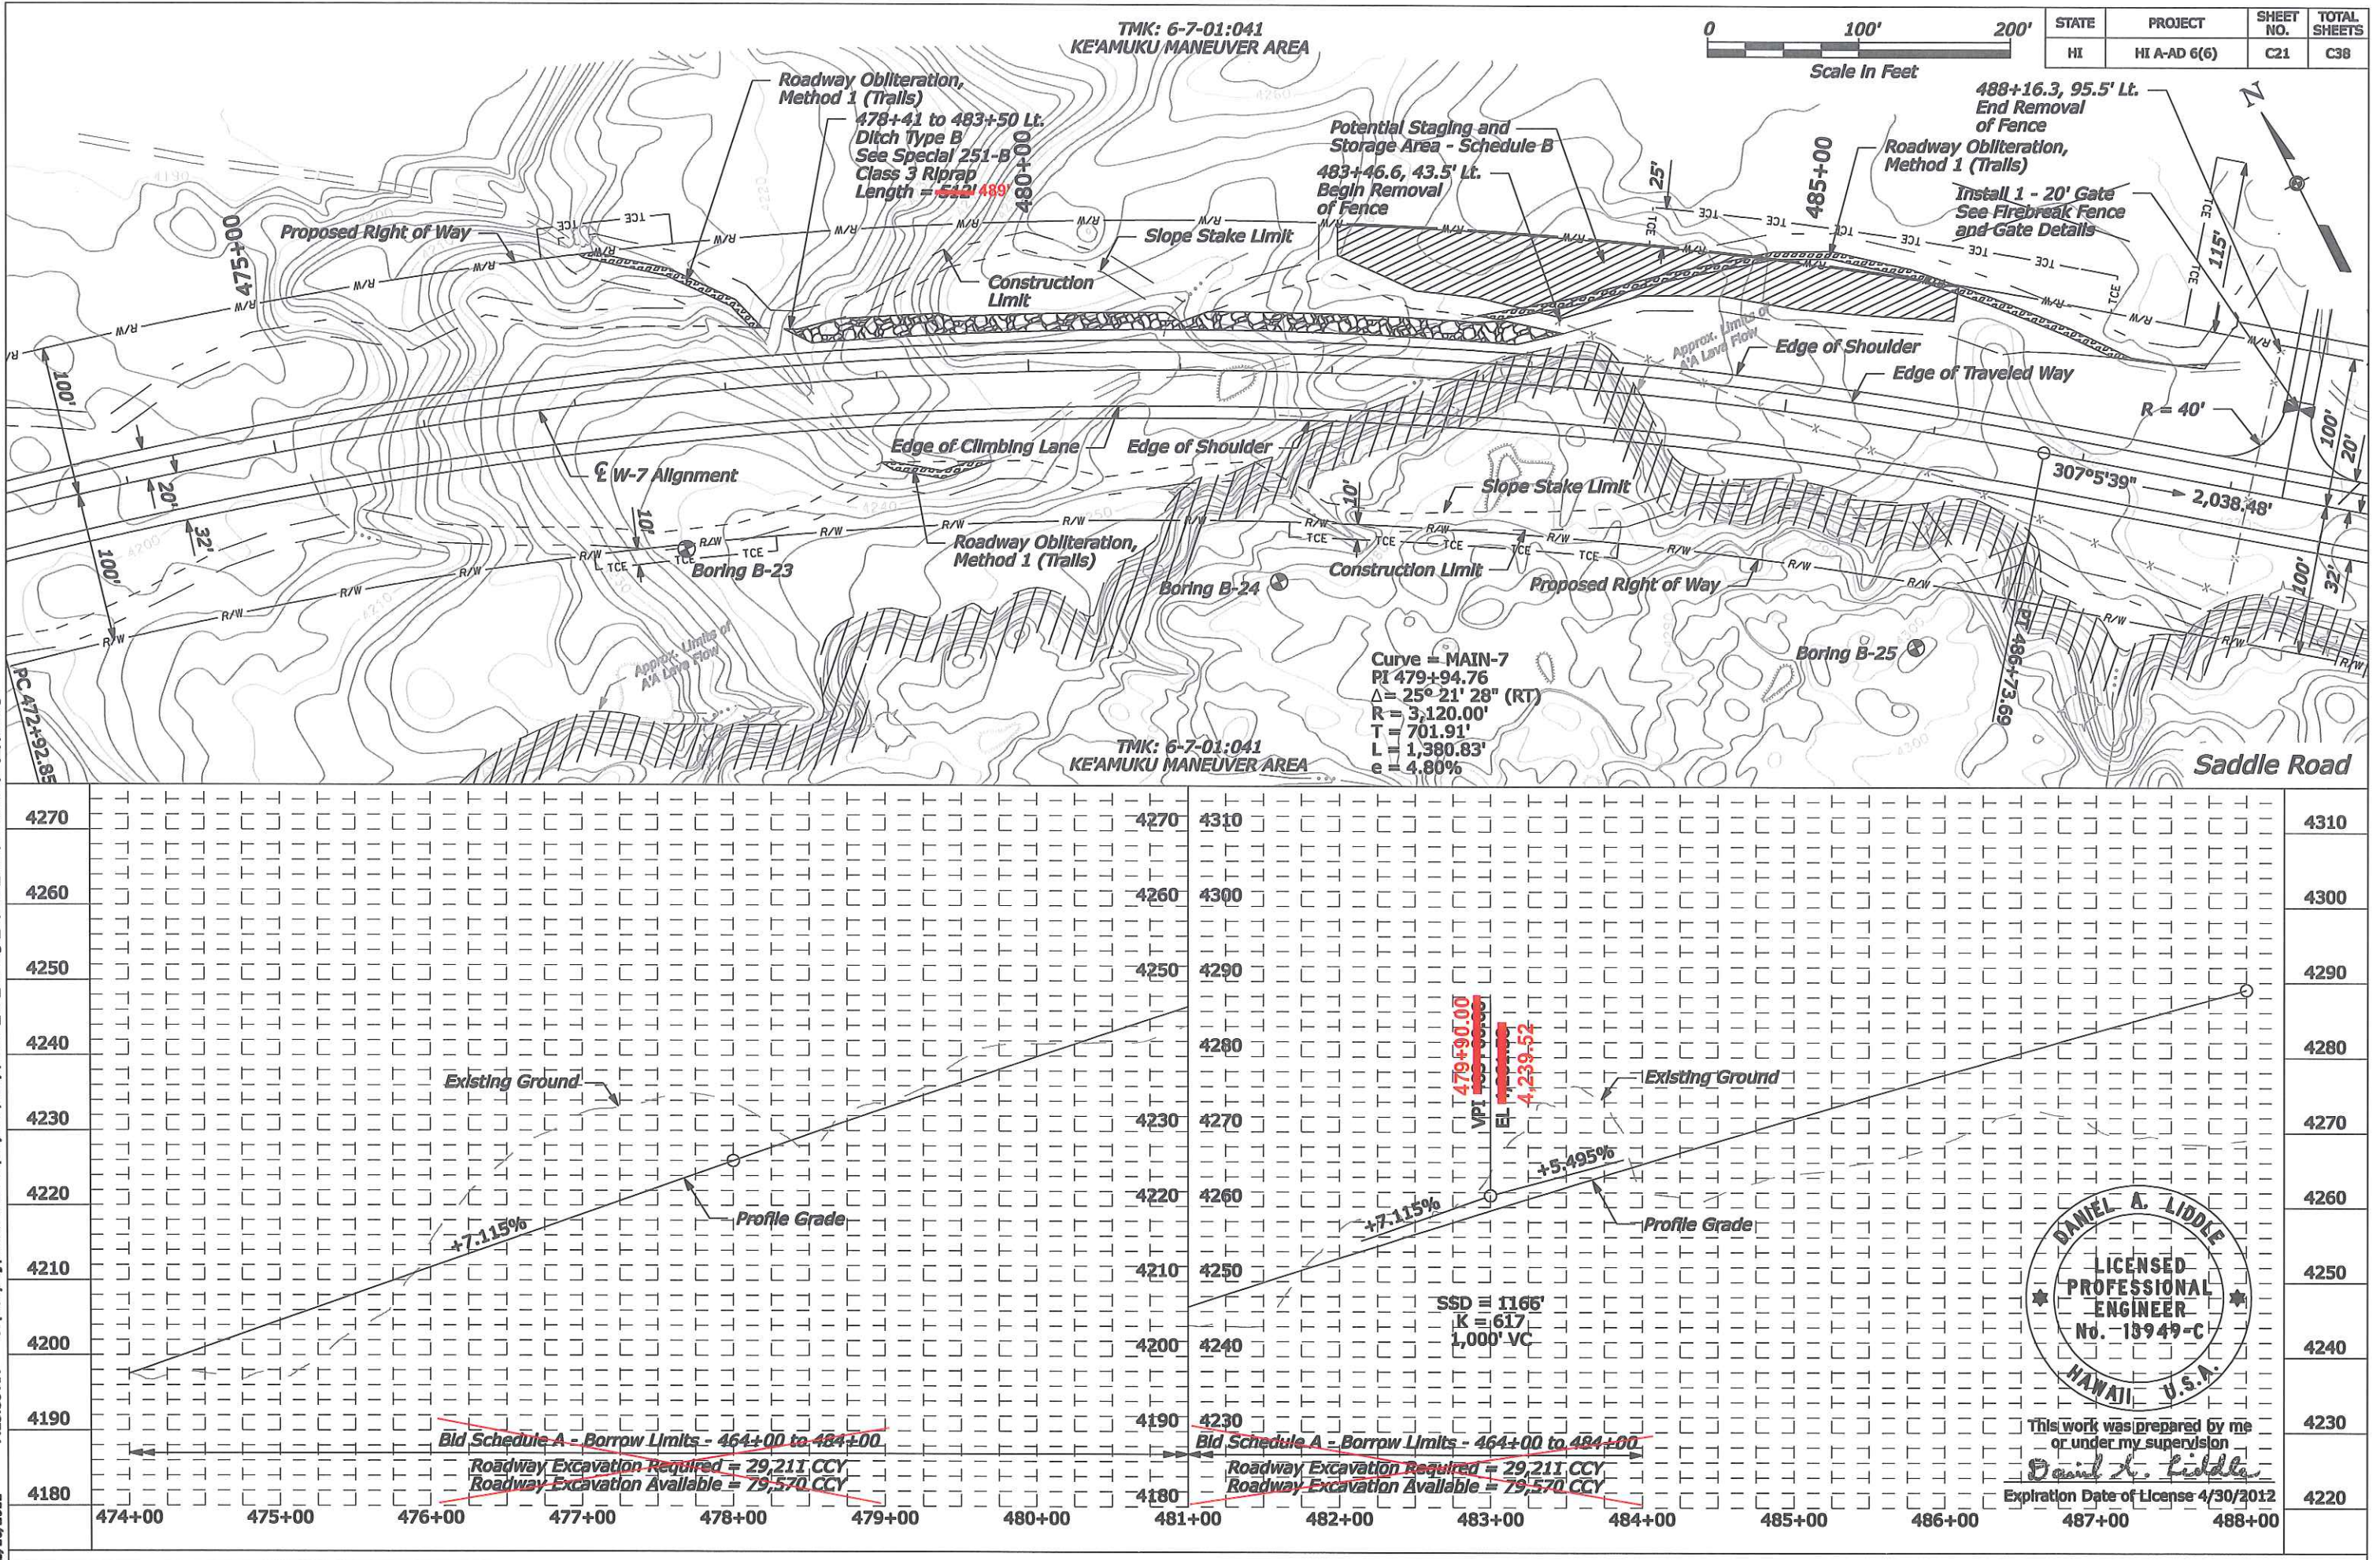





5/16/2011 7:25:13 AM S:\Temp\100013746-SR\HWDes\Raw\Sheets\_Bld\_Package\_1\1C-M\_L\_Peap\HI SR 200(00)\_pp22.dgn

TMK: 6-7-01:041  
KE'AMUKU MANEUVER AREA

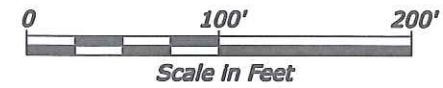


| STATE | PROJECT      | SHEET NO. | TOTAL SHEETS |
|-------|--------------|-----------|--------------|
| HI    | HI A-AD 6(6) | C22       | C38          |

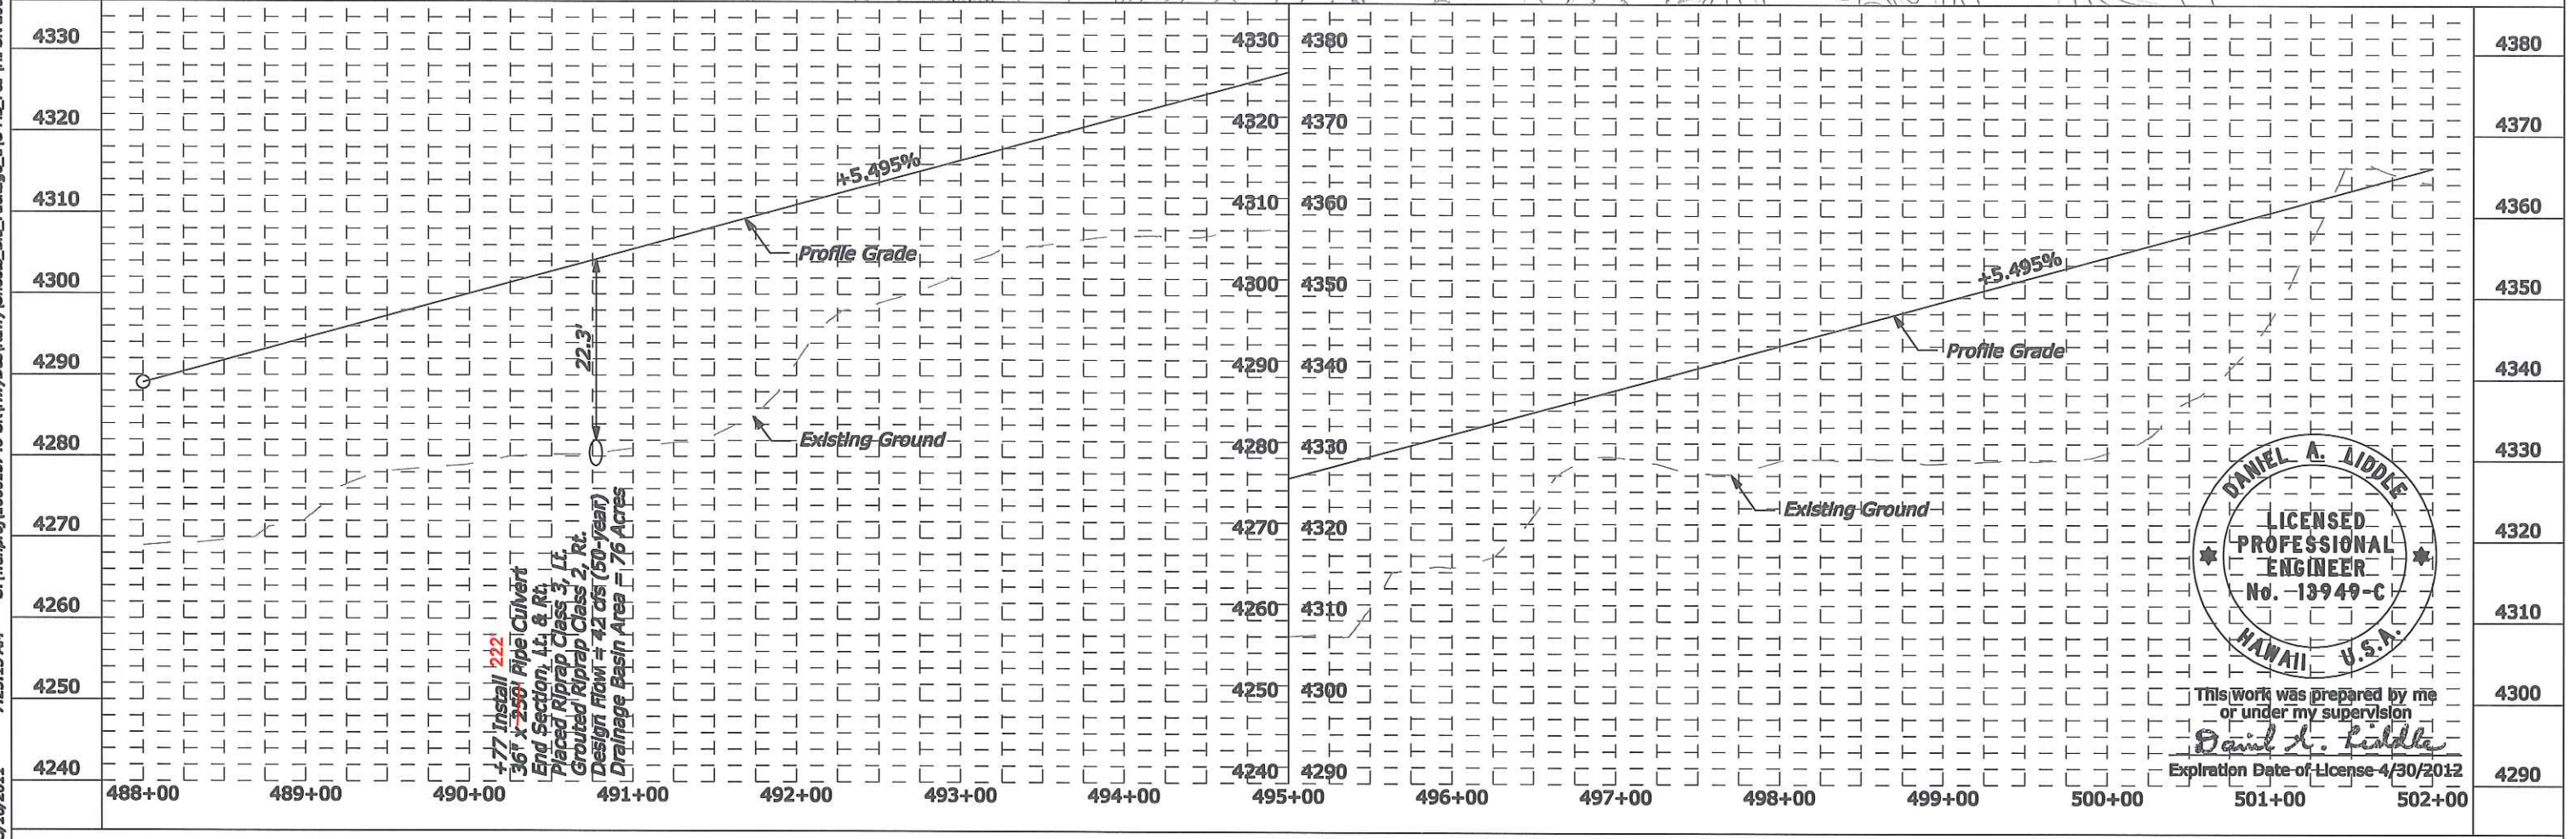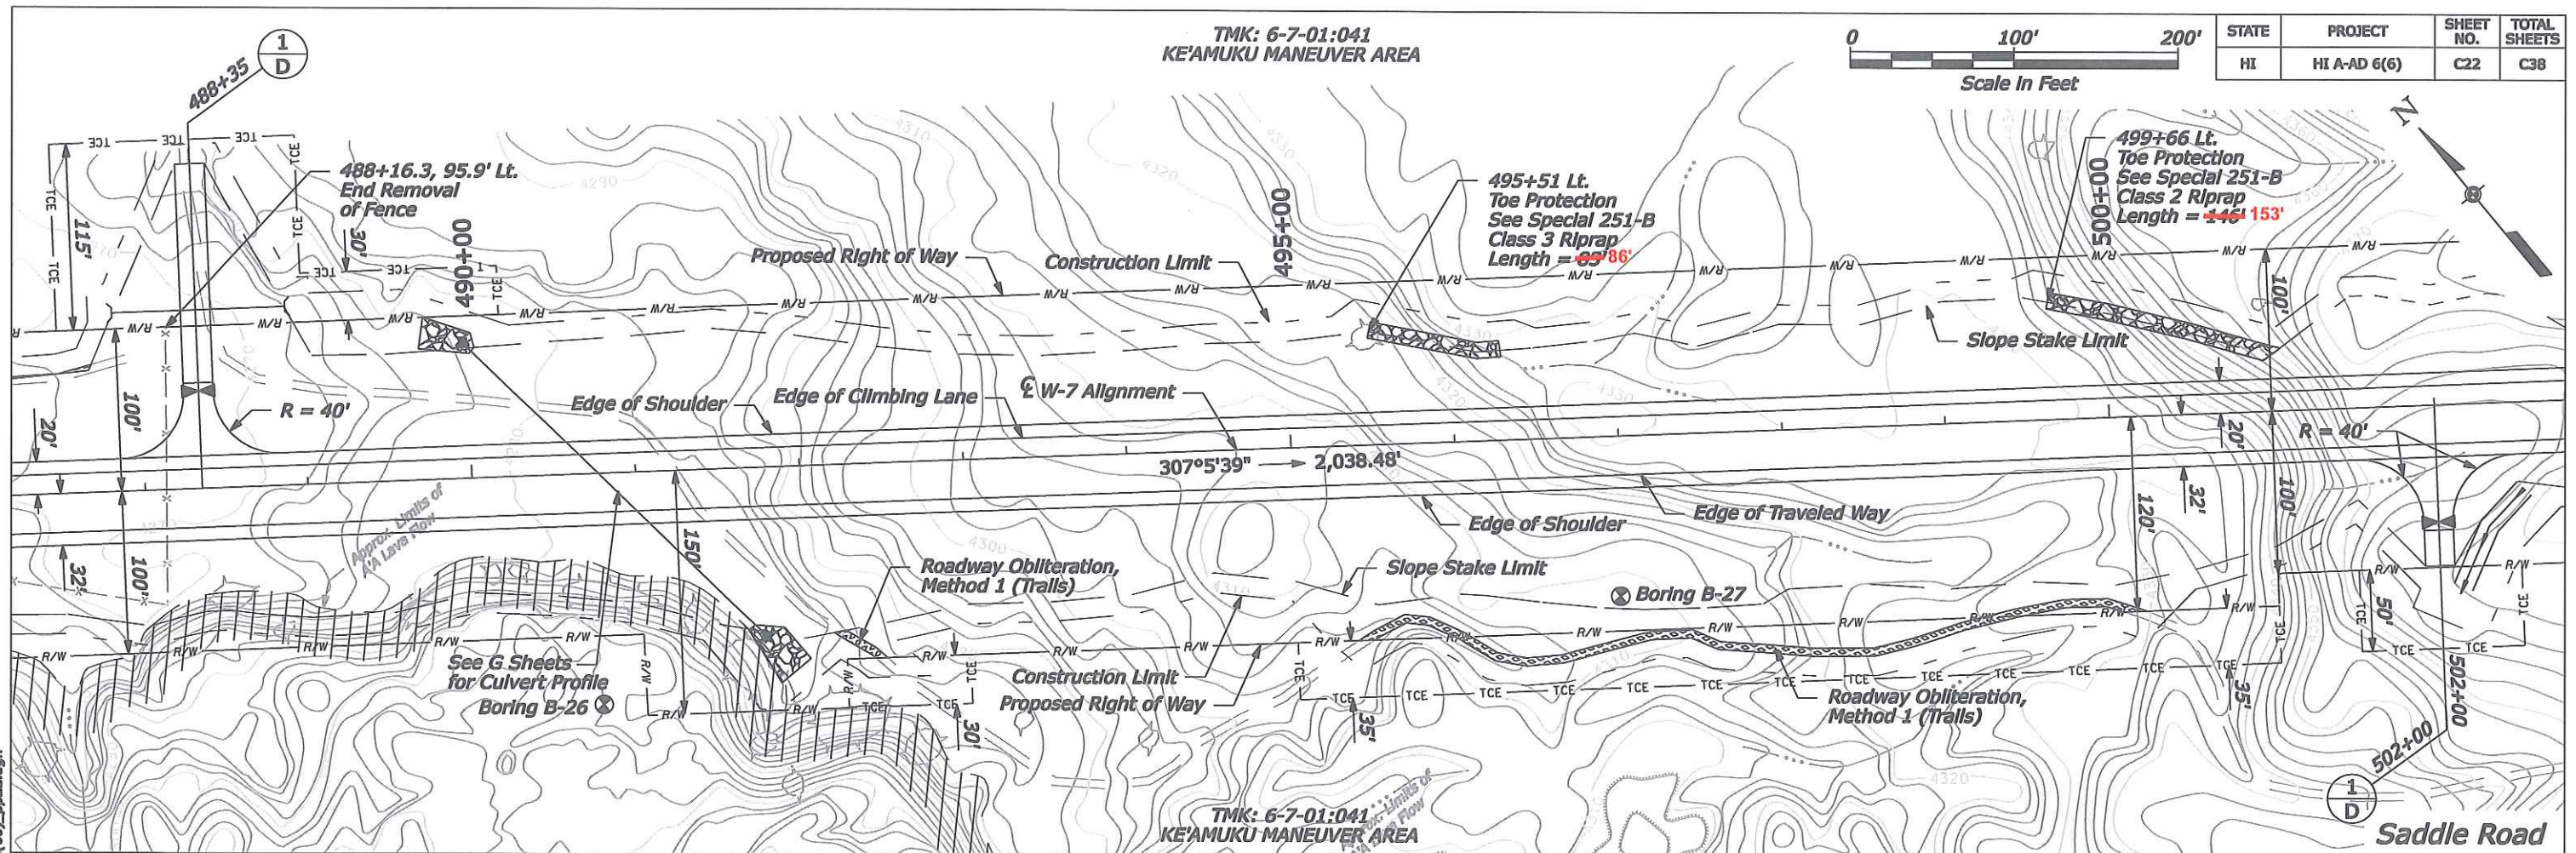




TMK: 6-7-01:041  
KE'AMUKU MANEUVER AREA

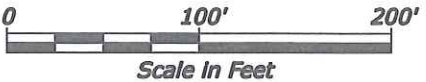



| STATE | PROJECT      | SHEET NO. | TOTAL SHEETS |
|-------|--------------|-----------|--------------|
| HI    | HI A-AD 6(6) | C23       | C38          |

Curve = MAIN-8  
PI 518+69.85  
 $\Delta = 40^\circ 42' 53''$  (LT)  
R = 3,120.00'  
T = 1,157.68'  
L = 2,217.09'  
e = 4.80%

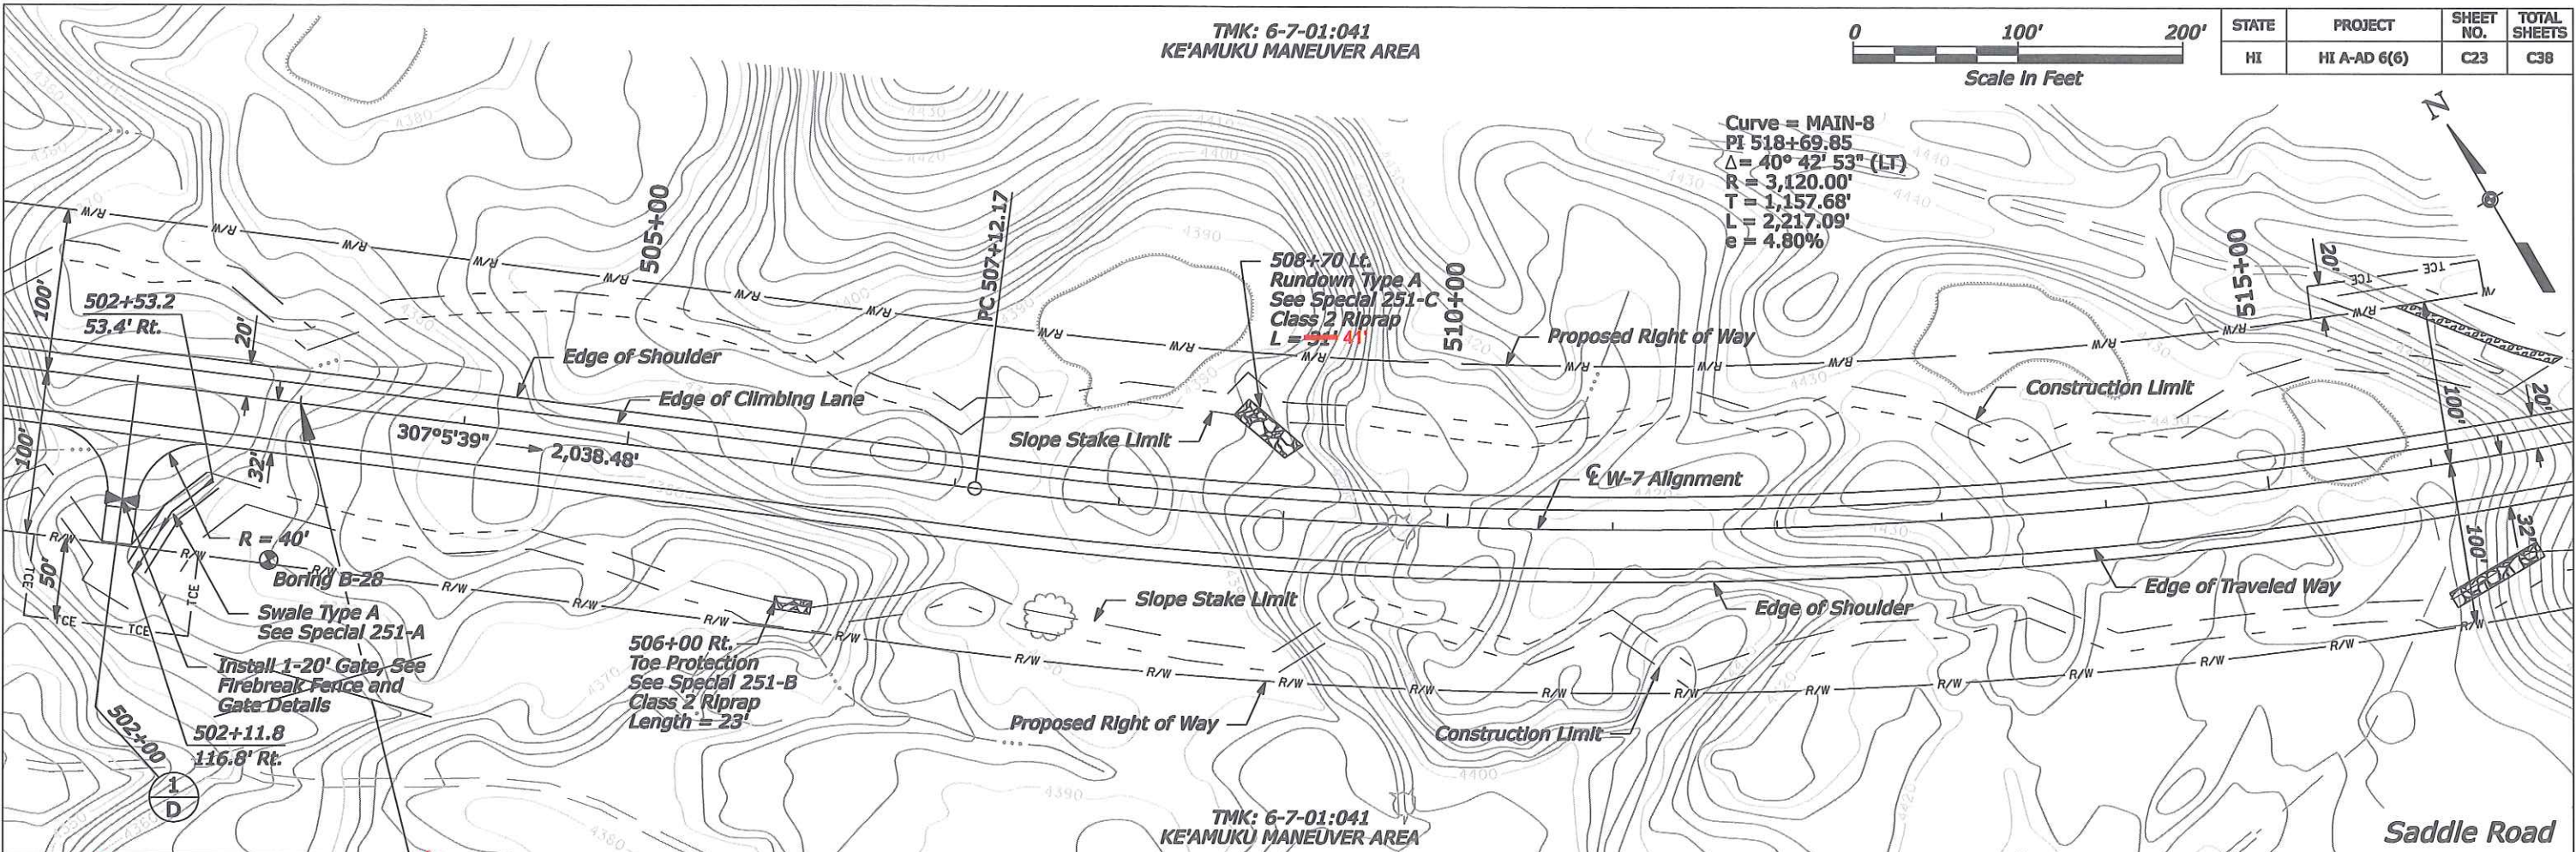

Saddle Road

TMK: 6-7-01:041  
KE'AMUKU MANEUVER AREA

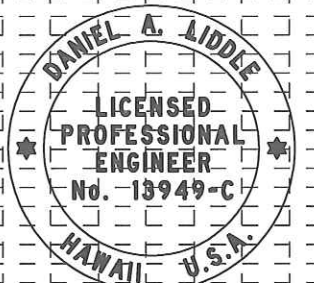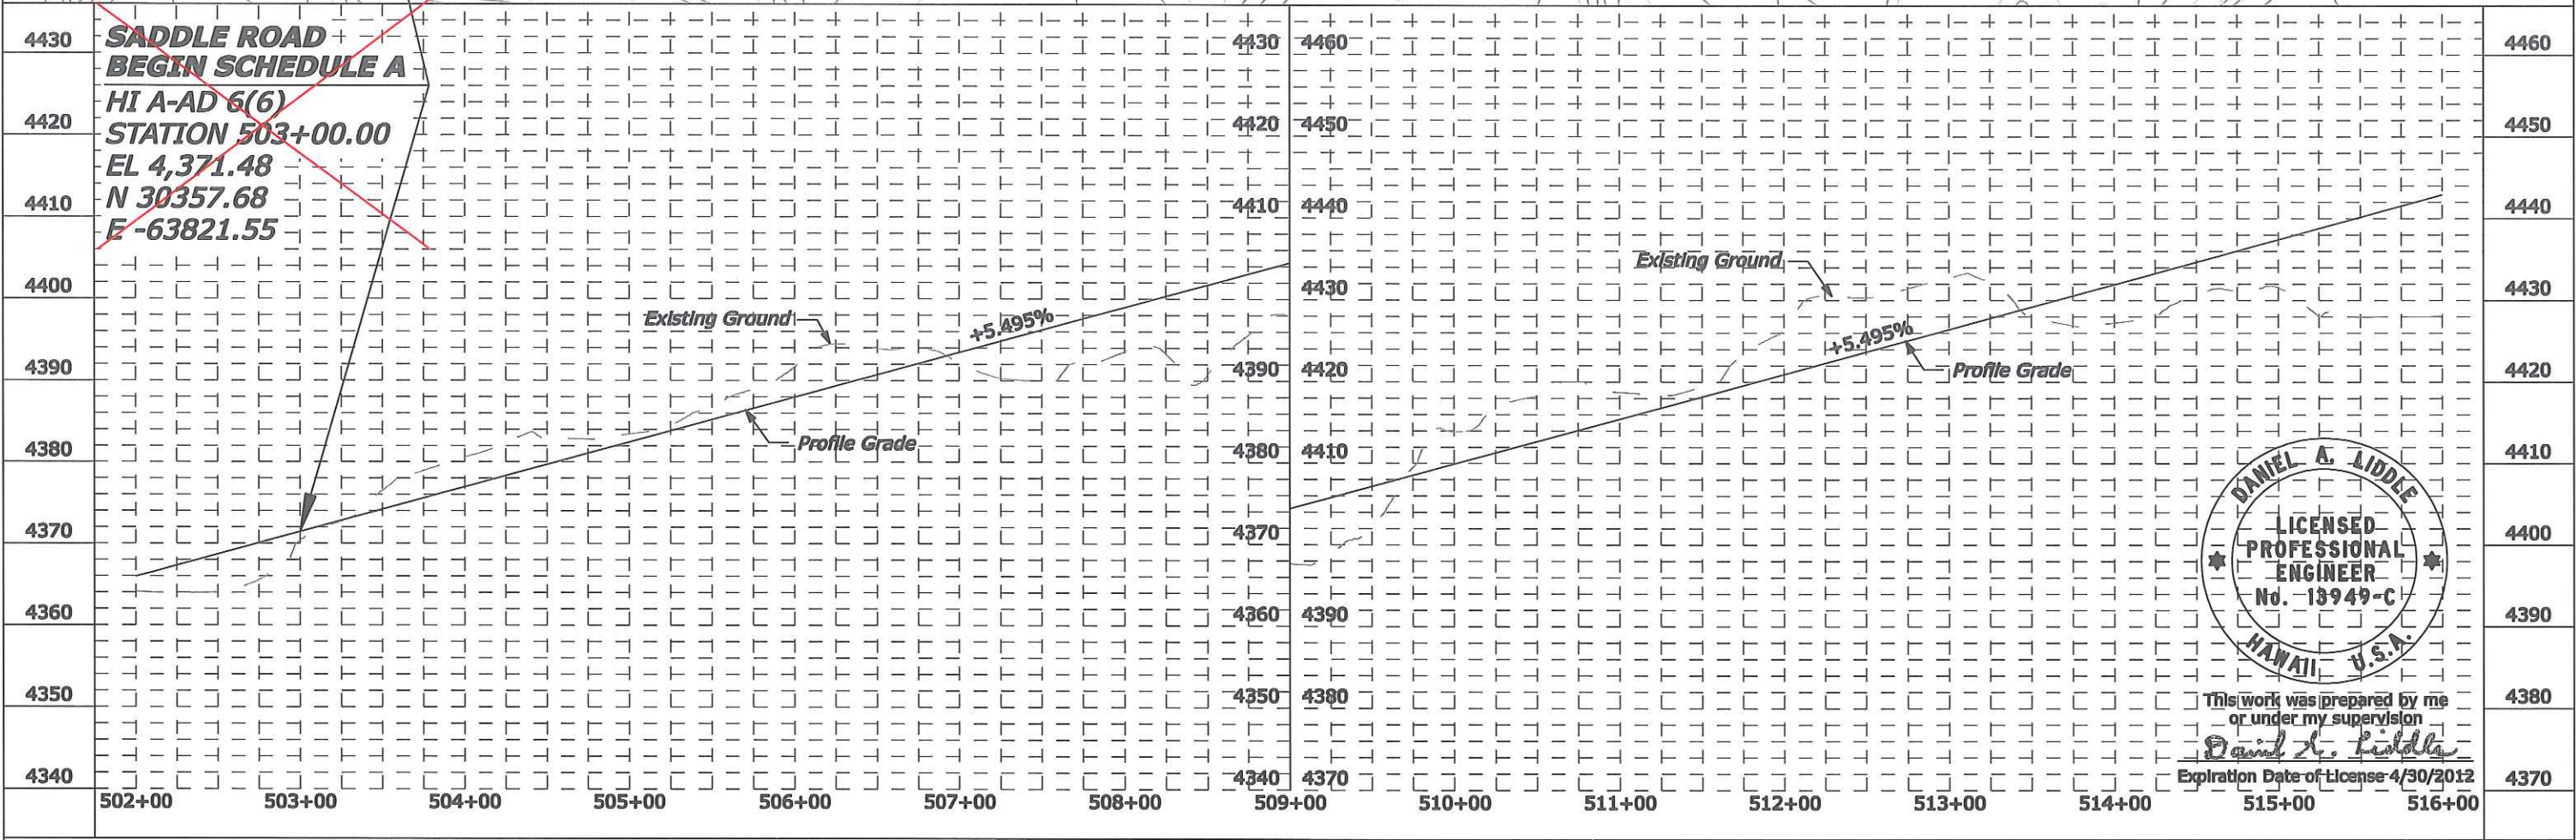


This work was prepared by me  
or under my supervision  
*Daniel A. Liddle*  
Expiration Date of License 4/30/2012

5/16/2011 7:26:38 AM S:\Transport\100012746-SR\HwyDes\Drawings\Sheets\_Bld\_Package\_1\C-M\_L\_P&PHI SR 200(00).pp23.dgn






5/16/2011 7:30:07 AM S:\Tranpro\100013746-SR\HwyDes\Drawings\Sheets\_Bld\_Package\_1\C-M\_L\_PeP\HI SR 200(00)\_pp24.dgn

TMK: 6-7-01:041  
KE'AMUKU MANEUVER AREA

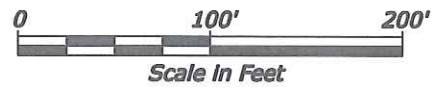

| STATE | PROJECT      | SHEET NO. | TOTAL SHEETS |
|-------|--------------|-----------|--------------|
| HI    | HI A-AD 6(6) | C24       | C38          |

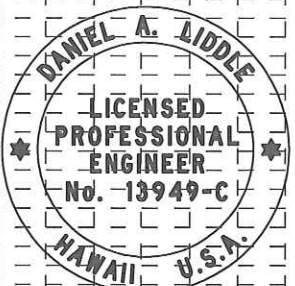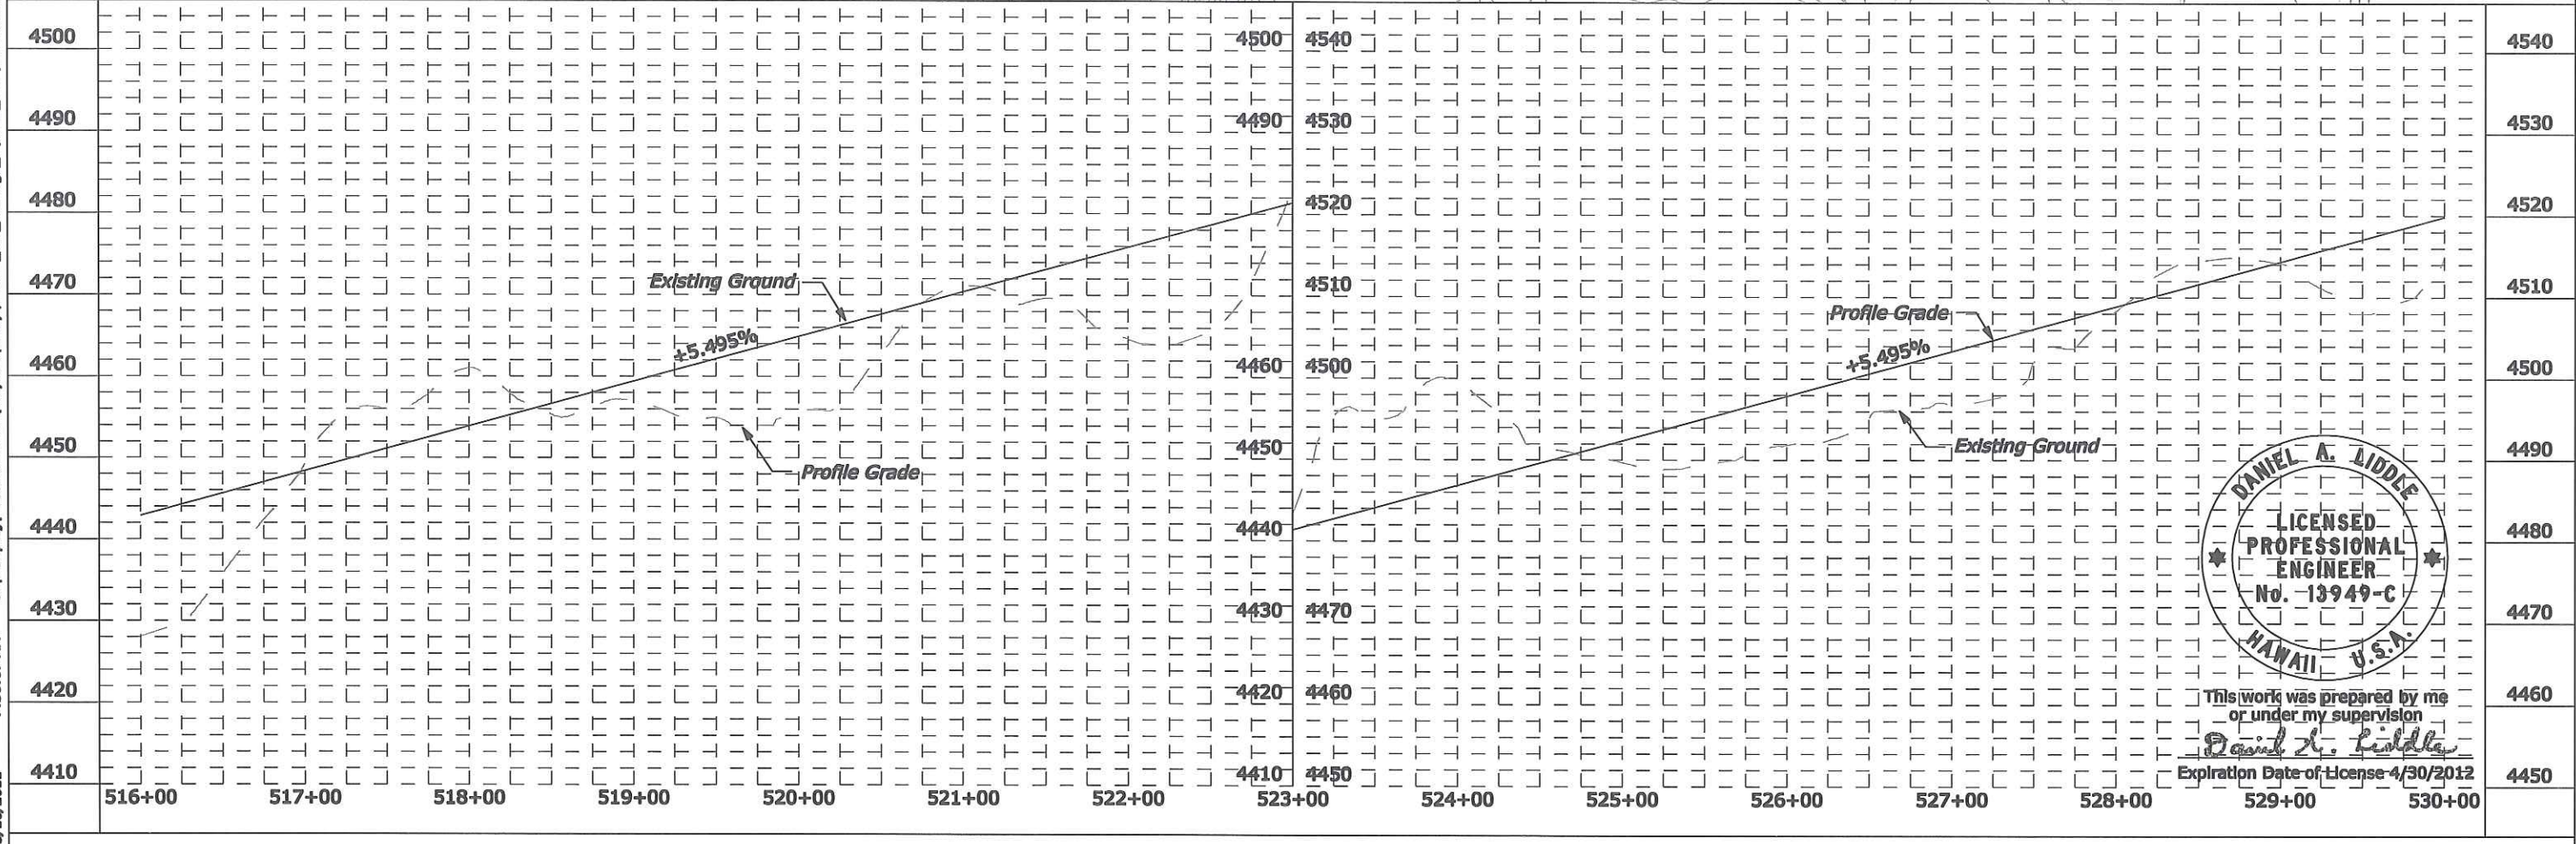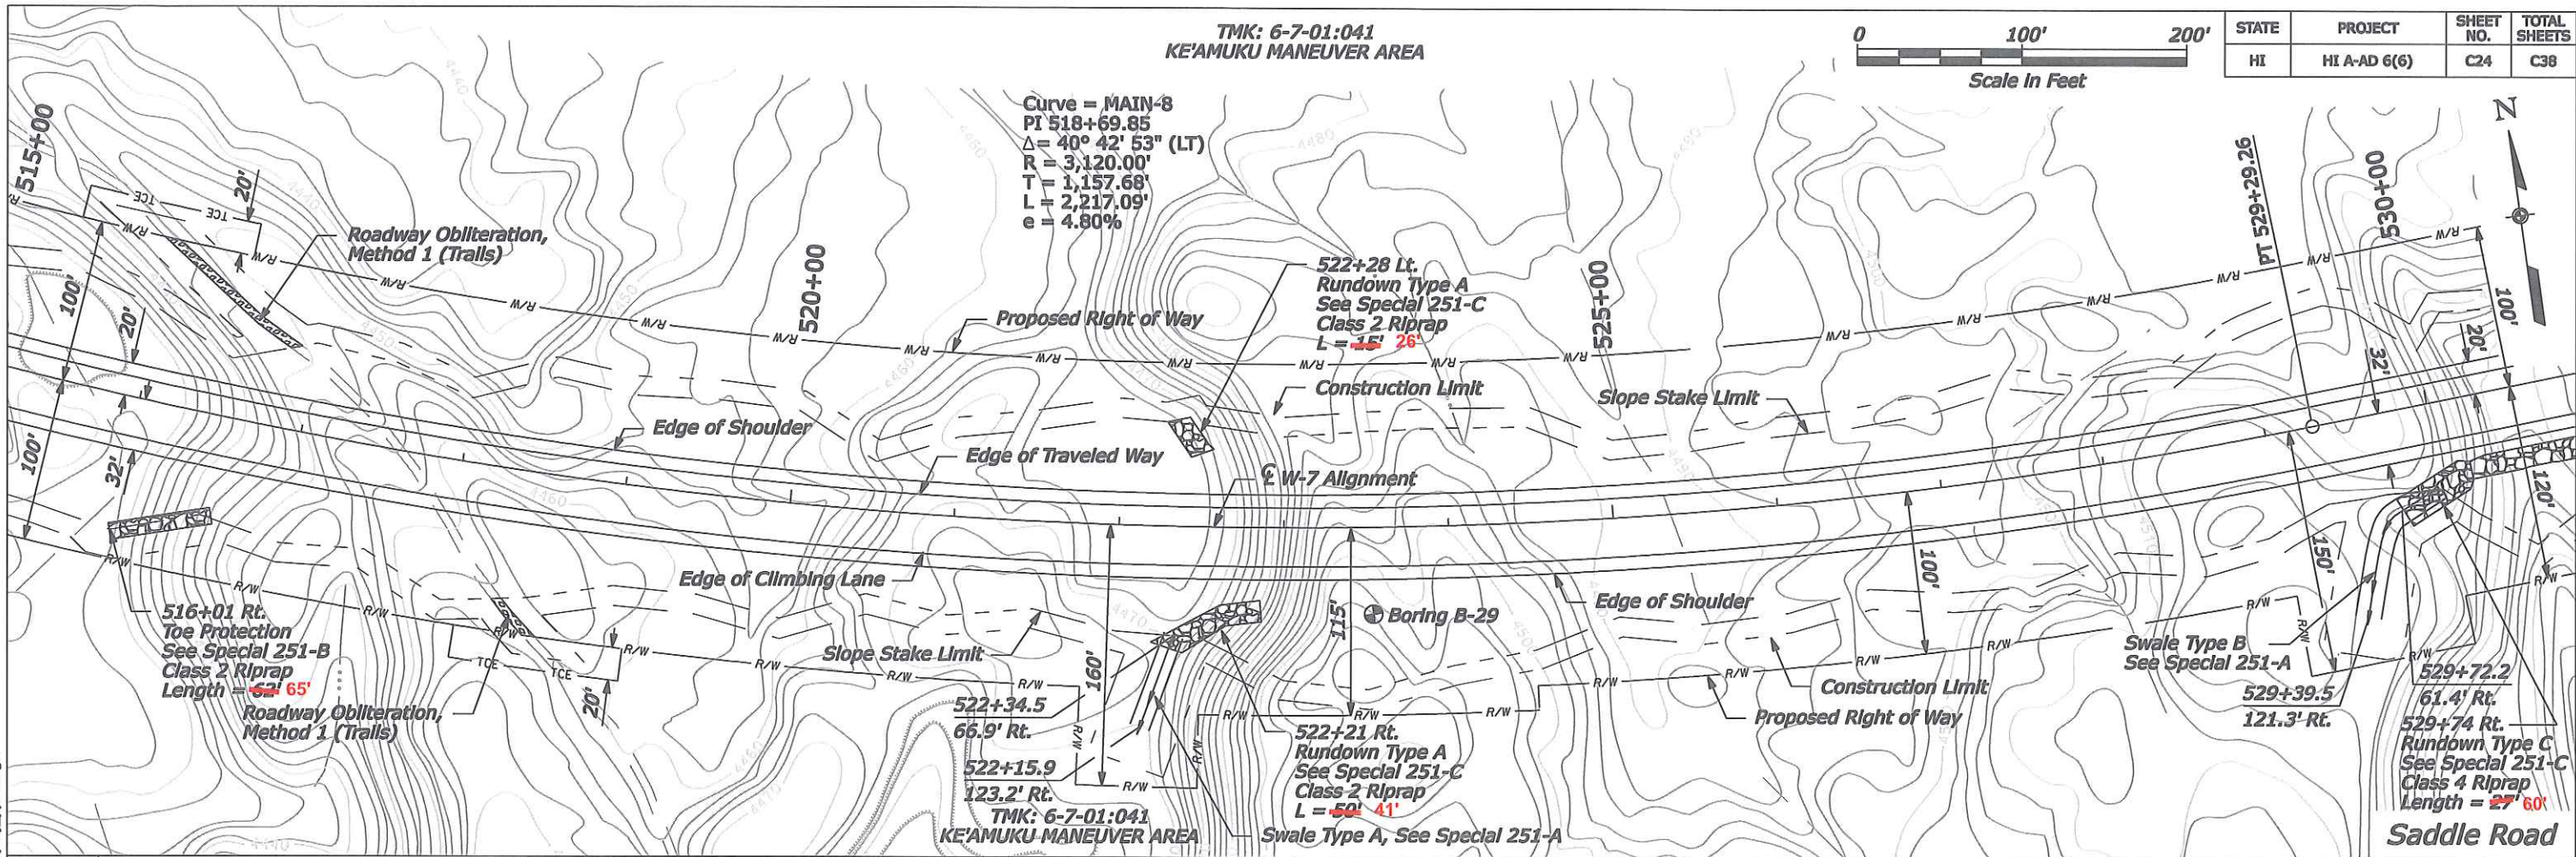


This work was prepared by me  
or under my supervision  
*Daniel A. Liddee*  
Expiration Date of License 4/30/2012





5/16/2011 7:32:21 AM S:\Transport\100013746-SR\HwyDes\Draws\Sheets\_Bld\_Package\_1\C-M\_L\_Paper\HI SR 200(00)\_pp25.dgn

TMK: 6-7-01:041  
KE'AMUKU MANEUVER AREA

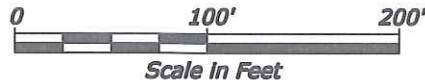


| STATE | PROJECT      | SHEET NO. | TOTAL SHEETS |
|-------|--------------|-----------|--------------|
| HI    | HI A-AD 6(6) | C25       | C38          |

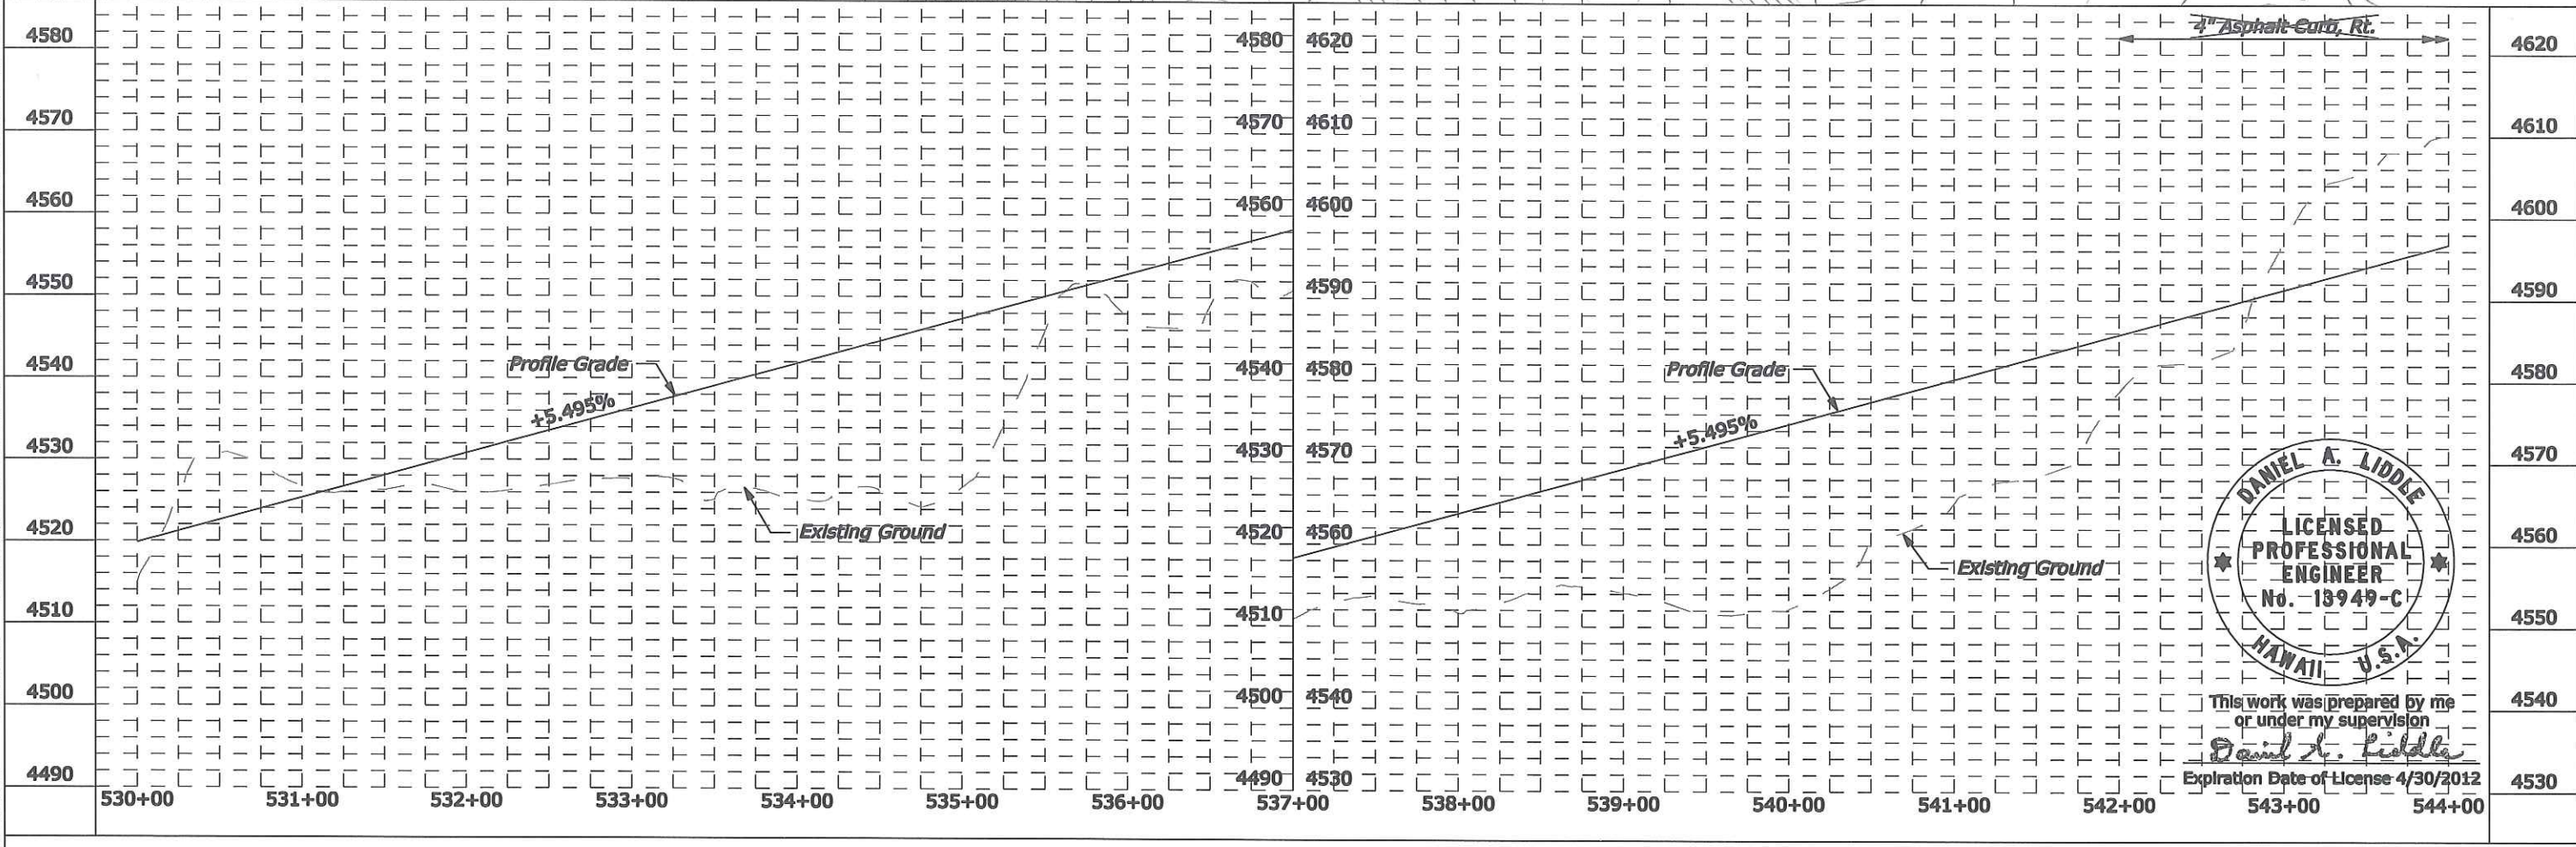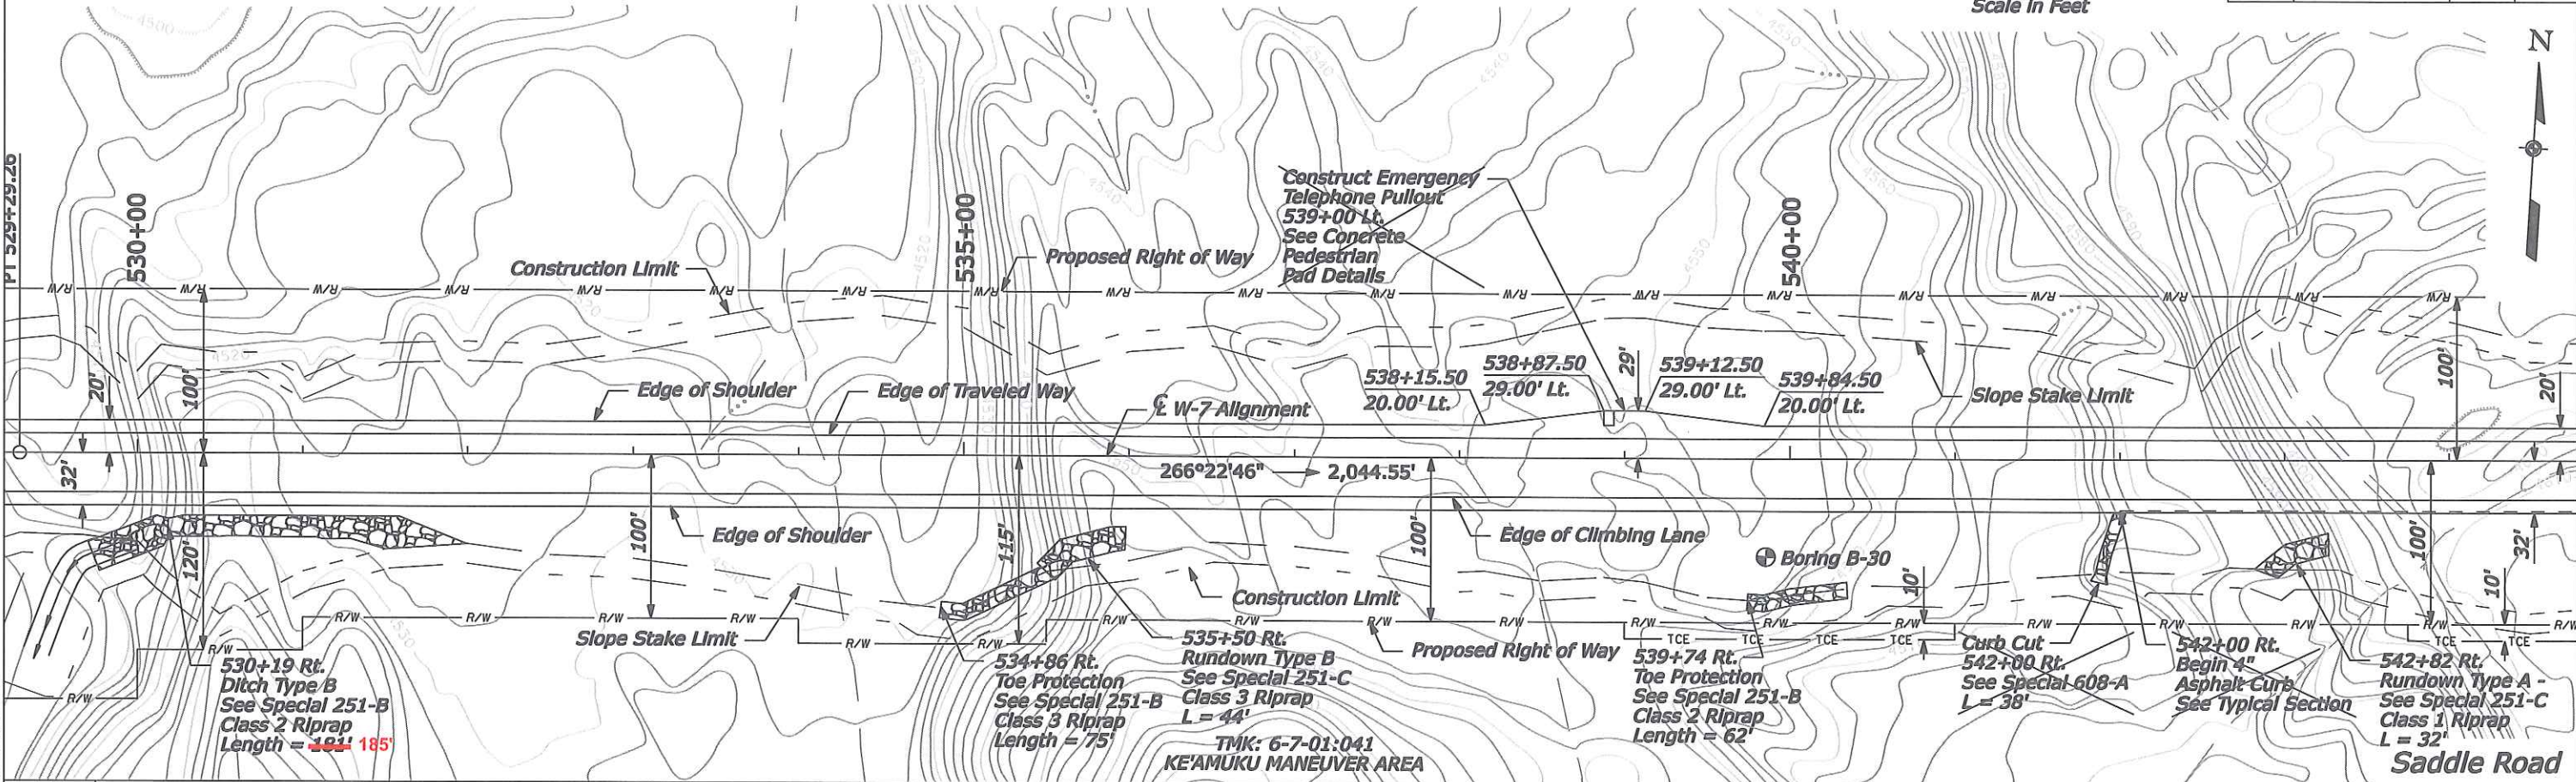




8:25:02 AM S:\Transport\100013746-SR\HwyDes\Drawings\Sheets\_End Package\_1\1C-MIL\_P8PHI SR 200(00)\_pp26.dgn

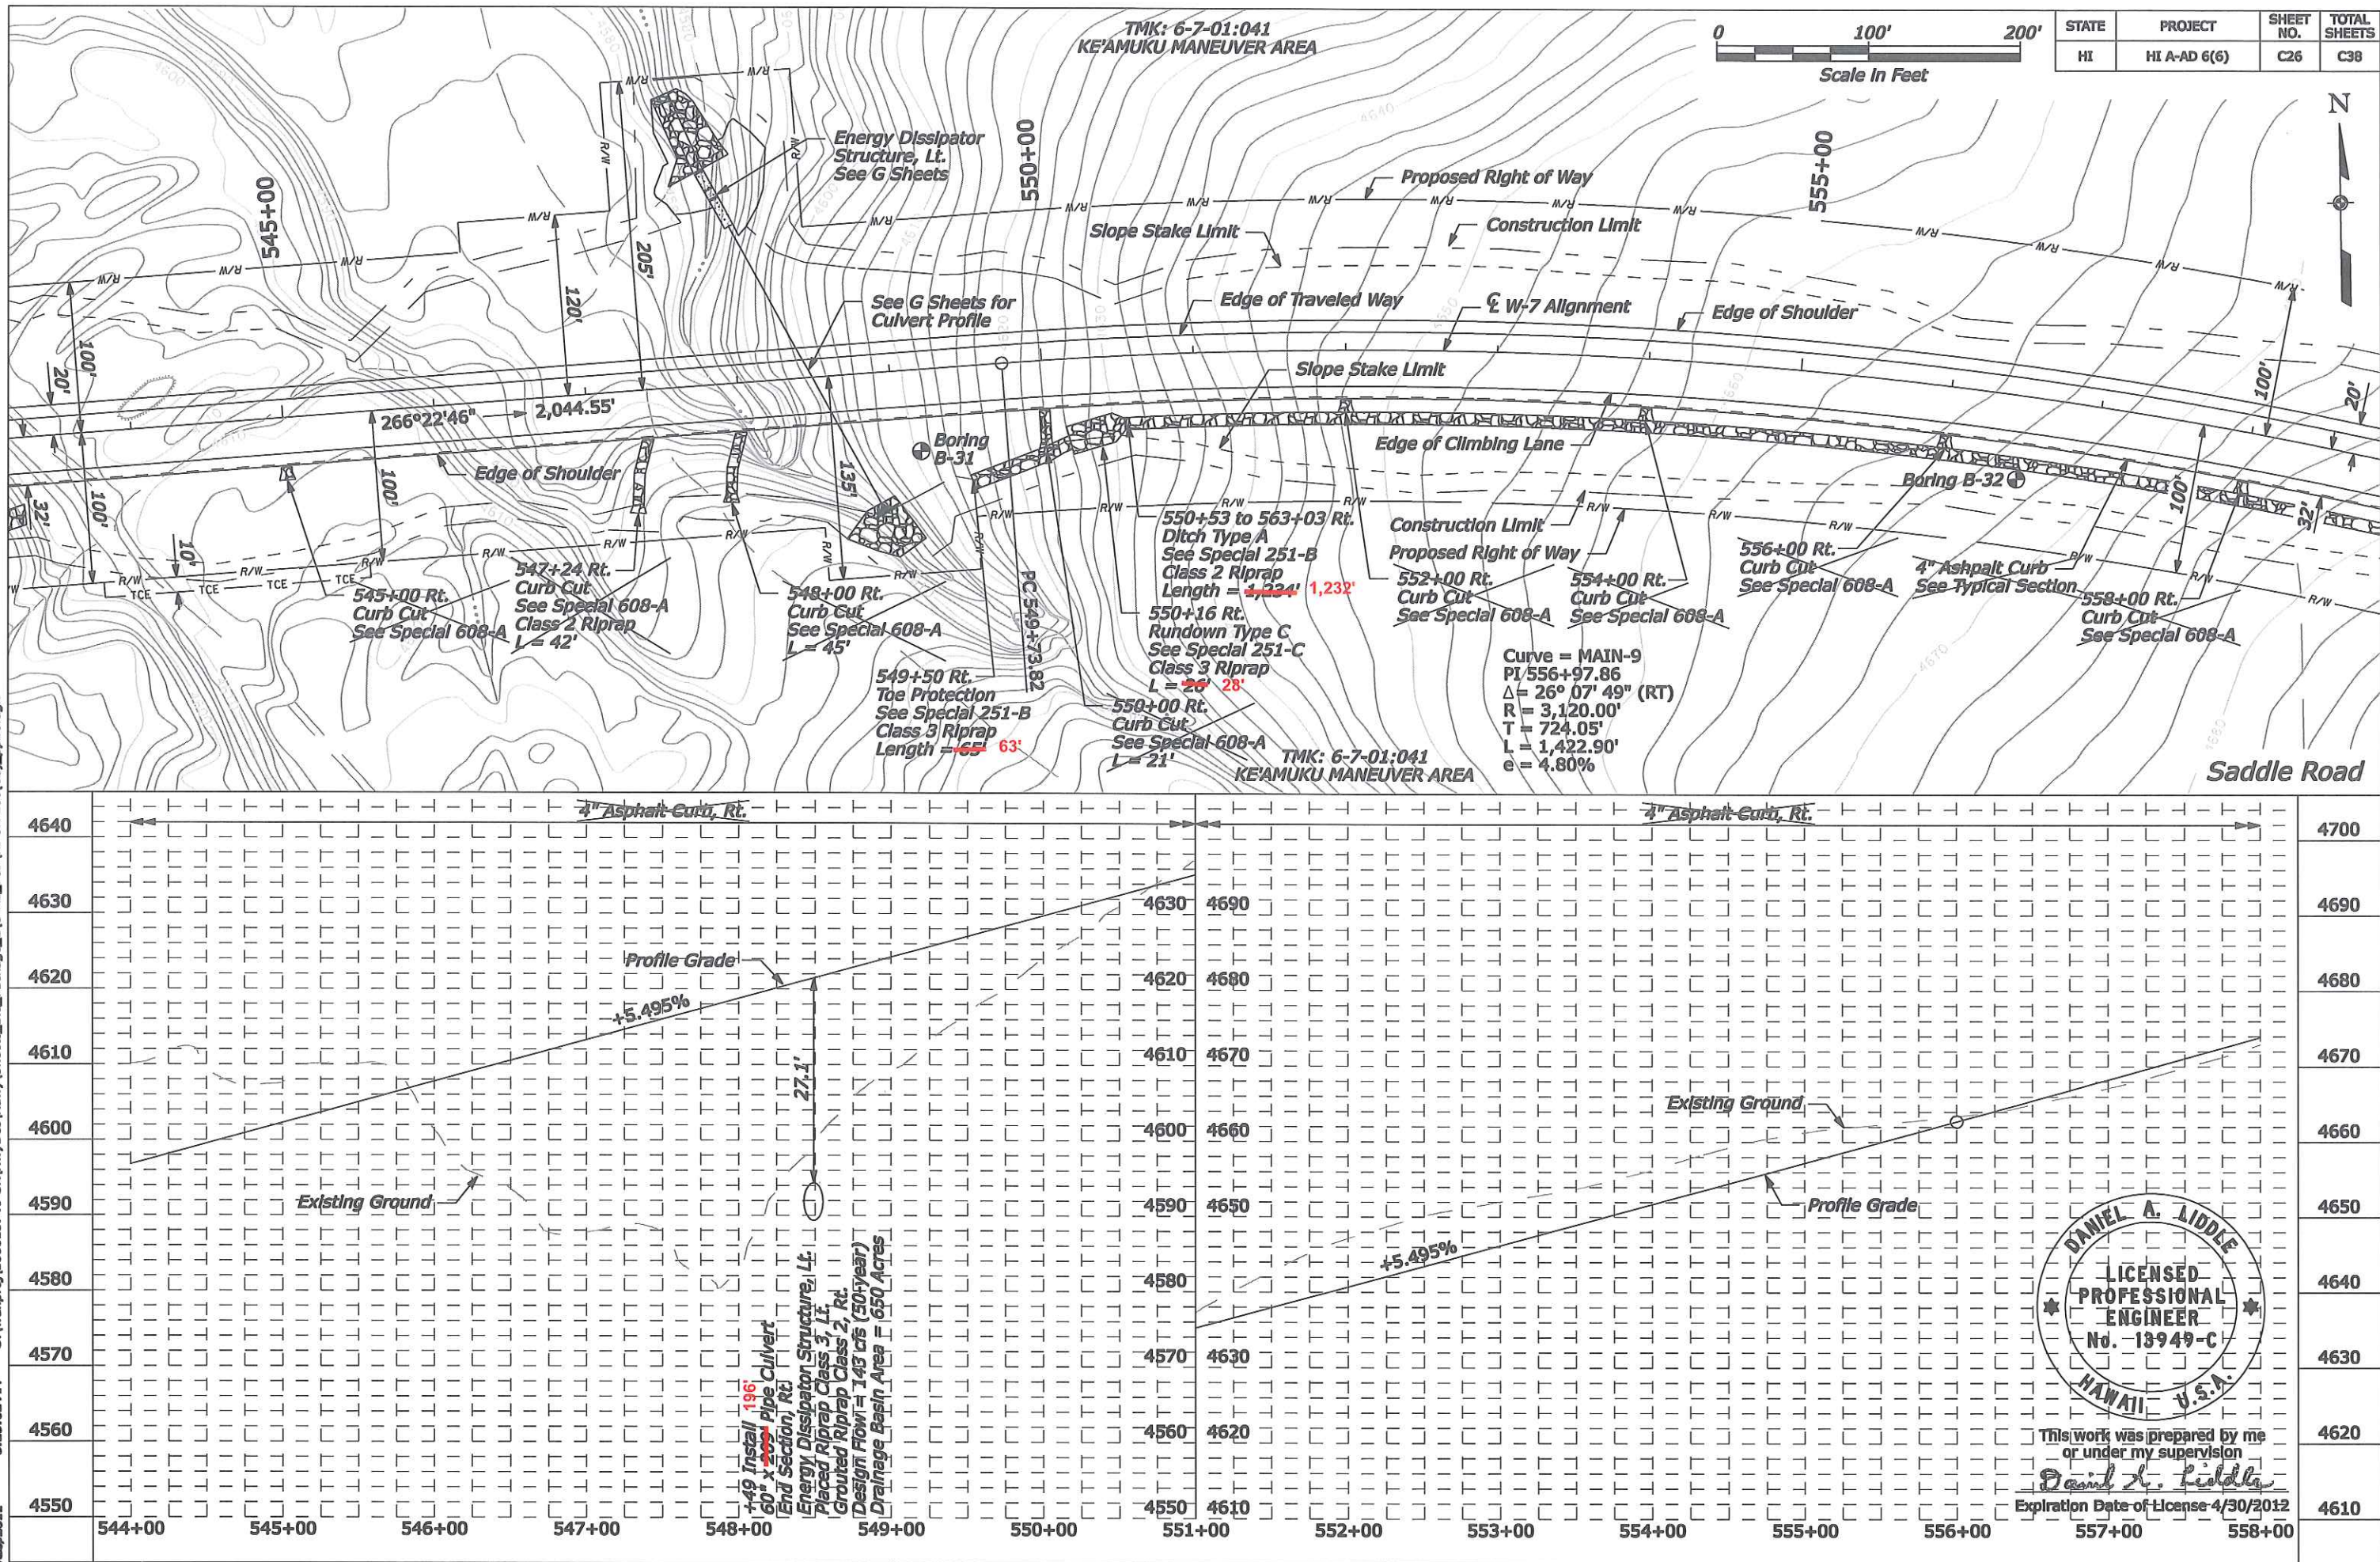




5/16/2011 8:50:18 AM S:\Transport\100013746-SR\HwyDes\Draws\Sheets\_Bld\_Package\_1\C-MIL\_PEP\HI SR 200(00)\_pp27.dgn

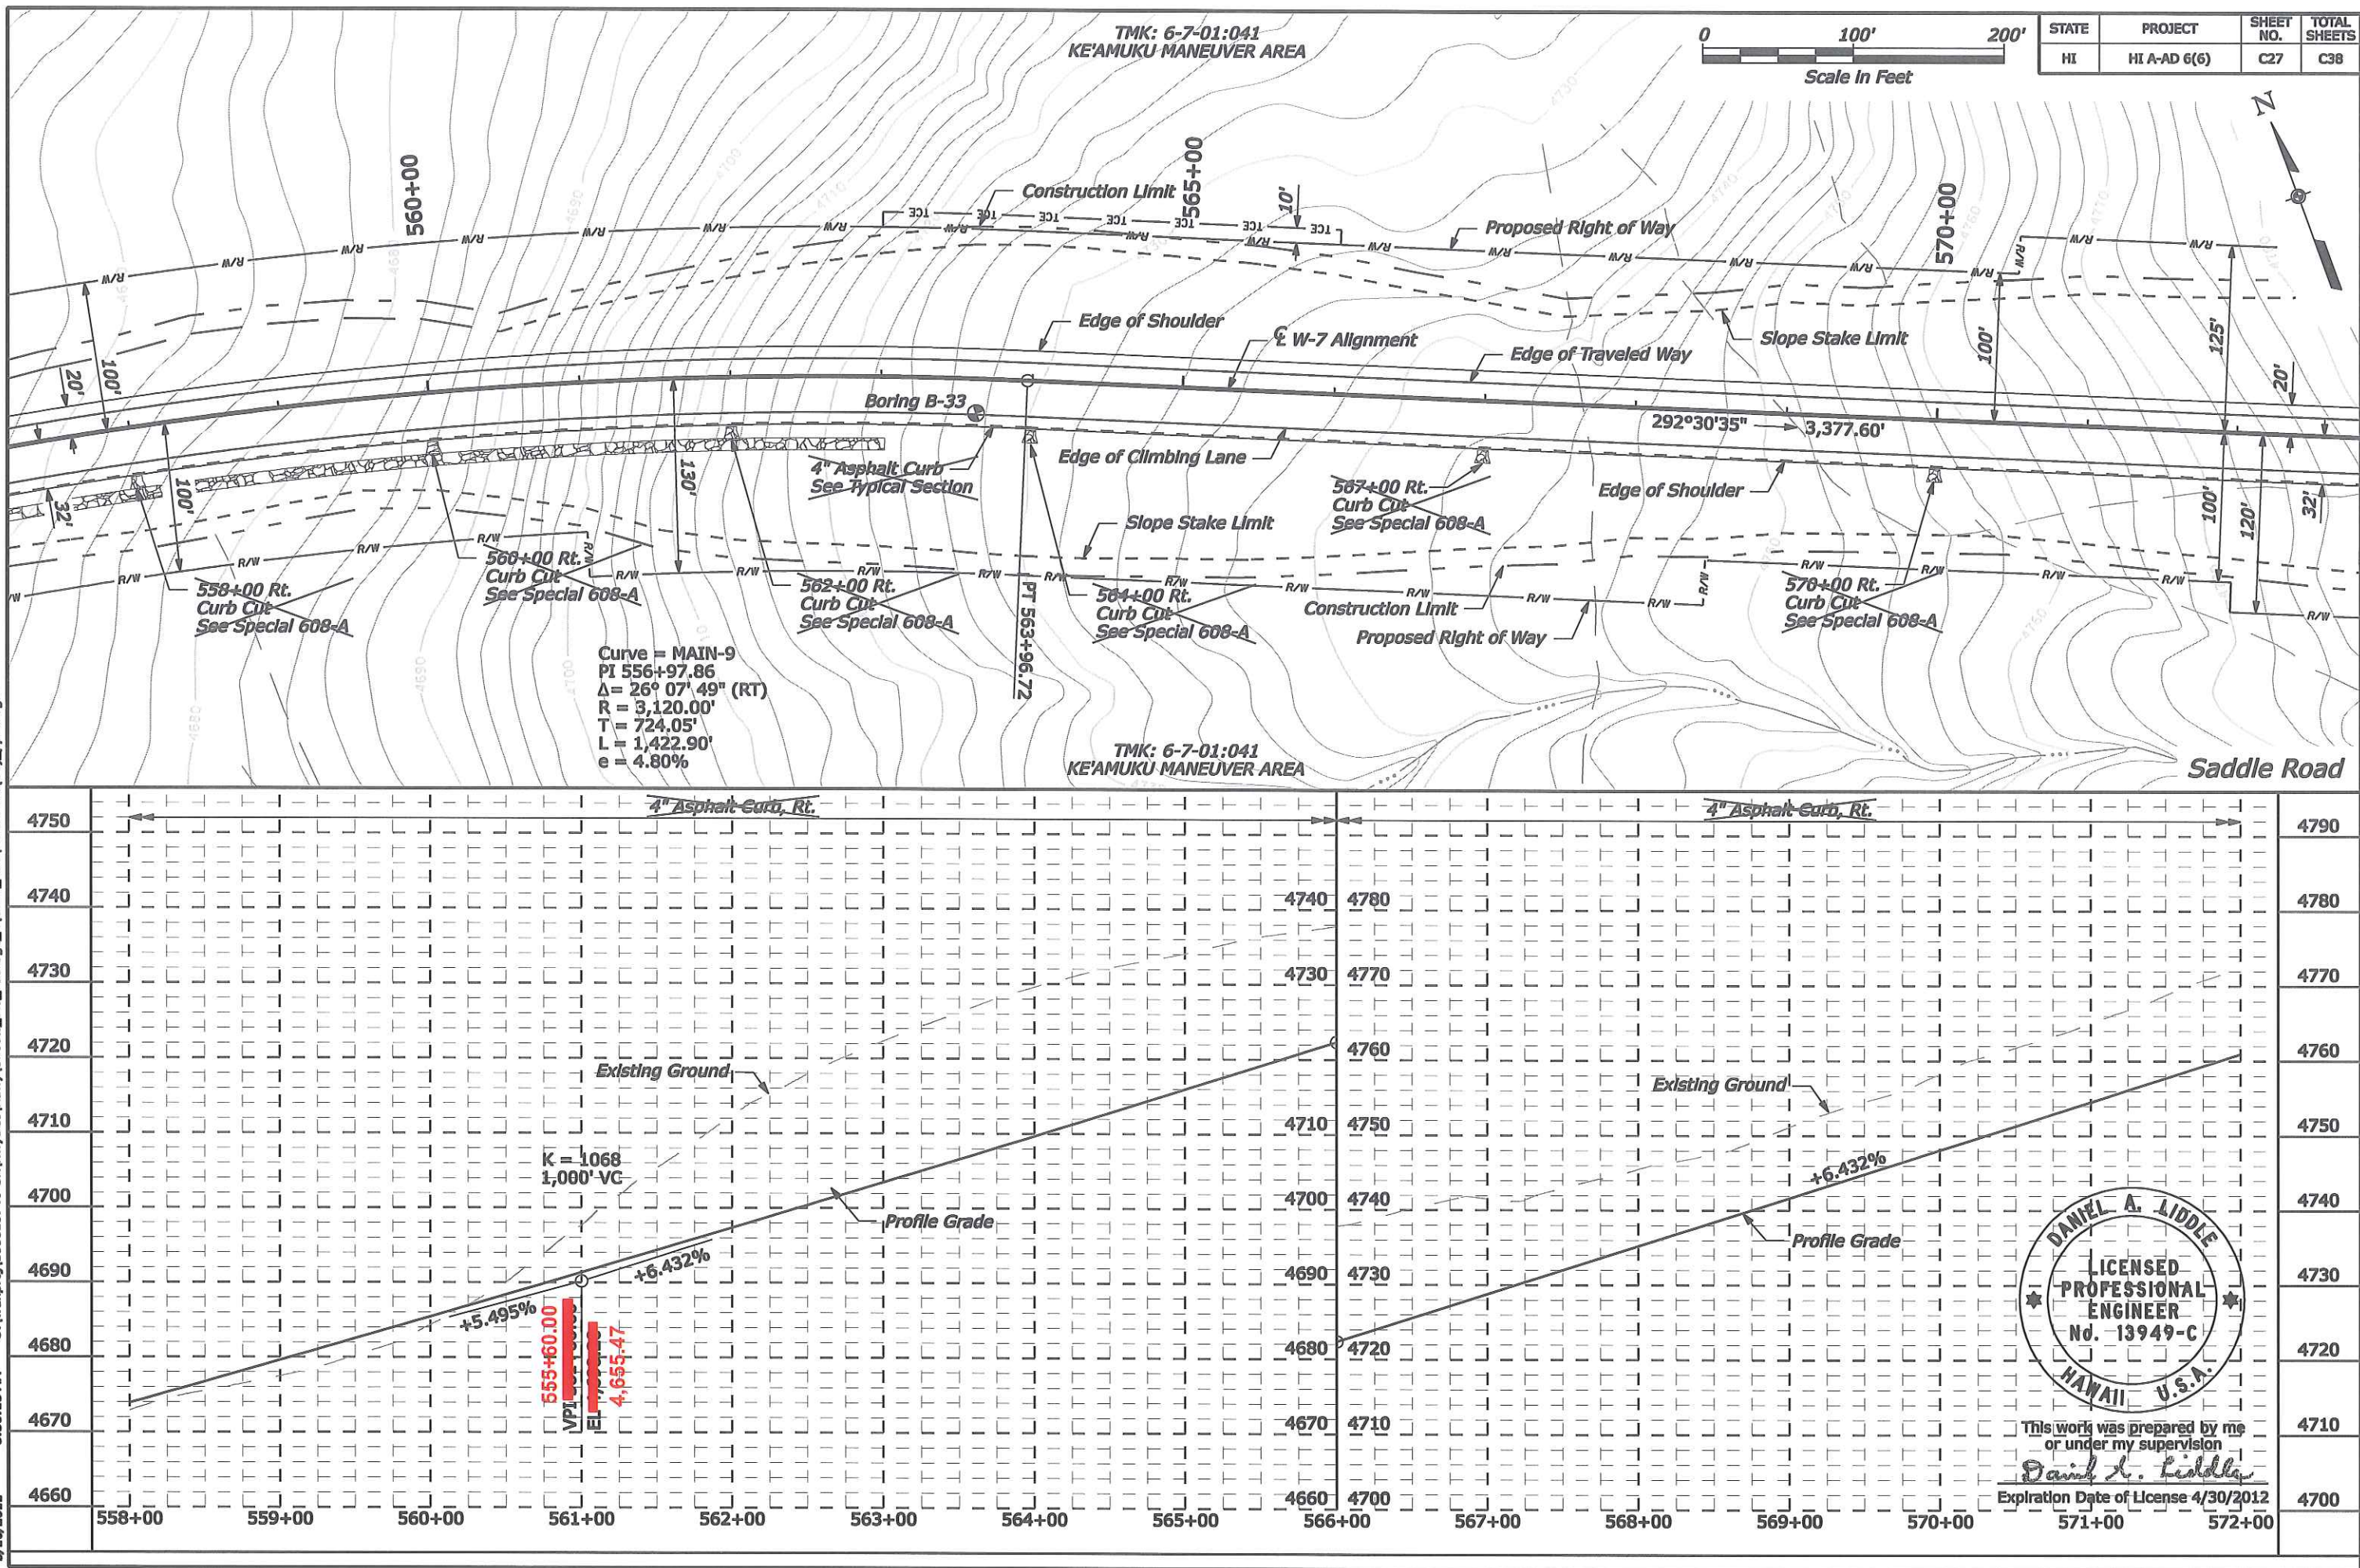




5/16/2011 8:51:13 AM S:\Transport\100013746-SR\HwyDes\Drawings\Sheets\_Bld\_Package\_1\1C-ML\_P&PHI SR 200(00).pp28.dgn

TMK: 6-7-01:041  
KE'AMUKU MANEUVER AREA


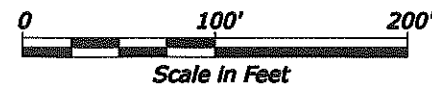


| STATE | PROJECT      | SHEET NO. | TOTAL SHEETS |
|-------|--------------|-----------|--------------|
| HI    | HI A-AD 6(6) | C28       | C38          |

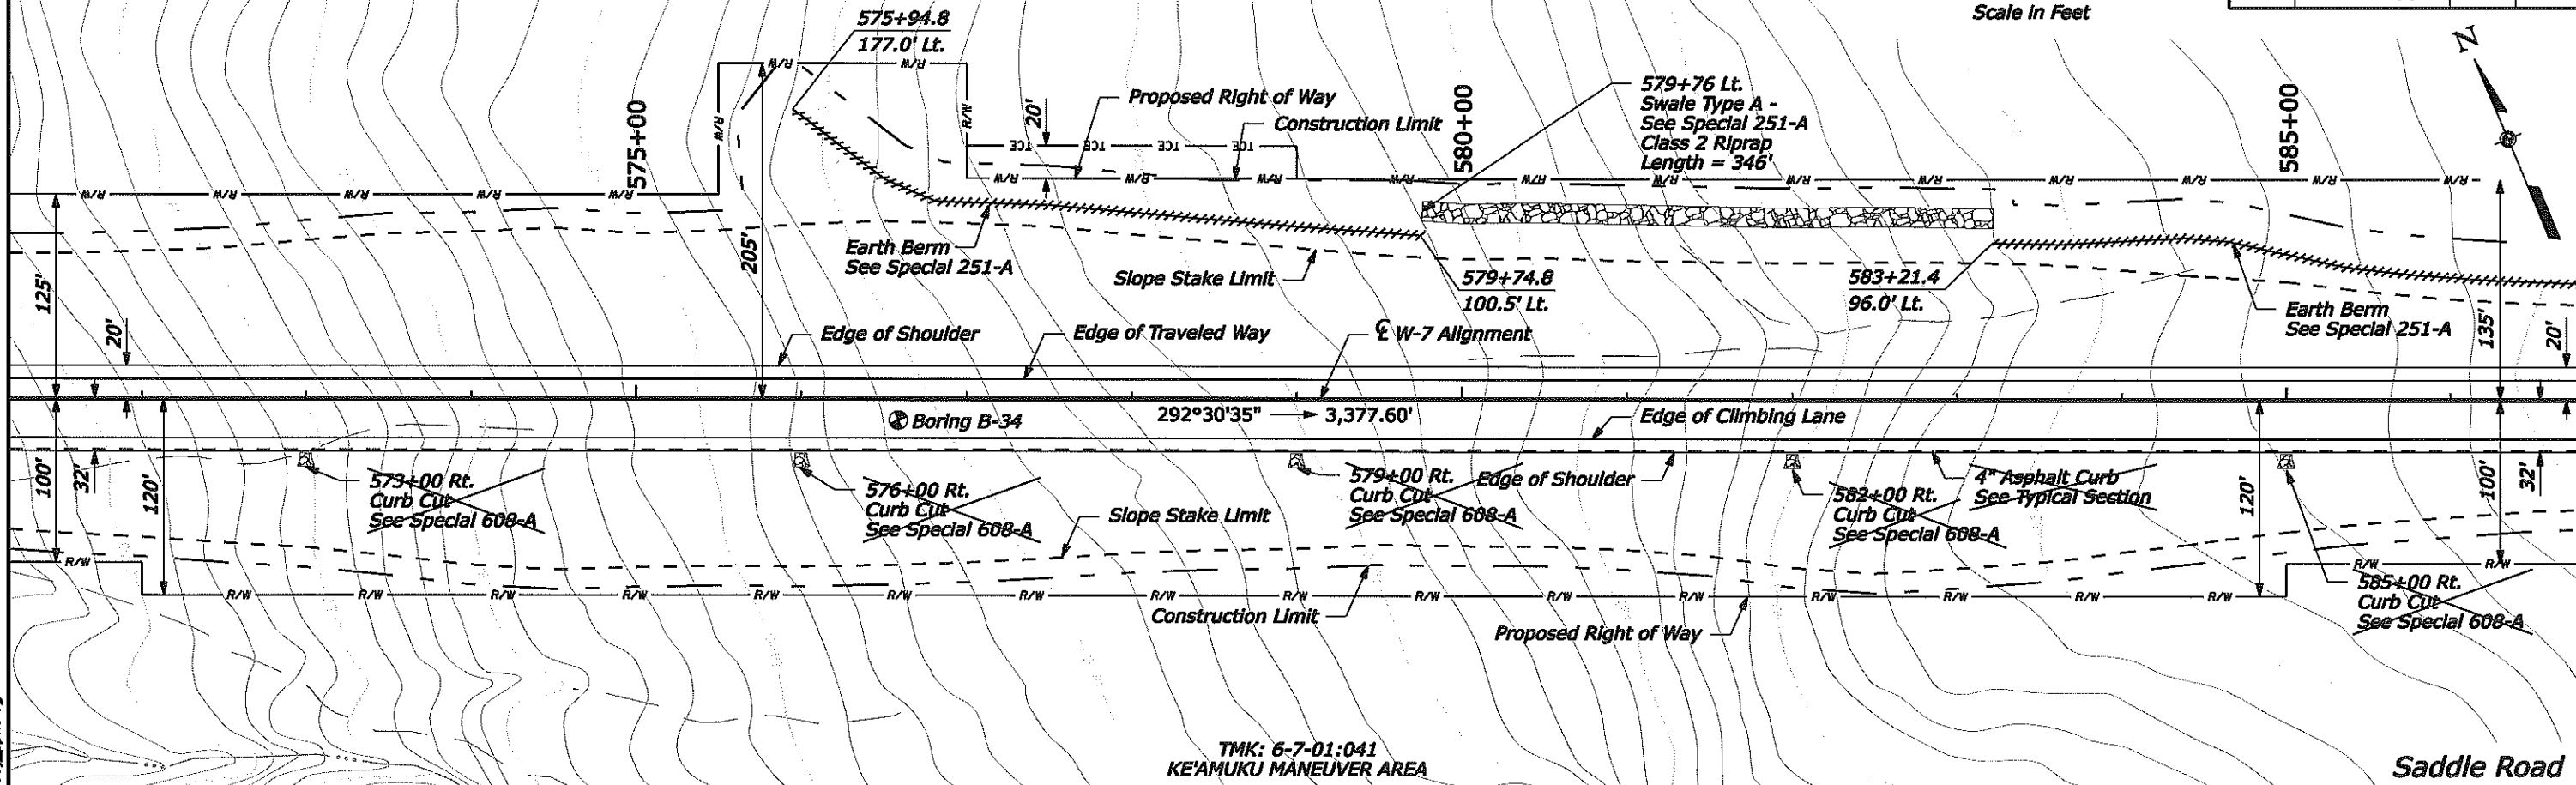

TMK: 6-7-01:041  
KE'AMUKU MANEUVER AREA

Saddle Road

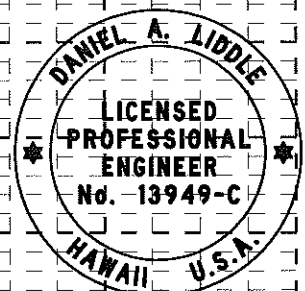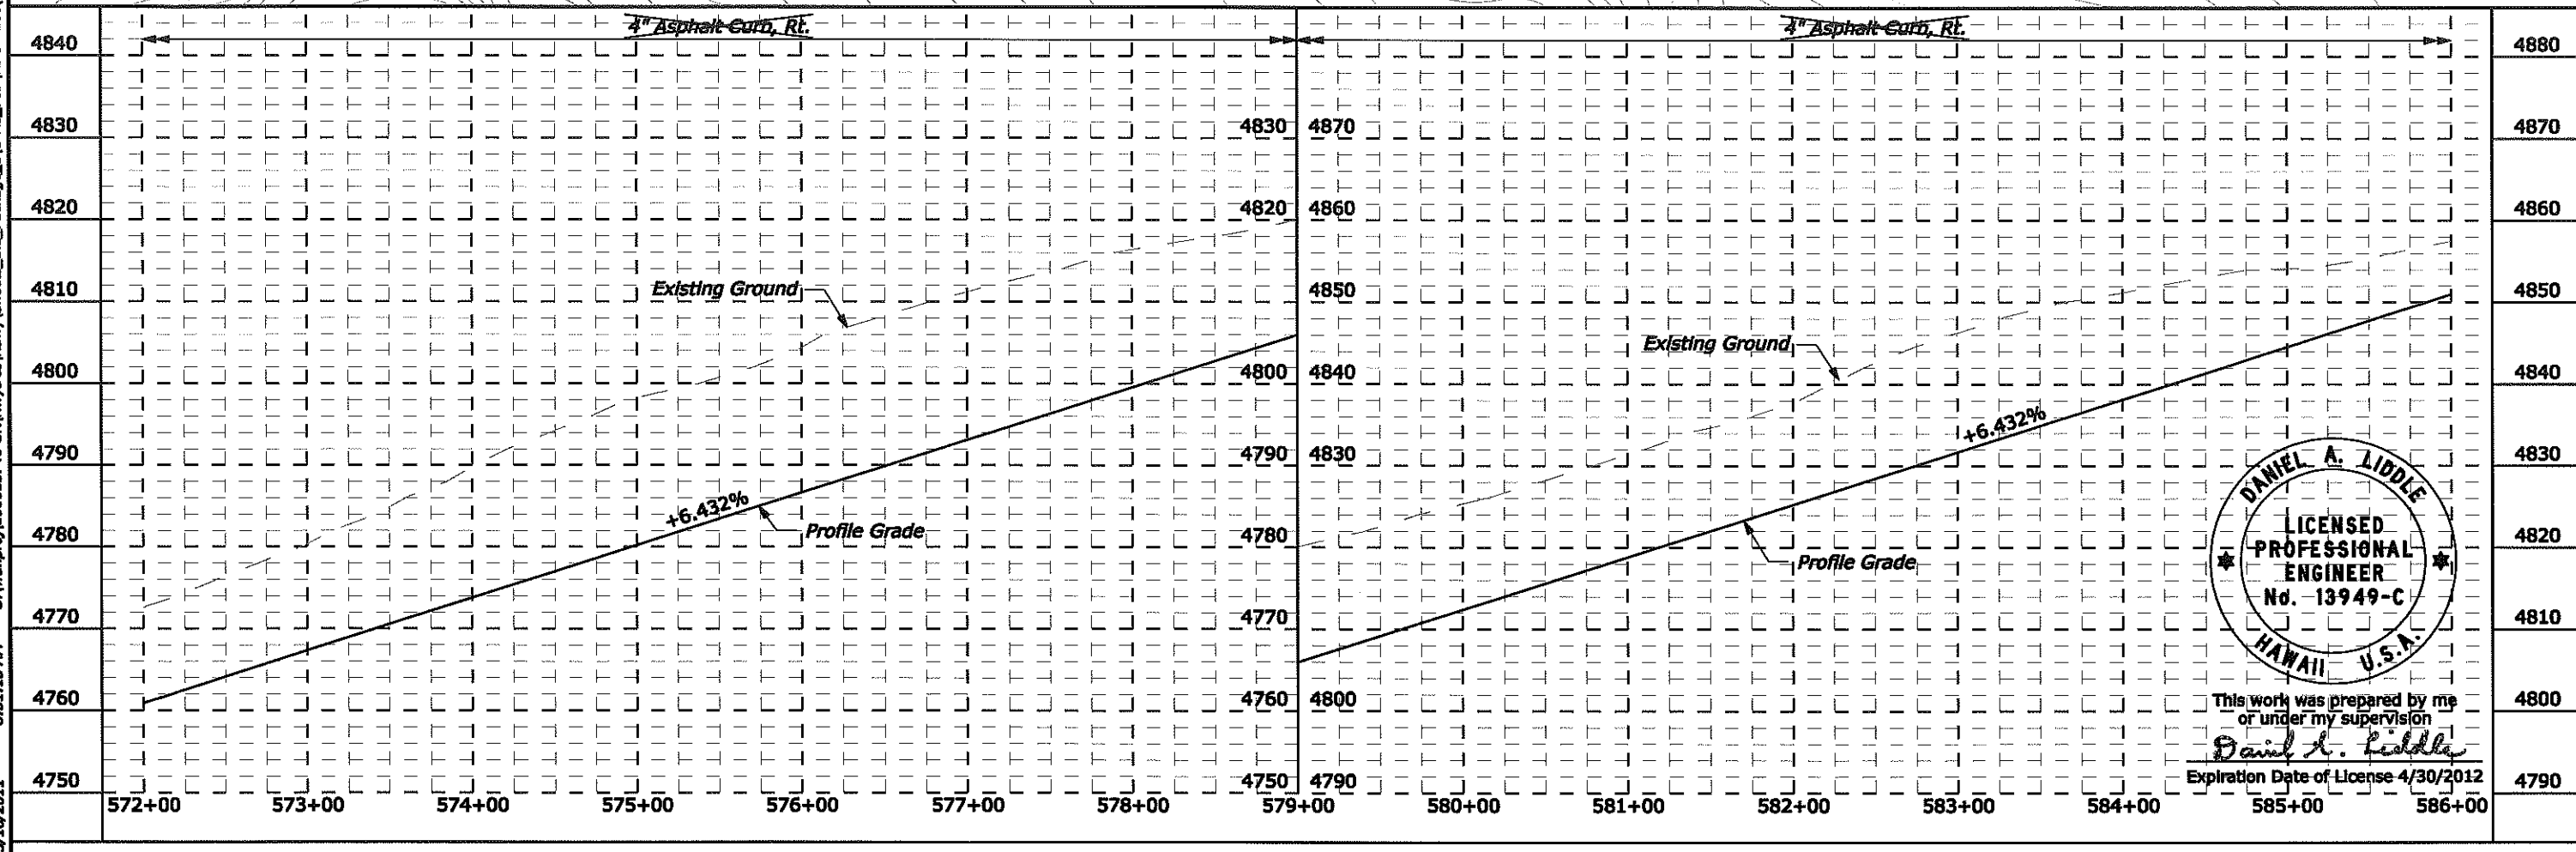


This work was prepared by me  
or under my supervision  
*Daniel A. Liddle*  
Expiration Date of License 4/30/2012





5/16/2011 8:52:01 AM S:\Transport\1000\13746-SR\HwyDes\Drawings\Sheets\_Bld\_Package\_1\C-M\_L\_P8P1H SR 200(00).pp29.dgn

TMK: 6-7-01:041  
KE'AMUKU MANEUVER AREA

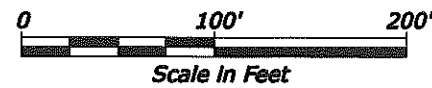



| STATE | PROJECT      | SHEET NO. | TOTAL SHEETS |
|-------|--------------|-----------|--------------|
| HI    | HI A-AD 6(6) | C29       | C38          |

Curve = MAIN-10  
PI 621+89.71  
 $\Delta = 66^\circ 42' 05''$  (LT)  
R = 3,670.00'  
T = 2,415.38'  
L = 4,272.45'  
e = 4.40%

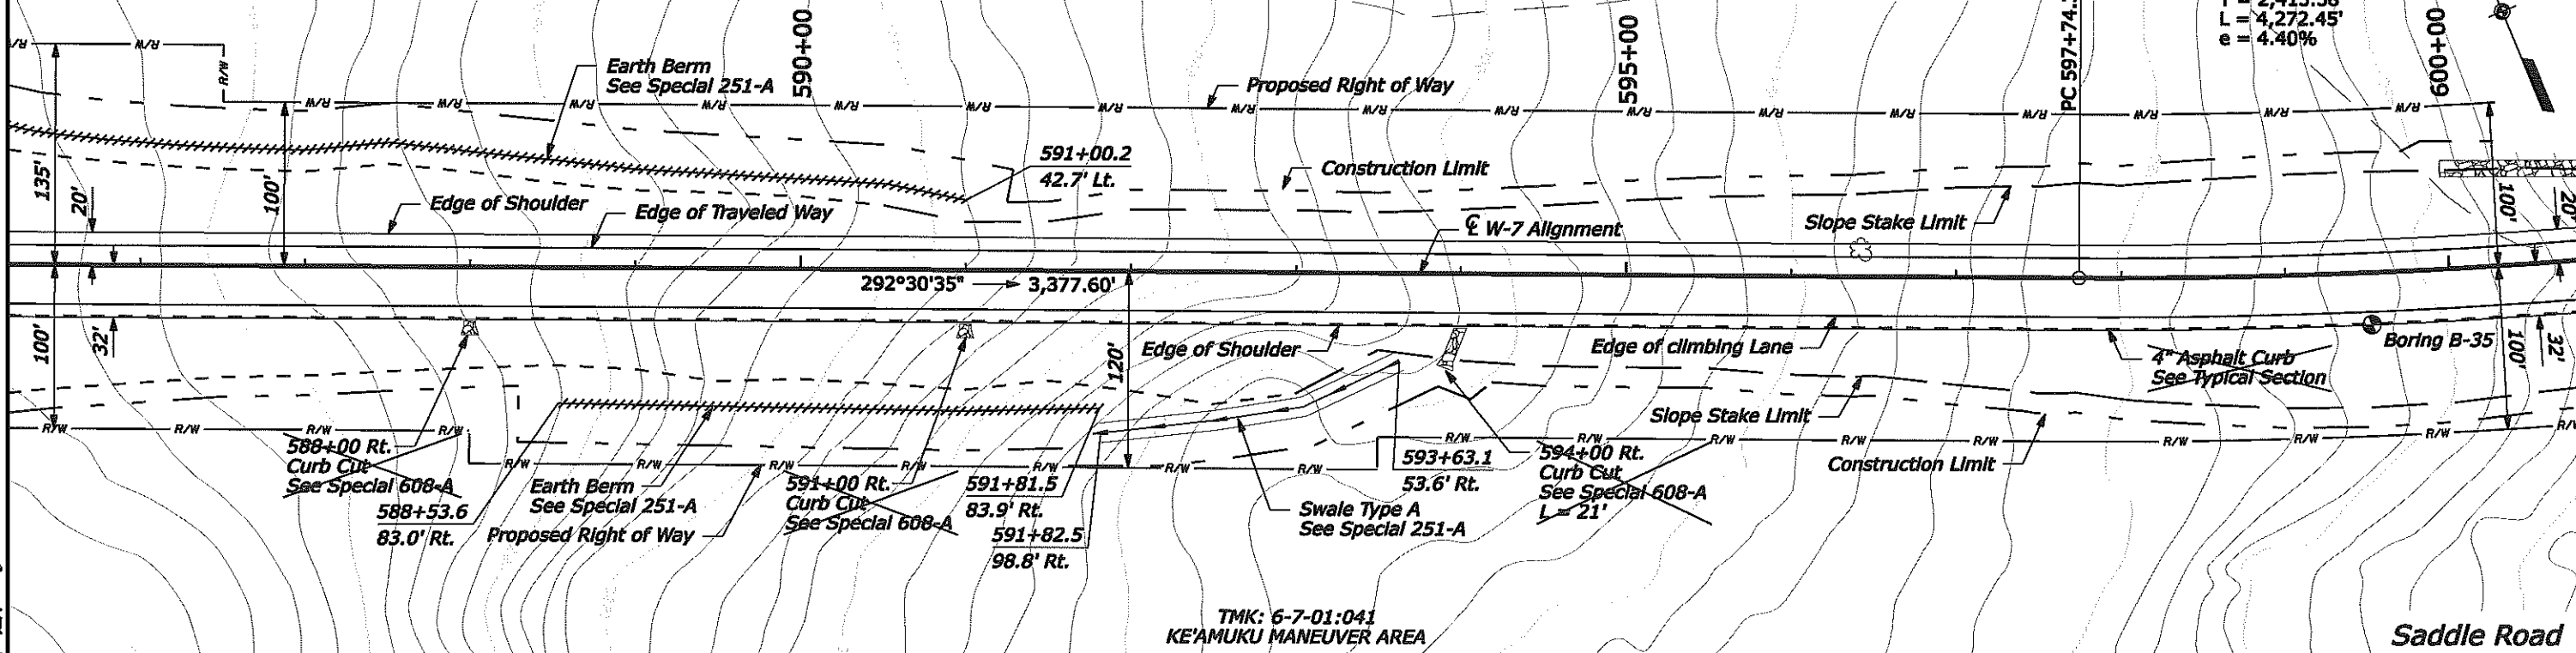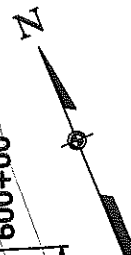

TMK: 6-7-01:041  
KE'AMUKU MANEUVER AREA


Saddle Road

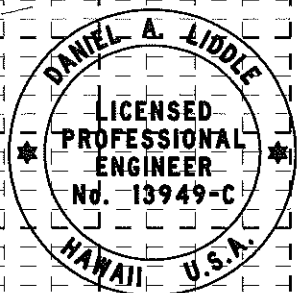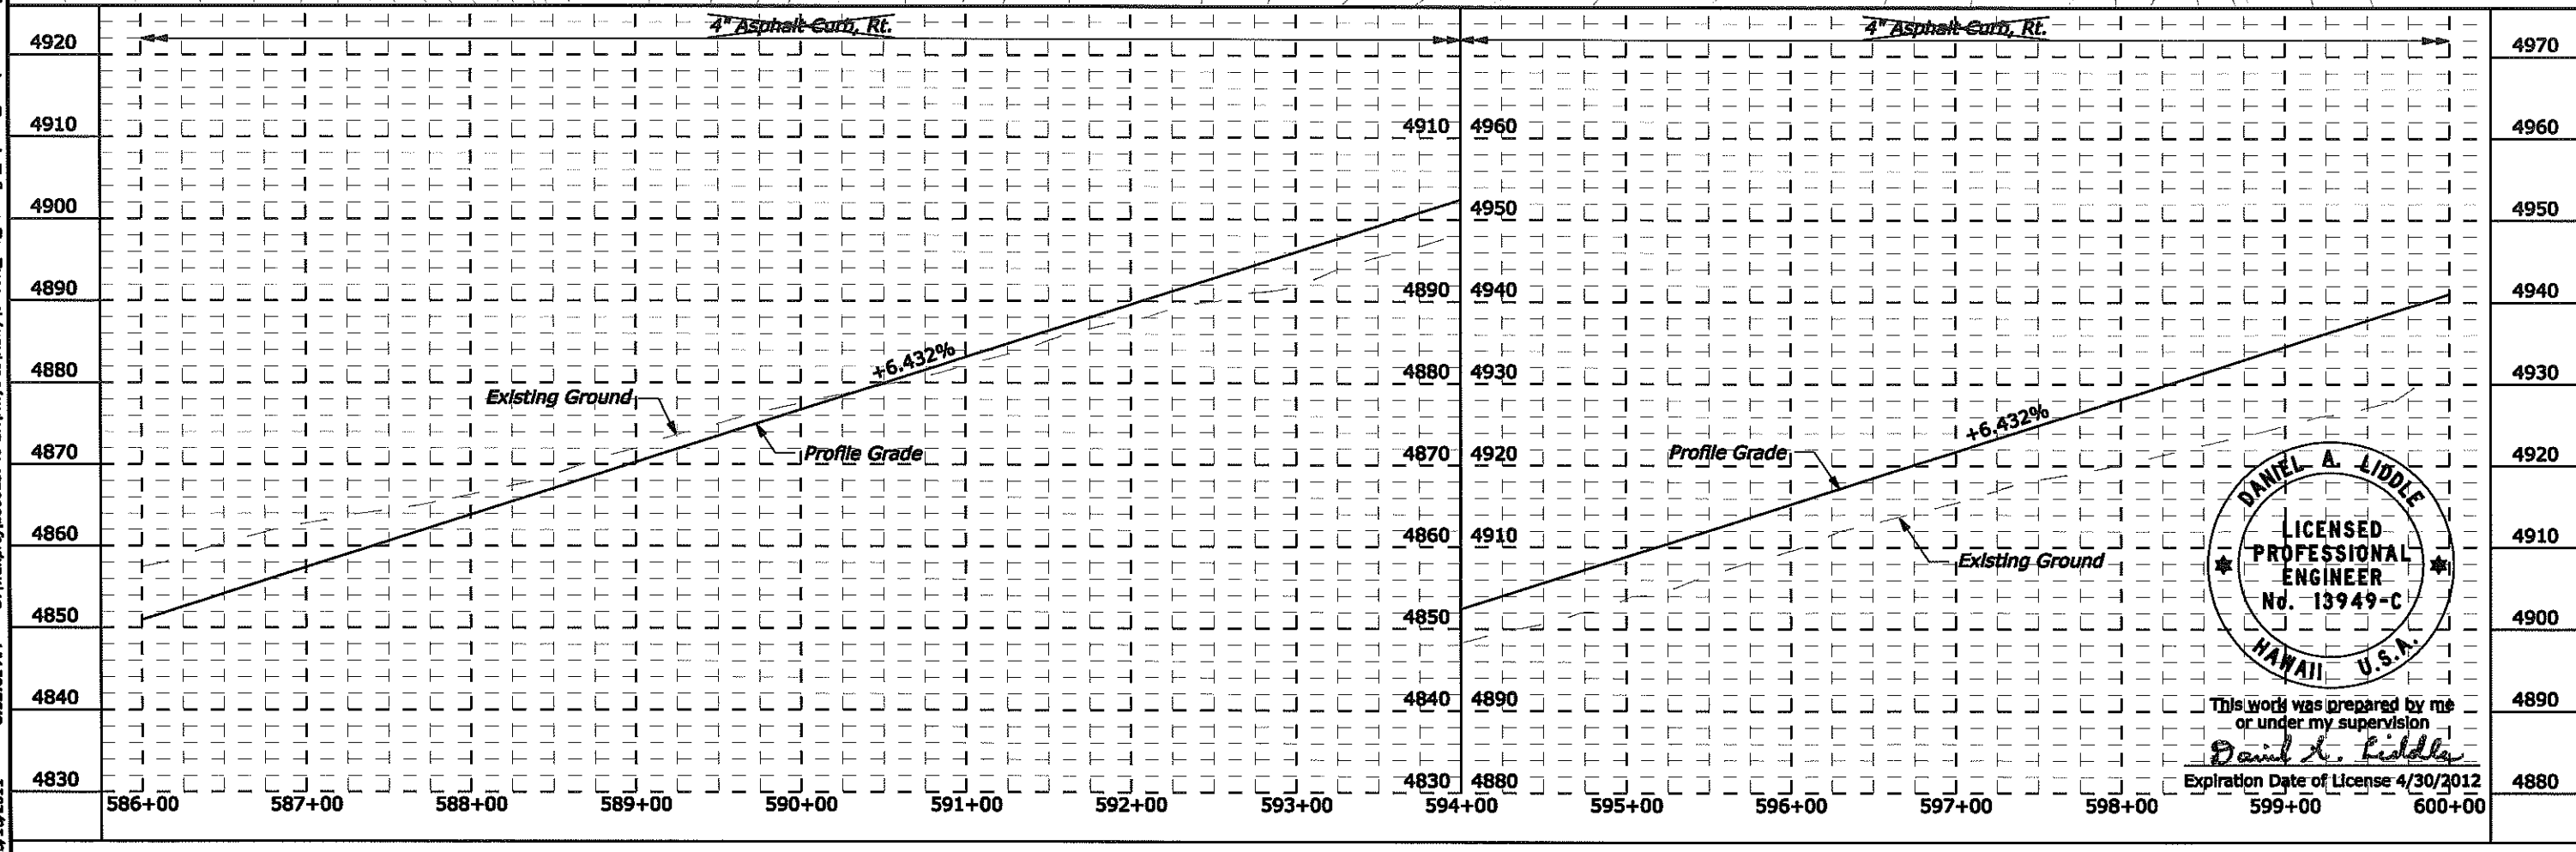

This work was prepared by me  
or under my supervision  
*Daniel A. Liddle*  
Expiration Date of License 4/30/2012




5/18/2011 6:28:24 AM S:\Transport\100013746-SR\HwyDes\Drawings\Sheets\_Bld\_Package\_1\C-MIL\_Peaplt SR 200(00)\_pp30.dgn

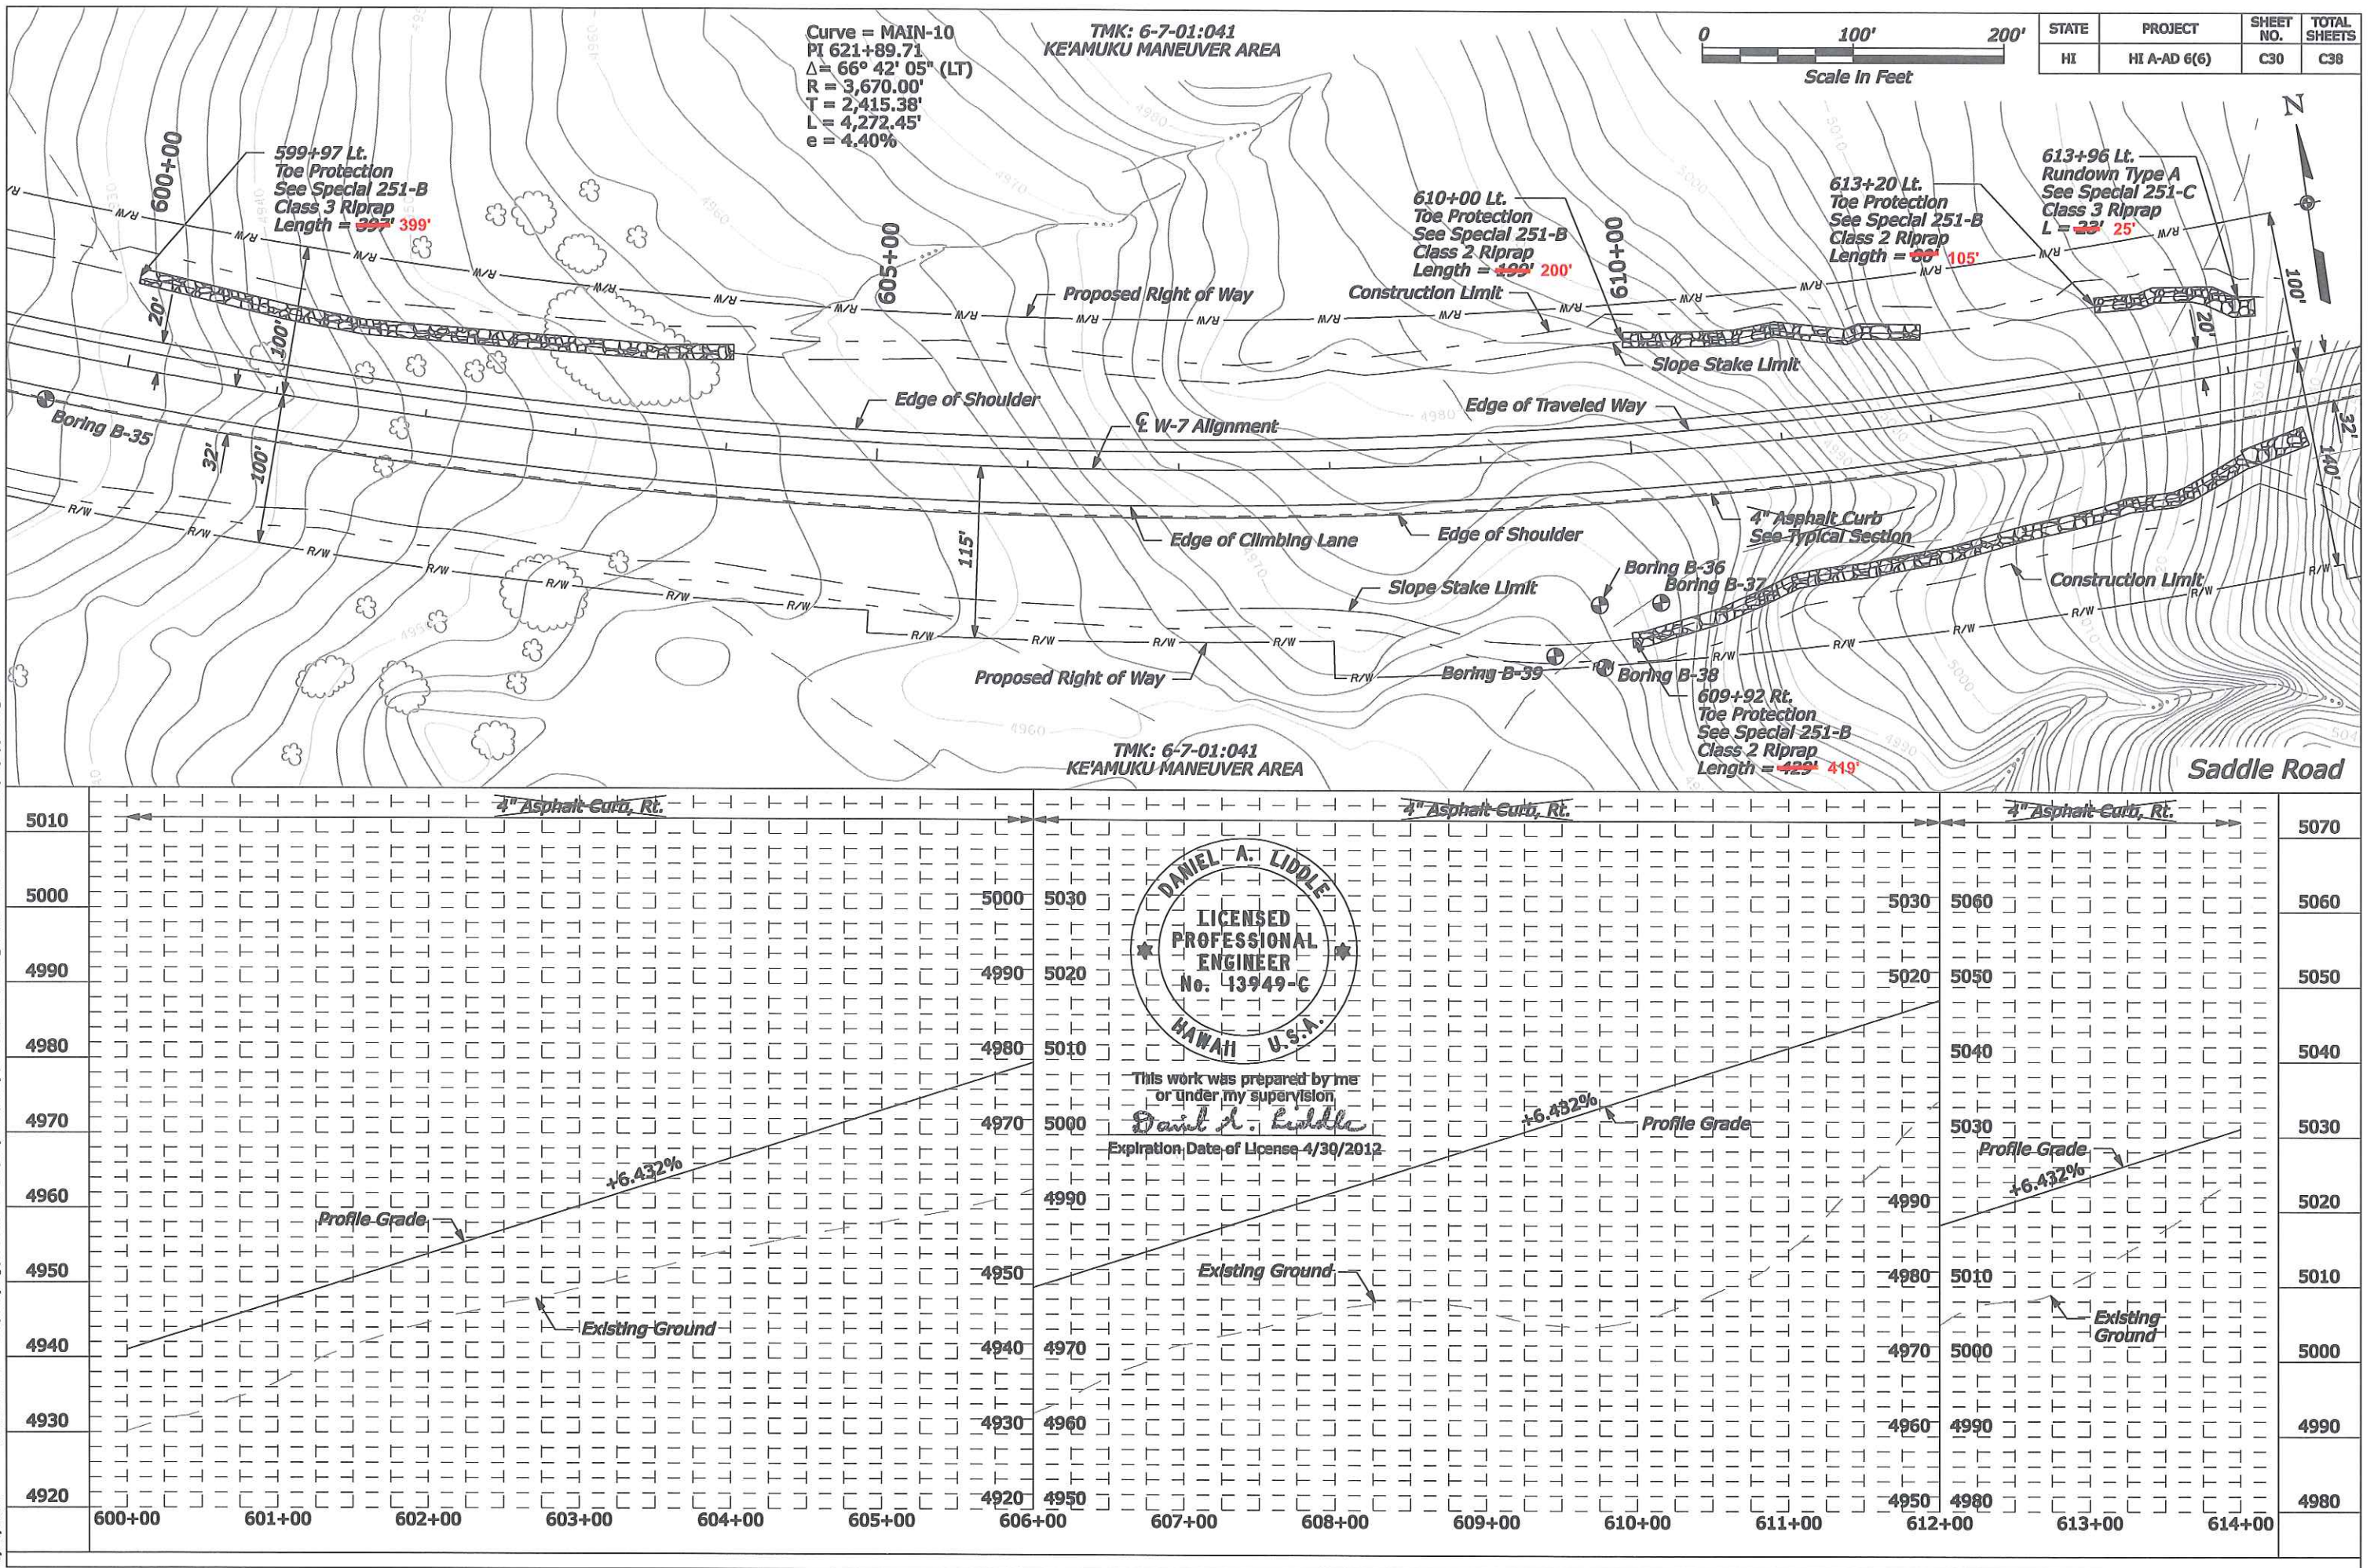



5/16/2011 8:56:47 AM S:\Temp\proj\100013746-SR\HwyDes\Roadway\Sheets\_Bld\_Package\_1\C-MIL\_PEP\Hwy SR 200(00)\_pp31.dgn

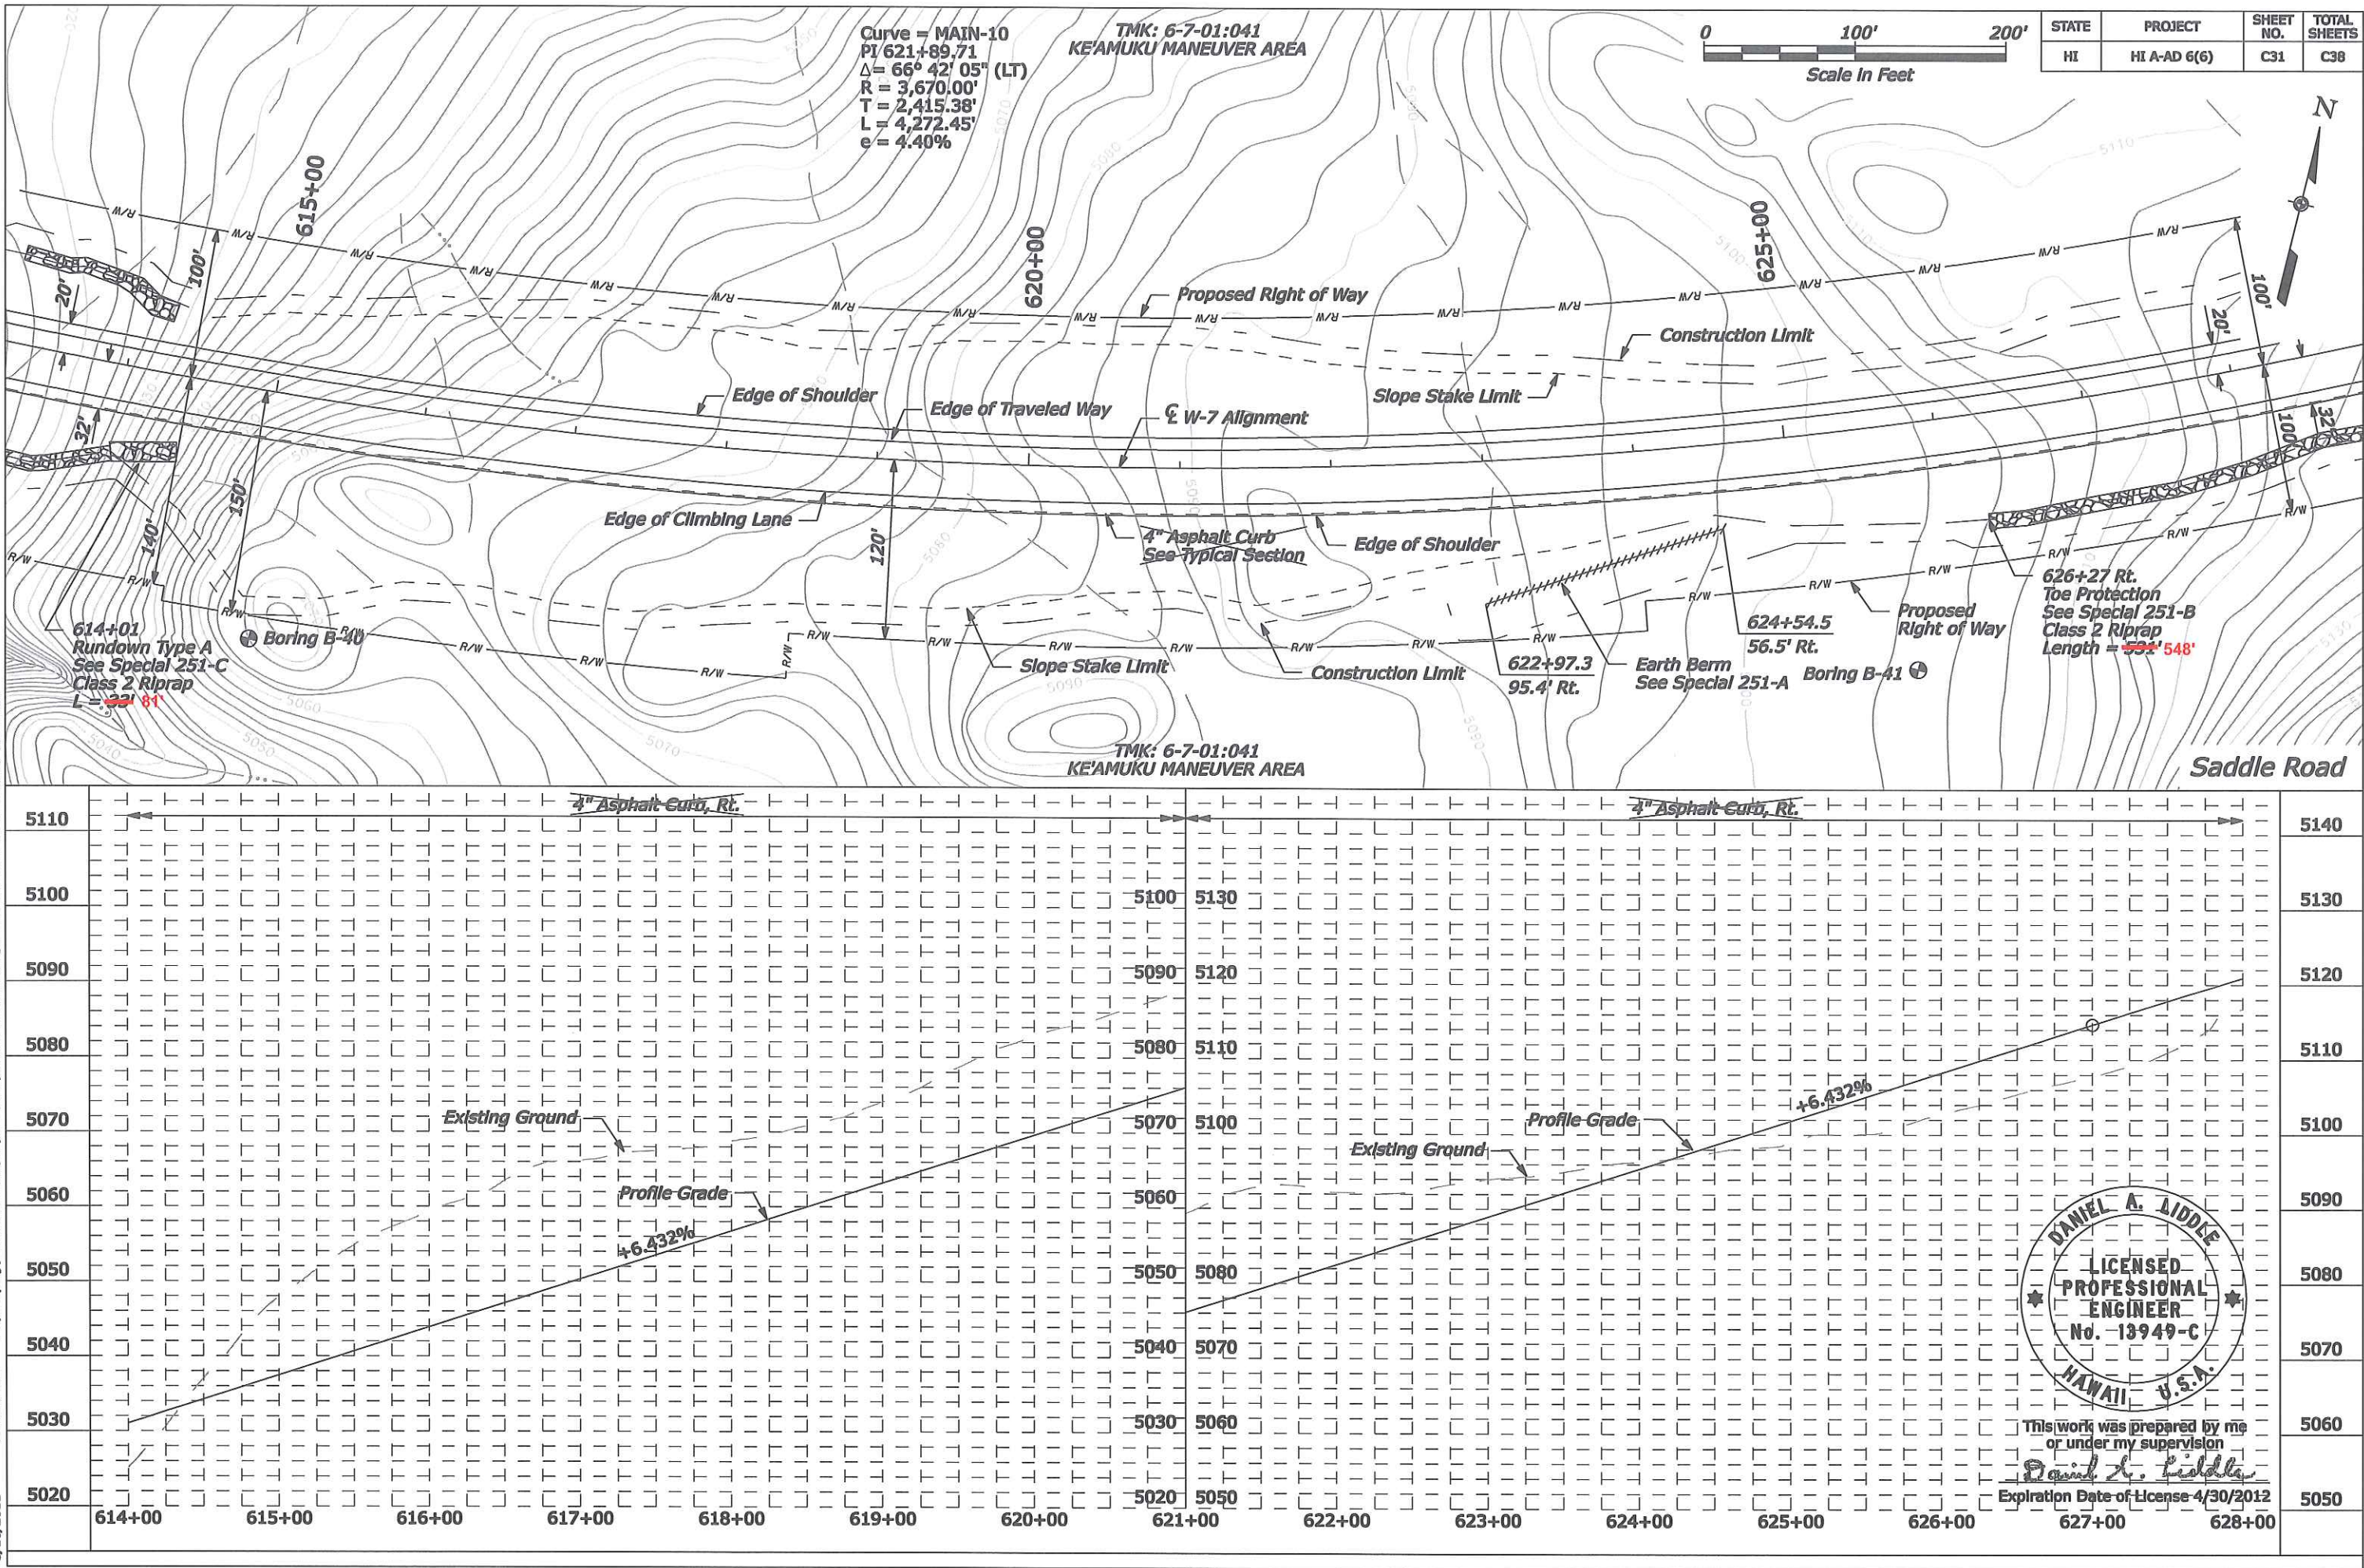







5/16/2011 8:57:40 AM S:\Transport\100013746-SR\HwyDes\Drawings\Sheets\_Bld\_Package\_1\1C-ML\_P&P\HI SR 200(00)\_pp32.dgn

Curve = MAIN-10  
PI 621+89.71  
 $\Delta = 66^\circ 42' 05''$  (LT)  
R = 3,670.00'  
T = 2,415.38'  
L = 4,272.45'  
e = 4.40%

TMK: 6-7-01:041  
KE'AMUKU MANEUVER AREA

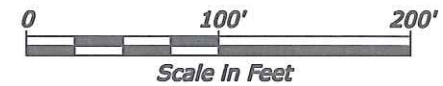

| STATE | PROJECT      | SHEET NO. | TOTAL SHEETS |
|-------|--------------|-----------|--------------|
| HI    | HI A-AD 6(6) | C32       | C38          |

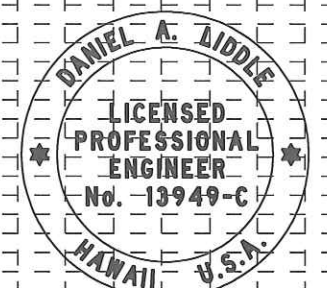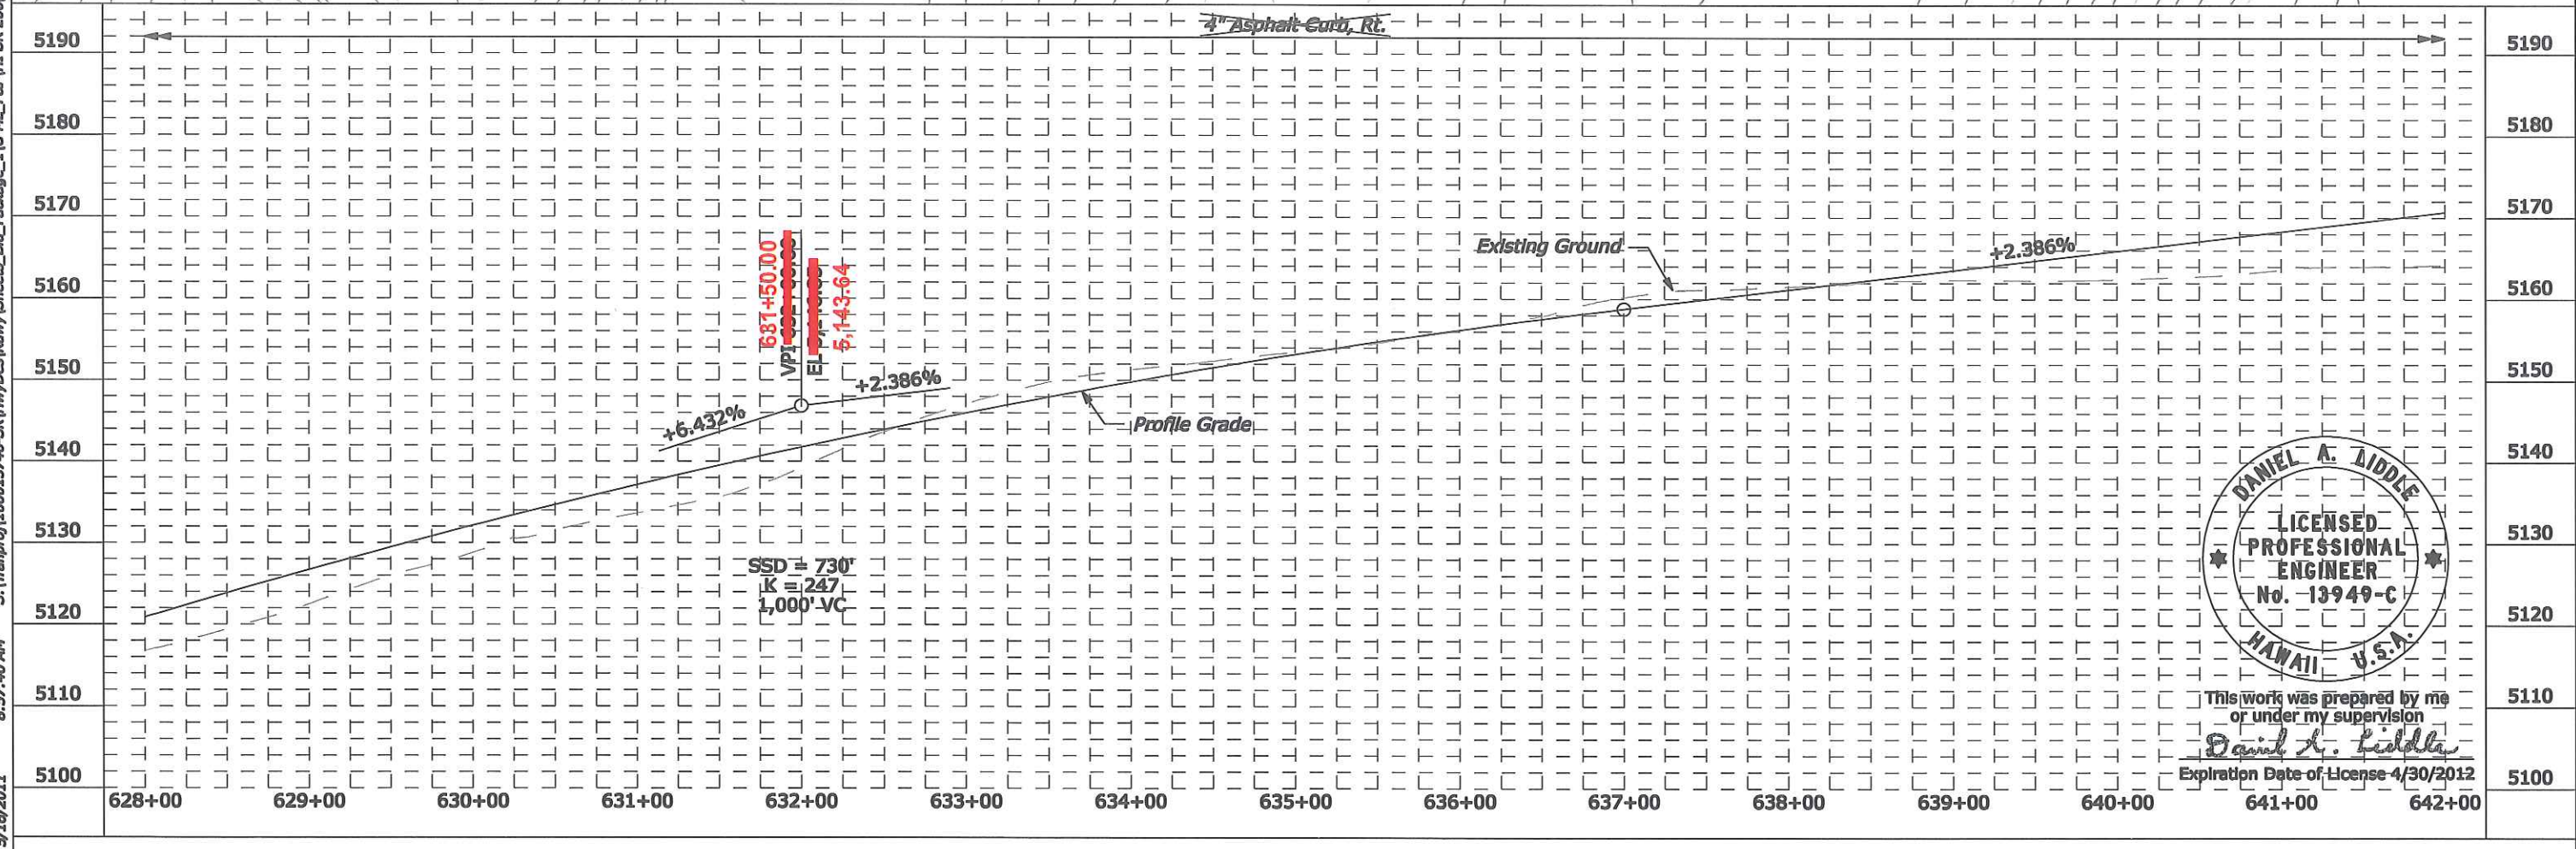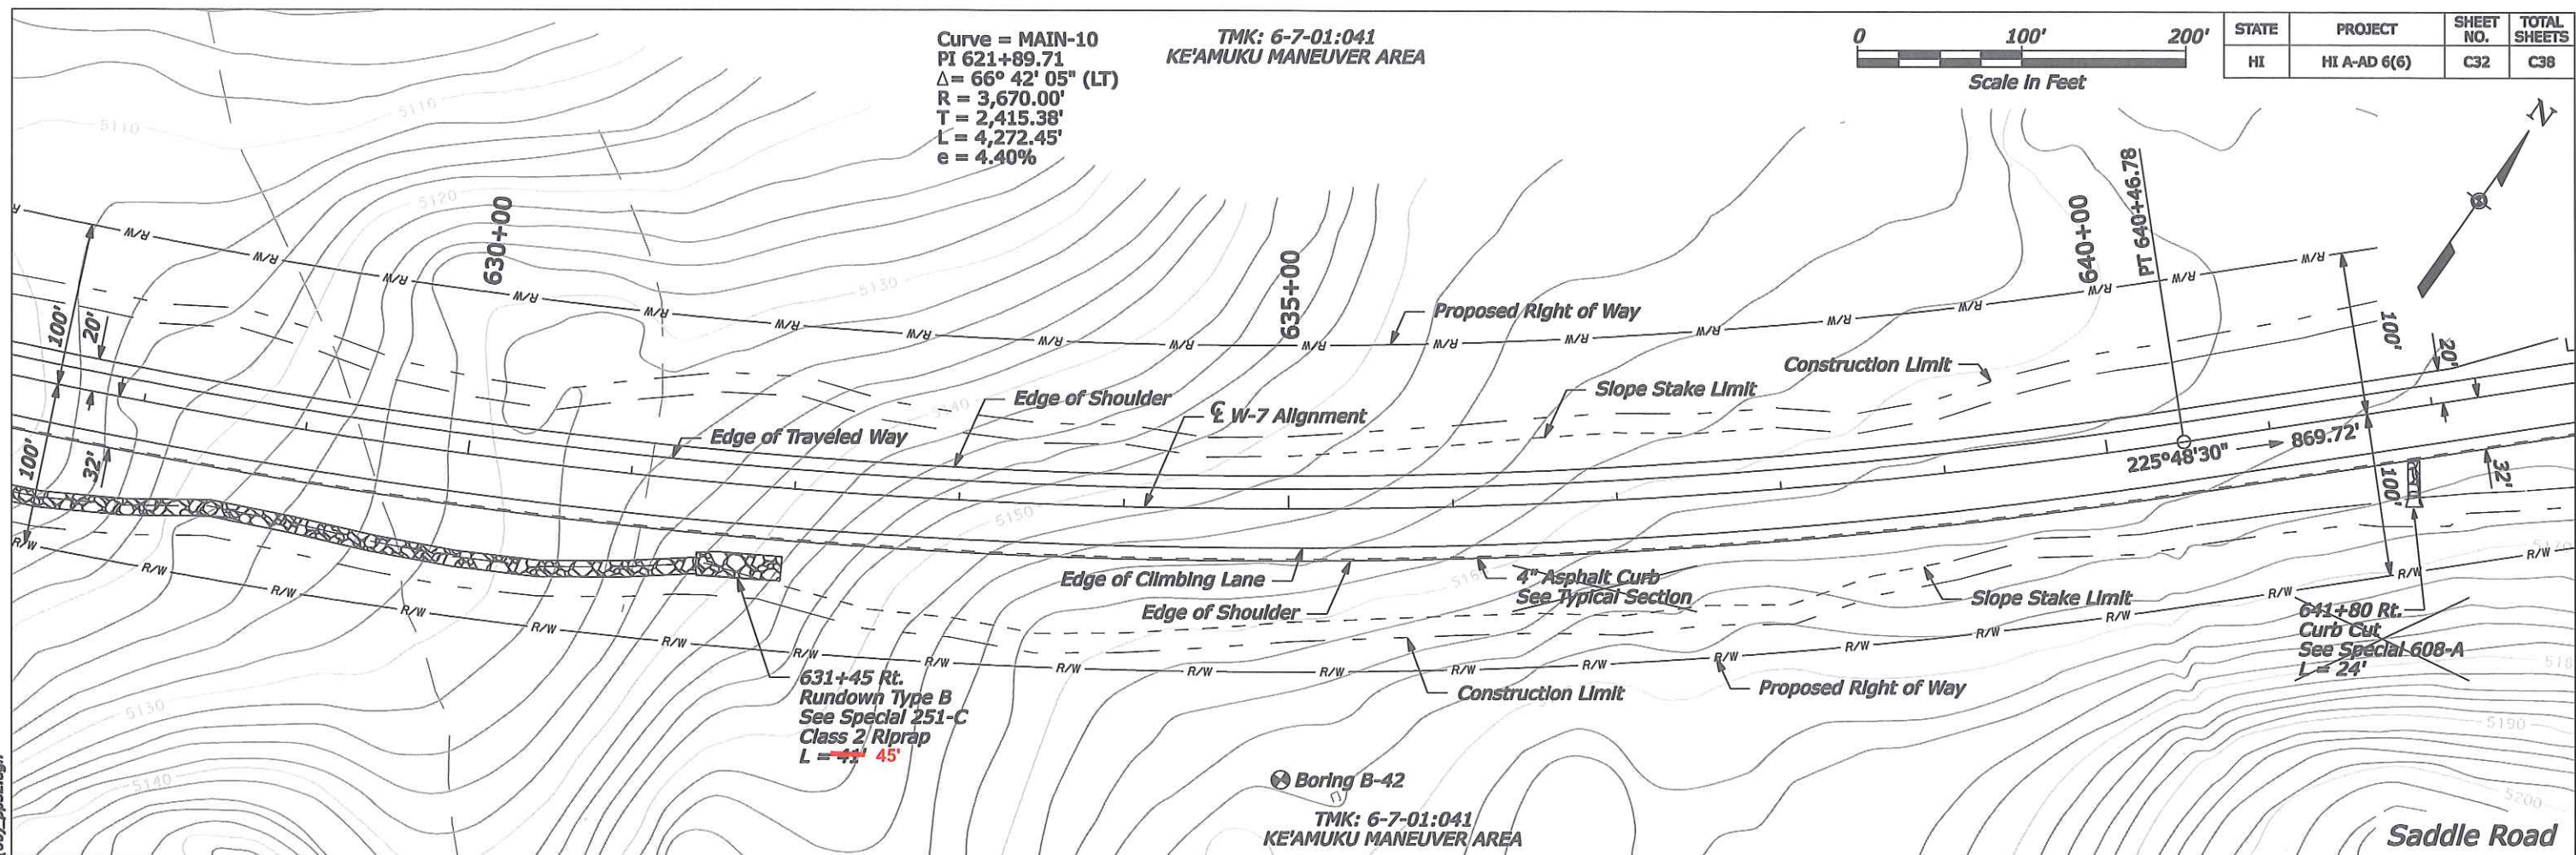


This work was prepared by me  
or under my supervision  
*Daniel A. Liddle*  
Expiration Date of License 4/30/2012








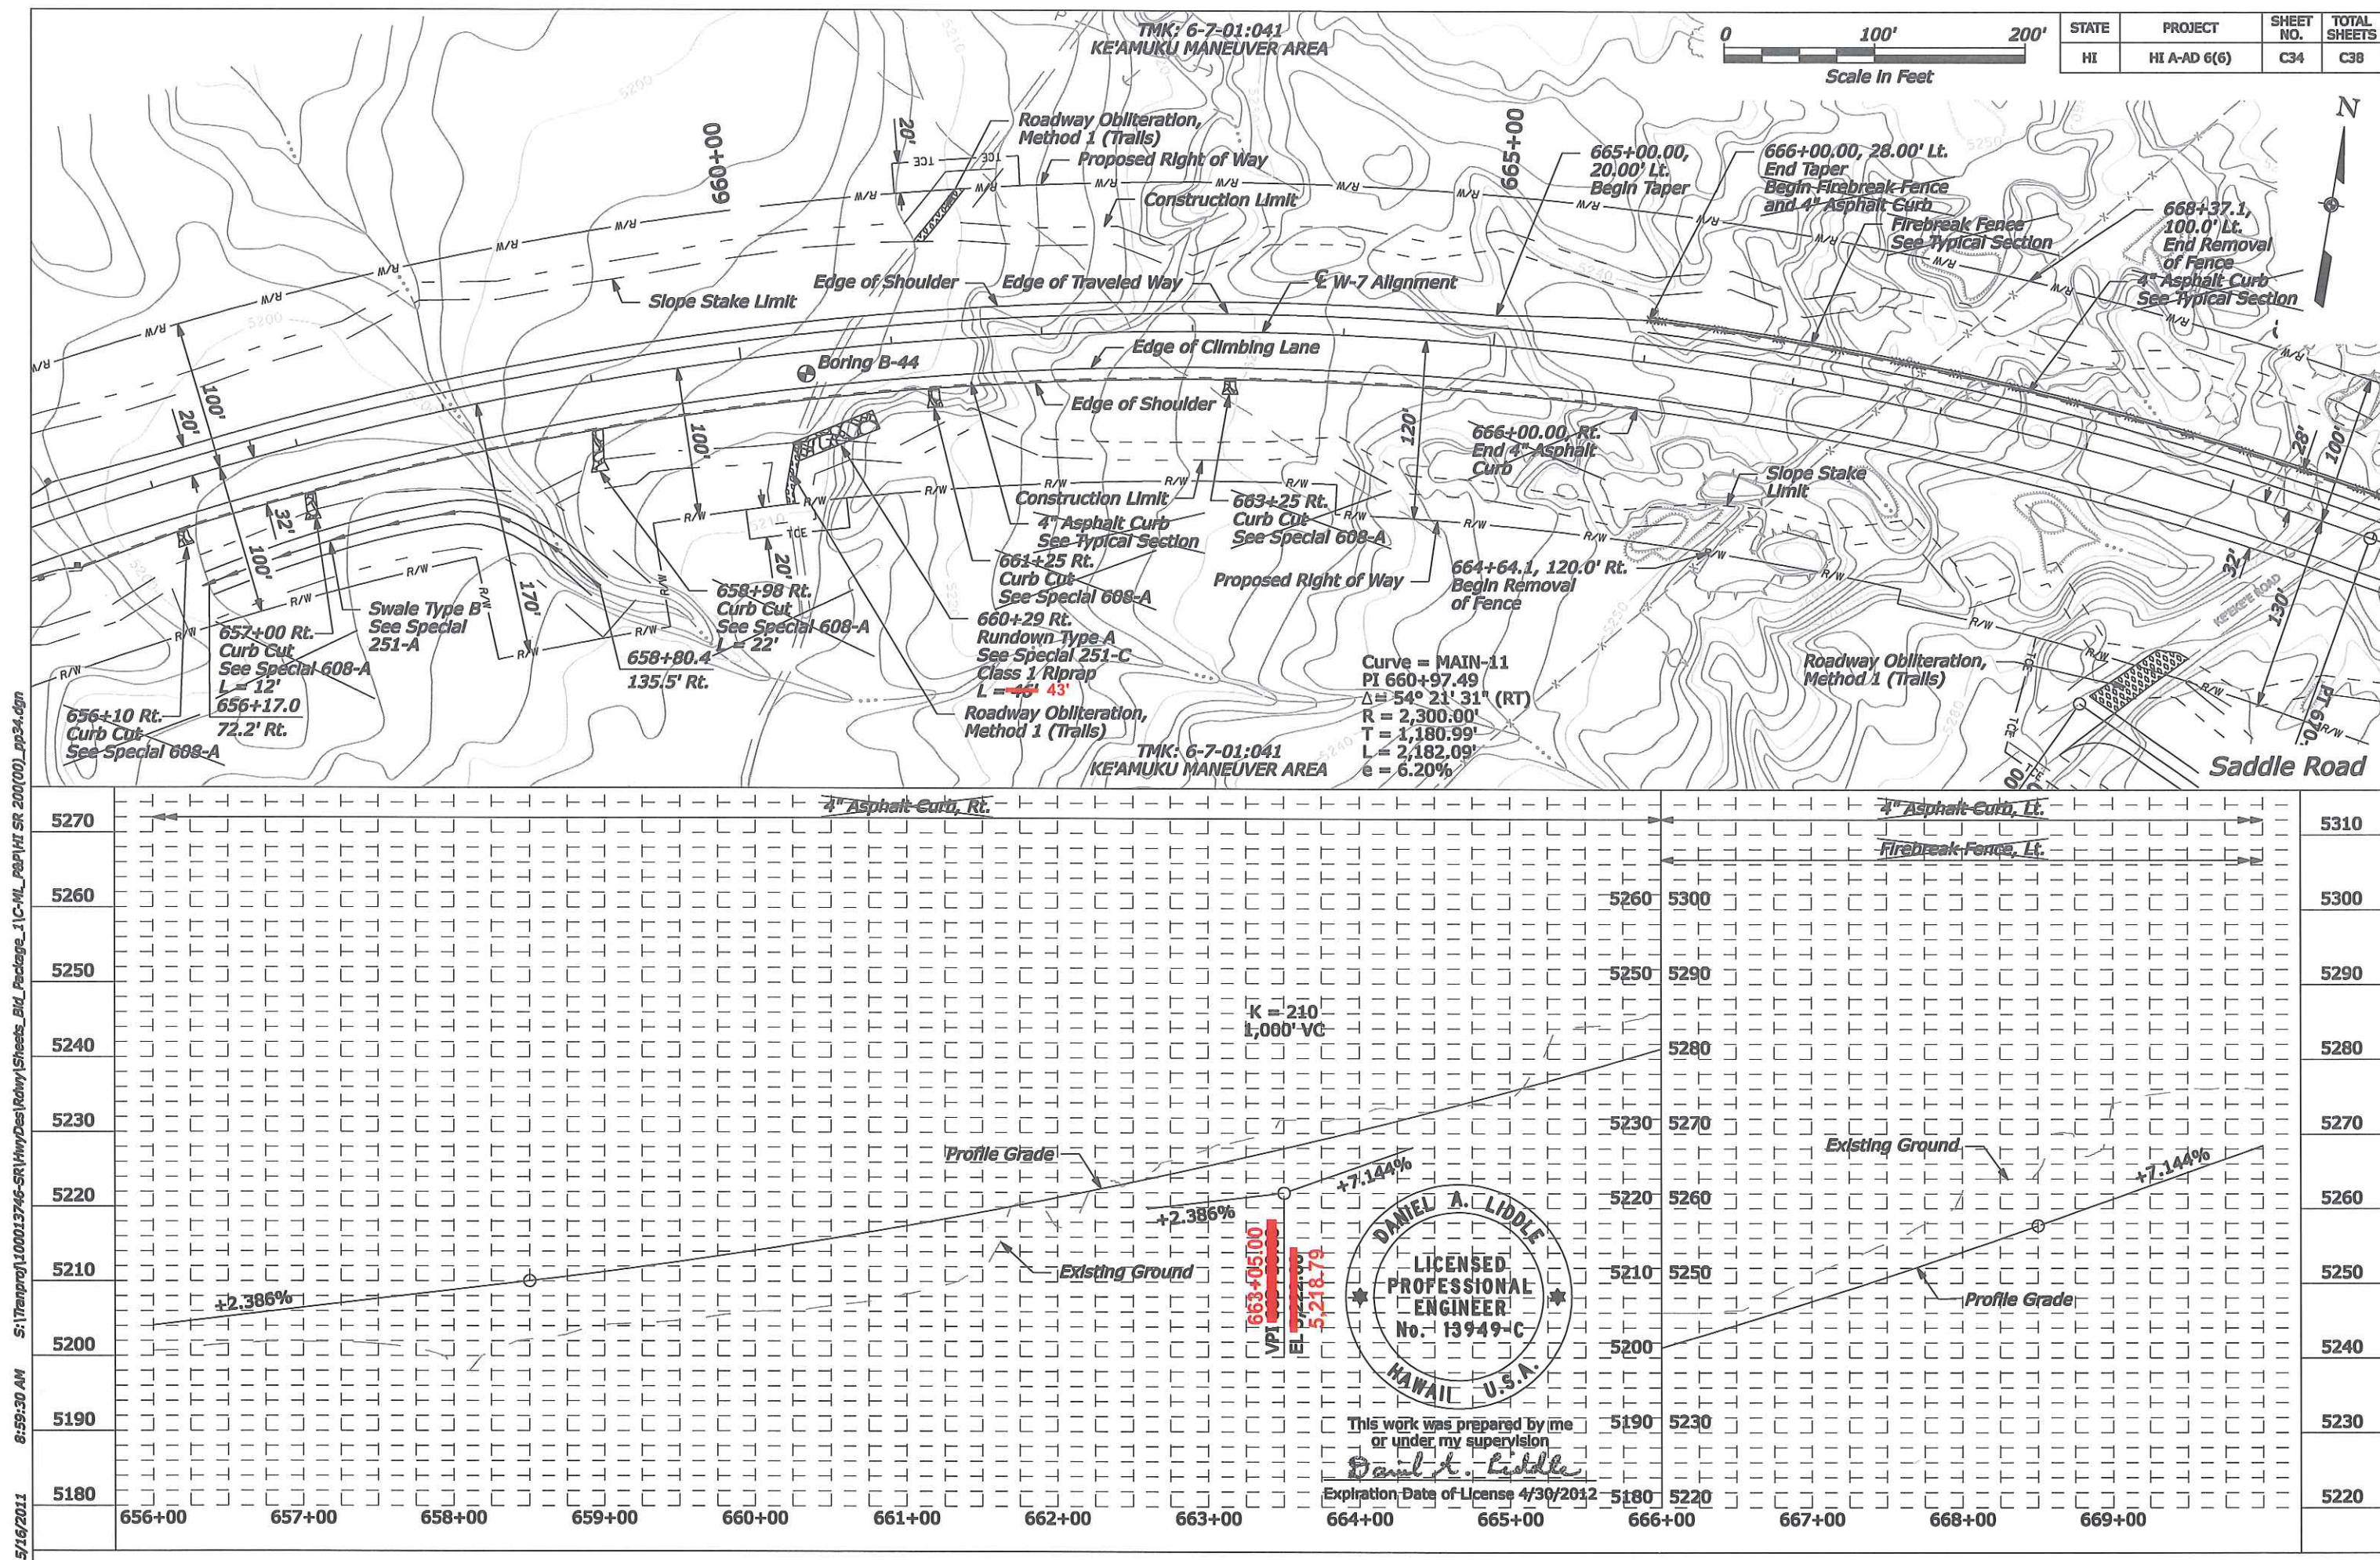




S:\Tranpro\100013746-SR\HwyDes\Draw\Sheets\_Bld\_Package\_1\C-HL\_Pkg\HI SR 200(00).pp35.dgn 5/16/2011 9:00:26 AM

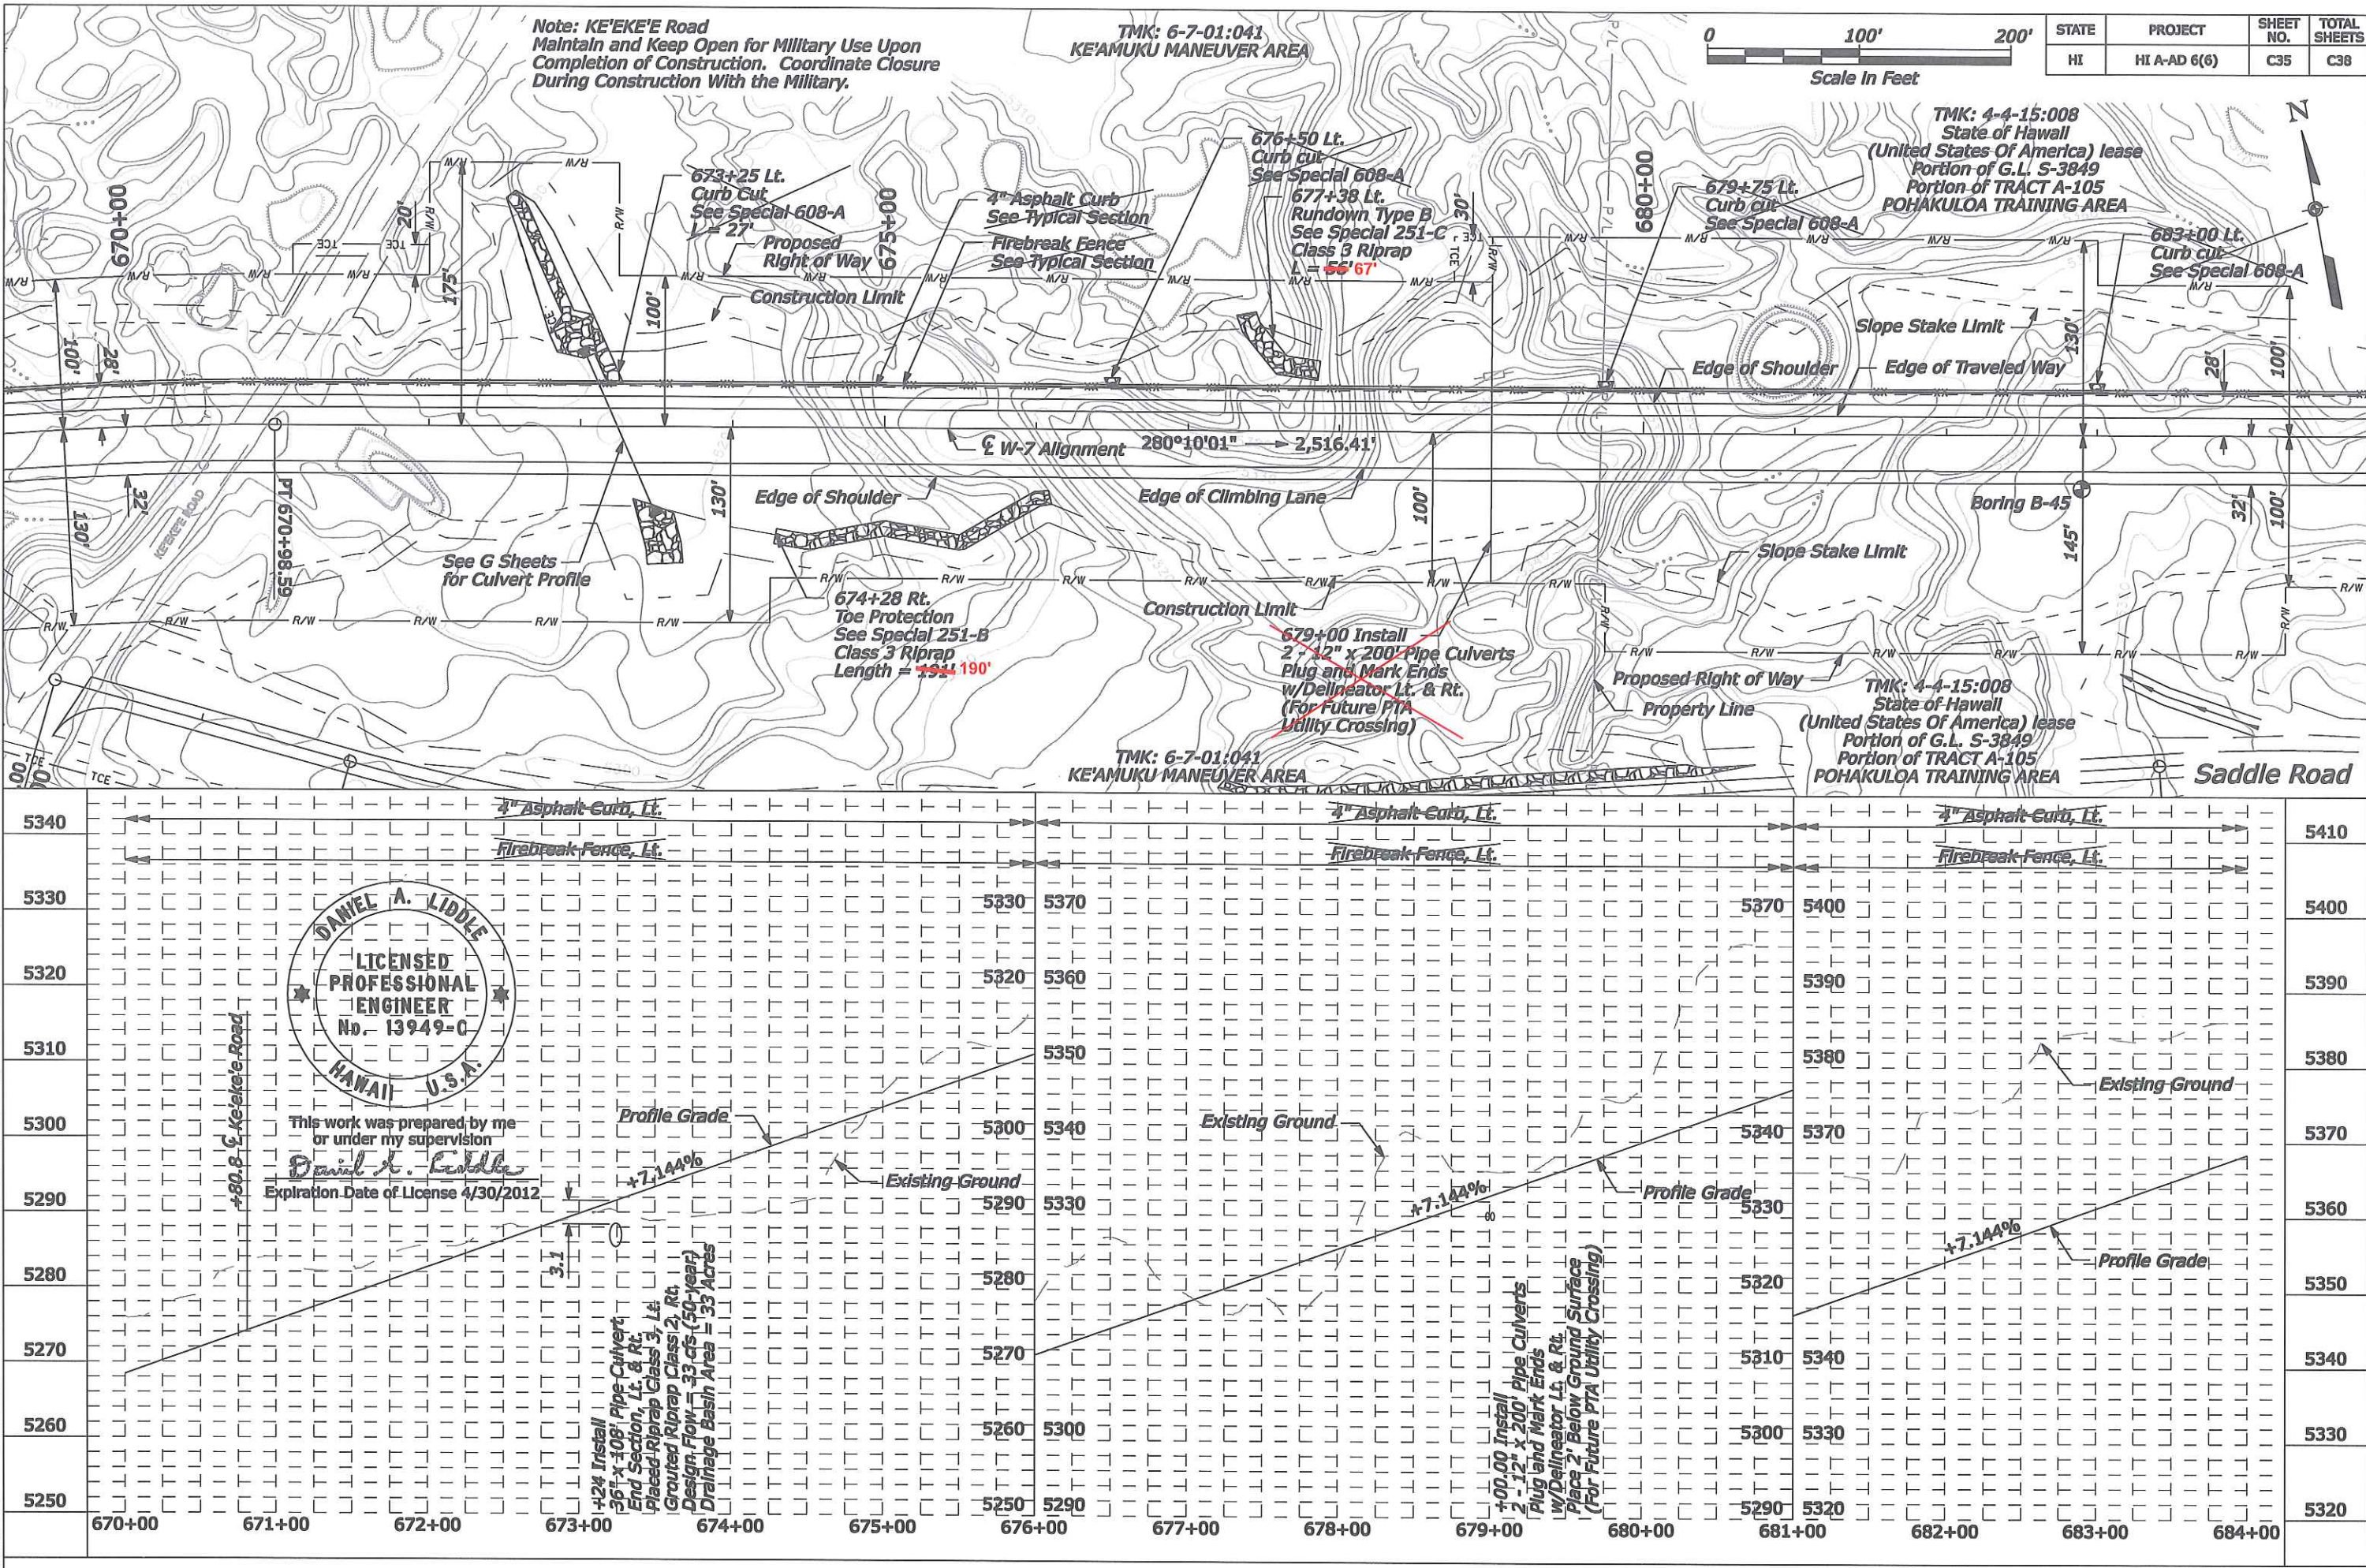






5/16/2011 9:04:29 AM S:\Temp\proj\100013746-SR\HwyDes\Drawings\Sheets\_Bld\_Package\_1\IC-MIL\_P8P\H1 SR 200(00)\_pp36.dgn

TMK: 4-4-15:008  
State of Hawaii  
(United States Of America) lease  
Portion of G.L. S-3849  
Portion of TRACT A-105  
POHAKULOLO TRAINING AREA

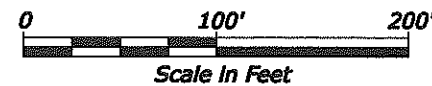

| STATE | PROJECT      | SHEET NO. | TOTAL SHEETS |
|-------|--------------|-----------|--------------|
| HI    | HI A-AD 6(6) | C36       | C38          |

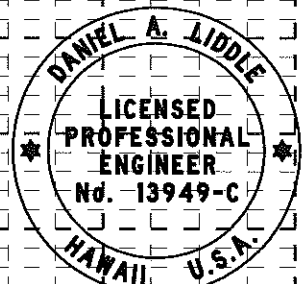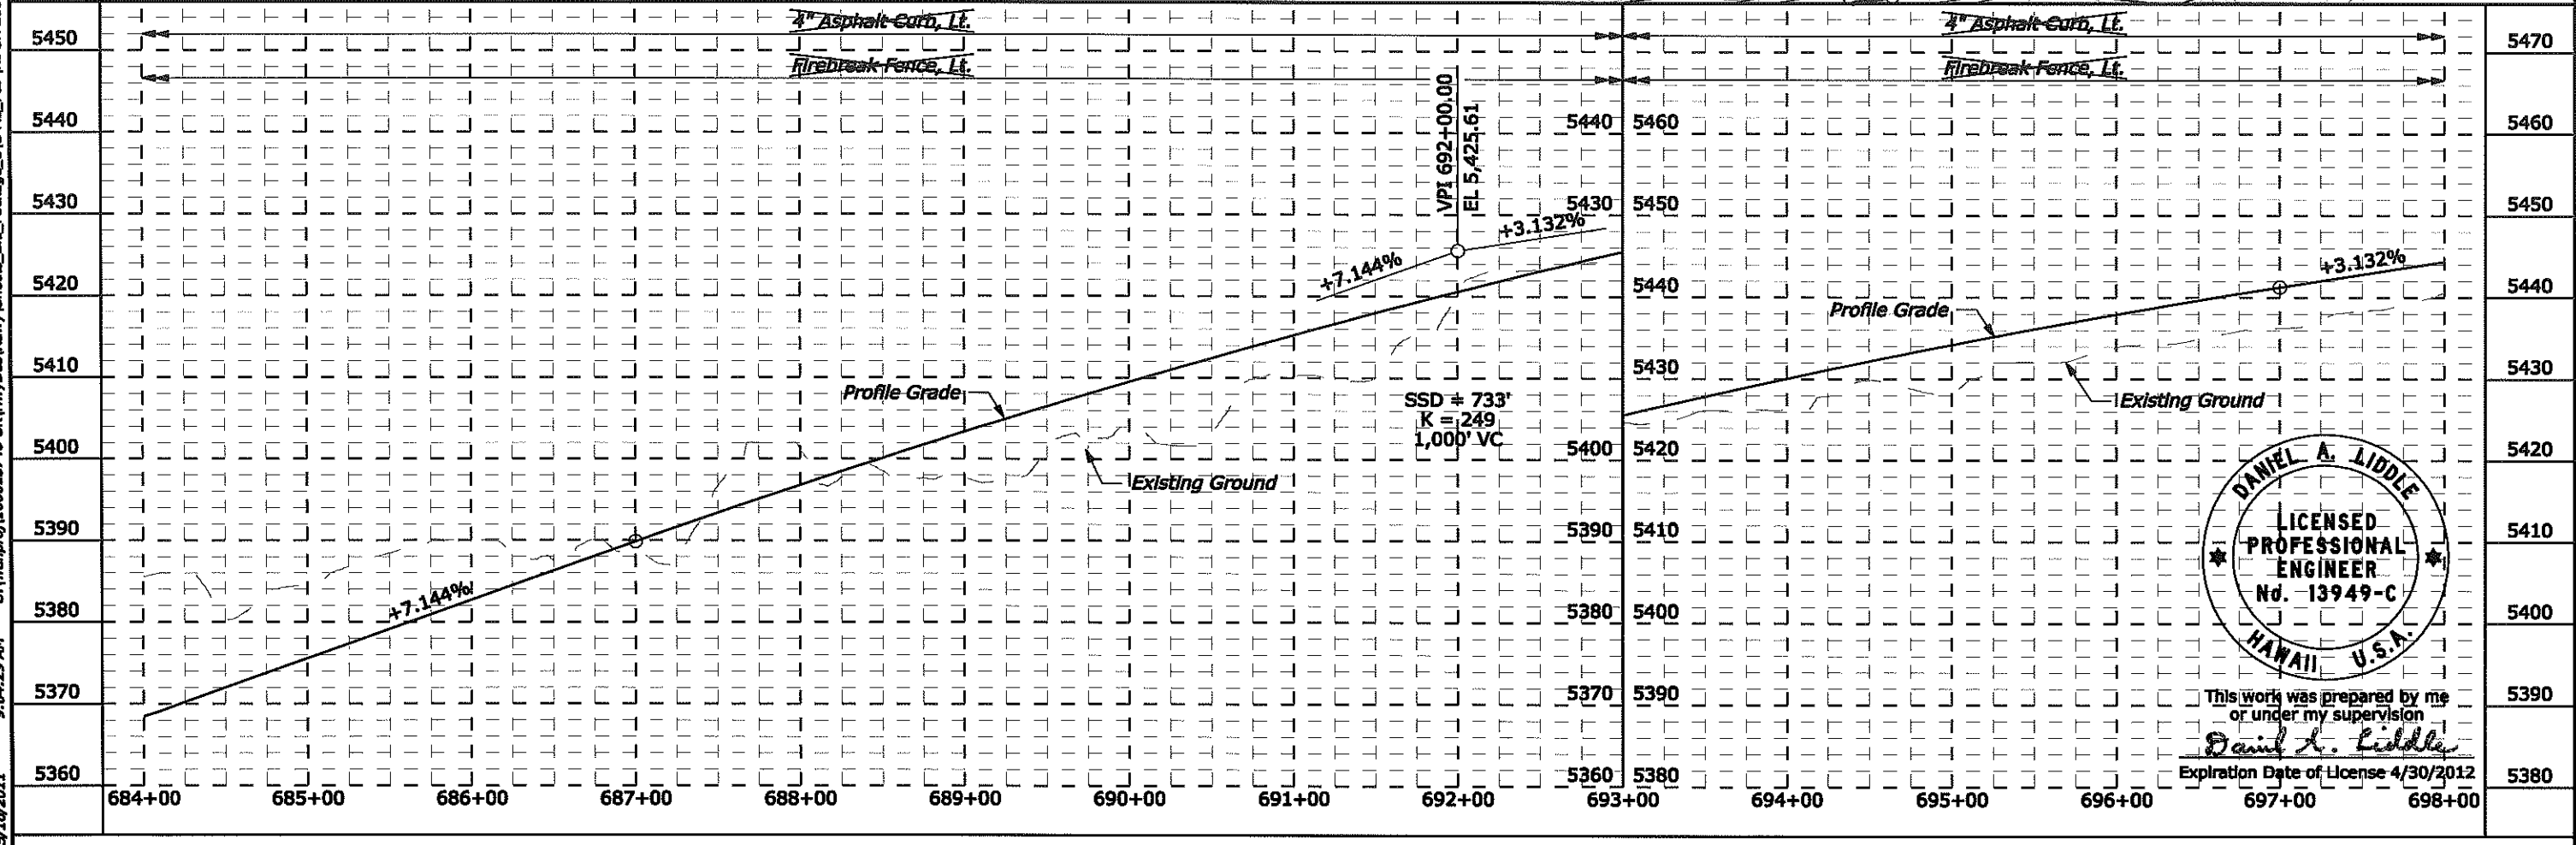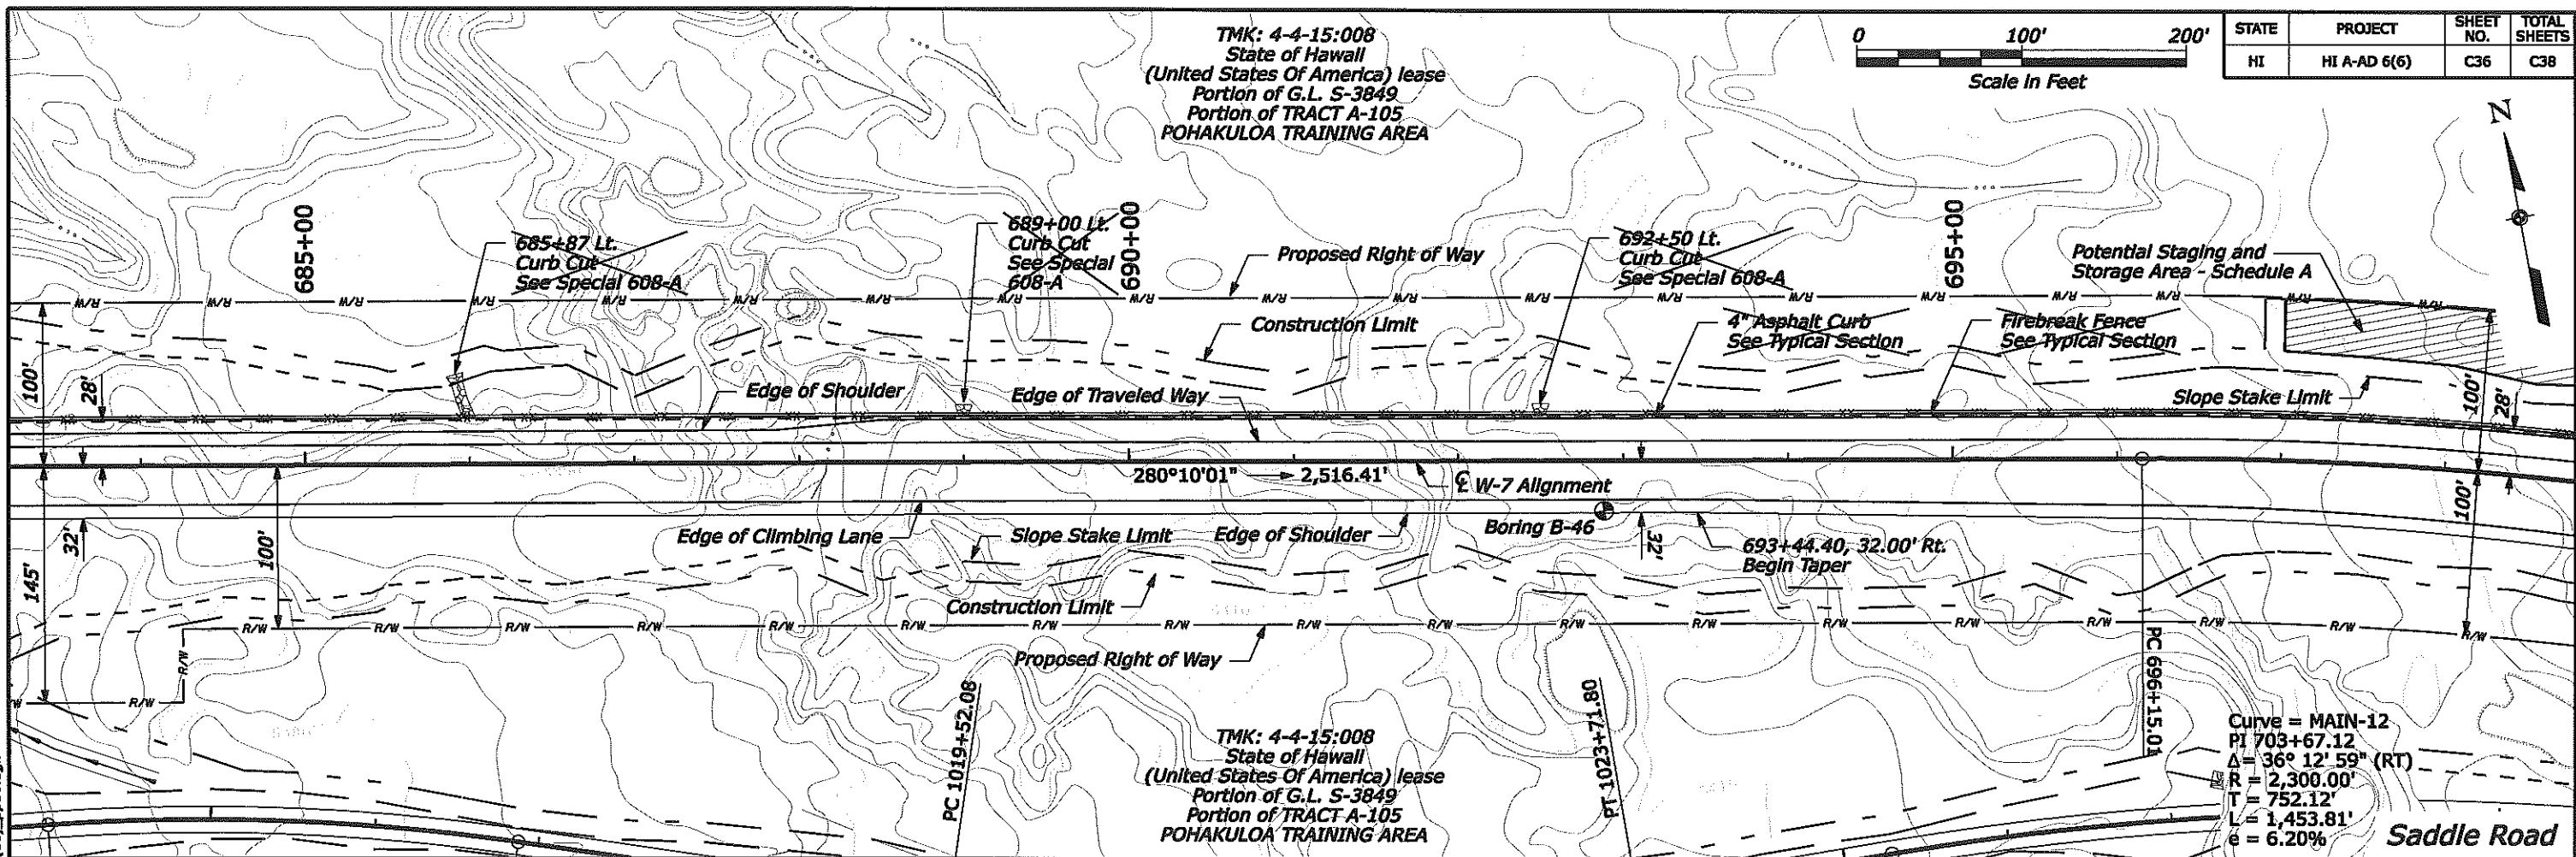

This work was prepared by me  
or under my supervision  
*Daniel A. Liddle*  
Expiration Date of License 4/30/2012



