



STATE	PROJECT	SHEET NO.	TOTAL SHEETS
HI	HI A-AD 6(7)	E13	E17

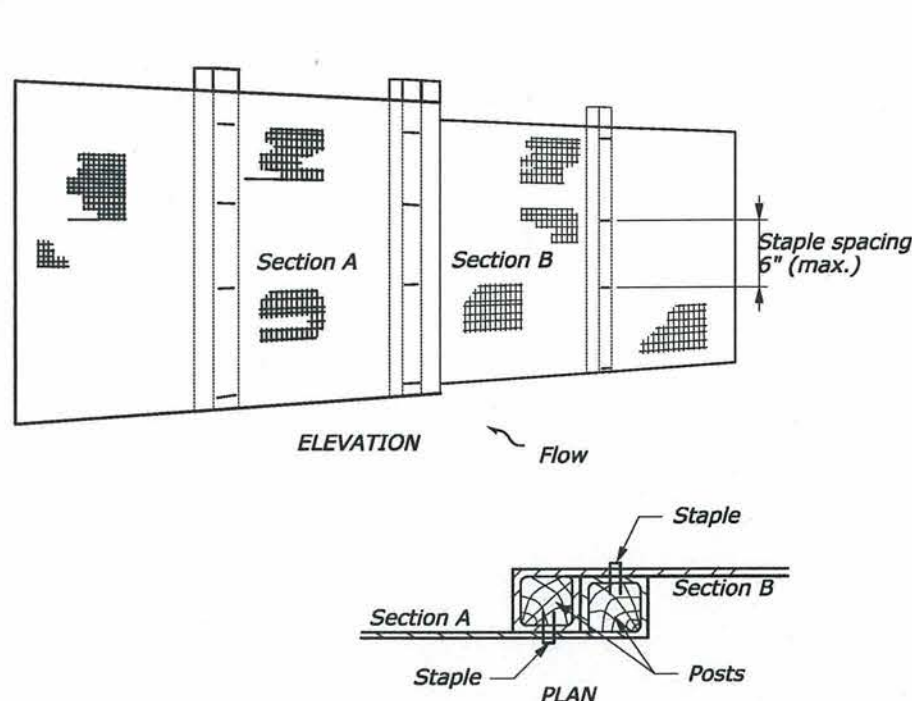


JOINING TWO ADJACENT SILT FENCE SECTIONS

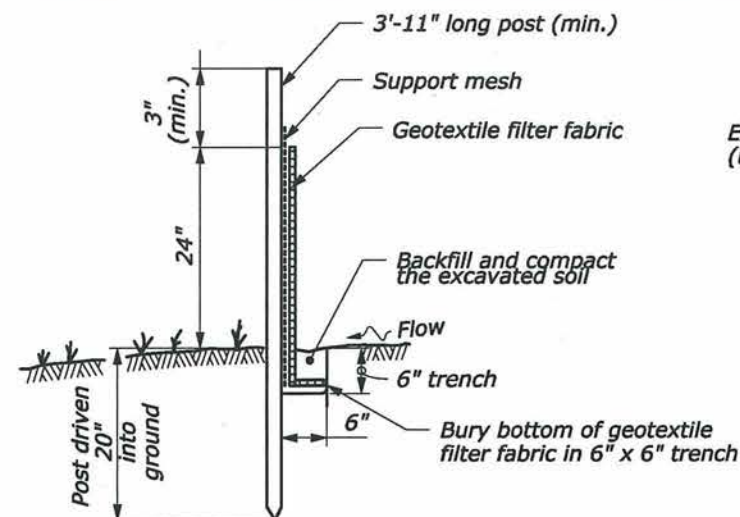

POST AND FABRIC INSTALLATION DETAIL

NOTE:


1. The filter fabric shall be a minimum of 36 inches wide.
2. If silt fence is obtained from manufacturer as a package (i.e. fabric attached to post) the manufacturer's installation instruction shall be adhered to.
3. Fence stakes may be wood or metal, must be capable of supporting anticipated loads.

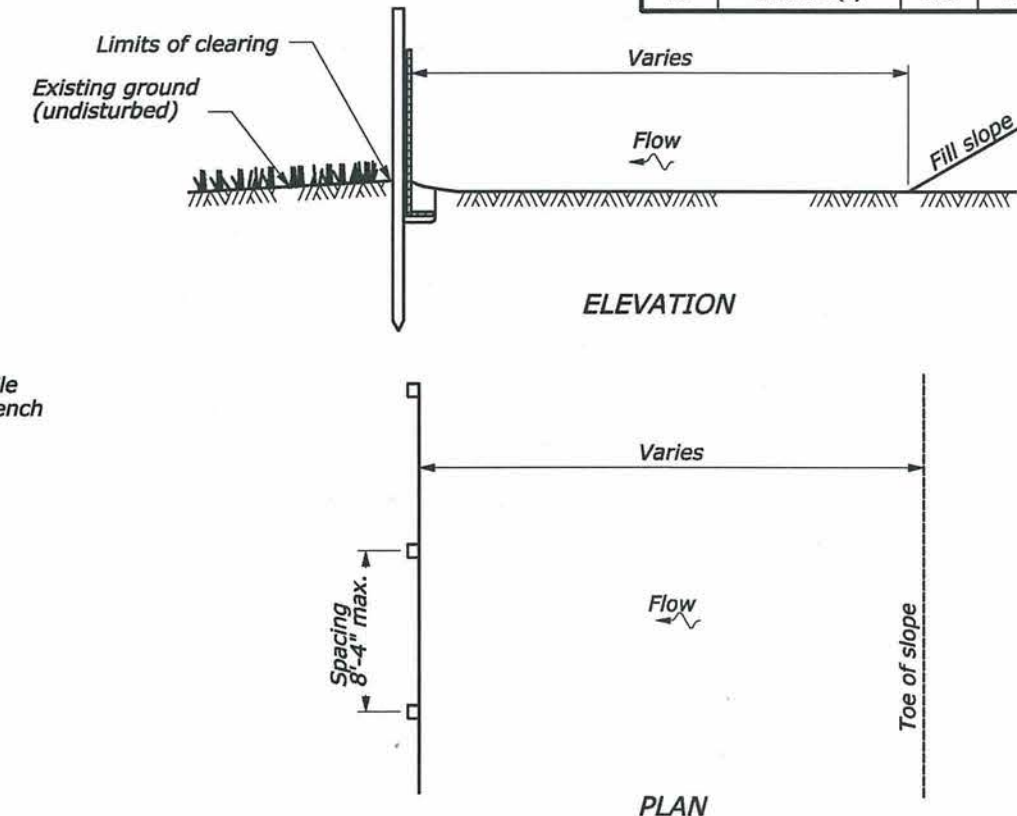


SILT FENCE INSTALLATION AT TOE OF FILL

Note:

Obtain location approval from CO.

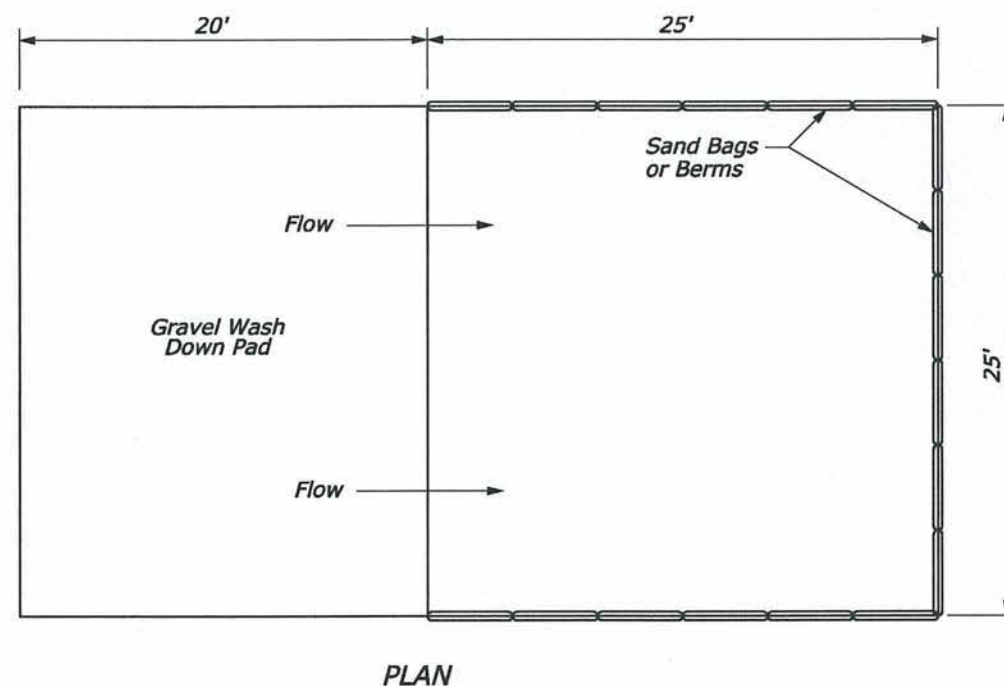

WASH DOWN DETAIL

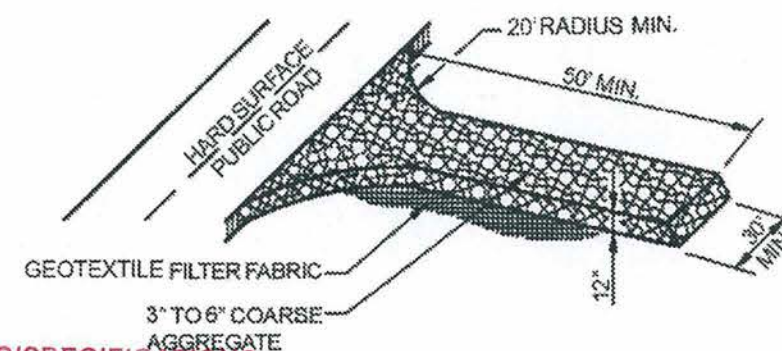

AS-BUILT DRAWINGS/SPECIFICATIONS
This certifies that the dimensions and details shown on this sheet reflect the dimensions and details and specifications as constructed in the field.

GOODFELLOW BROS., INC.
Contractor's Name:

Signature: *[Signature]* Date: 1/2/14

STABILIZED CONSTRUCTION ENTRANCE



THIS WORK WAS PREPARED BY ME OR UNDER MY SUPERVISION.

NO SCALE


Signature: *[Signature]* EXPIRATION DATE OF THE LICENSE: 4/30/2012

U.S. DEPARTMENT OF TRANSPORTATION
FEDERAL HIGHWAY ADMINISTRATION
CENTRAL FEDERAL LANDS HIGHWAY DIVISION

U.S. CUSTOMARY SPECIAL SILT FENCE, WASH DOWN, AND CONSTRUCTION ENTRANCE

SPECIAL
157-A

STATE	PROJECT	SHEET NO.	TOTAL SHEETS
HI	HI A-AD 6(7)	E14	E17

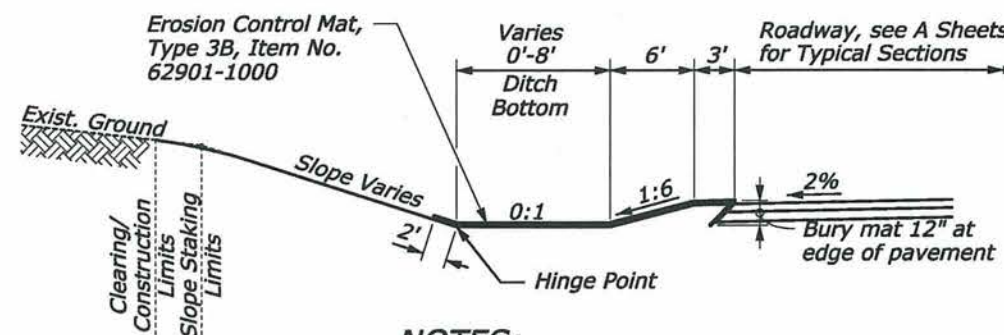

NOTES:

1. Use Erosion Control Mat, Type 3B (Item No. 62901-1000) to line foreslope from Edge of Road, Ditch Bottom, and a portion of the Backslope
2. Place Mat in all ditches.

EROSION CONTROL MAT PLACEMENT IN DITCH BOTTOM

AS-BUILT DRAWINGS/SPECIFICATIONS

This certifies that the dimensions and details shown on this sheet reflect the dimensions and details and specifications as constructed in the field.

GOODFELLOW BROS., INC.

Contractor's Name:

Signature: *[Signature]* Date: 1/2/14



THIS WORK WAS PREPARED BY ME OR UNDER MY SUPERVISION.
NO SCALE
Signature: *[Signature]* 4/30/2012
EXPIRATION DATE OF THE LICENSE

U.S. DEPARTMENT OF TRANSPORTATION
FEDERAL HIGHWAY ADMINISTRATION
CENTRAL FEDERAL LANDS HIGHWAY DIVISION

U.S. CUSTOMARY SPECIAL


EROSION CONTROL MAT DETAIL

SPECIAL
157-B


STATE	PROJECT	SHEET NO.	TOTAL SHEETS
HI	HI A-AD 6(7)	E15	E17

NOTE:


1. Repair all rills or gullies prior to installation.
2. Place Check Dams in Swales perpendicular to the flowline as shown on plans.
3. Place Check Dams in Ditches with longitudinal slopes 3% or greater.

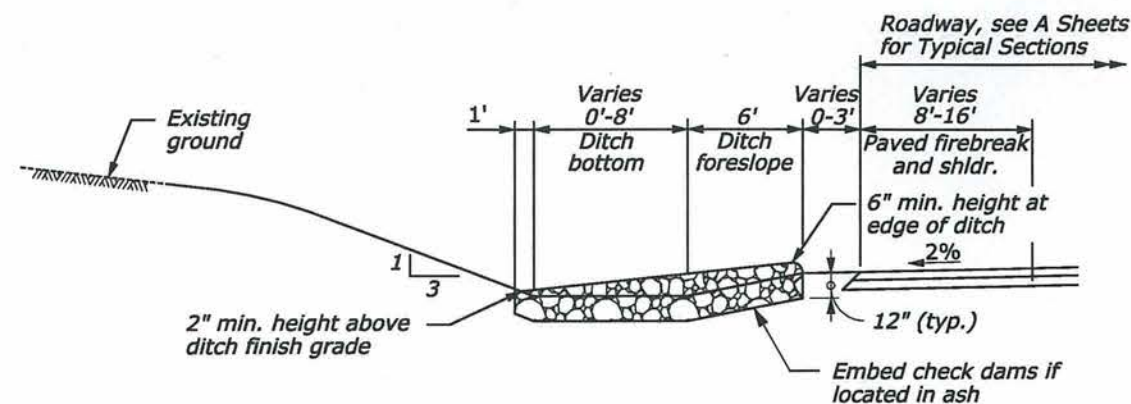

DITCH - CROSS SECTION

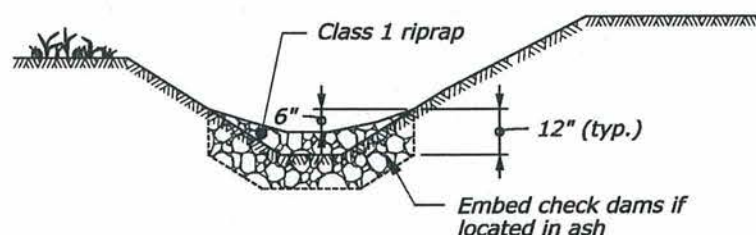


SWALE - CROSS SECTION

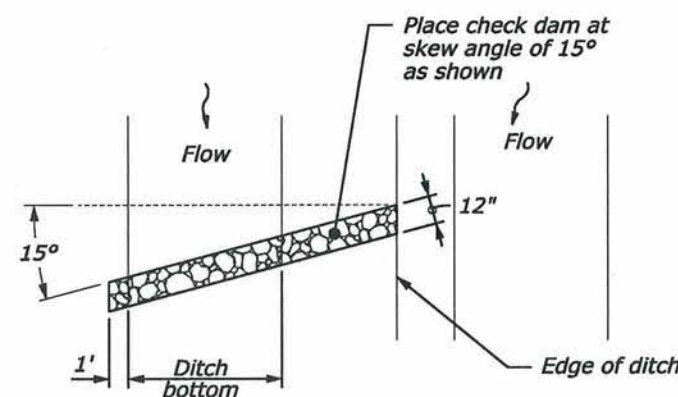


DITCH - PLAN

RIPRAP CHECK DAM SPACING	
DITCH GRADE (G)	CHECK DAM SPACING (S) max. (ft)
3%-4%	40
4%-5%	30
>5%	25

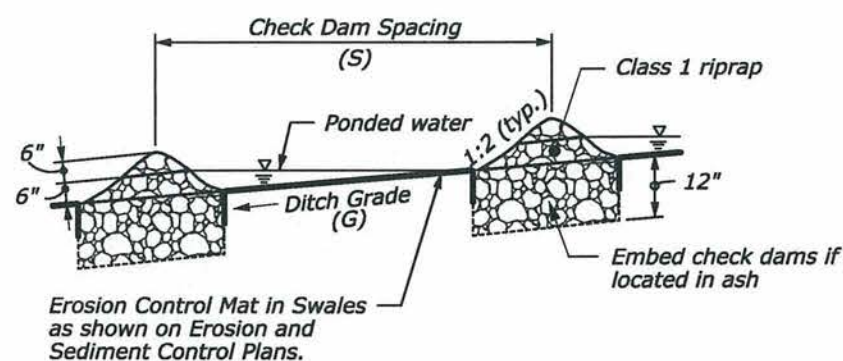

SWALE - PROFILE VIEW

SWALE

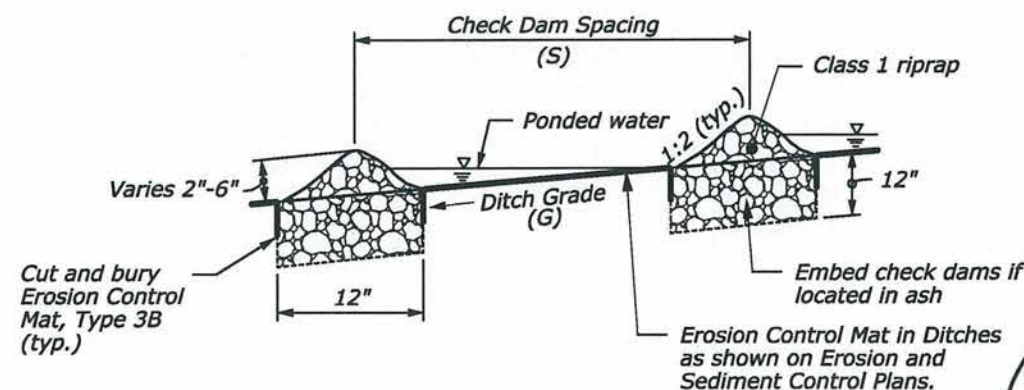

DITCH - PROFILE VIEW

DITCH

RIPRAP CHECK DAM

AS-BUILT DRAWINGS/SPECIFICATIONS
This certifies that the dimensions and details shown on this sheet reflect the dimensions and details and specifications as constructed in the field.

GOODFELLOW BROS., INC.
Contractor's Name:

Signature: *[Signature]* Date: *1/2/14*



THIS WORK WAS PREPARED BY ME OR UNDER MY SUPERVISION.
NO SCALE
Signature: *[Signature]* 4/30/2012
EXPIRATION DATE OF THE LICENSE

U.S. DEPARTMENT OF TRANSPORTATION
FEDERAL HIGHWAY ADMINISTRATION
CENTRAL FEDERAL LANDS HIGHWAY DIVISION


U.S. CUSTOMARY SPECIAL

RIPRAP CHECK DAM


DETAIL APPROVED FOR USE 01/2011

SPECIAL
157-C

STATE	PROJECT	SHEET NO.	TOTAL SHEETS
HI	HI A-AD 6(7)	E16	E17

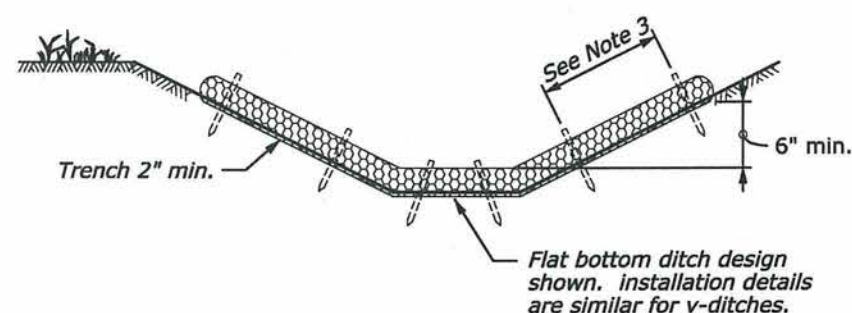


SWALE - CROSS SECTION

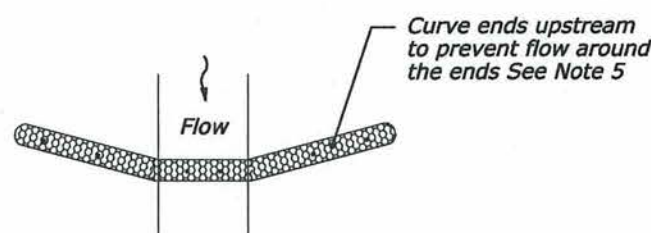

SWALE - PLAN

SWALE

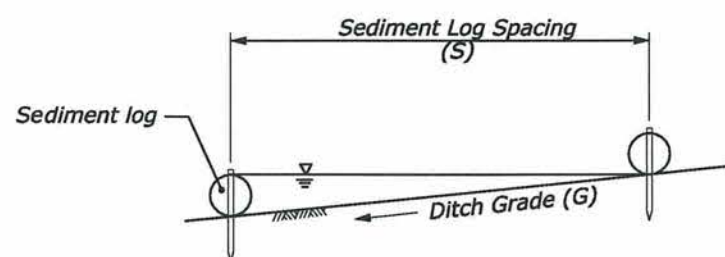


PROFILE VIEW


SEDIMENT LOG SPACING*	
DITCH GRADE	SEDIMENT LOG SPACING (S) max. (ft)
<2%	150
2%-3%	75
3%-4%	50
4%-5%	40
5%-6%	30

* Spacing calculated based on 18" Ø min sediment log.
No sediment log > 6%.

SEDIMENT LOG IN SWALE AND DITCH

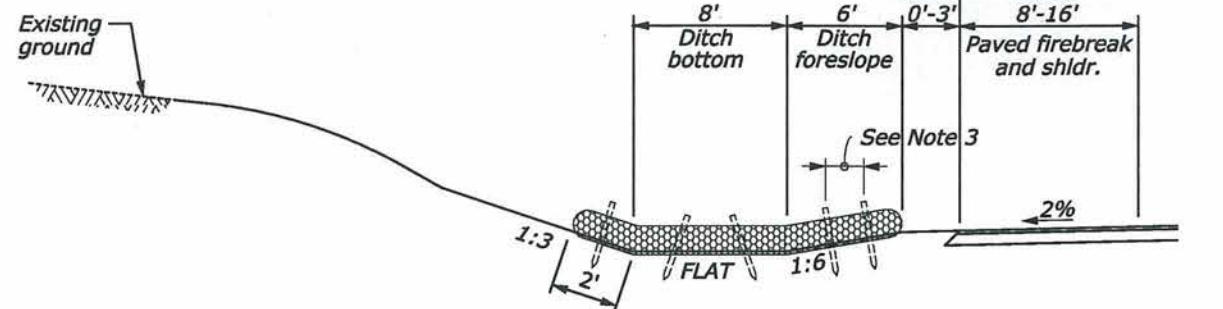

DITCH - CROSS SECTION

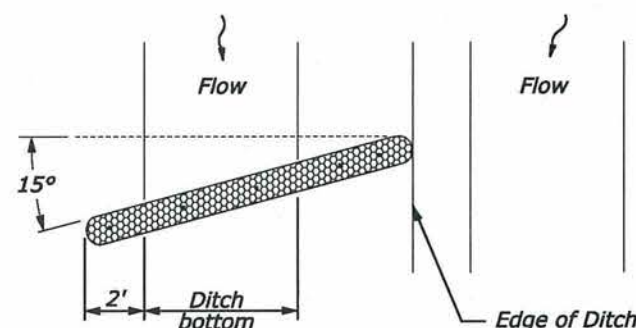


DITCH - PLAN

DITCH


AS-BUILT DRAWINGS/SPECIFICATIONS
This certifies that the dimensions and details shown on this sheet reflect the dimensions and details and specifications as constructed in the field.

GOODFELLOW BROS., INC.
Contractor's Name:

Signature: *[Signature]* Date: 1/2/14

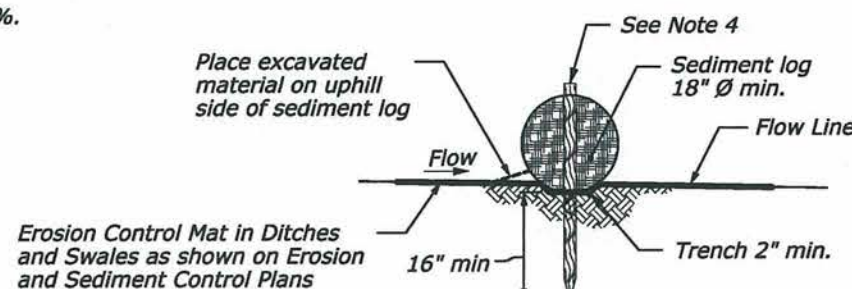

SEDIMENT LOG STAKING DETAIL

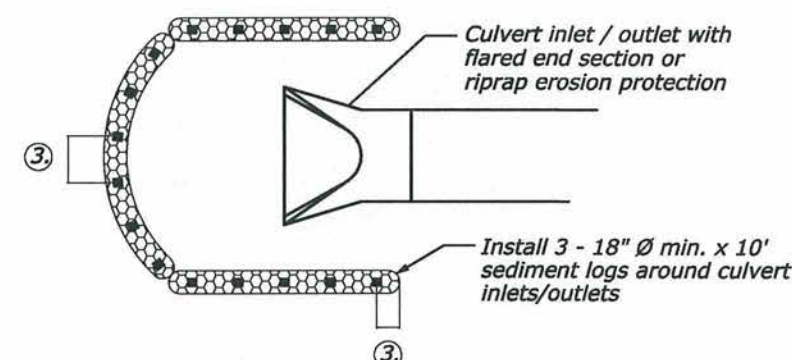

SEDIMENT LOG AT CULVERT INLET/OUTLET



THIS WORK WAS PREPARED BY ME OR UNDER MY SUPERVISION.
Signature: *[Signature]* 4/30/2012
EXPIRATION DATE OF THE LICENSE

NO SCALE

U.S. DEPARTMENT OF TRANSPORTATION
FEDERAL HIGHWAY ADMINISTRATION
CENTRAL FEDERAL LANDS HIGHWAY DIVISION

U.S. CUSTOMARY SPECIAL

SEDIMENT LOG

DETAIL APPROVED FOR USE 01/2011

SPECIAL
157-D

M:\2009\2009_057.001 ANA Saddle Road West Side Bld Pkg 21G Dwgs\Contract Documents\Civil\Roadway\Sheets\150\HI SR 200\000_sp157-D.dgn
9/21/2011 1:36:33 PM