




STATE	PROJECT	SHEET NO.	TOTAL SHEETS
HI	HI A-AD 6(7)	F2	F2

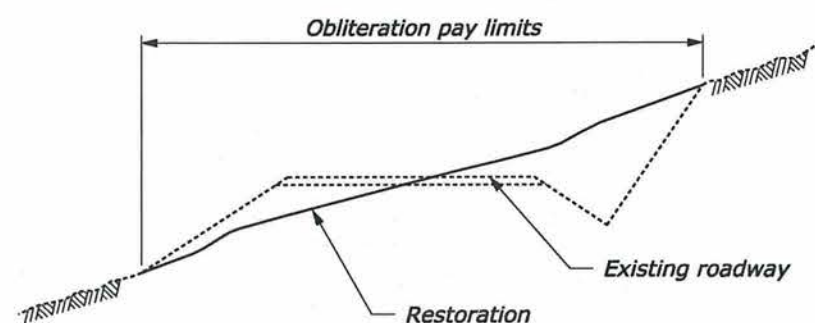


**ROADWAY OBLITERATION, METHOD 1
TYPICAL SECTION**

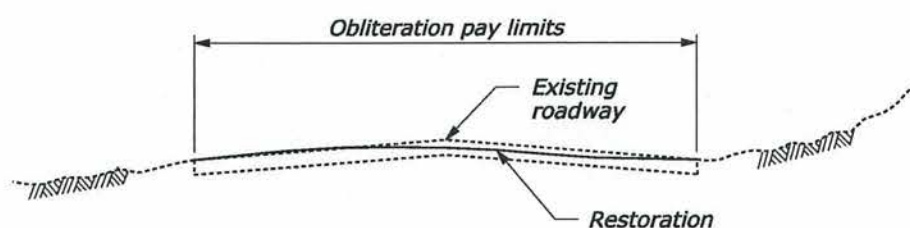

**ROADWAY OBLITERATION, METHOD 1
TYPICAL SECTION**

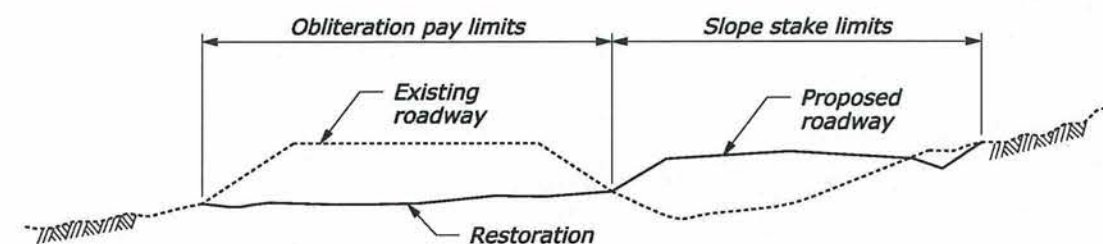

**ROADWAY OBLITERATION, METHOD 1
TYPICAL SECTION**

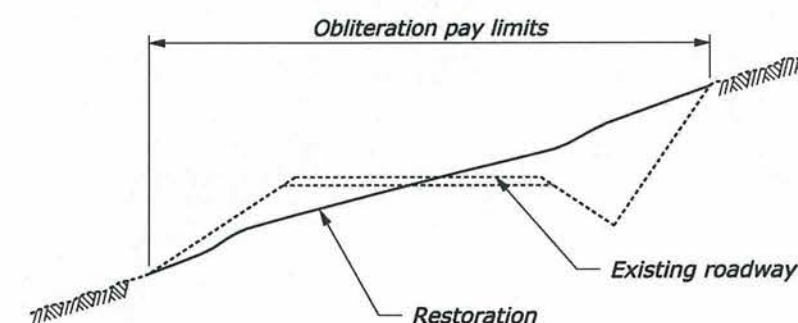

**ROADWAY OBLITERATION, METHOD 2
TYPICAL SECTION**

AS-BUILT DRAWINGS/SPECIFICATIONS
This certifies that the dimensions and details shown on this sheet reflect the dimensions and details and specifications as constructed in the field.

GOODFELLOW BROS., INC.
Contractor's Name:

John Han 1/2/14
Signature Date



This work was prepared by me
or under my supervision

Daniel A. Liddle

Expiration Date of License 4/30/2014

NO SCALE

U.S. DEPARTMENT OF TRANSPORTATION
FEDERAL HIGHWAY ADMINISTRATION
CENTRAL FEDERAL LANDS HIGHWAY DIVISION

U.S. CUSTOMARY SPECIAL

ROADWAY OBLITERATION

SPECIAL
211-A

3/21/2012 11:08:46 AM S:\Transport\100013746-SR\HwyDes\Roadway\Sheets_Bld_Package_2\F-200\HI SR 200(00)_sp211-A.dgn