

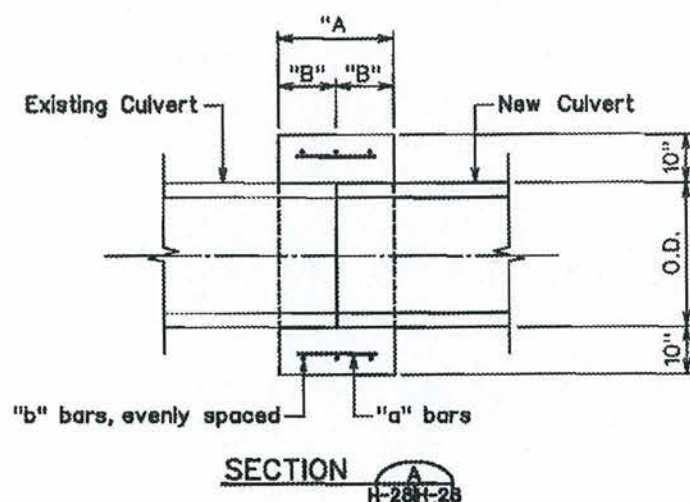
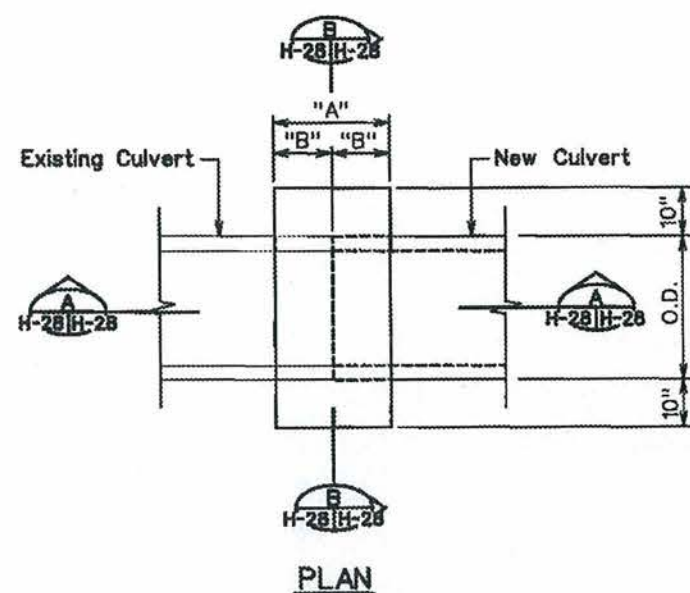


STATE	PROJECT	SHEET NO.	TOTAL SHEETS
HI	HI A-AD 6(7)	G11	G25

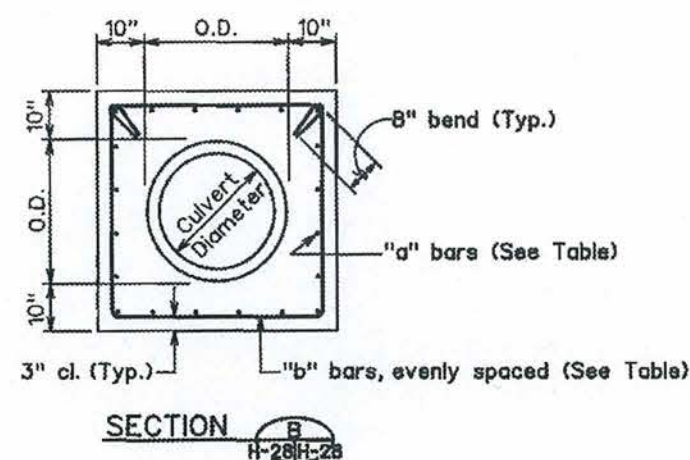

REINFORCED CONCRETE COLLAR

Item No. 60101-0000

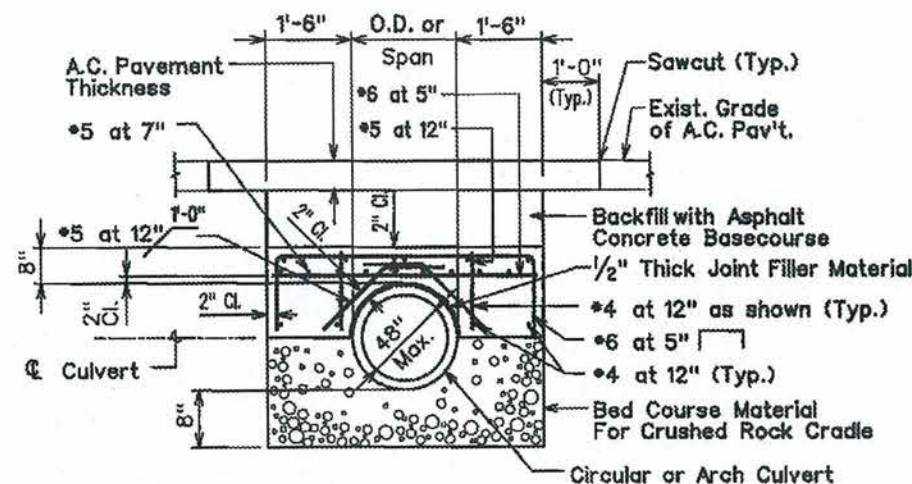


Culvert Diameter	"a" bars	"b" bars	"A"	"B"
18" to 30"	*4 at 9"	3 - *4	24"	12"
36" to 48"	*5 at 9"	4 - *5	30"	15"

AS-BUILT DRAWINGS/SPECIFICATIONS
This certifies that the dimensions and details shown on this sheet reflect the dimensions and details and specifications as constructed in the field.

GOODFELLOW BROS., INC.
Contractor's Name:

Signature: *[Signature]* Date: 1/2/14

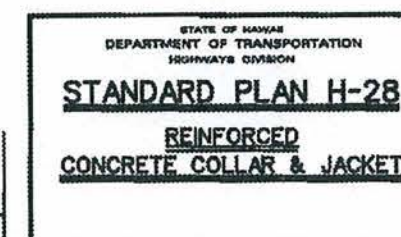

DATE	REVISION	APP'D.
X	X	

STANDARD PLAN H-28 05/31/07



THIS WORK WAS PREPARED BY ME OR UNDER MY SUPERVISION.
Signature: *[Signature]* Date: 4/30/2012
EXPIRATION DATE OF THE LICENSE

U.S. DEPARTMENT OF TRANSPORTATION
FEDERAL HIGHWAY ADMINISTRATION
CENTRAL FEDERAL LANDS HIGHWAY DIVISION

U.S. CUSTOMARY SPECIAL
**(HDOT STD H-28)
REINFORCED
CONCRETE COLLAR**

NO SCALE

SPECIAL
601-A