

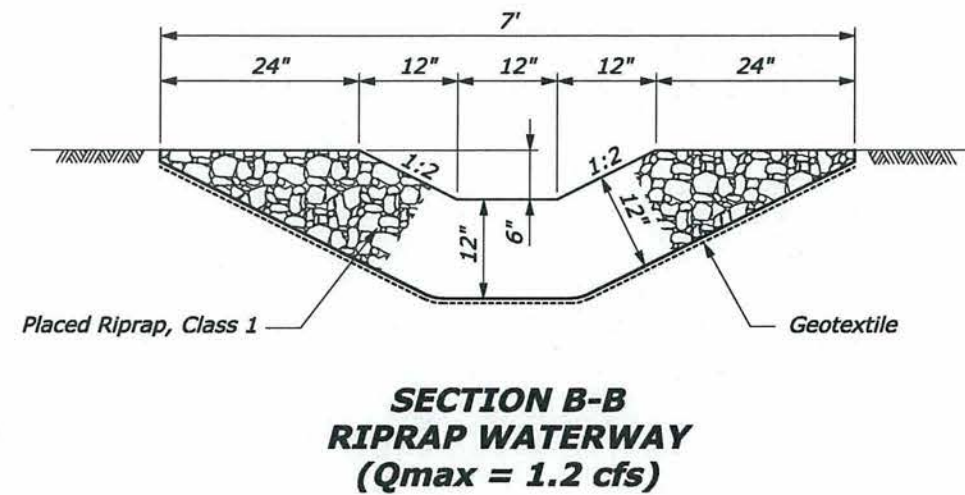
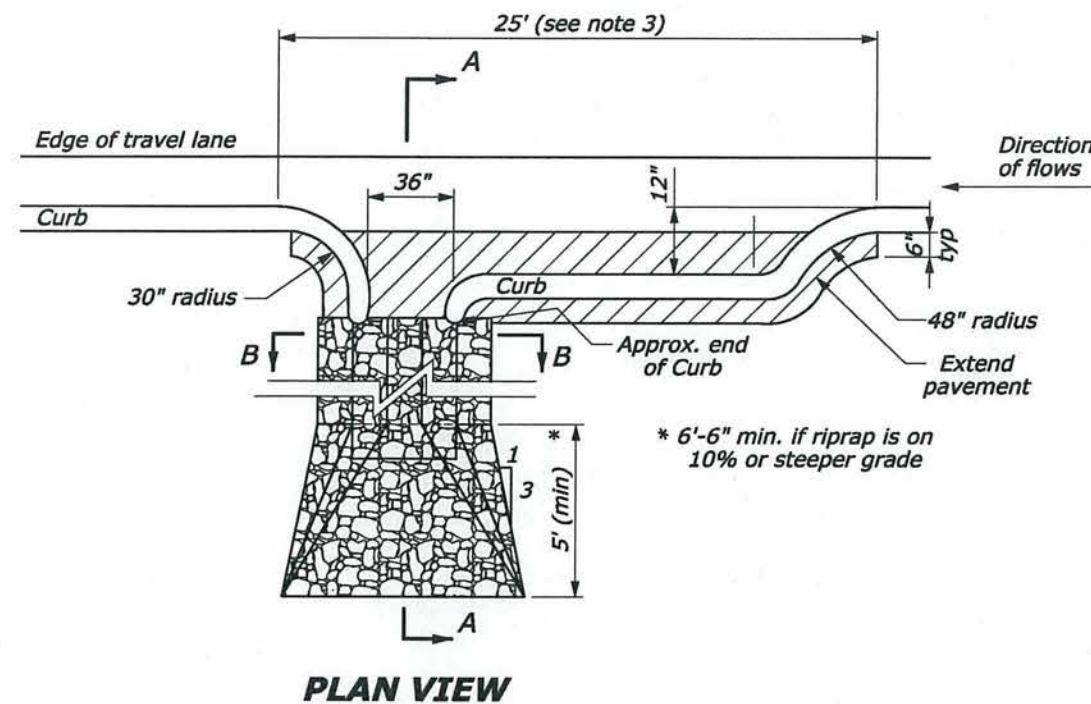


STATE	PROJECT	SHEET NO.	TOTAL SHEETS
HI	HI A-AD 6(7)	G25	G25

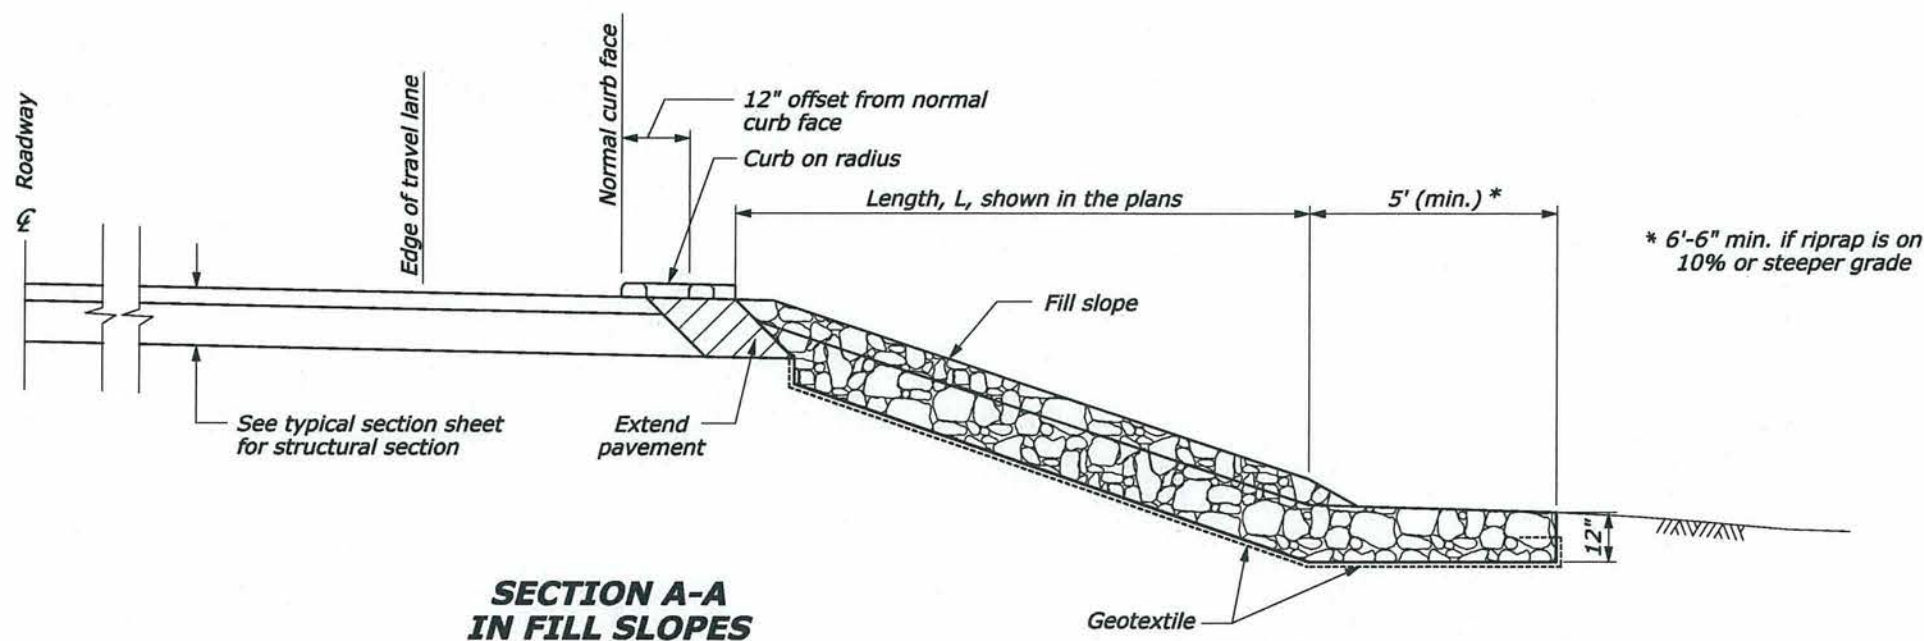

NOTE:

1. Excavation for placement of riprap waterway will not be measured for payment.
2. Furnish geotextile conforming to Subsection 714.01(a).
3. Adjust dimensions as necessary to accommodate guardrail posts.

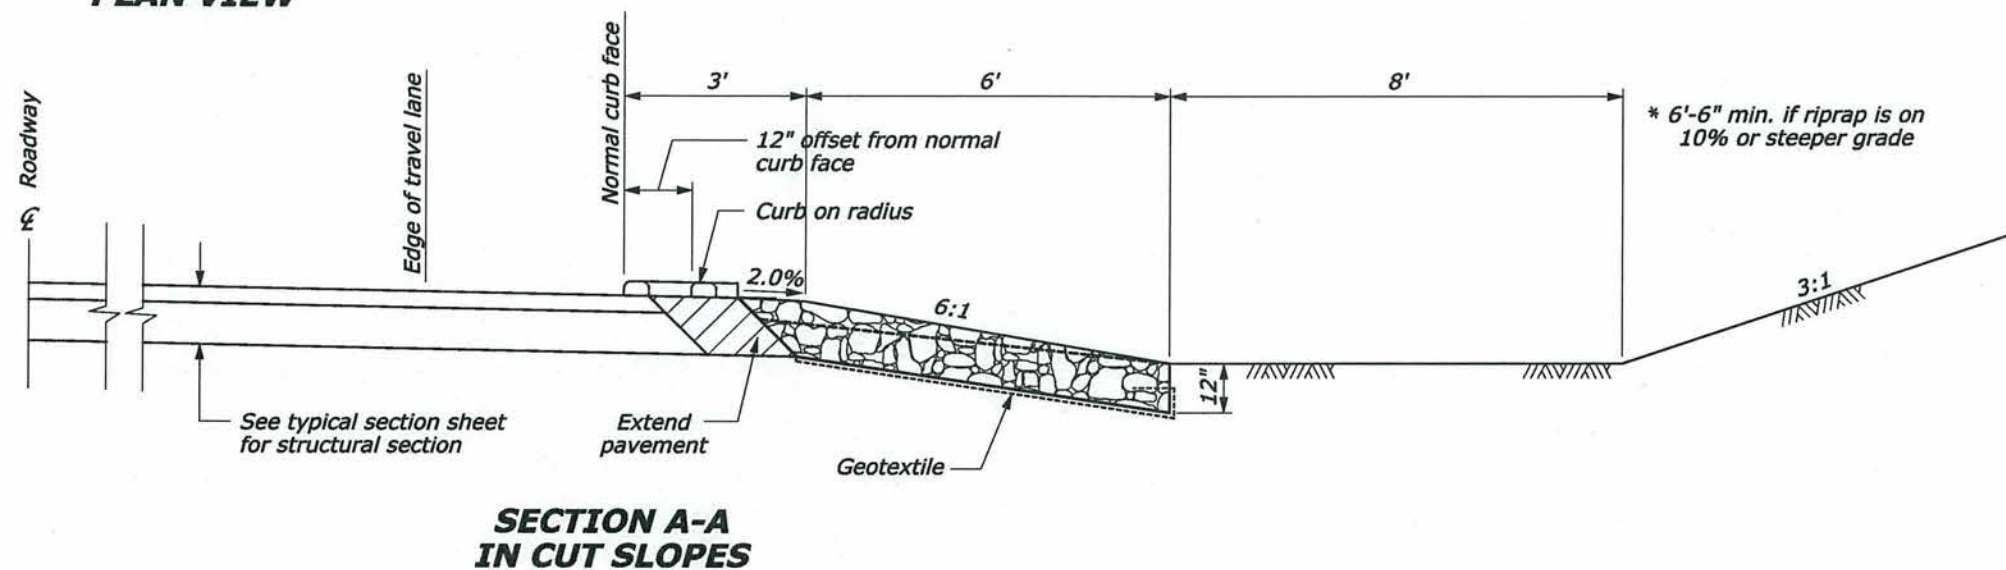

AS-BUILT DRAWINGS/SPECIFICATIONS
This certifies that the dimensions and details shown on this sheet reflect the dimensions and details and specifications as constructed in the field.

GOODFELLOW BROS., INC.
Contractor's Name:

[Signature] 1/2/14
Signature Date



THIS WORK WAS PREPARED BY ME OR UNDER MY SUPERVISION.

[Signature] 4/30/2012
SIGNATURE EXPIRATION DATE OF THE LICENSE

U.S. DEPARTMENT OF TRANSPORTATION
FEDERAL HIGHWAY ADMINISTRATION
CENTRAL FEDERAL LANDS HIGHWAY DIVISION

U.S. CUSTOMARY SPECIAL

**RIPRAP WATERWAY
IN CURB CUT**

SPECIAL
608-A

NO SCALE