




STATE	PROJECT	SHEET NO.	TOTAL SHEETS
HI	HI A-AD 6(7)	T80	T101

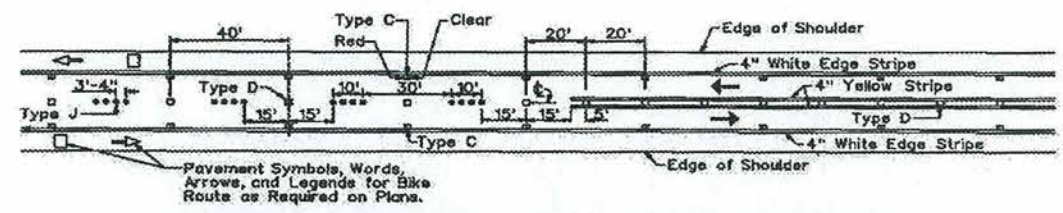


PASSING PERMITTED AND PASSING PROHIBITED

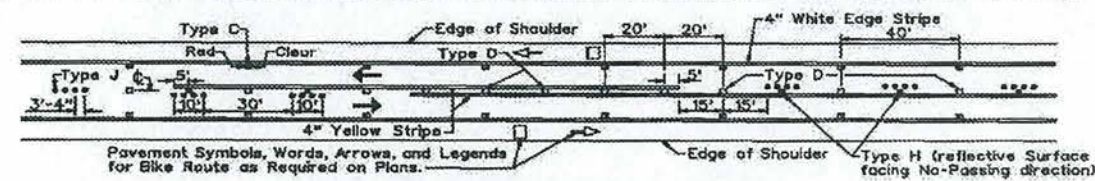


PASSING PROHIBITED ZONES

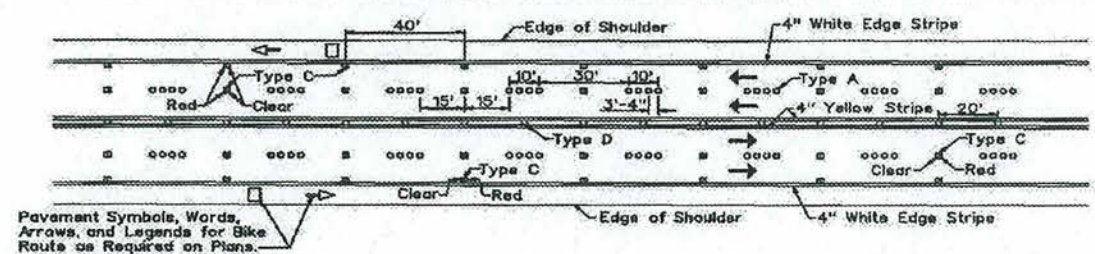


TWO - LANE

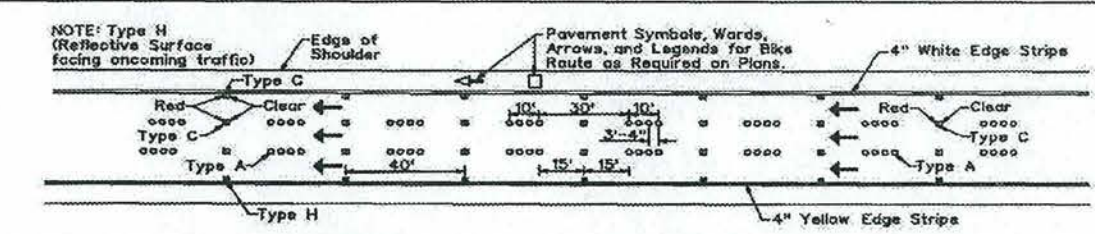

DIVIDED HIGHWAY AND FREEWAY

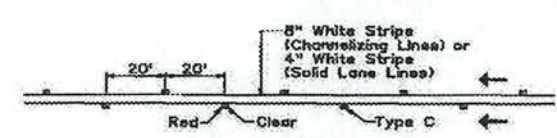


CHANNELIZING LINES OR SOLID LANE LINES

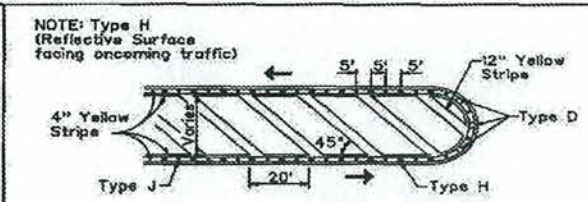


MEDIAN NOSE DELINEATION


MISCELLANEOUS

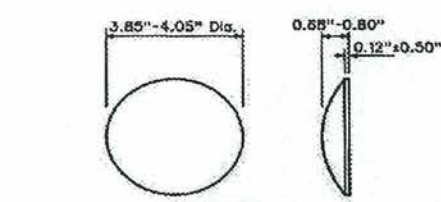


TYPE A
○ NON-REFLECTIVE WHITE MARKER
TYPE J
● NON-REFLECTIVE YELLOW MARKER

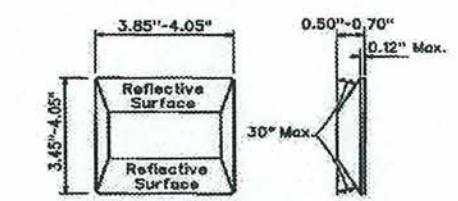

TYPE C
□ RED - CLEAR REFLECTIVE MARKER

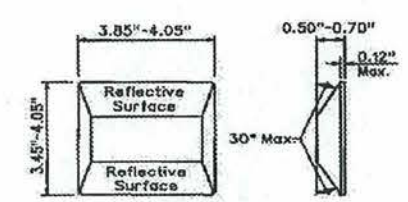

TYPE D
□ TWO-WAY YELLOW REFLECTIVE MARKER

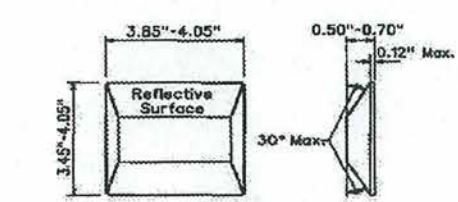

TYPE H
■ ONE-WAY YELLOW REFLECTIVE MARKER


TYPE F
■ TWO-WAY BLUE REFLECTIVE MARKER (FIRE HYDRANT MARKER)

GENERAL NOTES

1. Pavement marking and striping shall conform to the latest "Manual on Uniform Traffic Control Devices for Streets and Highways" and as amended.
2. Layout and installation of pavement marking and striping shall be done by the Contractor. The Contractor shall check the layouts with the Engineer prior to performing work.
3. Edge lines shall not be continued through intersections and shall not be broken for driveways unless otherwise shown or directed.

DATE	REVISION	APP'D.
00/00/00 X		


STANDARD PLAN TE-26 07/11/08

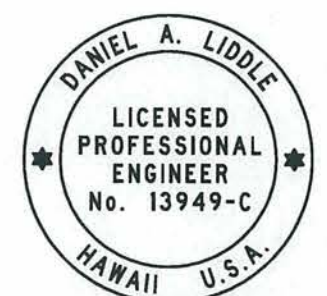

This work was prepared by me or under my supervision
Daniel A. Liddle
Expiration Date of License 4/30/2014




AS-BUILT DRAWINGS/SPECIFICATIONS
This certifies that the dimensions and details shown on this sheet reflect the dimensions and details and specifications as constructed in the field.
GOODFELLOW BROS., INC.
Contractor's Name:
[Signature]
Signature Date 1/2/14

U.S. DEPARTMENT OF TRANSPORTATION FEDERAL HIGHWAY ADMINISTRATION CENTRAL FEDERAL LANDS HIGHWAY DIVISION	U.S. CUSTOMARY SPECIAL (HDOT STD TE-26) RAISED PAVEMENT MARKERS AND STRIPING	SPECIAL 634-A
---	---	------------------

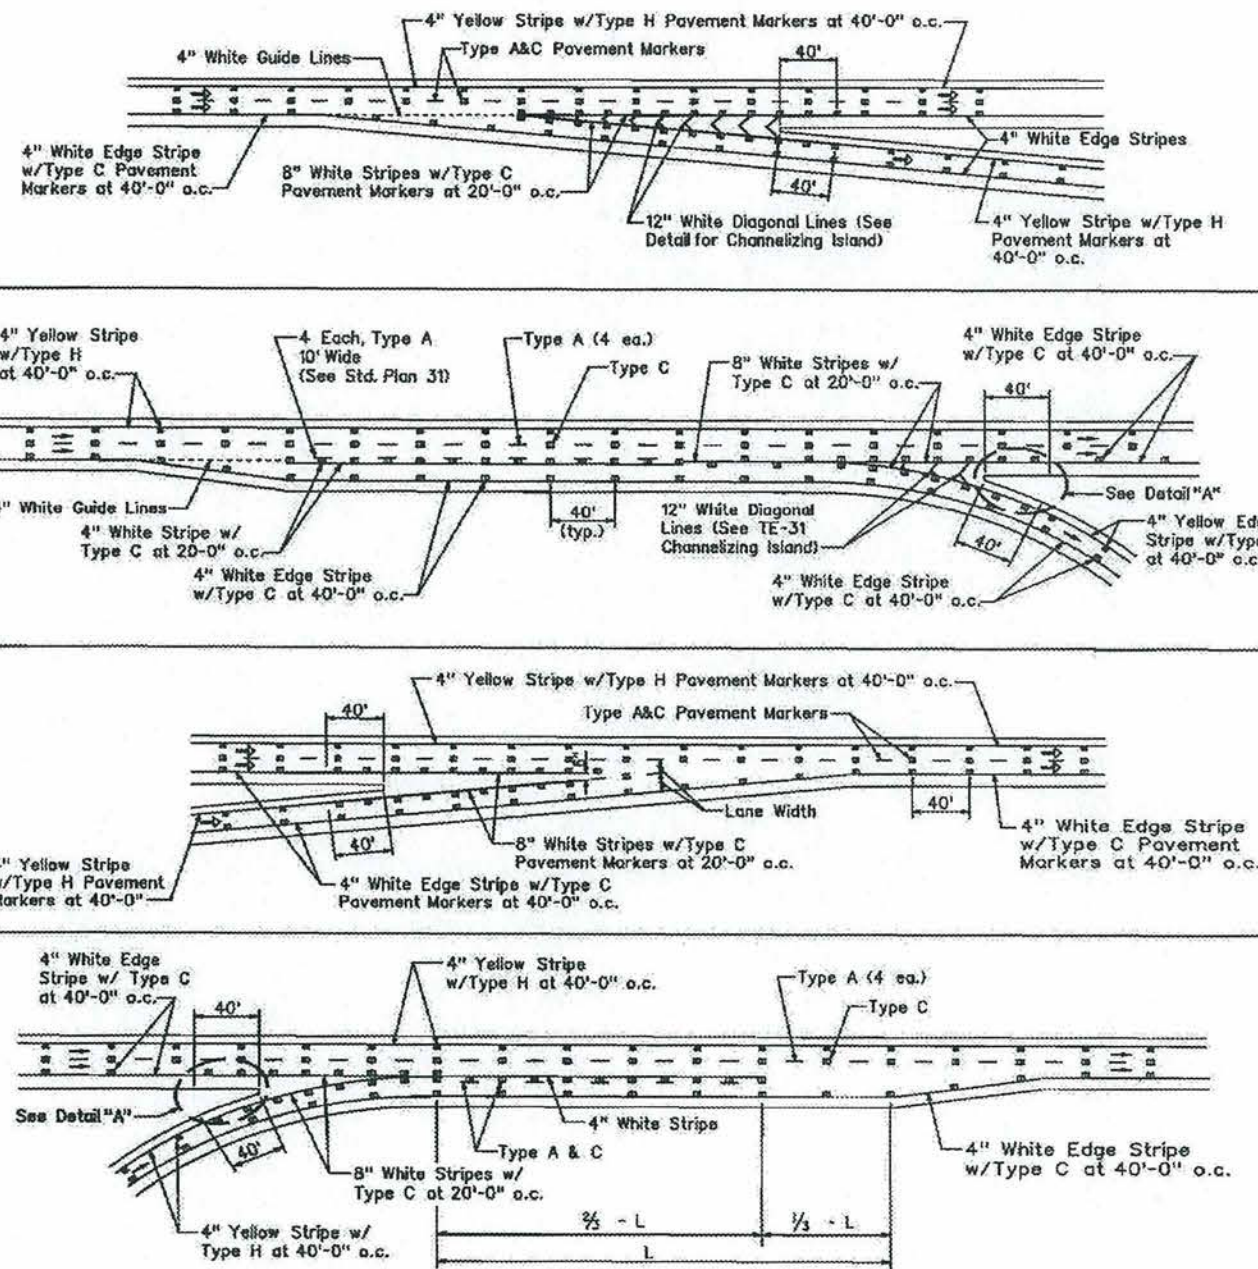

GENERAL NOTES

1. Pavement Markings and Striping shall conform to the latest edition of the "Manual on Uniform Traffic Control Devices for Streets and Highways" by the FHWA and as amended.
2. Layout of Pavement Markings and Striping shall be done by the Contractor. The Contractor shall check layout of markings and striping with the Engineer prior to performing work.
3. For additional details, see Standard Plan TE-26 & TE-27.

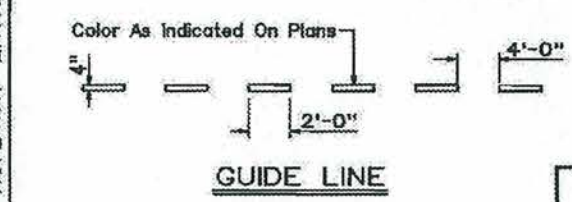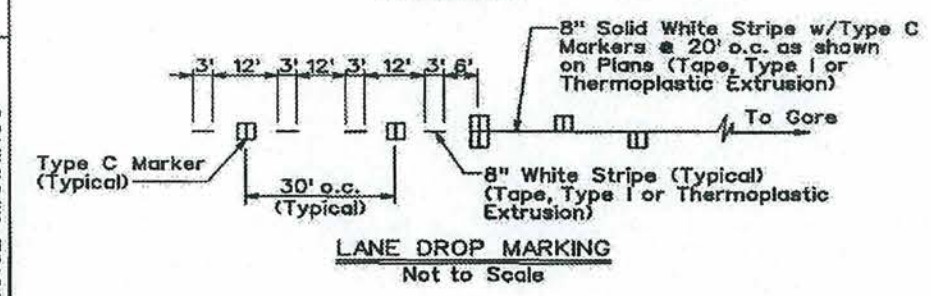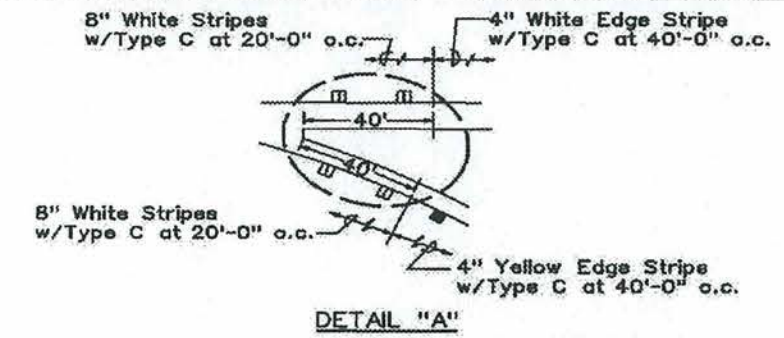

DATE	REVISION	APP'D.
00/00/00 X		

STANDARD PLAN TE-28 07/11/08

AS-BUILT DRAWINGS/SPECIFICATIONS
 This certifies that the dimensions and details shown on this sheet reflect the dimensions and details and specifications as constructed in the field.
GOODFELLOW BROS., INC.
 Contractor's Name:
Yun Han
 Signature
 1/2/14
 Date



This work was prepared by me or under my supervision
Daniel A. Liddle
 Expiration Date of License 4/30/2014

U.S. DEPARTMENT OF TRANSPORTATION
 FEDERAL HIGHWAY ADMINISTRATION
 CENTRAL FEDERAL LANDS HIGHWAY DIVISION

U.S. CUSTOMARY SPECIAL
(HDOT STD TE-28)
RAISED PAVEMENT MARKERS AND STRIPING


SPECIAL
 634-C

STATE	PROJECT	SHEET NO.	TOTAL SHEETS
HI	HI A-AD 6(7)	T83	T101




AS-BUILT DRAWINGS/SPECIFICATIONS
This certifies that the dimensions and details shown on this sheet reflect the dimensions and details and specifications as constructed in the field.

GOODFELLOW BROS., INC.
Contractor's Name:


[Signature] 1/2/14
Signature Date

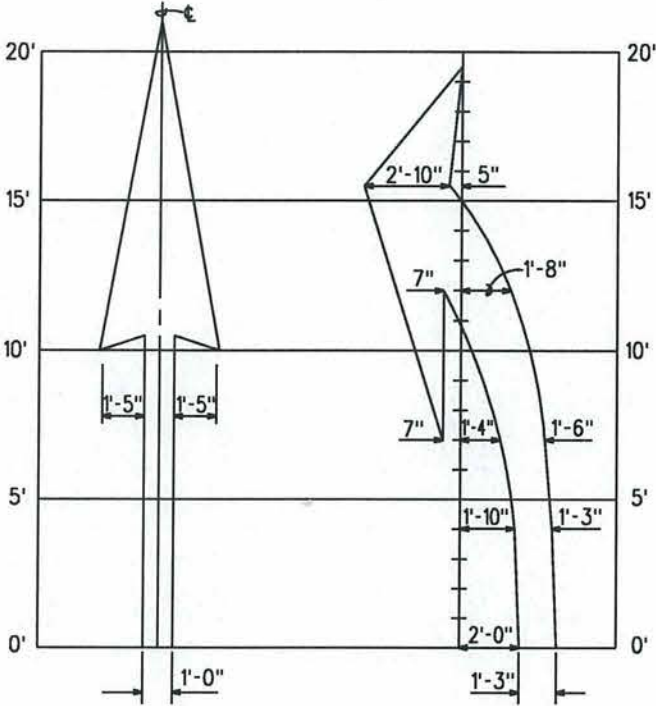

ELONGATED

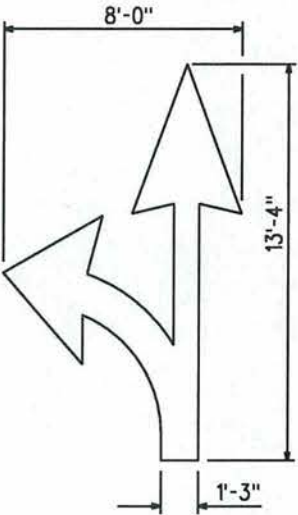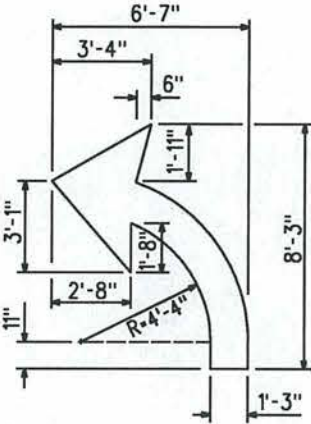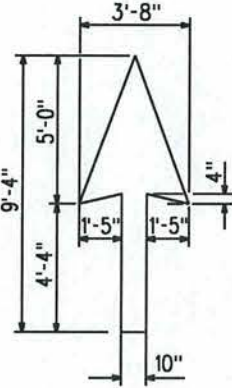

STANDARD

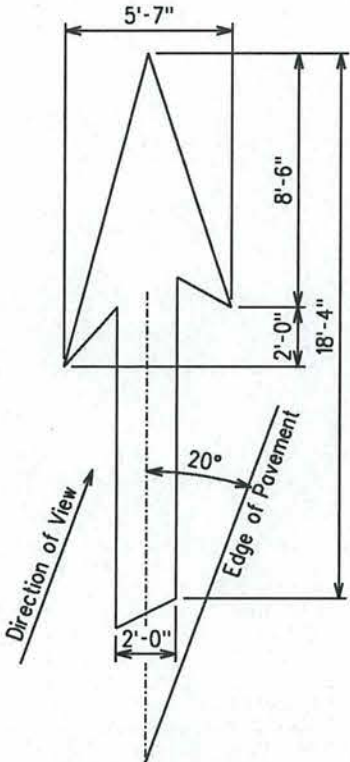

TYPE VI ARROW
RIGHT LANE DROP ARROW
(FOR LEFT LANE DROP USE MIRROR IMAGE)

GENERAL NOTES:

- Pavement marking and striping shall conform to the latest edition of the "Manual on Uniform Traffic Control Devices for Streets and Highways," by the FHWA, and as amended.
- Layout of pavement markings and striping shall be done by the Contractor. The Contractor shall check layout of markings and striping with the Contracting Officer prior to performing work.
- For additional pavement marking details, see Standard Plan TE-30, TE-31, & TE-32.



This work was prepared by me or under my supervision
Daniel A. Liddle
Expiration Date of License 4/30/2014

11/3/89 Added Alternote Elongated Pavement Arrow layout. Transferred Crosswalk and Stop Line plan and detail to Standard Plan TE-32. Revised General Note No. 3.



DATE REVISION APP'D.

U.S. DEPARTMENT OF TRANSPORTATION
FEDERAL HIGHWAY ADMINISTRATION
CENTRAL FEDERAL LANDS HIGHWAY DIVISION


U.S. CUSTOMARY SPECIAL

(HDOT STD TE-33)
MISC. PAVEMENT MARKERS

SPECIAL
634-D

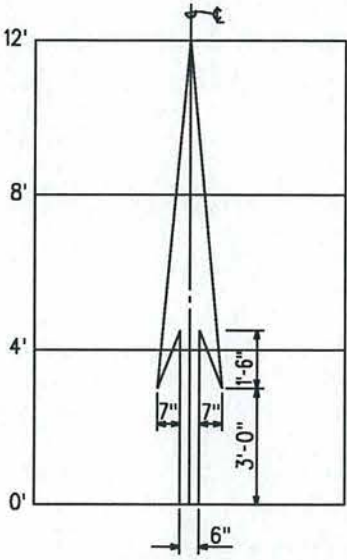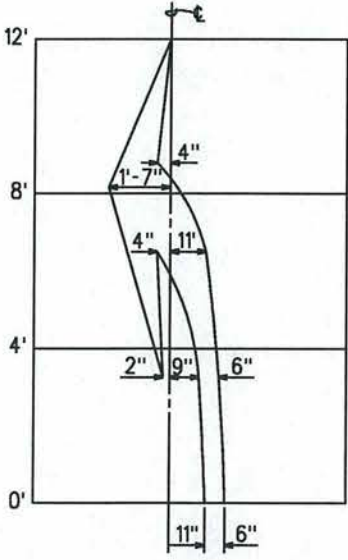

ELONGATED ALTERNATE DESIGN
PAVEMENT ARROWS

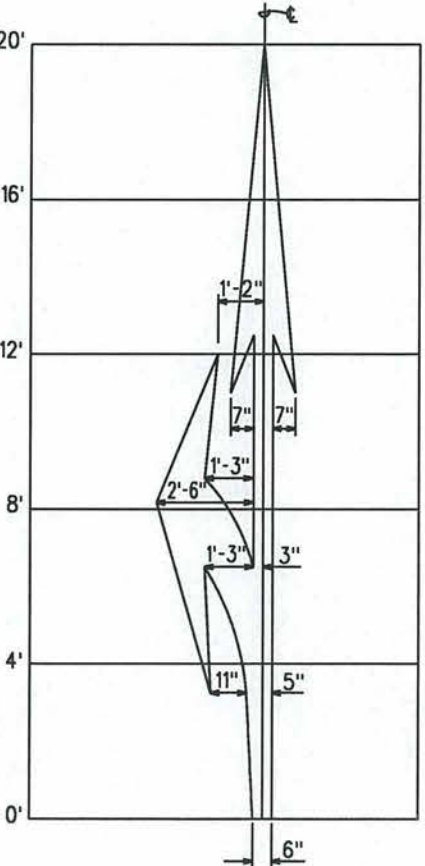


Reference: FHWA -OTO-(HTO-21)
September, 1988




STATE	PROJECT	SHEET NO.	TOTAL SHEETS
HI	HI A-AD 6(7)	T84	T101

AS-BUILT DRAWING/SPECIFICATIONS
This certifies that the dimensions and details shown on this sheet reflect the dimensions and details and specifications as constructed in the field.

GOOZFELLOW BROS., INC.
Contractor's Name:
[Signature] *1/2/14*
Signature Date

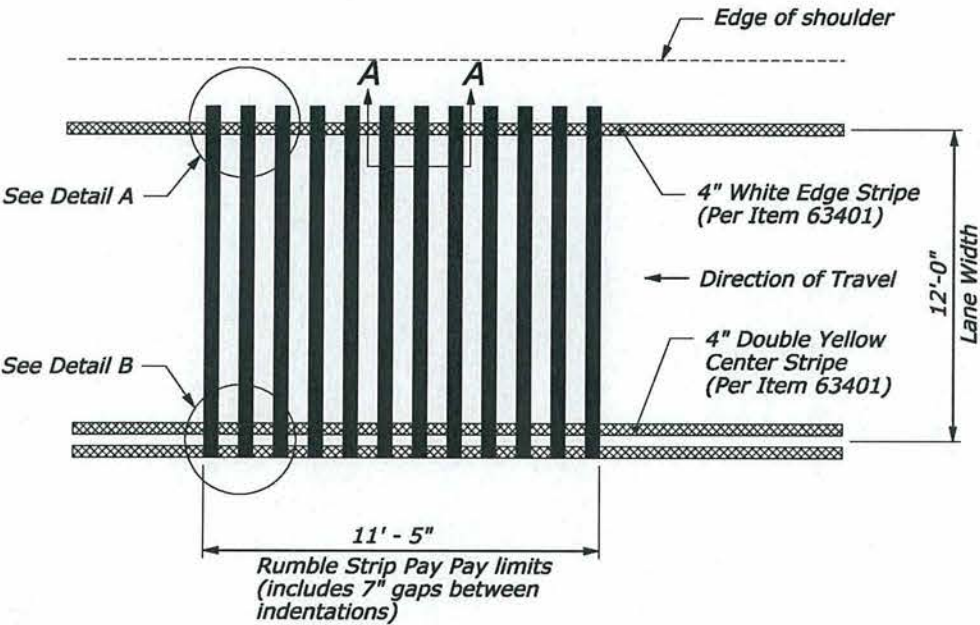

PLAN - MILLED RUMBLE STRIPS

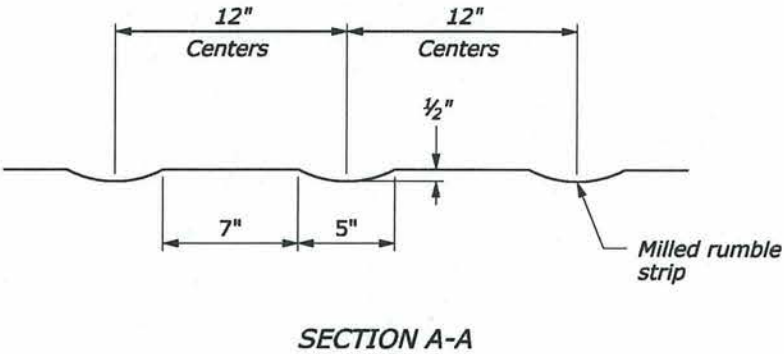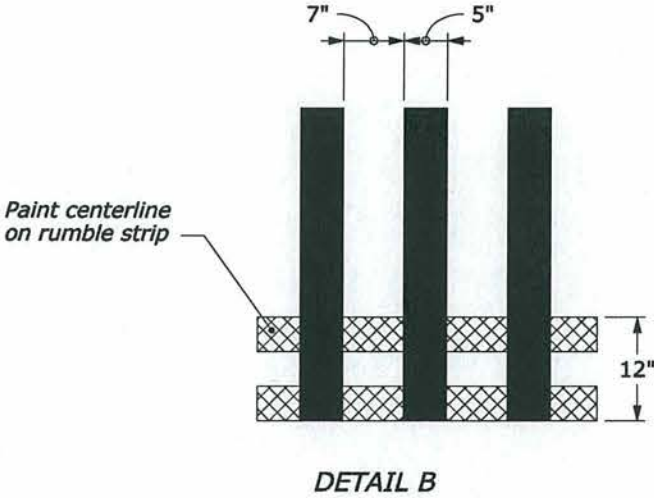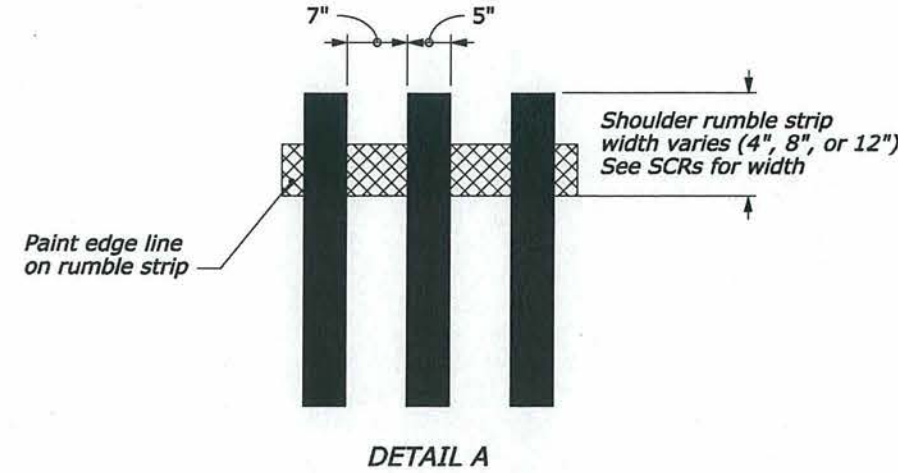

- NOTES:**
1. Submit the Milled Rumble Strip construction method to the Contracting Officer for acceptance prior to the actual work.
 2. Install Milled Rumble Strips only at designated locations.



This work was prepared by me or under my supervision
Daniel A. Liddle
Expiration Date of License 4/30/2014

U.S. DEPARTMENT OF TRANSPORTATION FEDERAL HIGHWAY ADMINISTRATION CENTRAL FEDERAL LANDS HIGHWAY DIVISION	
U.S. CUSTOMARY SPECIAL MILLED RUMBLE STRIPS DETAILS	
	SPECIAL
	634-E