

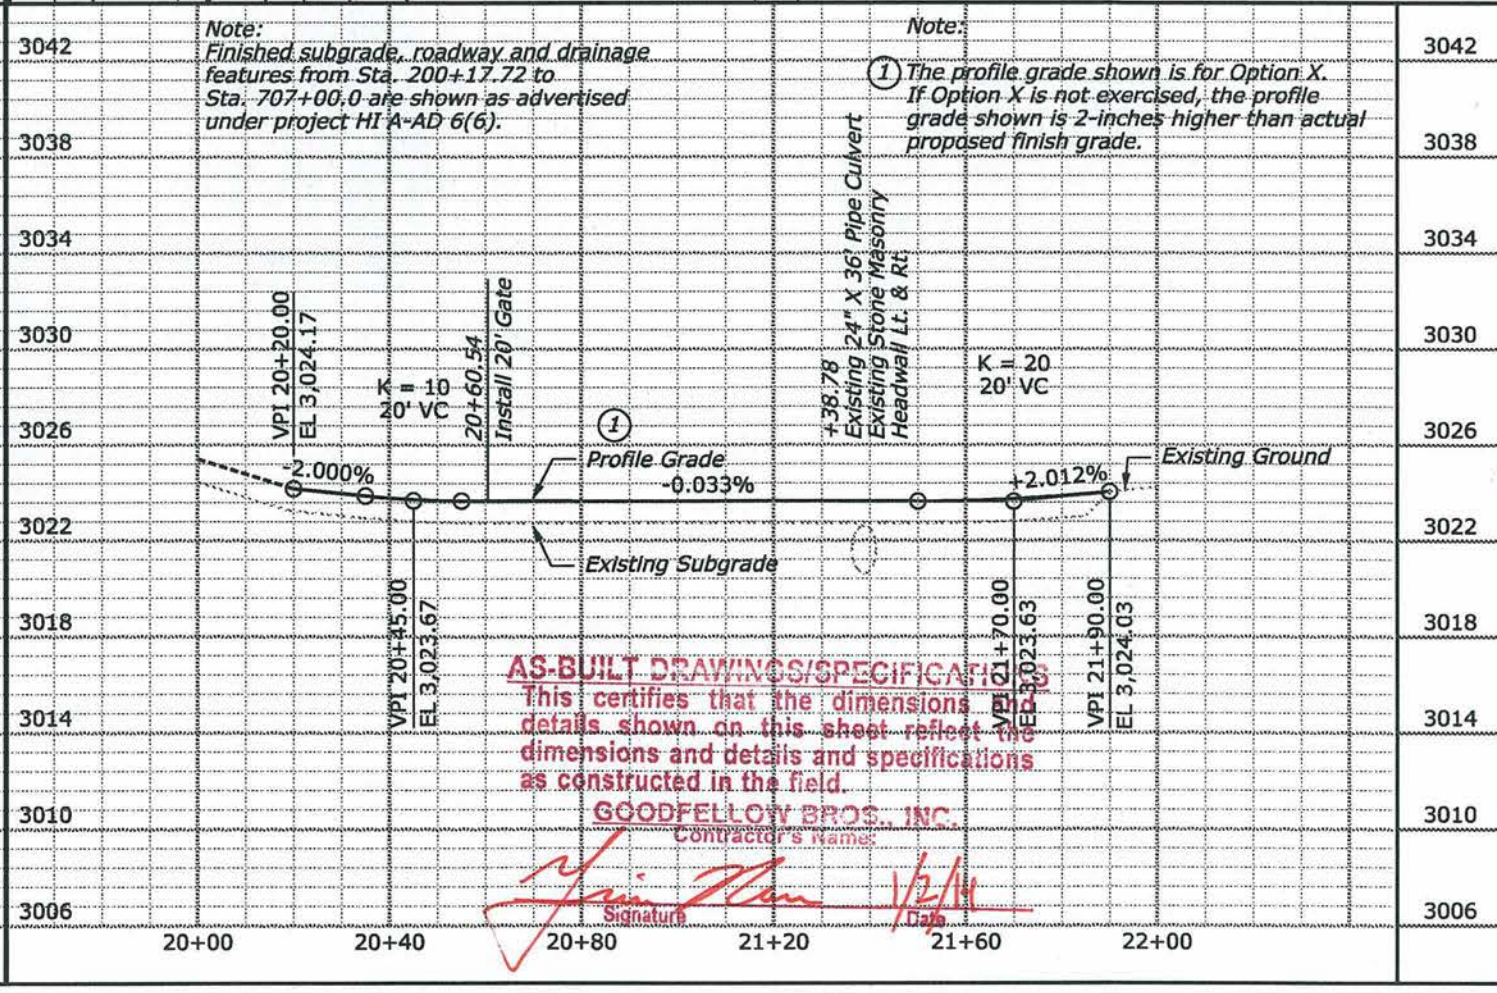
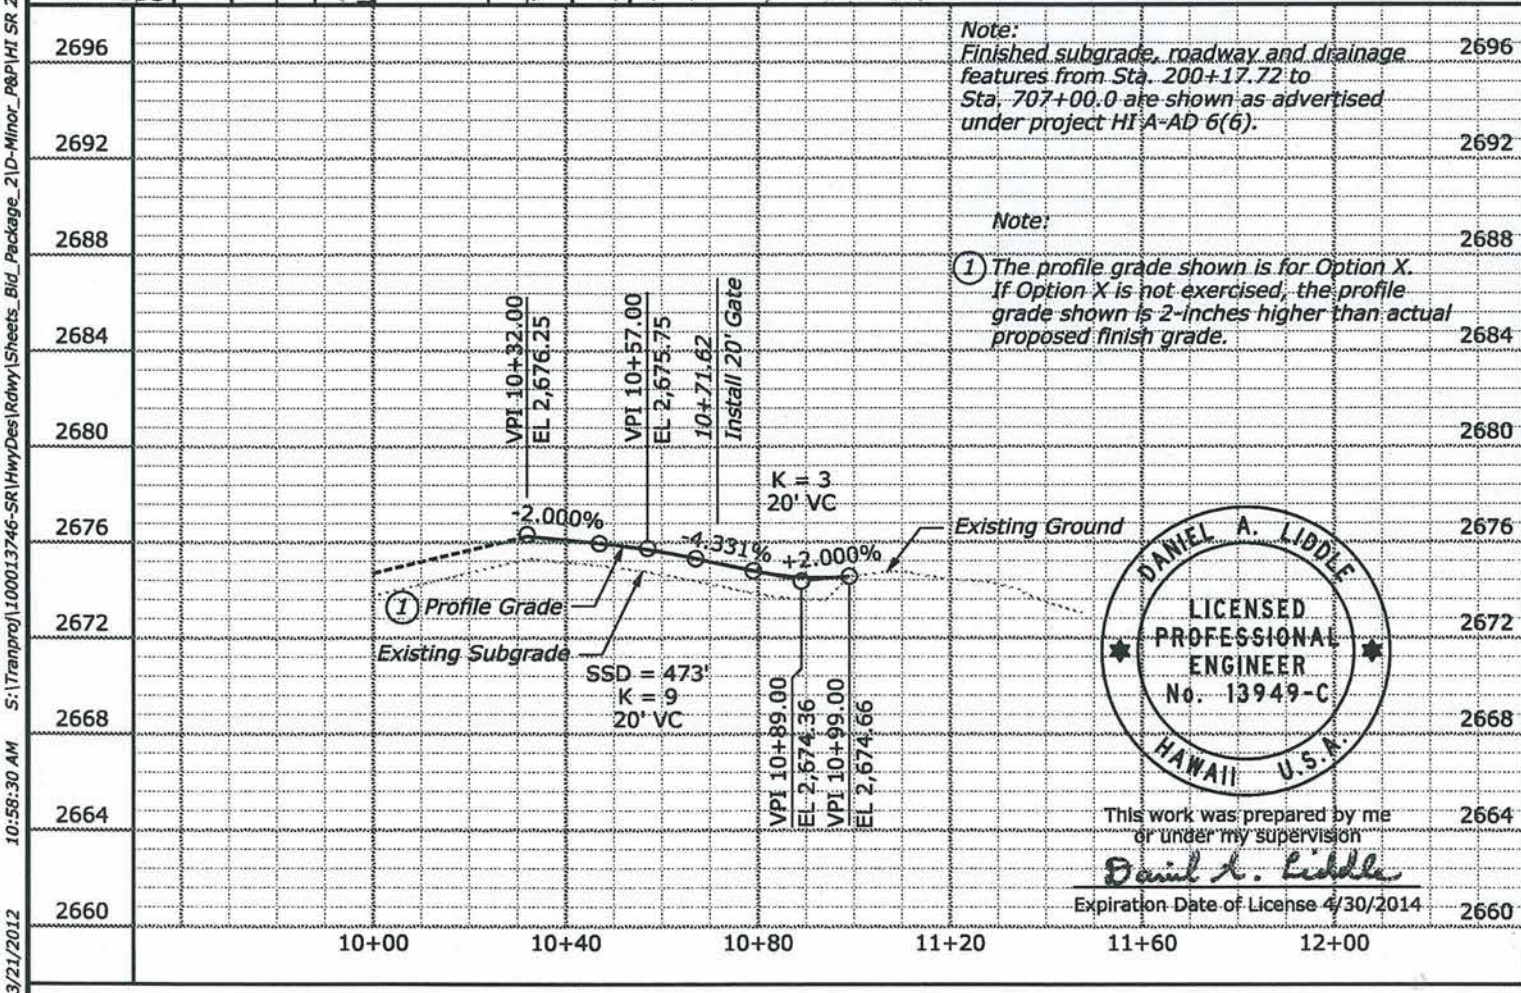
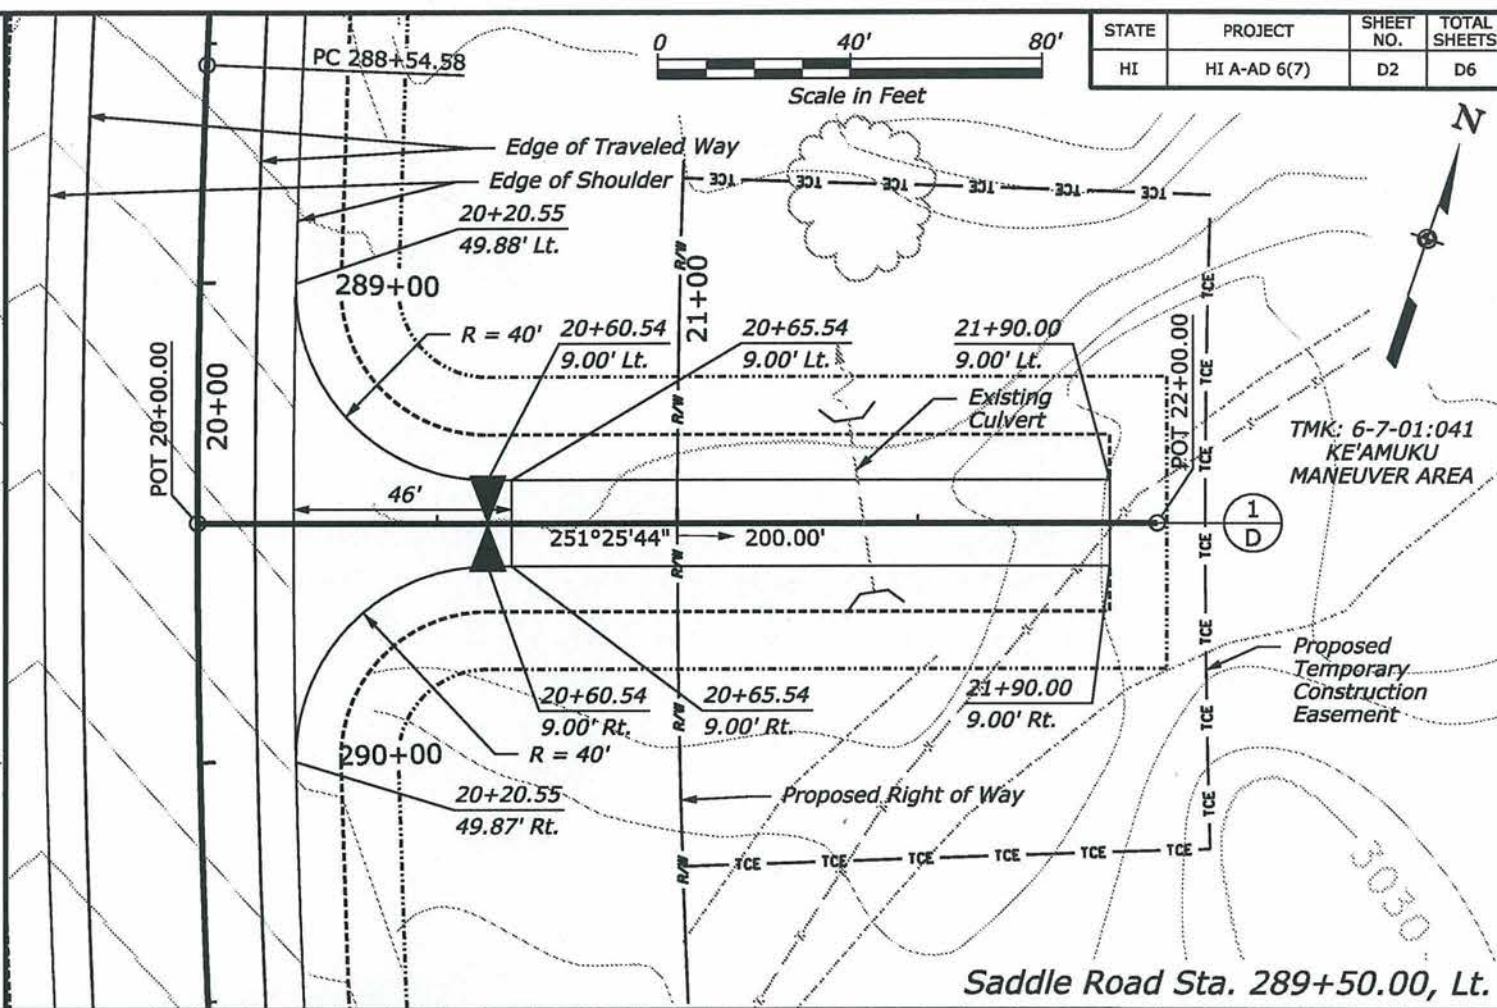
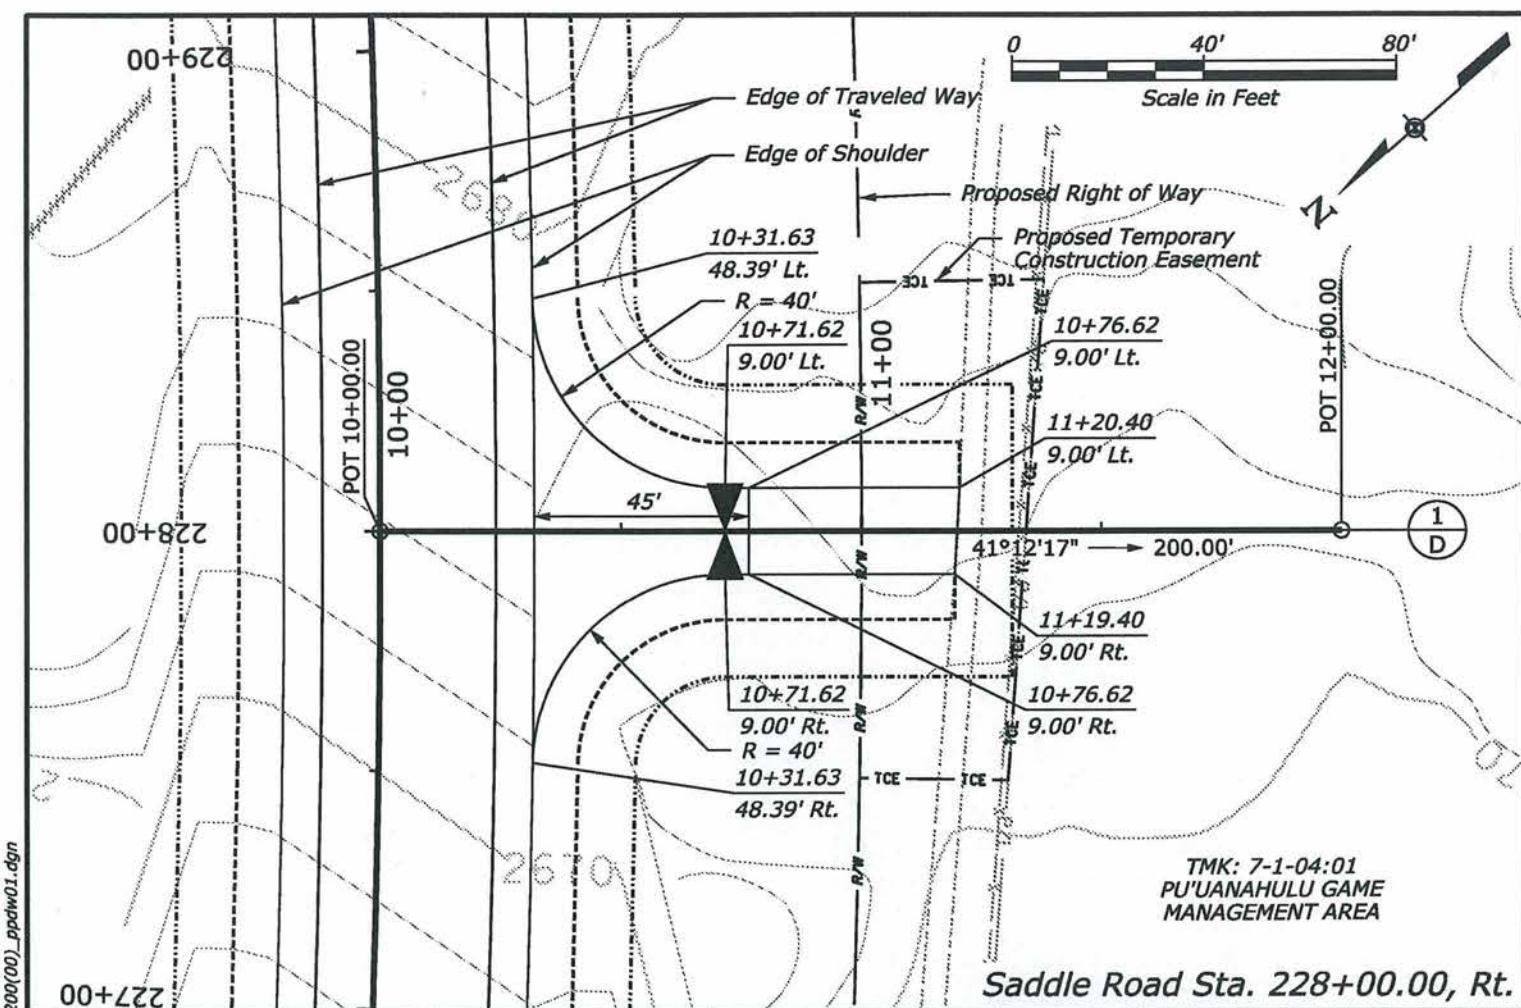






S:\Transport\100013746-SR\HwyDes\Drawings\21D-Minor_P&P\HI SR 200(00)_ppdw01.dgn
10:59:30 AM
3/21/2012

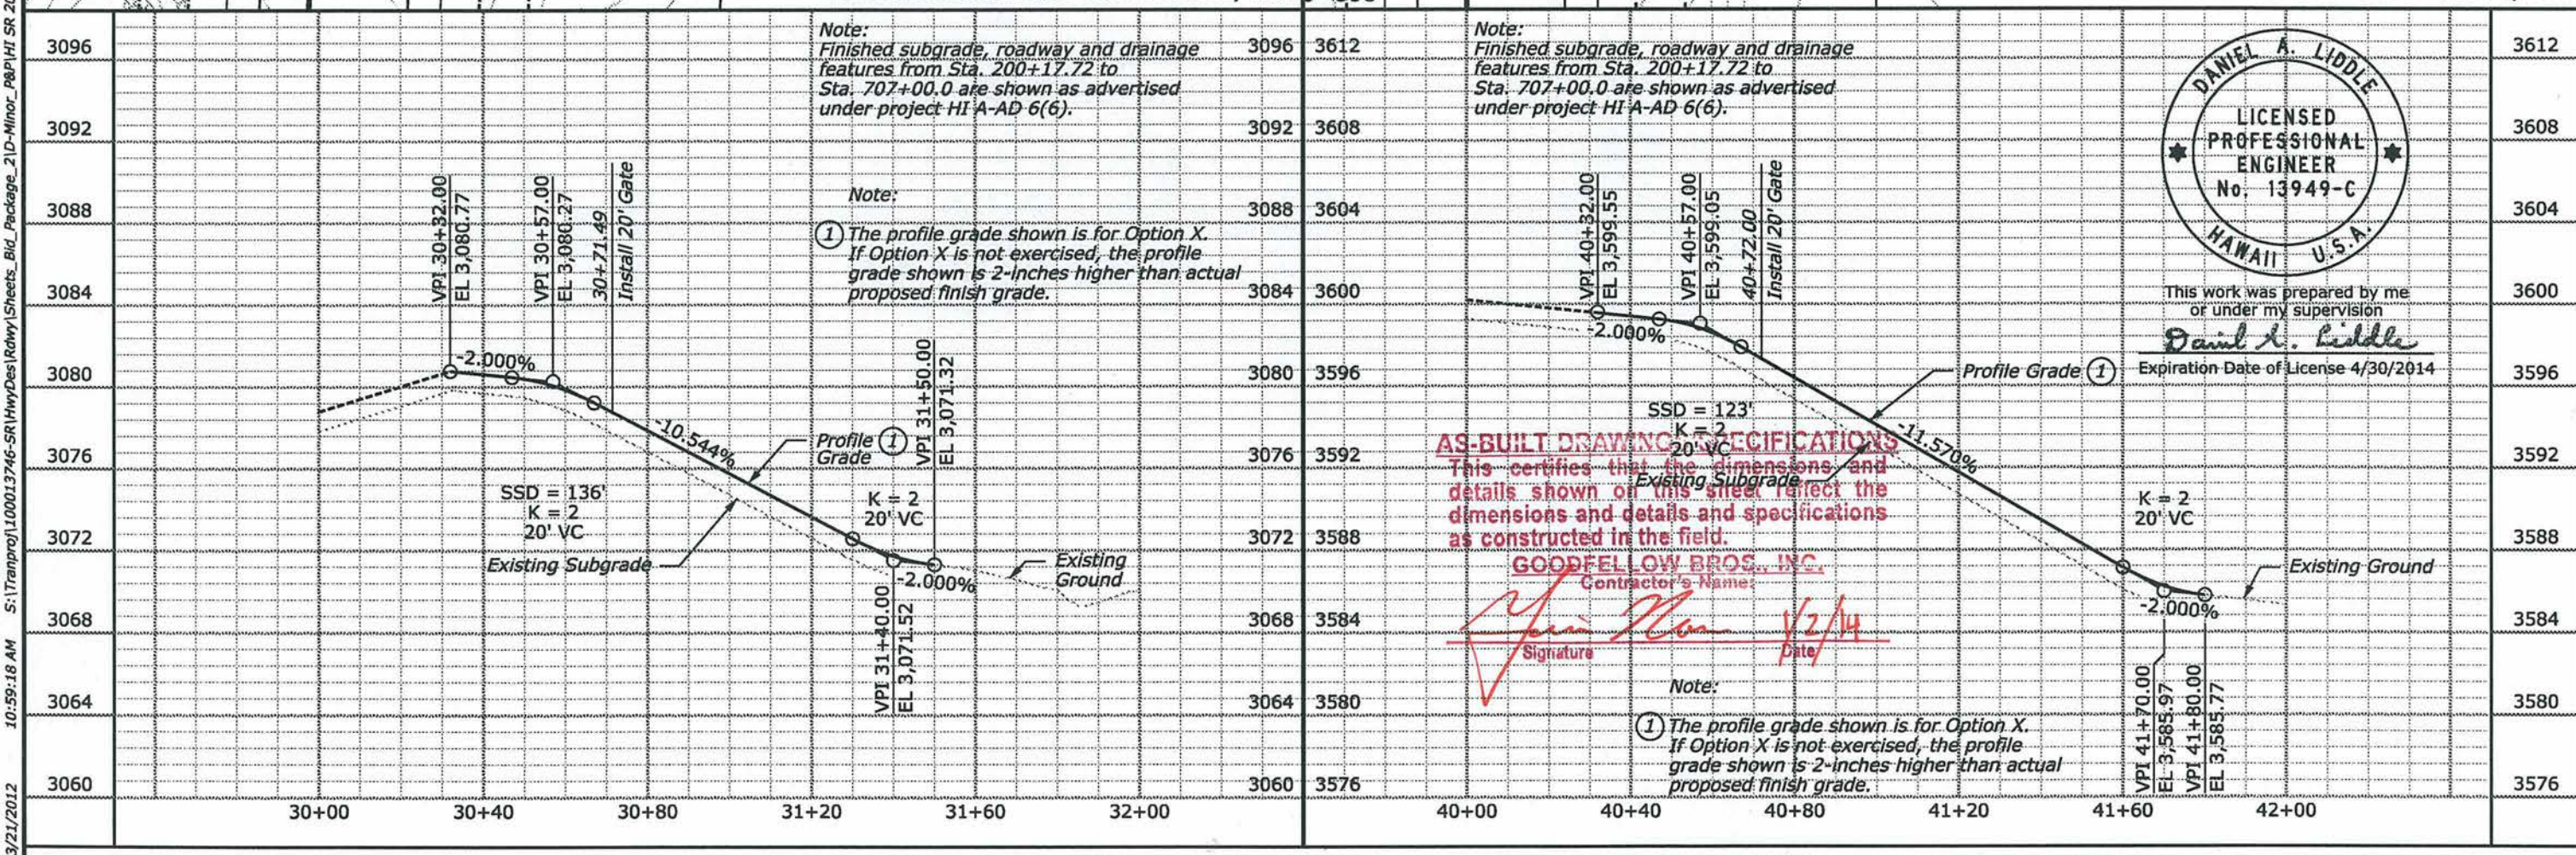

S:\Transport\100013746-SR\HwyDes\Drawings\21D-Minor_P&P\HI SR 200(00)_ppdw02.dgn
10:59:18 AM 3/21/2012

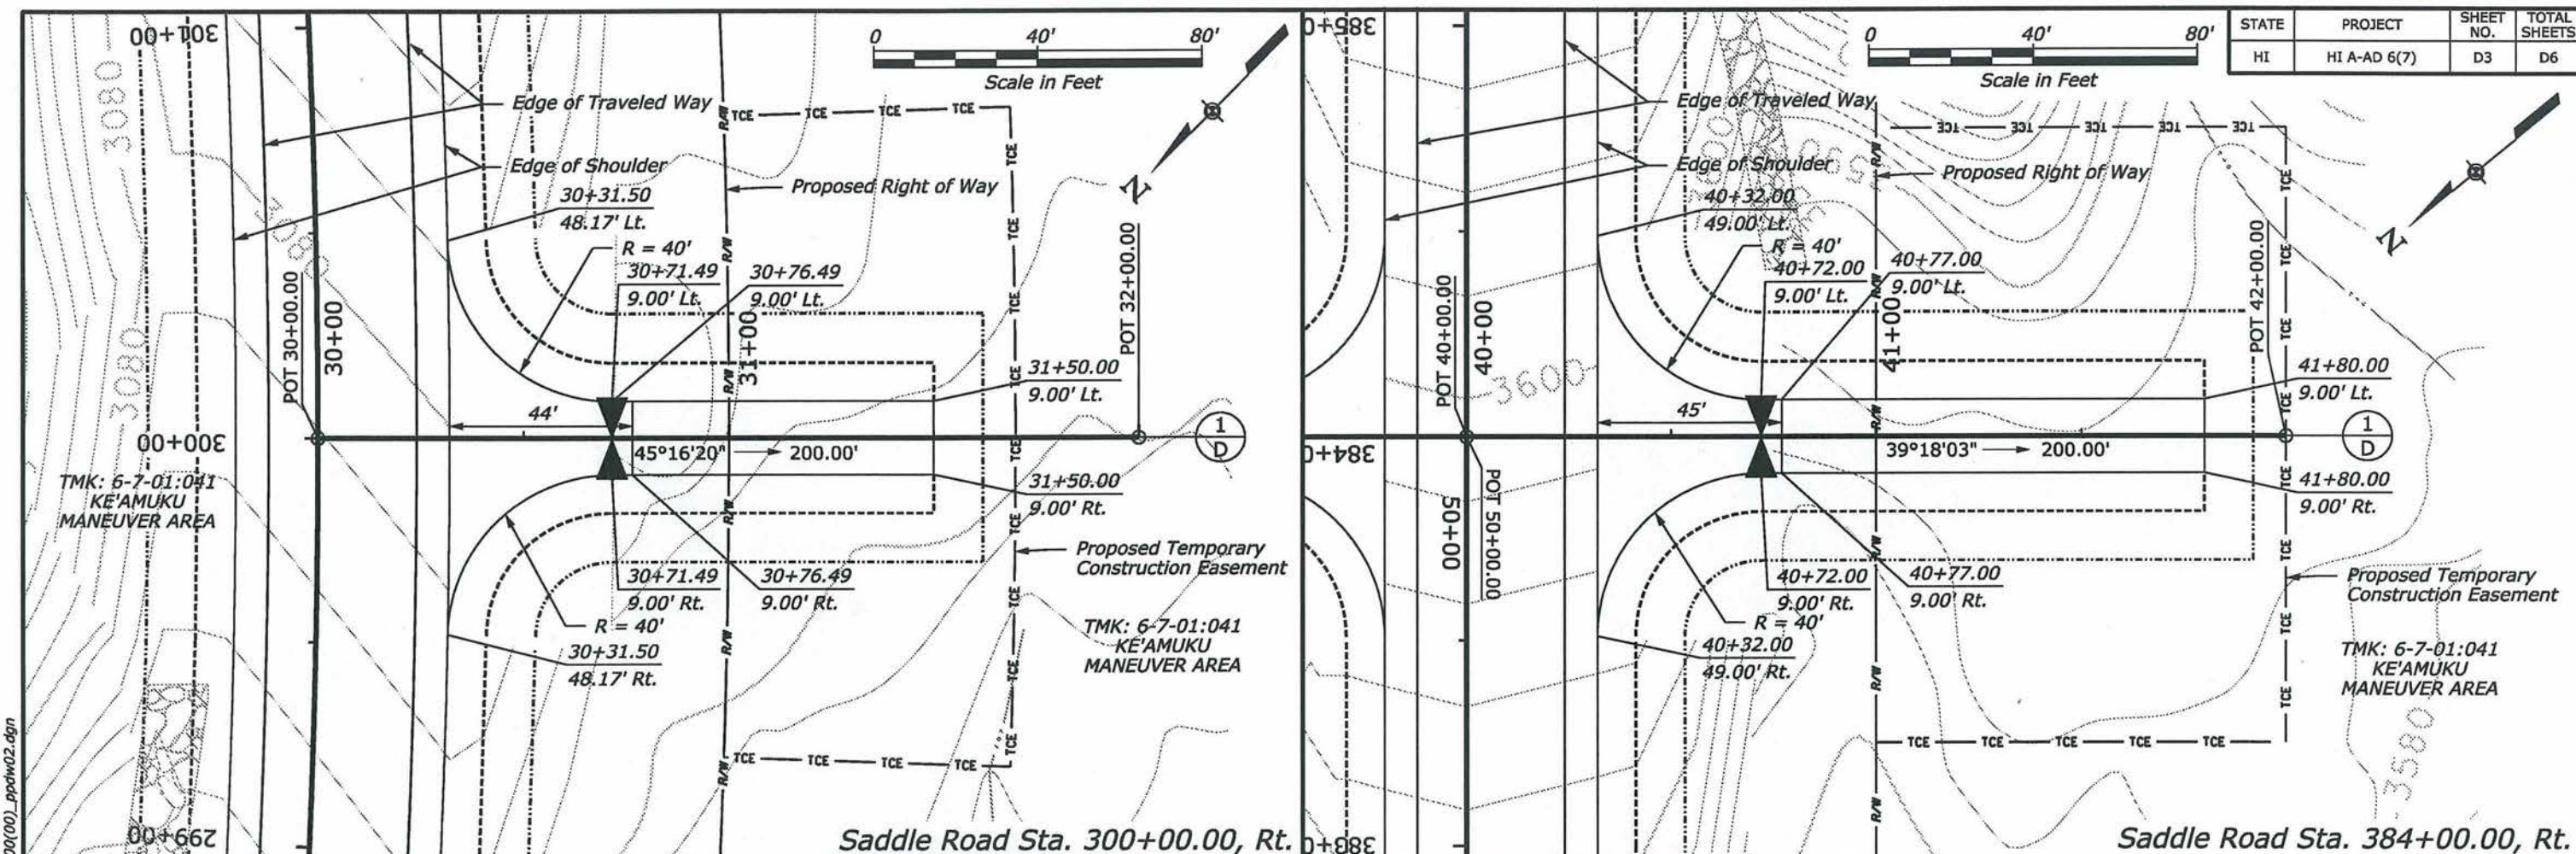

S:\Transport\100013746-SR(HwyDes\Row) Sheets_Bld_Package_21D-Minor_P&P\HI SR 200(00).ppdw03.dgn
11:00:02 AM 3/21/2012

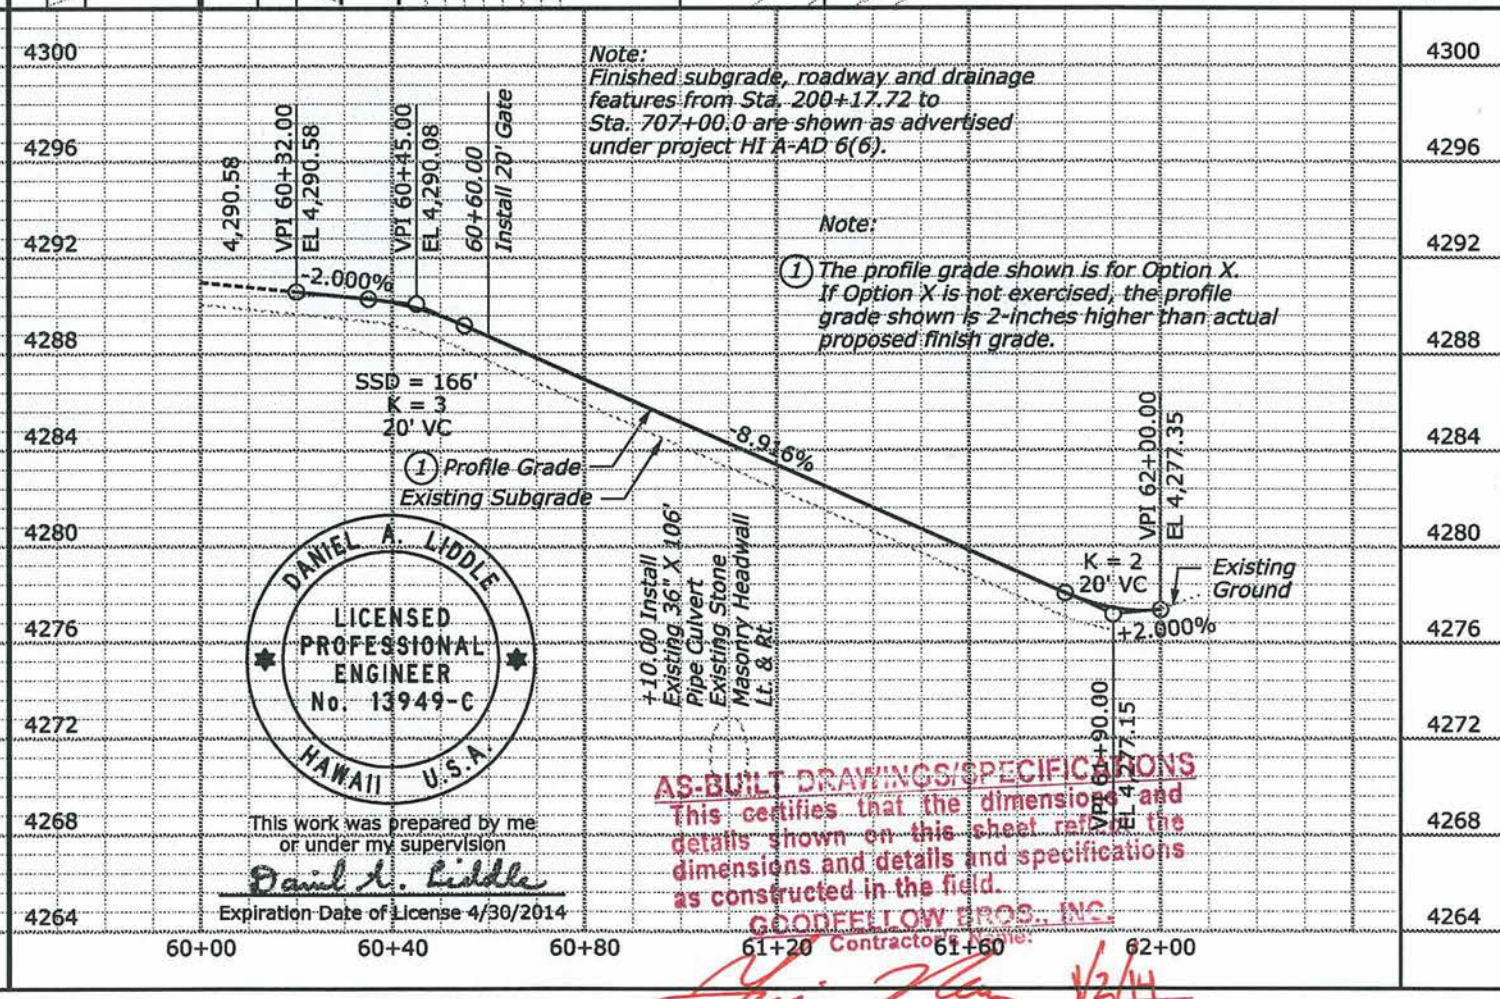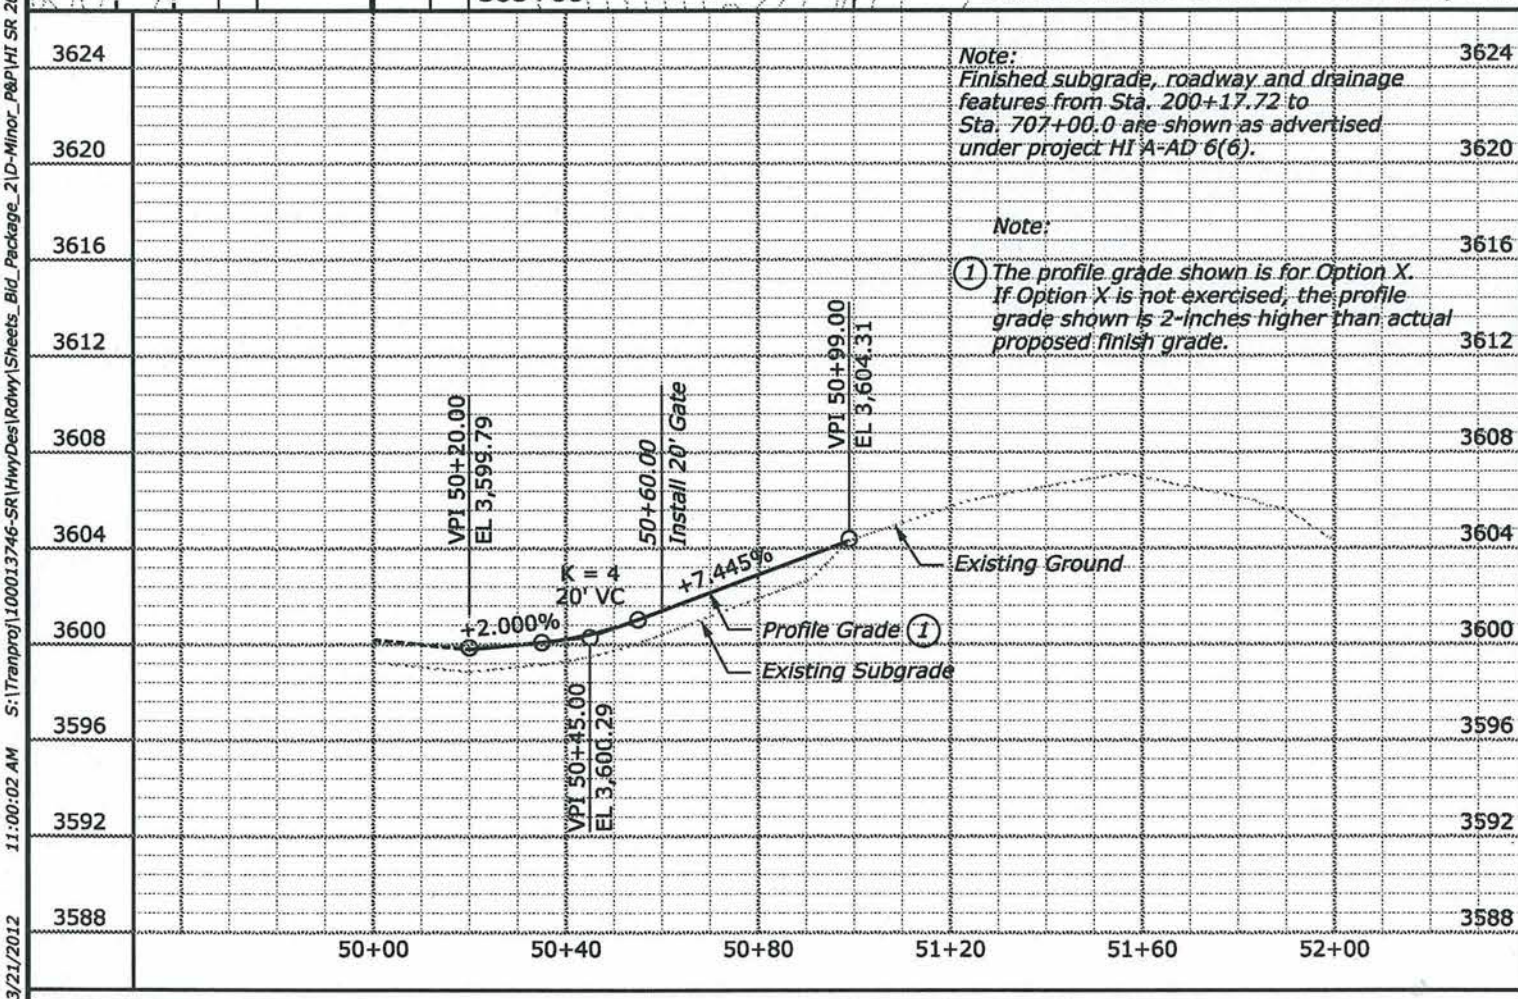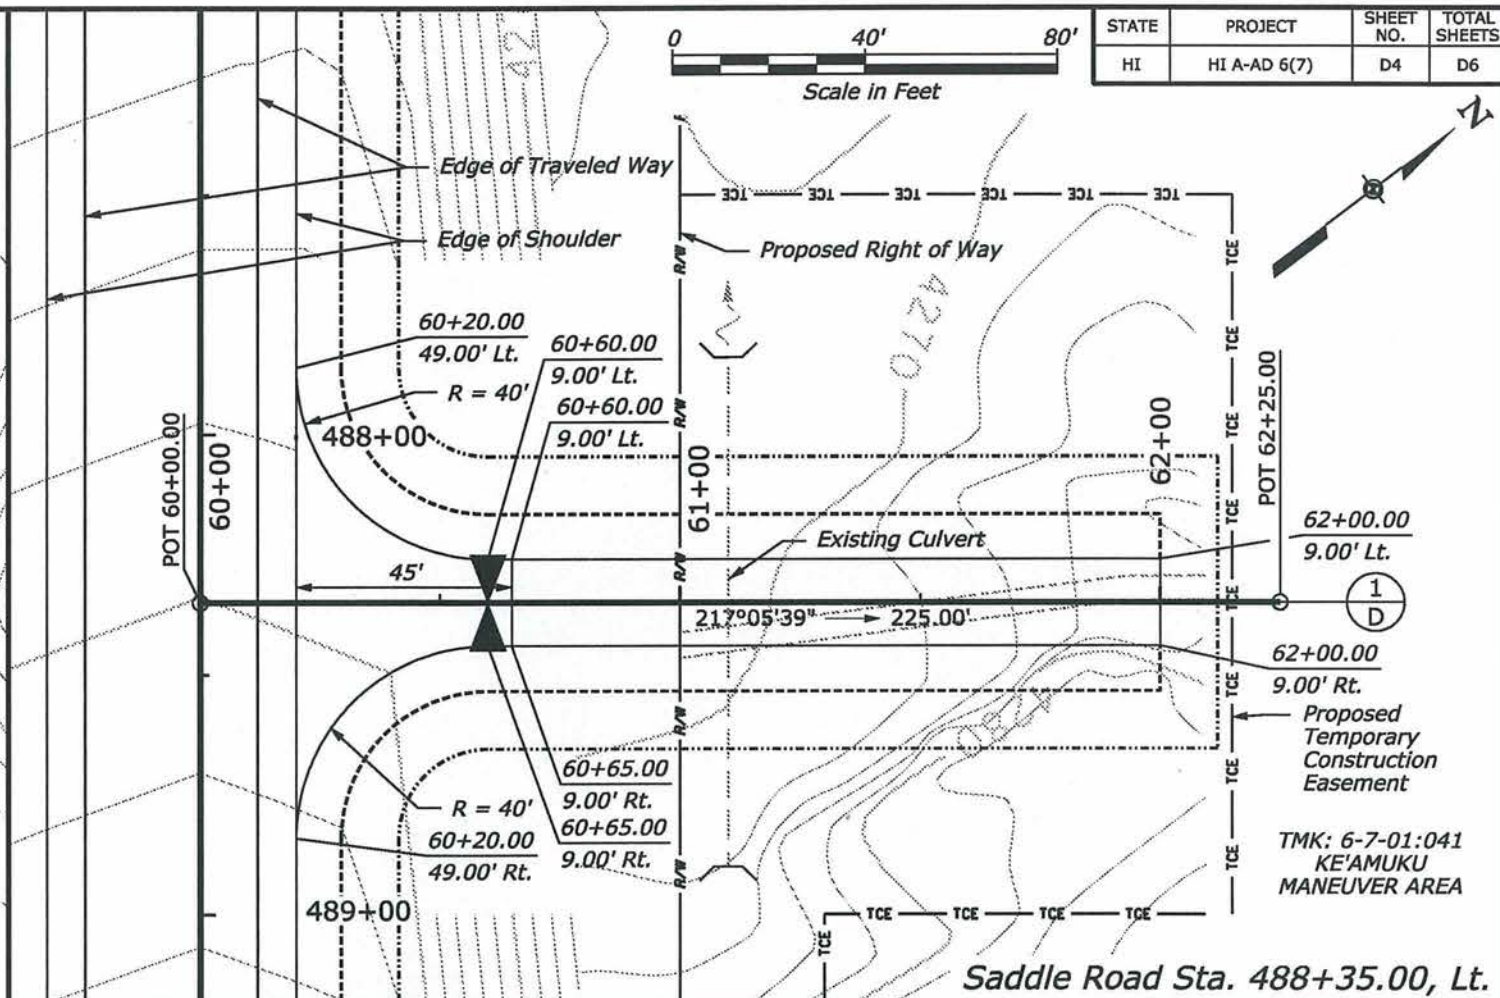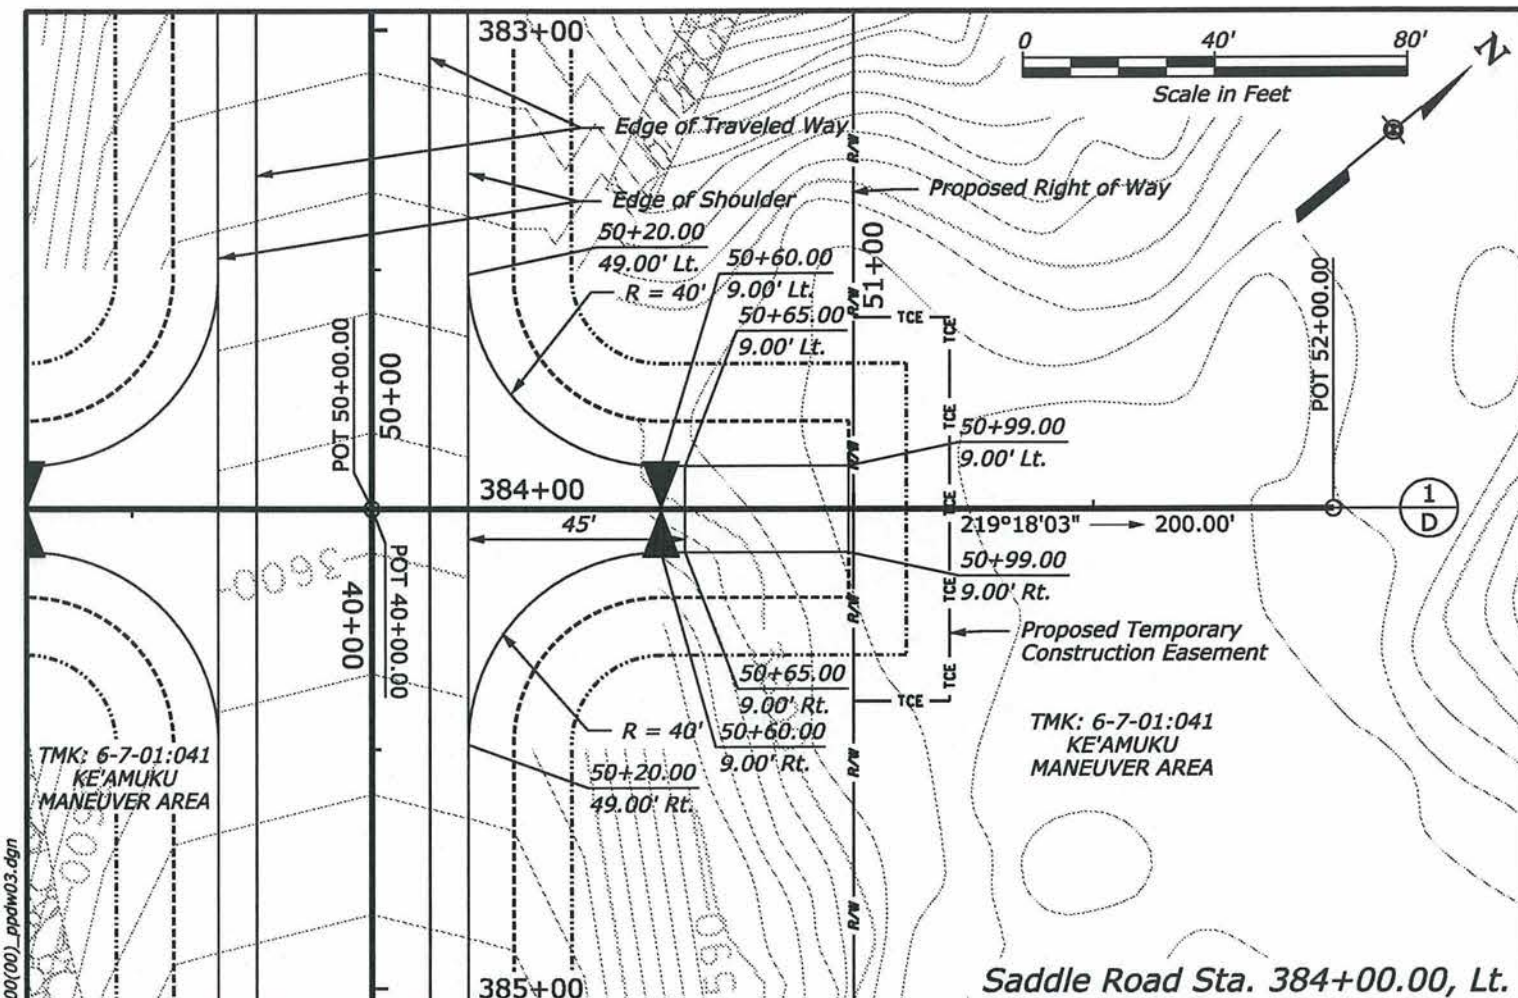


DANIEL A. LIDDLE
LICENSED
PROFESSIONAL
ENGINEER
No. 13949-C
HAWAII U.S.A.

This work was prepared by me
or under my supervision
Daniel A. Liddle
Expiration Date of License 4/30/2014

AS-BUILT DRAWINGS/SPECIFICATIONS
This certifies that the dimensions and
details shown on this sheet reflect the
dimensions and details of the
as constructed in the field.
GOODFELLOW BROS., INC.
Contractors
[Signature] 1/2/11
Date

STATE	PROJECT	SHEET NO.	TOTAL SHEETS
HI	HI A-AD 6(7)	D5	D6


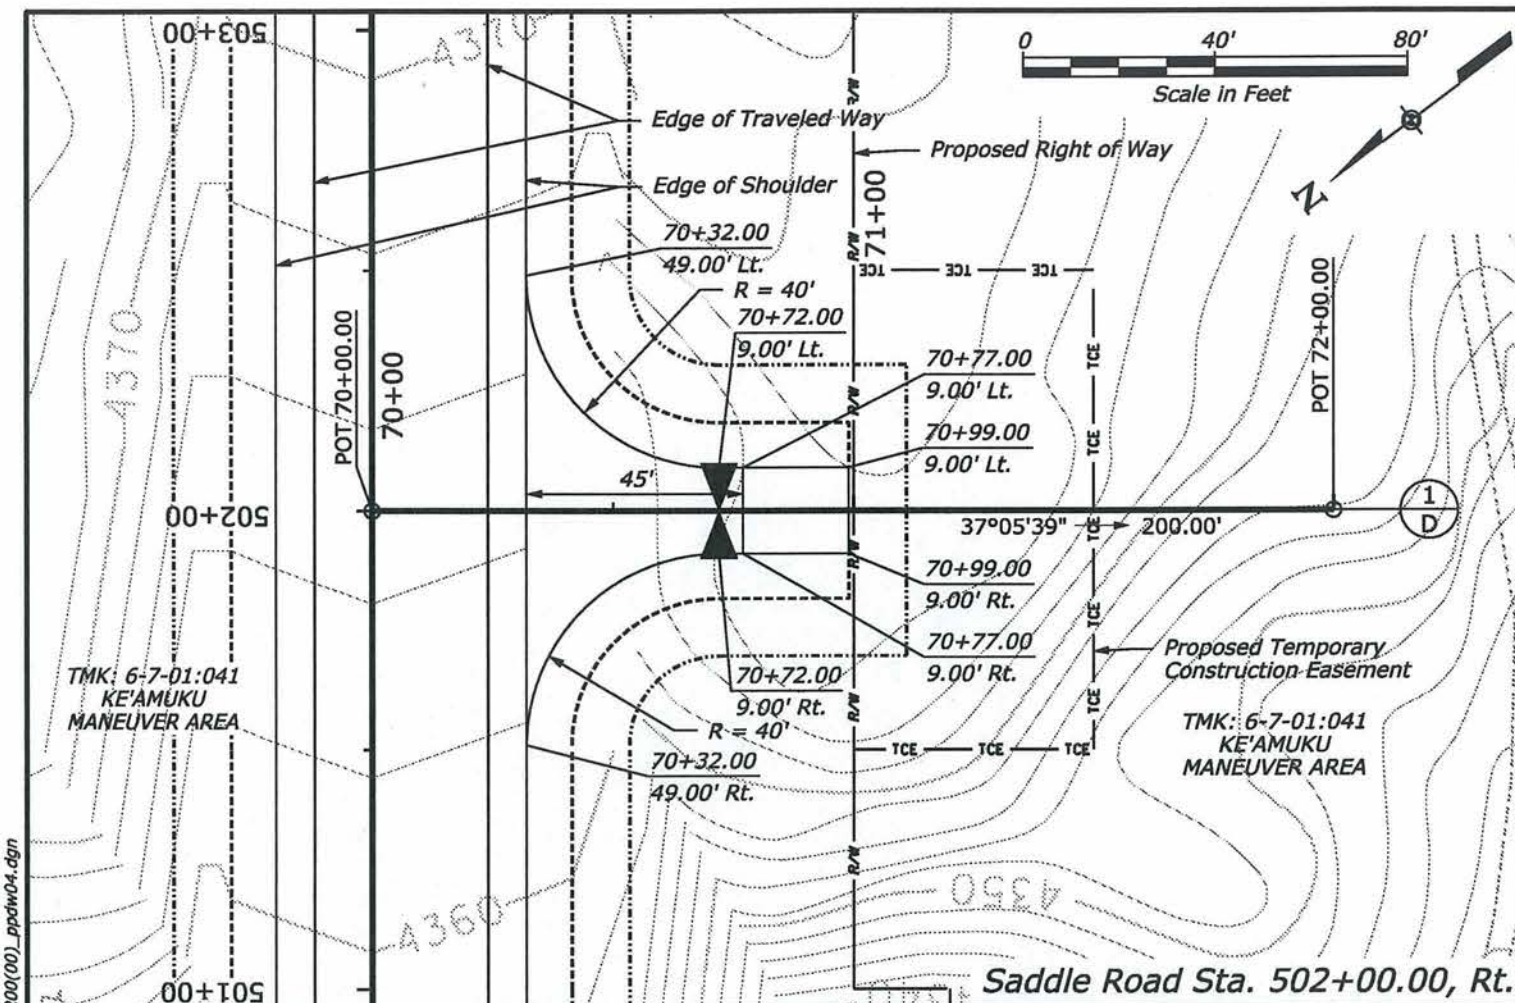


AS-BUILT DRAWINGS/SPECIFICATIONS

This certifies that the dimensions and details shown on this sheet reflect the dimensions and details and specifications as constructed in the field.


GOODFELLOW BROS., INC.
Contractor's Name:

Signature: *[Signature]* Date: 1/2/14

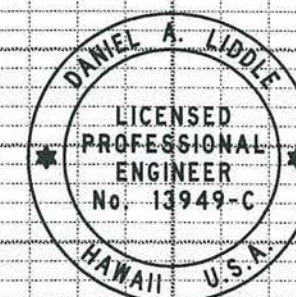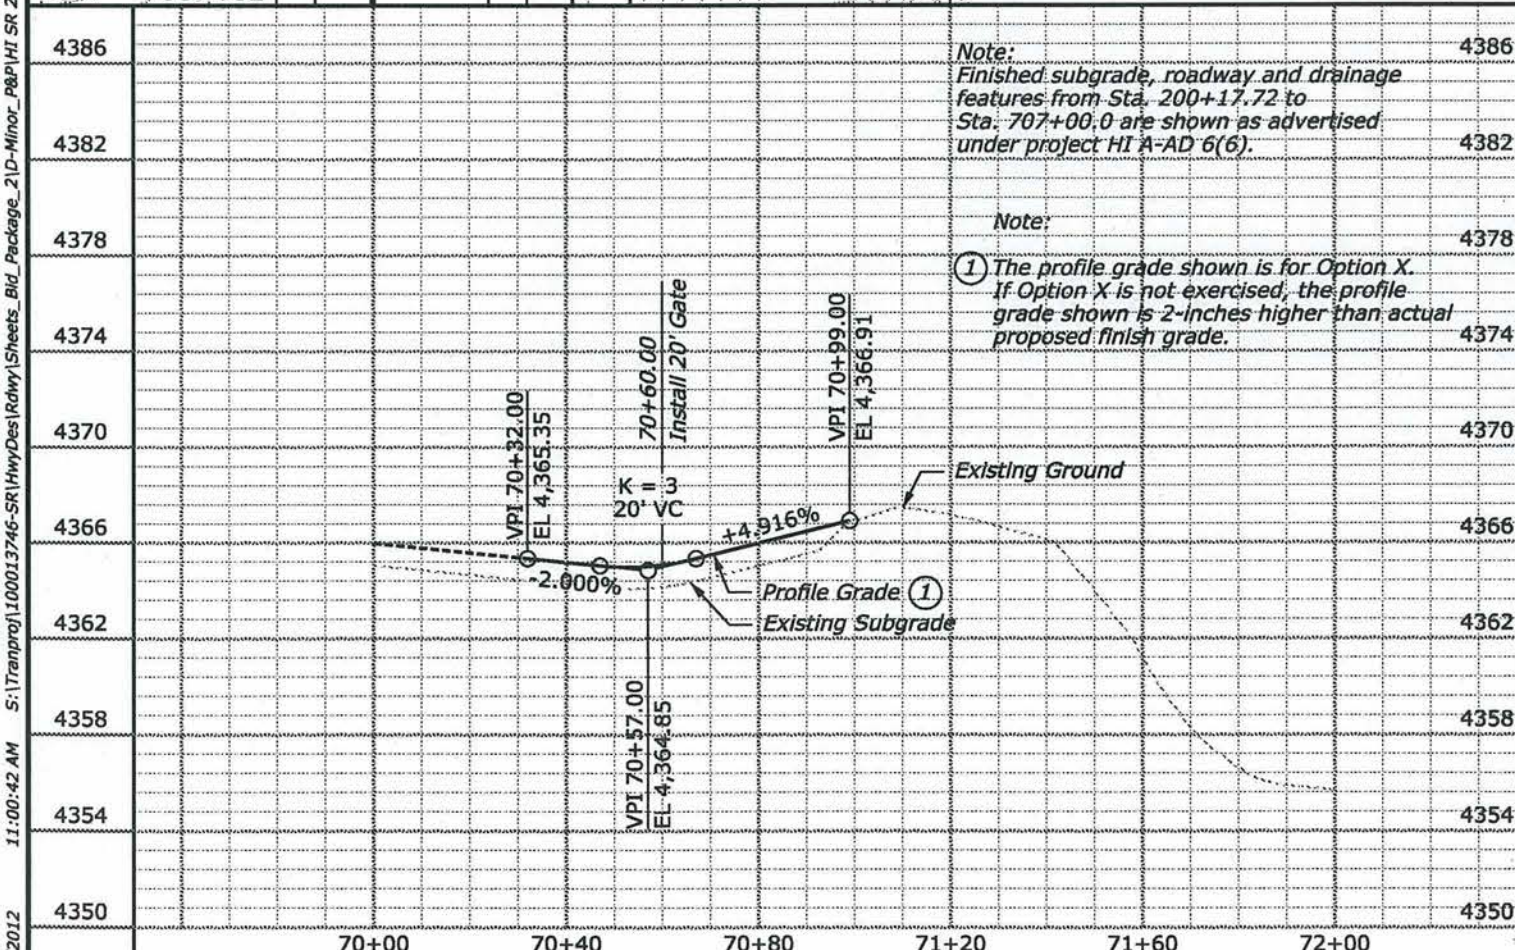

This work was prepared by me
or under my supervision
Daniel A. Liddle
Expiration Date of License 4/30/2014

TMK: 4-4-15:008
State of Hawaii
(United States Of America) lease
Portion of G.L. S-3849
Portion of TRACT A-105
POHAKULOA TRAINING AREA

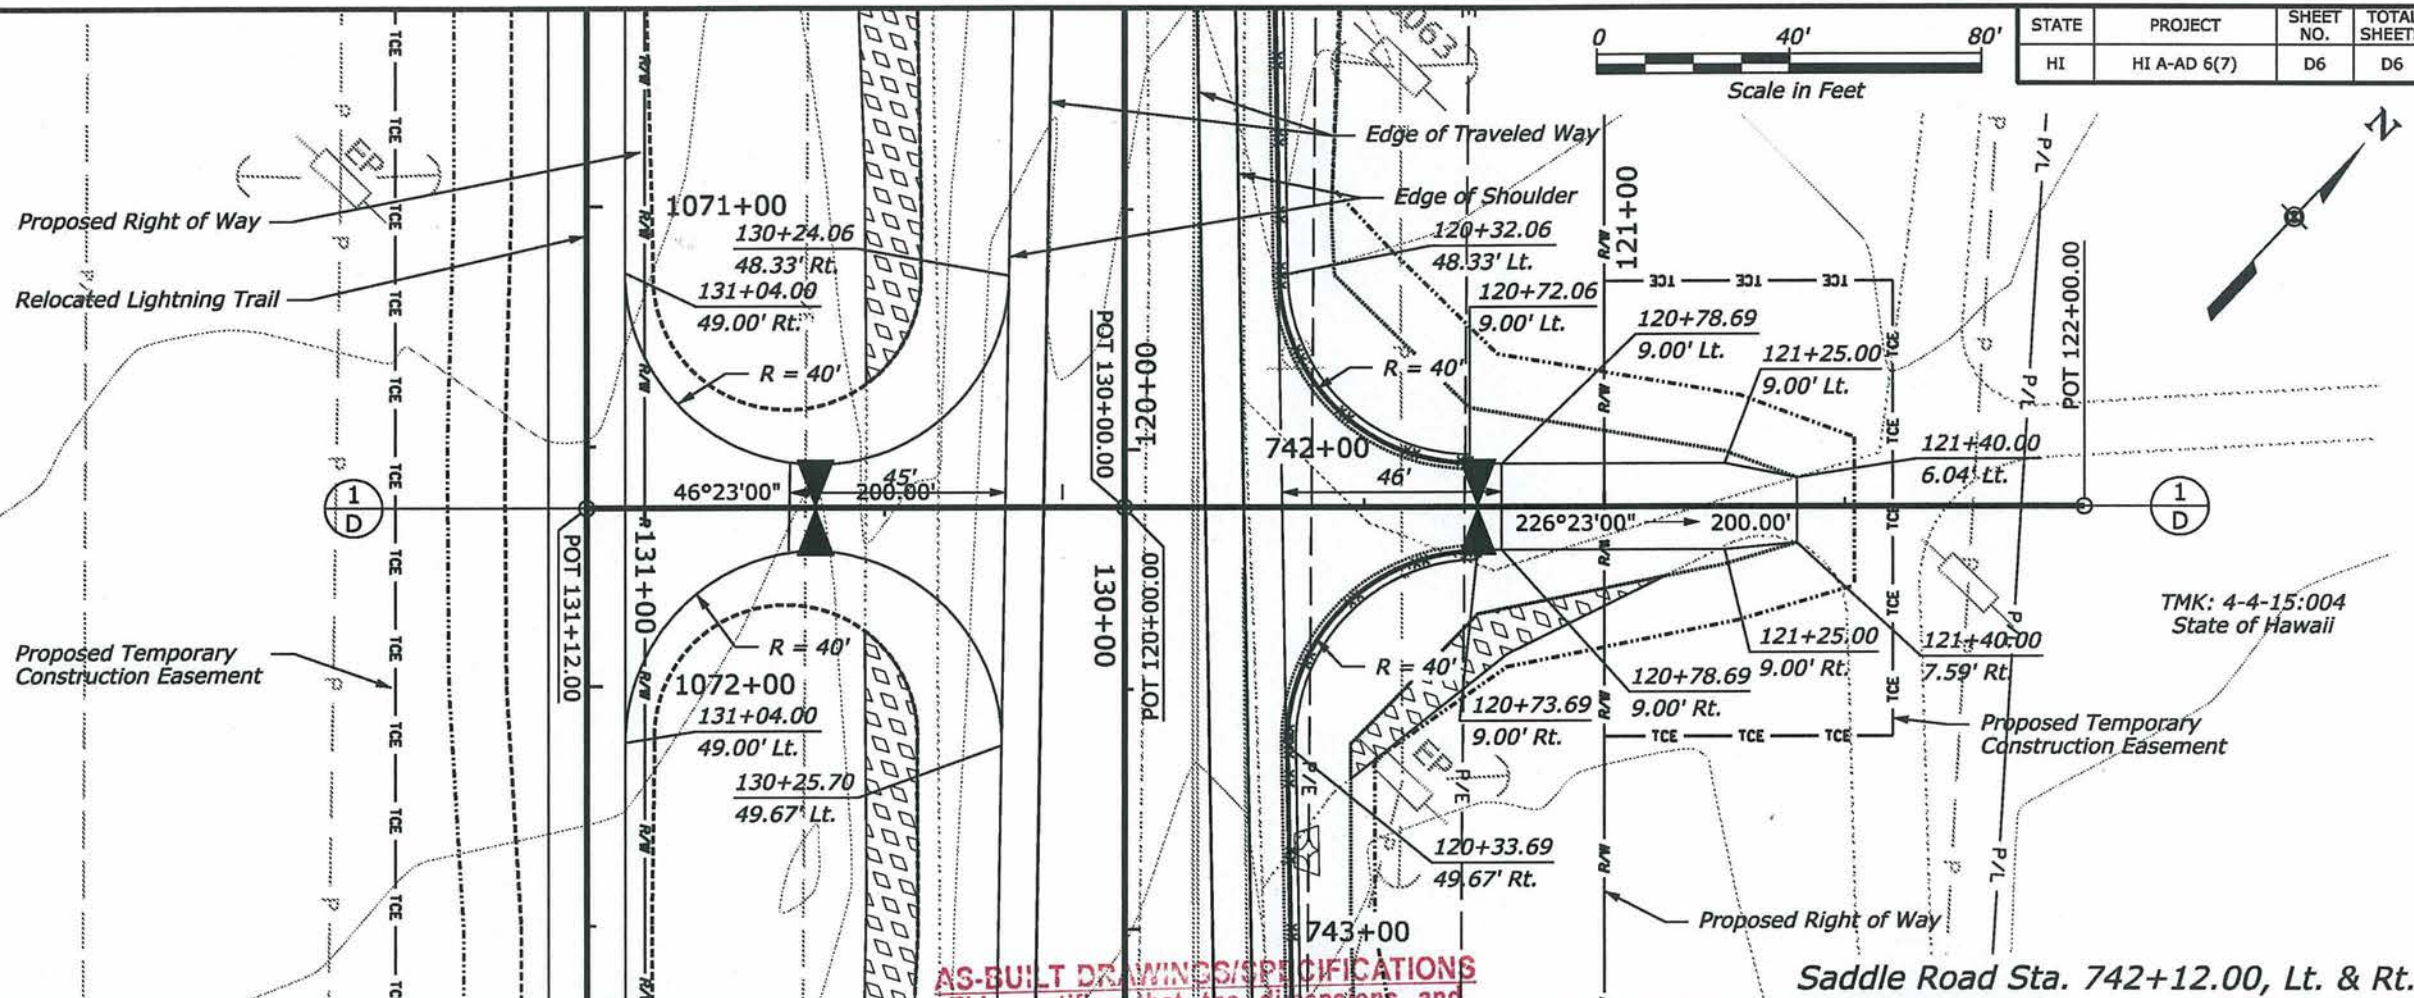

AS-BUILT DRAWINGS/SPECIFICATIONS

This certifies that the dimensions and details shown on this sheet reflect the dimensions and details and specifications as constructed in the field.



GOODFELLOW BROS. INC.
Contractor's Name:

[Signature]
Signature Date: 1/2/14

Saddle Road Sta. 742+12.00, Lt. & Rt.

Note:

- ① The profile grade shown is for Option X. If Option X is not exercised, the profile grade shown is 2-inches higher than actual proposed finish grade.

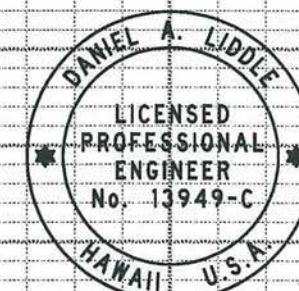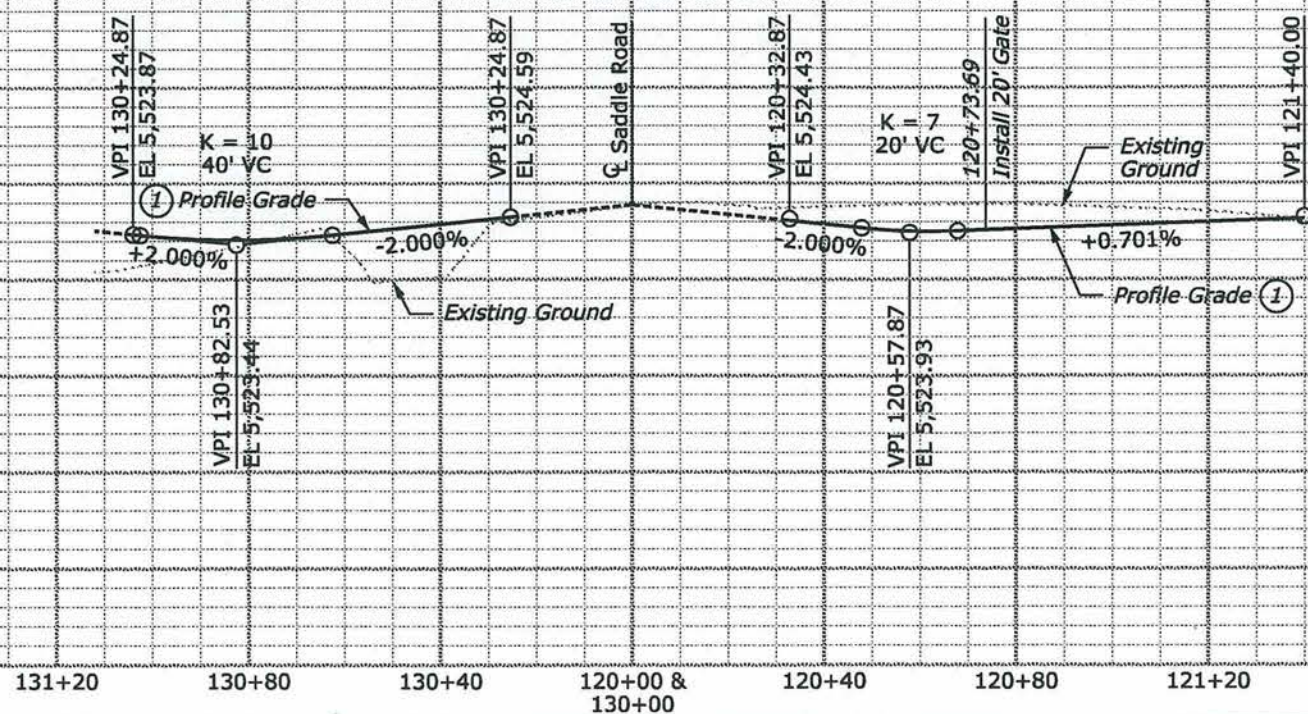

This work was prepared by me
or under my supervision
[Signature]
Expiration Date of License 4/30/2014