


REGION	STATE	PROJECT	SHEET NO.	TOTAL SHEETS
	HI	HI A-AD 6(7)	S14	S16



AS-BUILT DRAWINGS/SPECIFICATIONS
This certifies that the dimensions and details shown on this sheet reflect the dimensions and details as constructed in the field.

GOODFELLOW BROS., INC.
Contractor's Name:
[Signature] 1/2/14
Signature Date

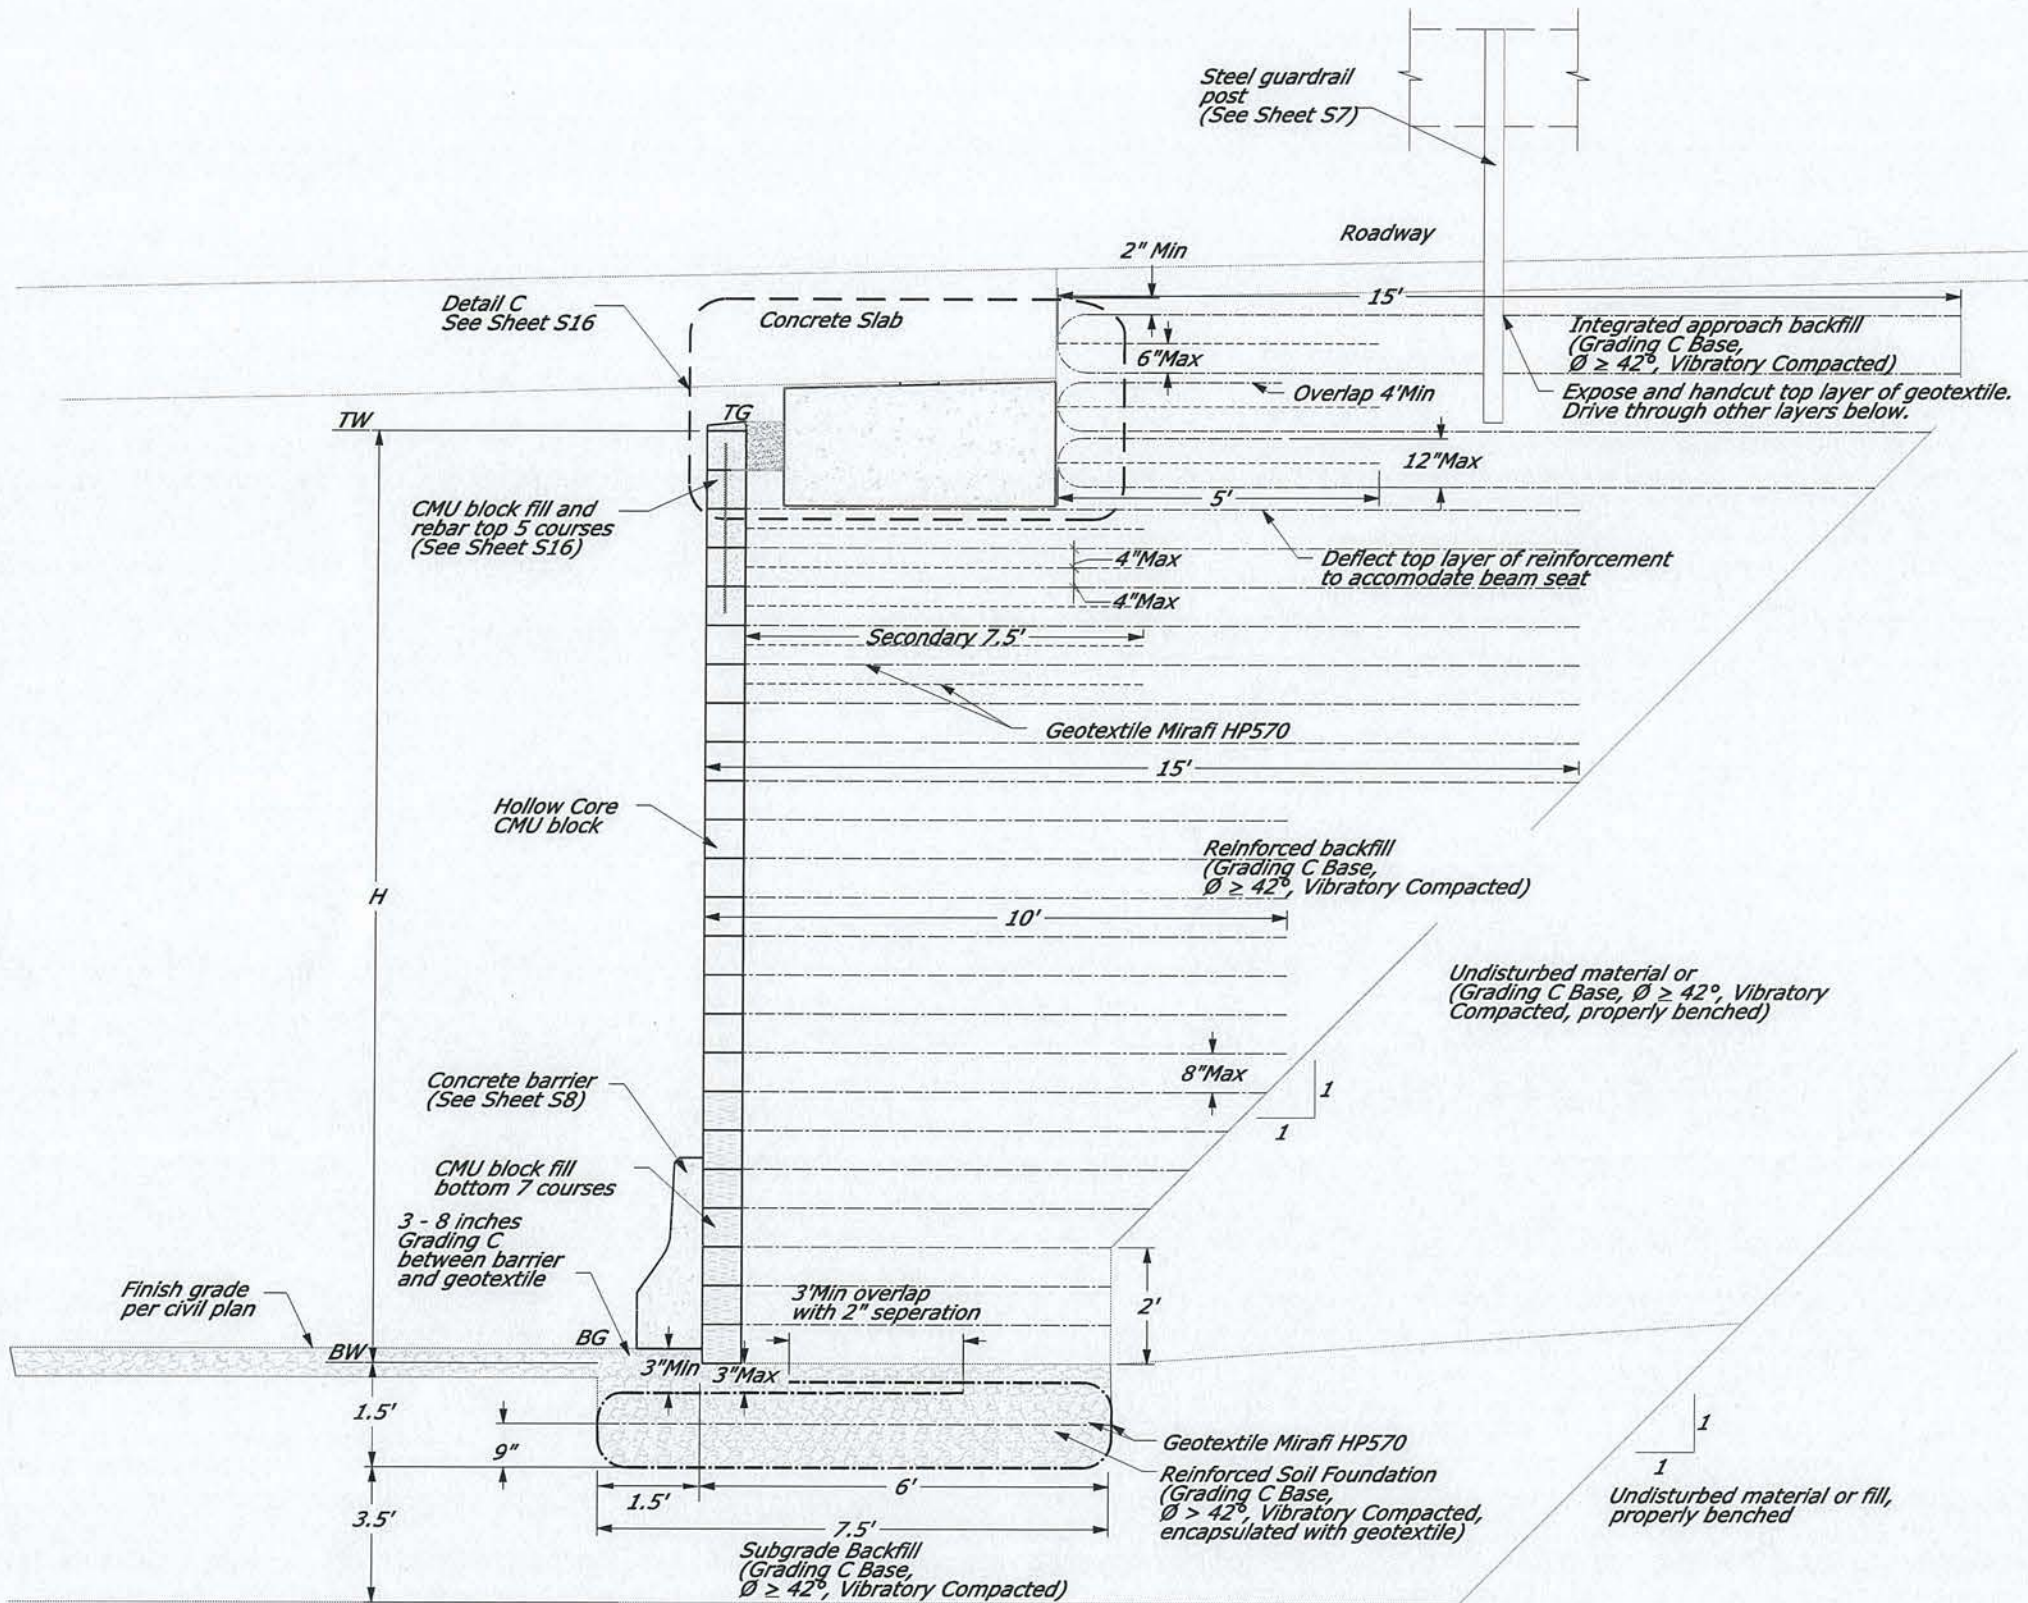

THIS WORK WAS PREPARED BY ME OR UNDER MY SUPERVISION.

[Signature]
SIGNATURE 04/30/14
EXPIRATION DATE OF THE LICENSE

U.S. DEPARTMENT OF TRANSPORTATION
FEDERAL HIGHWAY ADMINISTRATION
CENTRAL FEDERAL LANDS HIGHWAY DIVISION

**GRS-IBS
TYPICAL ABUTMENT SECTION**

TYPICAL ABUTMENT WALL CROSS SECTION A-A

APPROVED FOR CONSTRUCTION

NO.	DATE	BY	REVISIONS	NO.	DATE	BY	REVISIONS	DESIGNED BY	DRAWN BY	CHECKED BY	SCALE
								J.ARTHURS	H.SIDERS	H.H.CHIANG	NOT TO SCALE



BRIDGE DRAWING	DATE	DRAWING NO.
14 of 16	MARCH 2013	-

3/14/2013 9:36:03 AM K:\2012 Jobs\Engineering\12-3680\Working Documents\MicroStation\HI SR 200-00_SECTION01.dgn