

| REGION | STATE | PROJECT      | SHEET NO. | TOTAL SHEETS |
|--------|-------|--------------|-----------|--------------|
|        | HI    | HI A-AD 6(7) | S15       | S16          |

**AS-BUILT DRAWINGS/SPECIFICATIONS**  
This certifies that the dimensions and details shown on this sheet reflect the dimensions and details and specifications as constructed in the field.

**GOODFELLOW BROS., INC.**  
Contractor's Name:

*[Signature]* 1/2/14  
Signature Date




THIS WORK WAS PREPARED BY  
ME OR UNDER MY SUPERVISION.

*[Signature]*  
SIGNATURE 04/30/14  
EXPIRATION DATE OF THE LICENSE

U.S. DEPARTMENT OF TRANSPORTATION  
FEDERAL HIGHWAY ADMINISTRATION  
CENTRAL FEDERAL LANDS HIGHWAY DIVISION

**GRS-IBS**  
**TYPICAL WING WALL SECTION**

| BRIDGE DRAWING | DATE       | DRAWING NO. |
|----------------|------------|-------------|
| 15 of 16       | MARCH 2013 | -           |

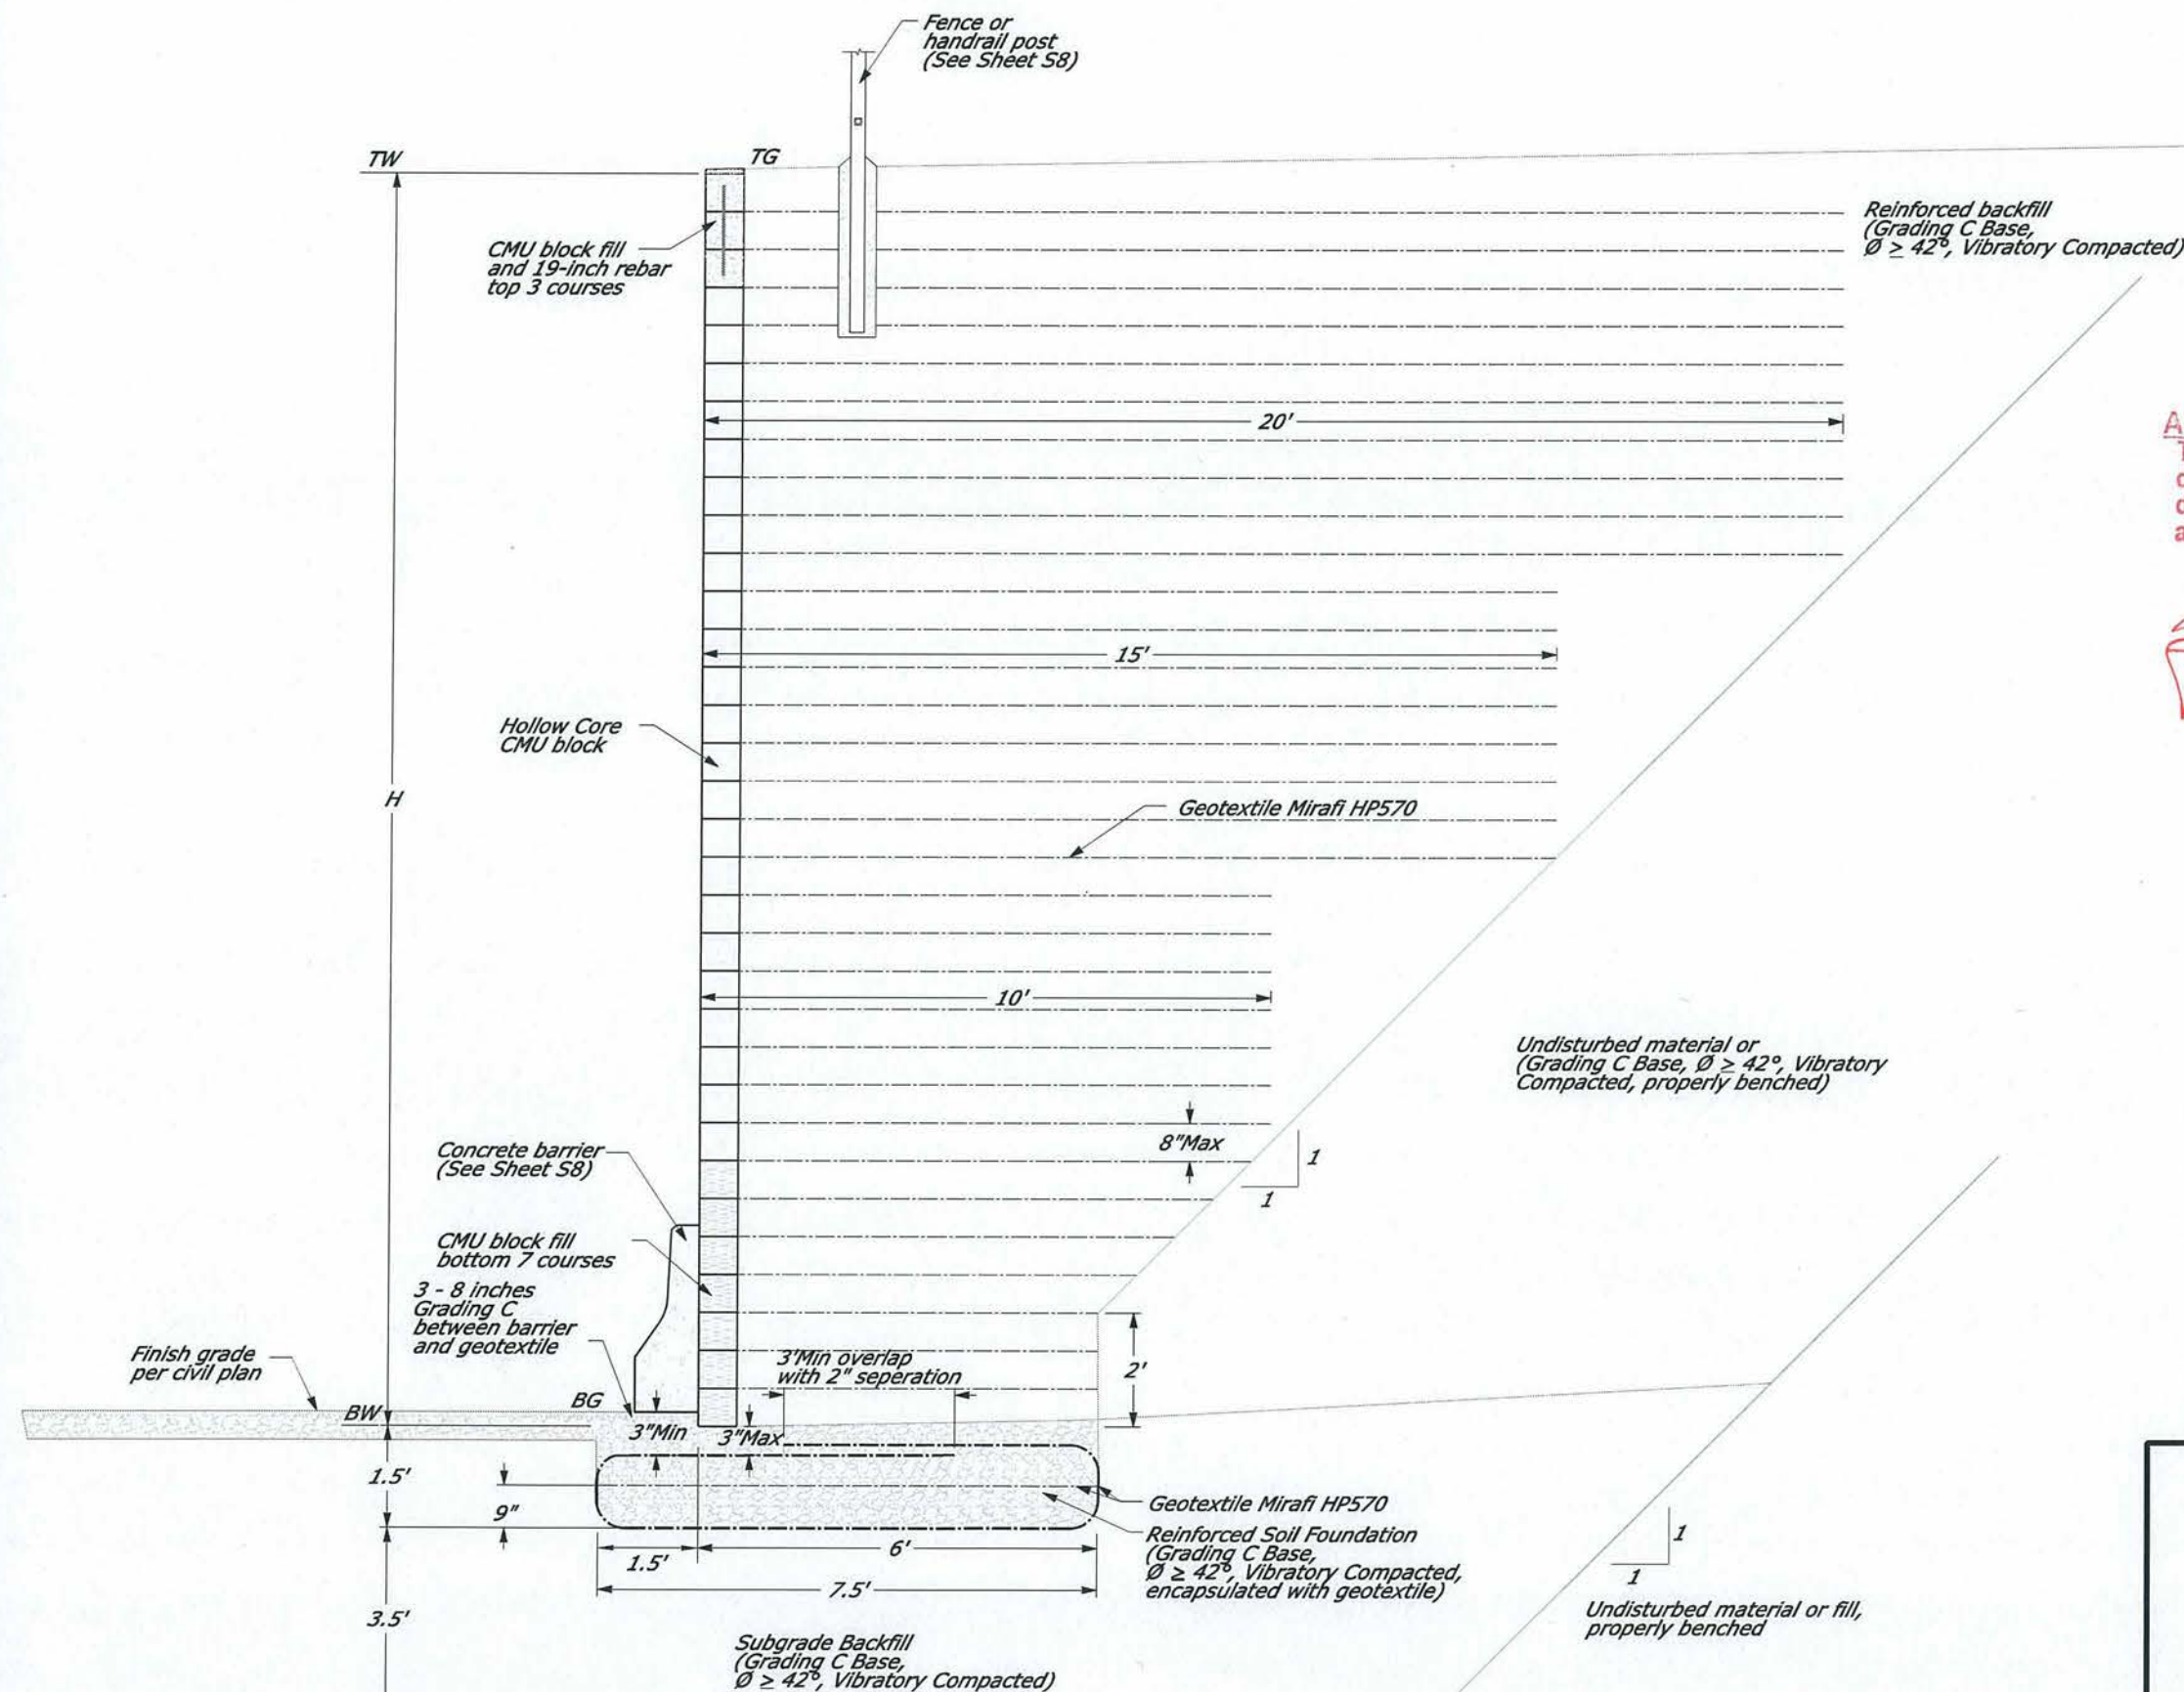

TYPICAL WING WALL CROSS SECTION A-A

APPROVED FOR CONSTRUCTION

| NO. | DATE | BY | REVISIONS | NO. | DATE | BY | REVISIONS | DESIGNED BY | DRAWN BY | CHECKED BY | SCALE        |
|-----|------|----|-----------|-----|------|----|-----------|-------------|----------|------------|--------------|
|     |      |    |           |     |      |    |           | J.ARTHURS   | H.SIDERS | H.H.CHIANG | NOT TO SCALE |

**GROUND**  
ENGINEERING CONSULTANTS

3/14/2013 9:37:20 AM K:\2012 Jobs\Engineering\12-3680\Working Documents\MicroStation\HI SR 200-00\_SECTION02.dgn